


TWENTY-FIRST STREET BRIDGE

OVER THE

BIG ARKANSAS RIVER

CITY OF

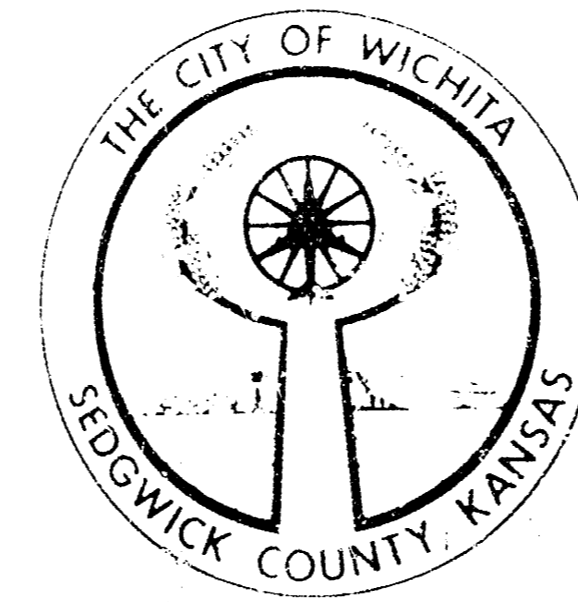

WICHITA

A. PRICE WOODARD JR., MAYOR

WALTER M. KEELER

DONALD K. ENOCH

JACK H. GREENE

JOHN S. STEVENS

COMMISSIONERS

RALPH WULZ, CITY MANAGER

DEPARTMENT OF PUBLIC WORKS

R. W. BRUGGEMAN, P.E. DIRECTOR OF PUBLIC WORKS

BILL E. SMITH, P.E. CITY ENGINEER





R. S. DELAMATER & ASSOCIATES, WICHITA, CONSULTING ENGINEERS

INDEX OF SHEETS

1. Title Sheet
2. Contour Map
3. Plan-Profile
4. Construction Layout
5. Abutment Plan
6. Abutment Reinforcing
7. Pier Detail
8. Deck Sections
9. Superstructure Plan
10. Superstructure and Sidewalk Details
11. Handrail Details
12. Structural Steel Details and Bearing Devices
13. Weir Details
14. Auxiliary Details and Summary of Quantities
15. Bar List and Bending Diagrams





PROJECT C10-51

DECEMBER, 1970

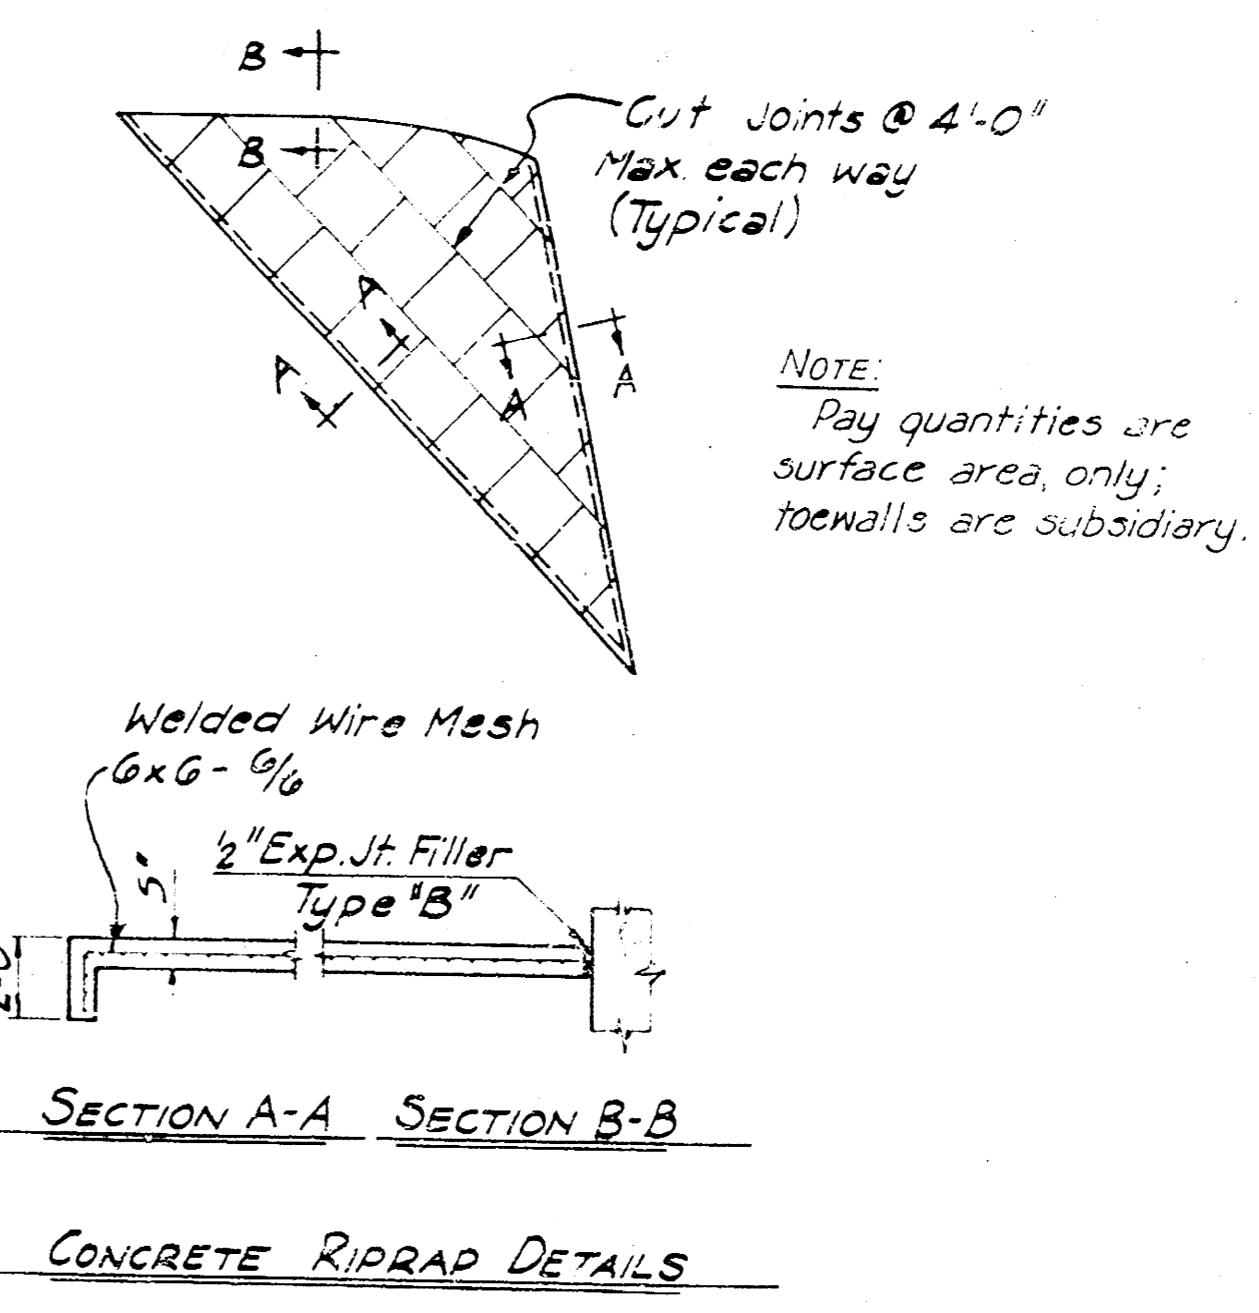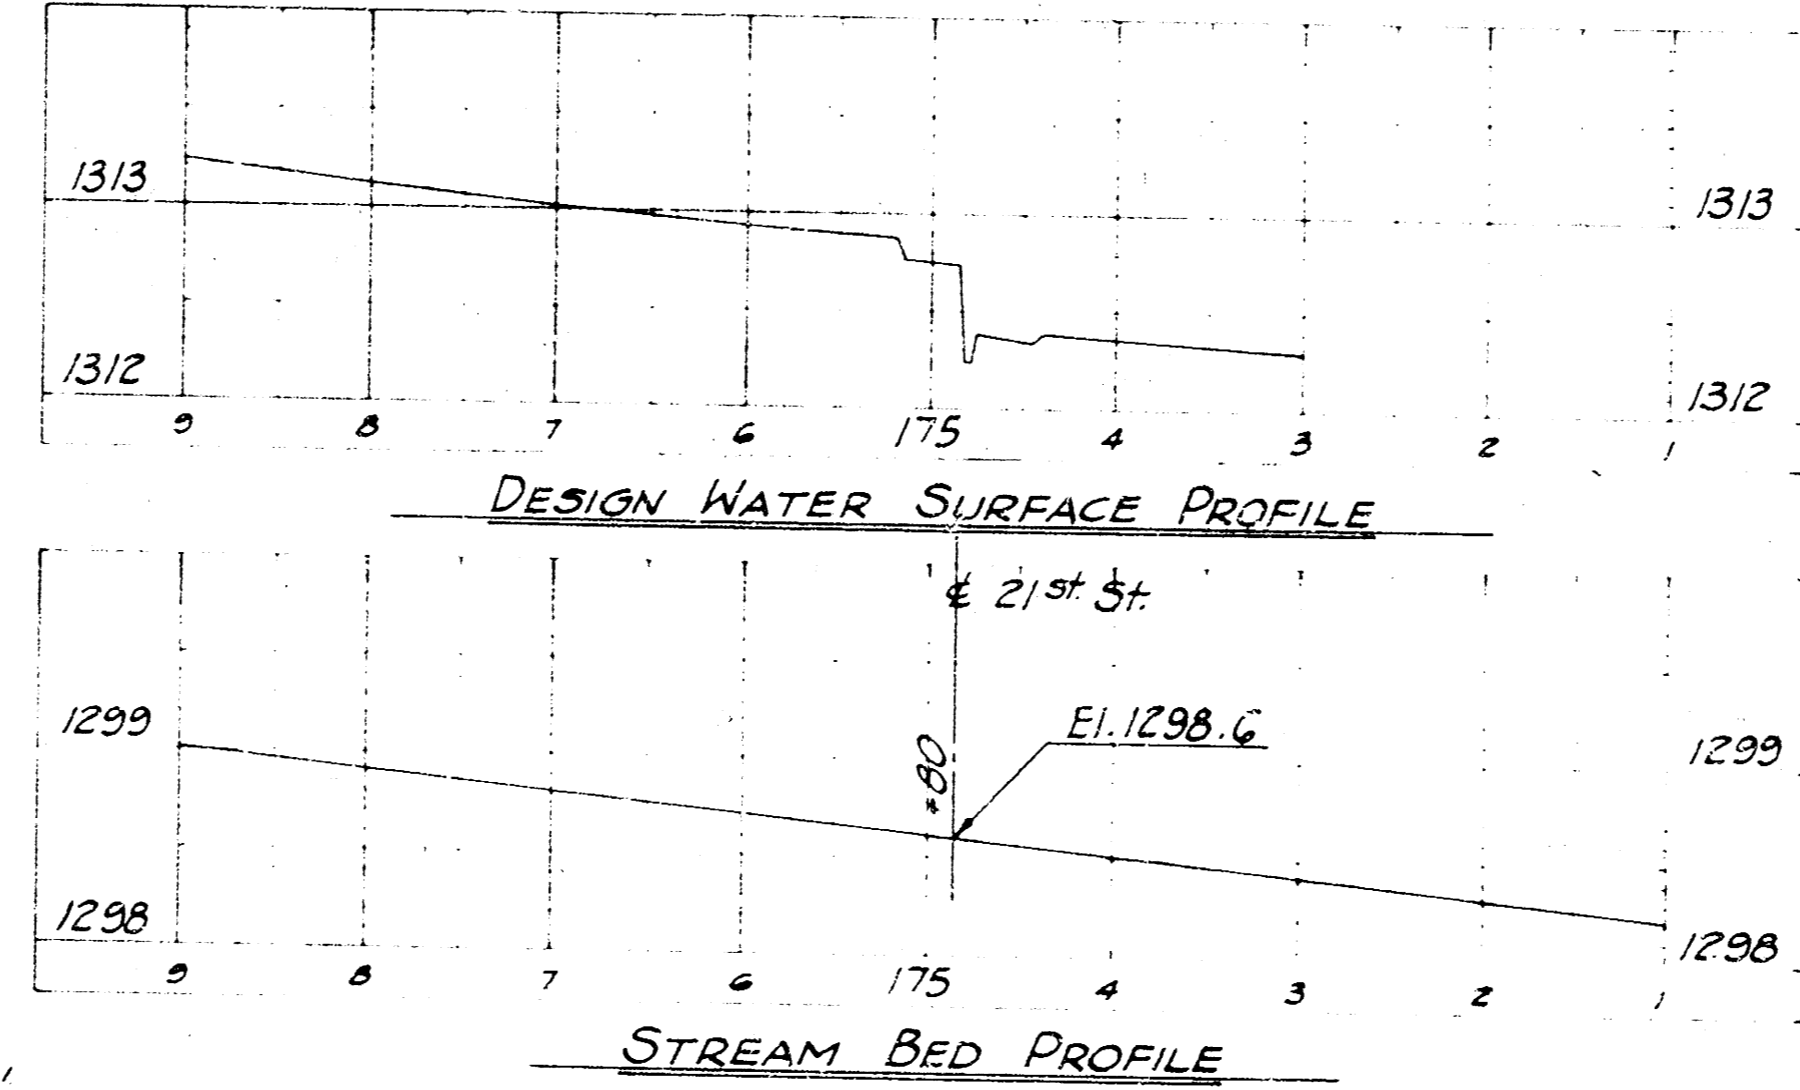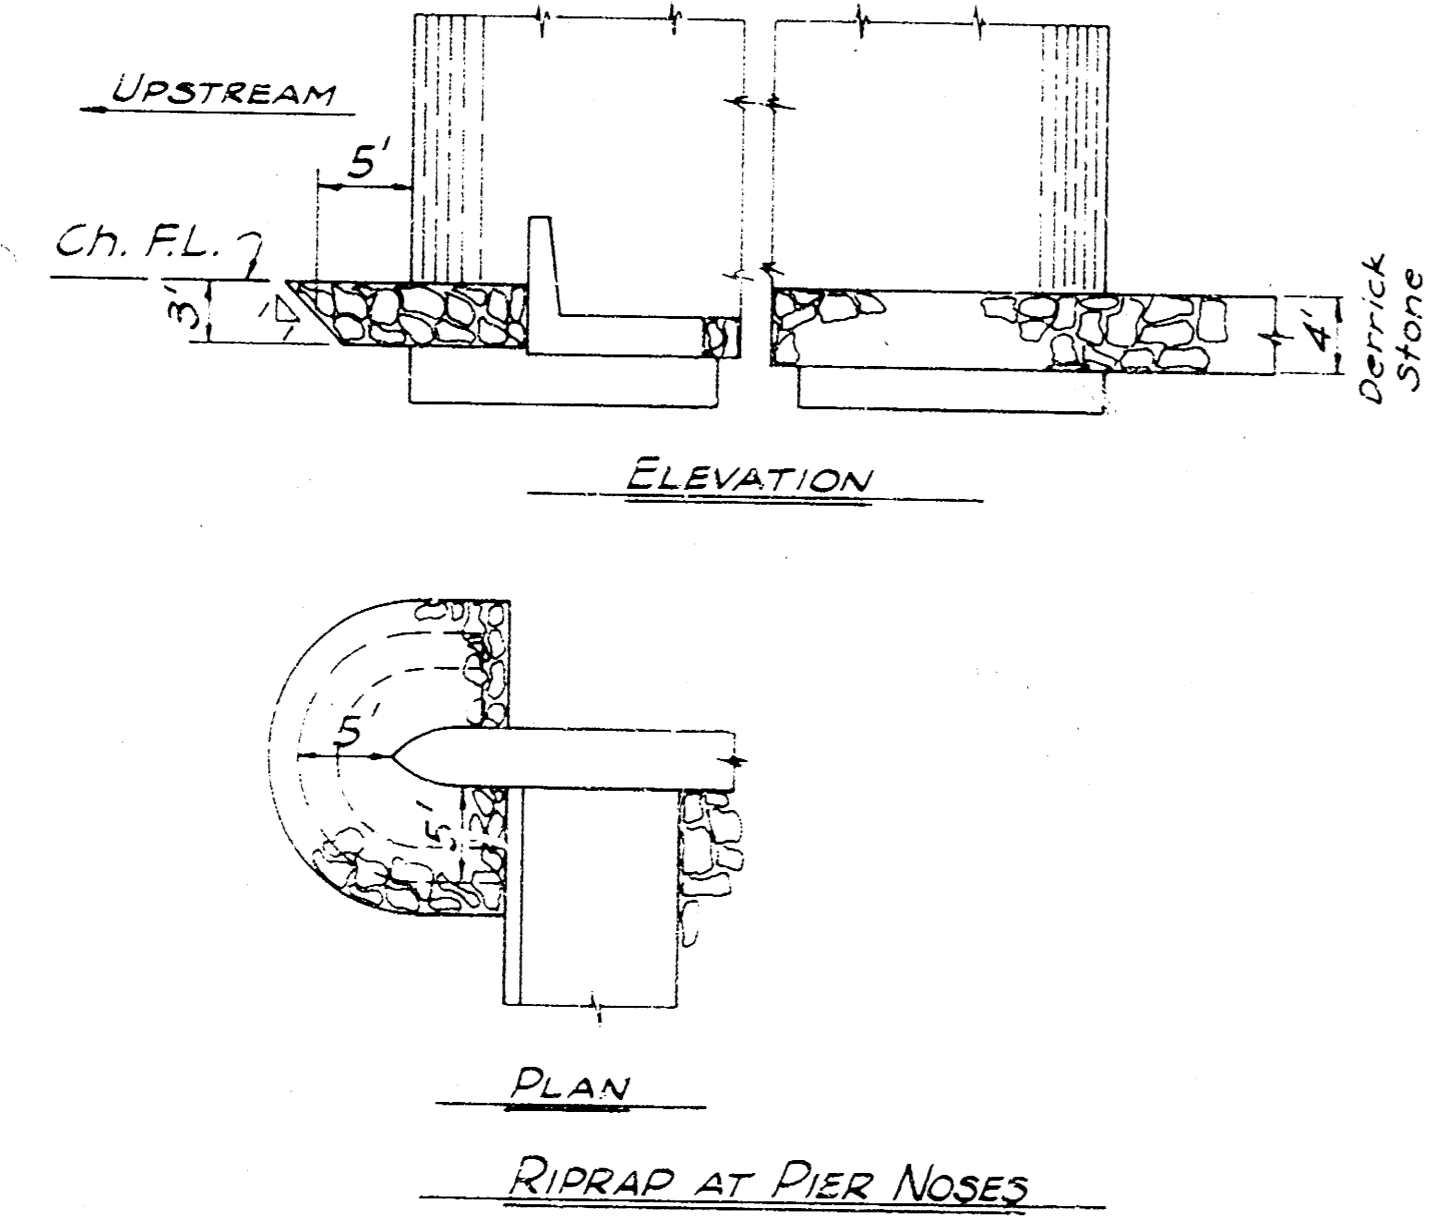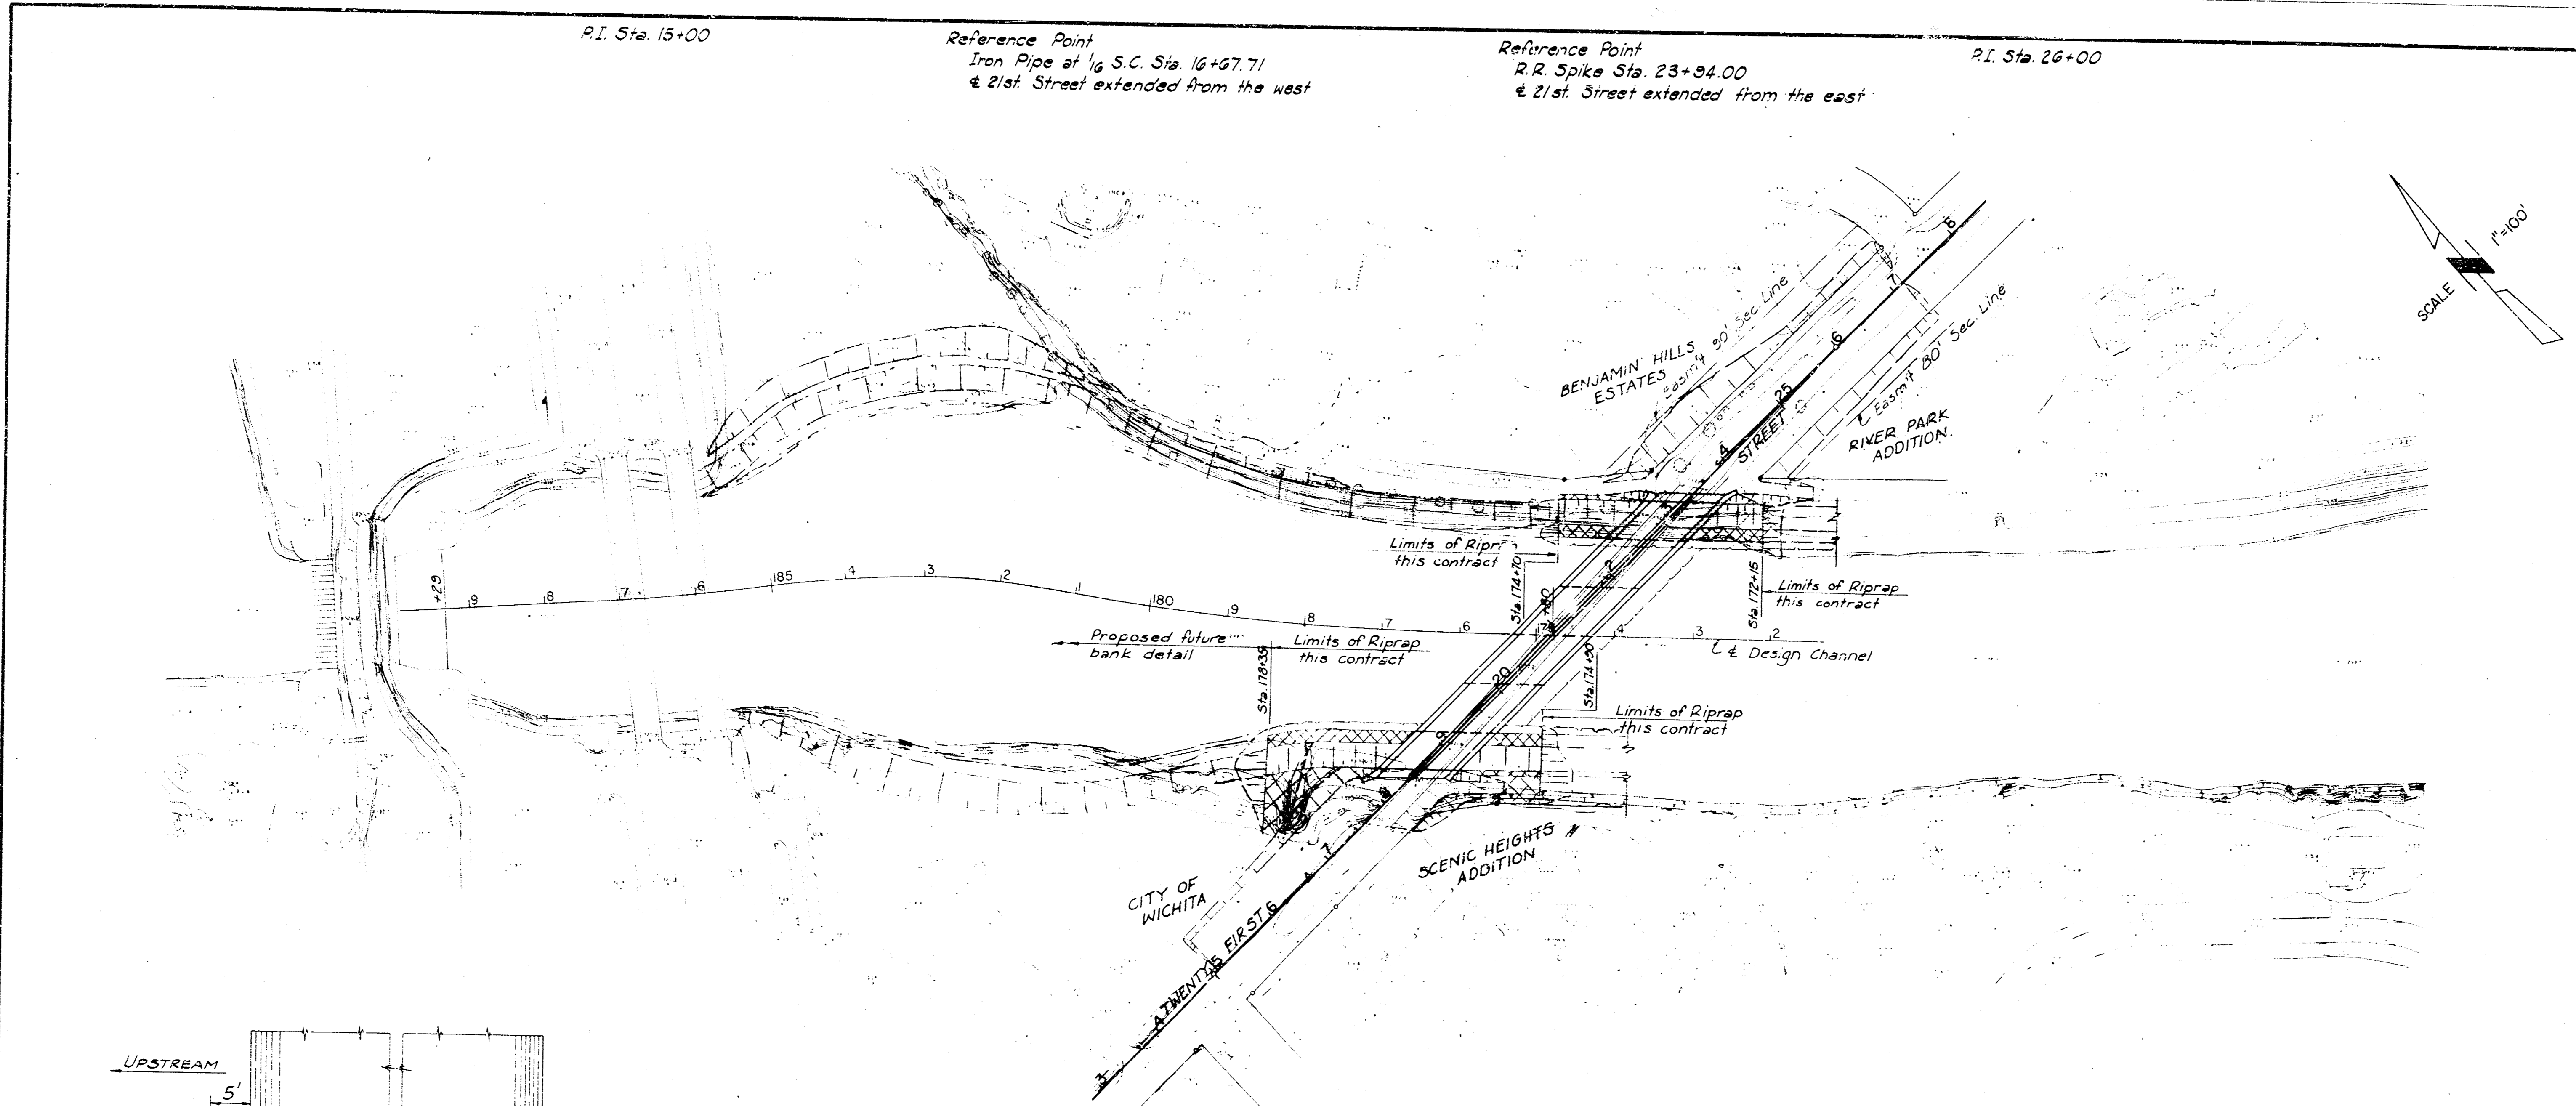


NOTES
 See Sheet 3 for Profile.
 See Sheet 3 and 14 for details of storm sewer extension.
 See Sheet 4 for location of concrete riprap.
 See Sheet 13 for limits and grade on Derrick Stone.


DRAINAGE DATA
 Big Arkansas River design discharge at Twenty-First Street, Wichita-Valley Center Flood Control project, 20,000 c.f.s.

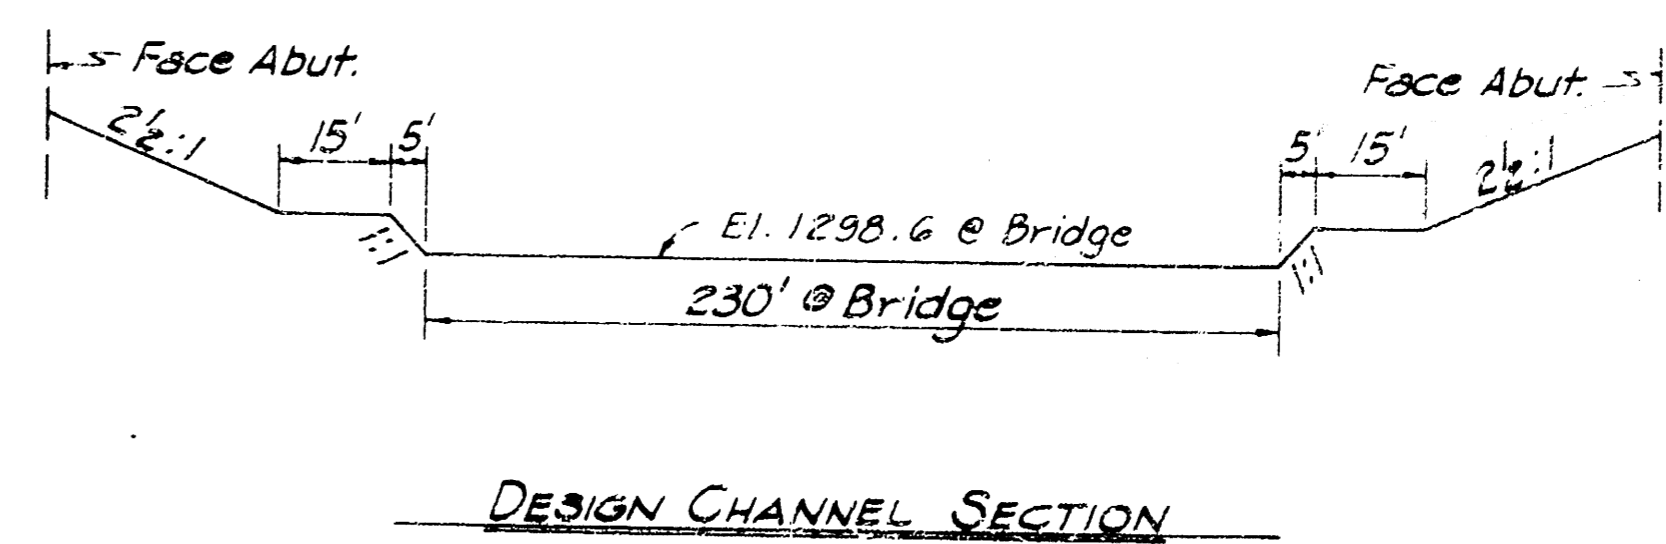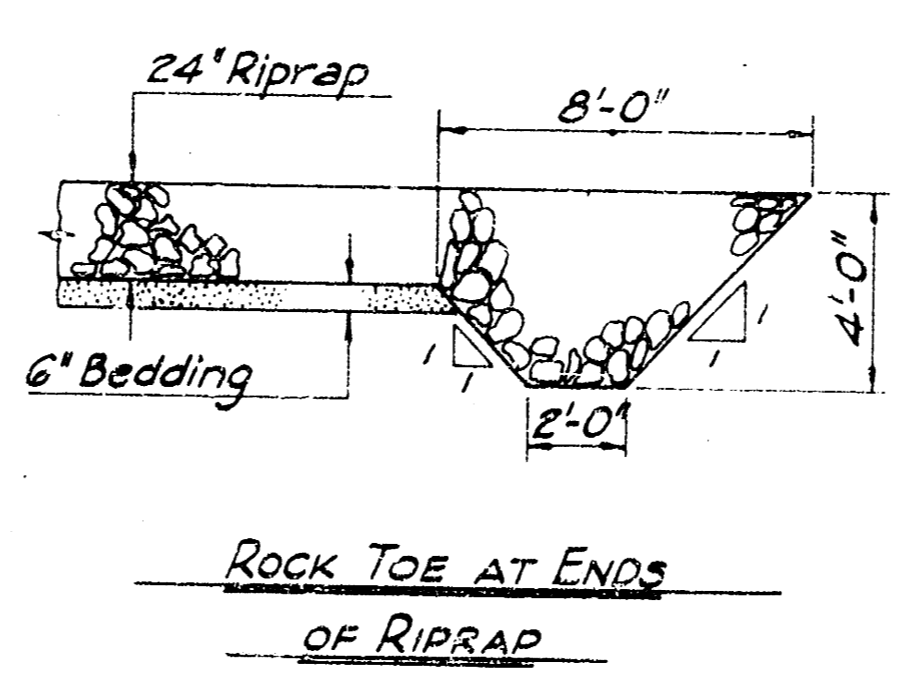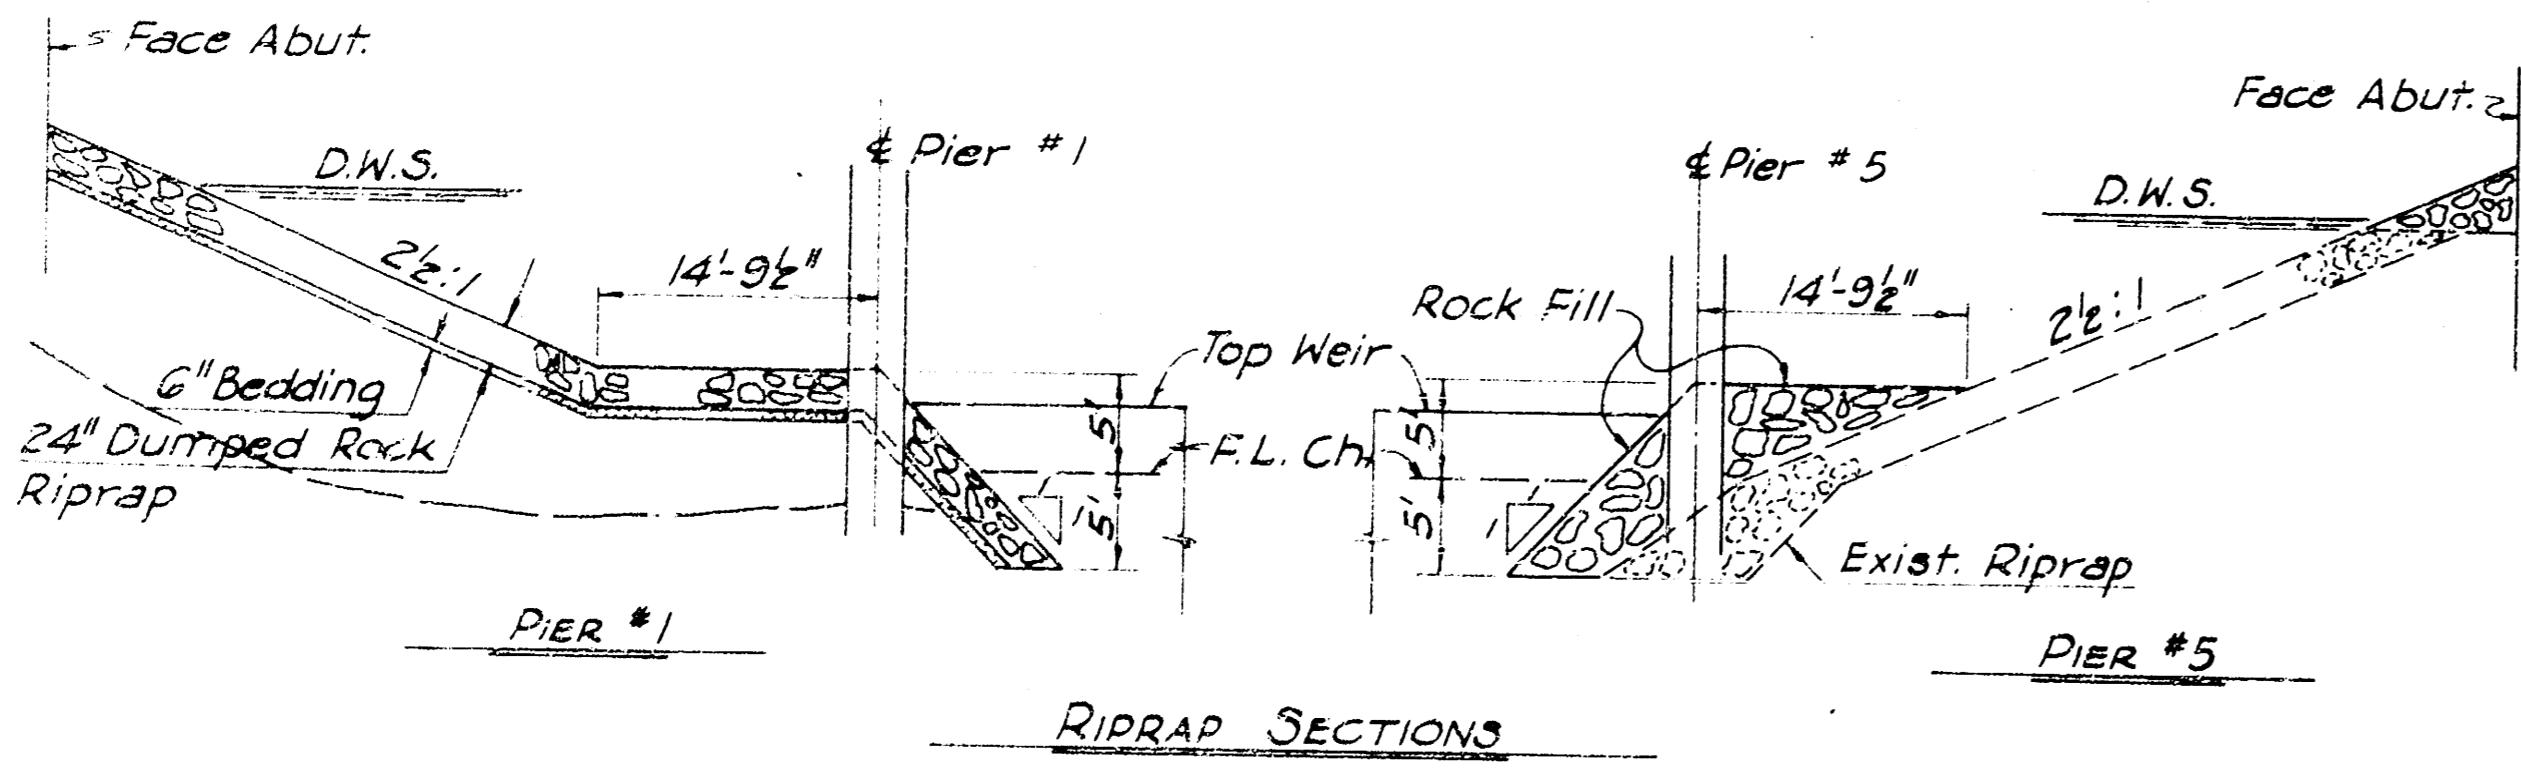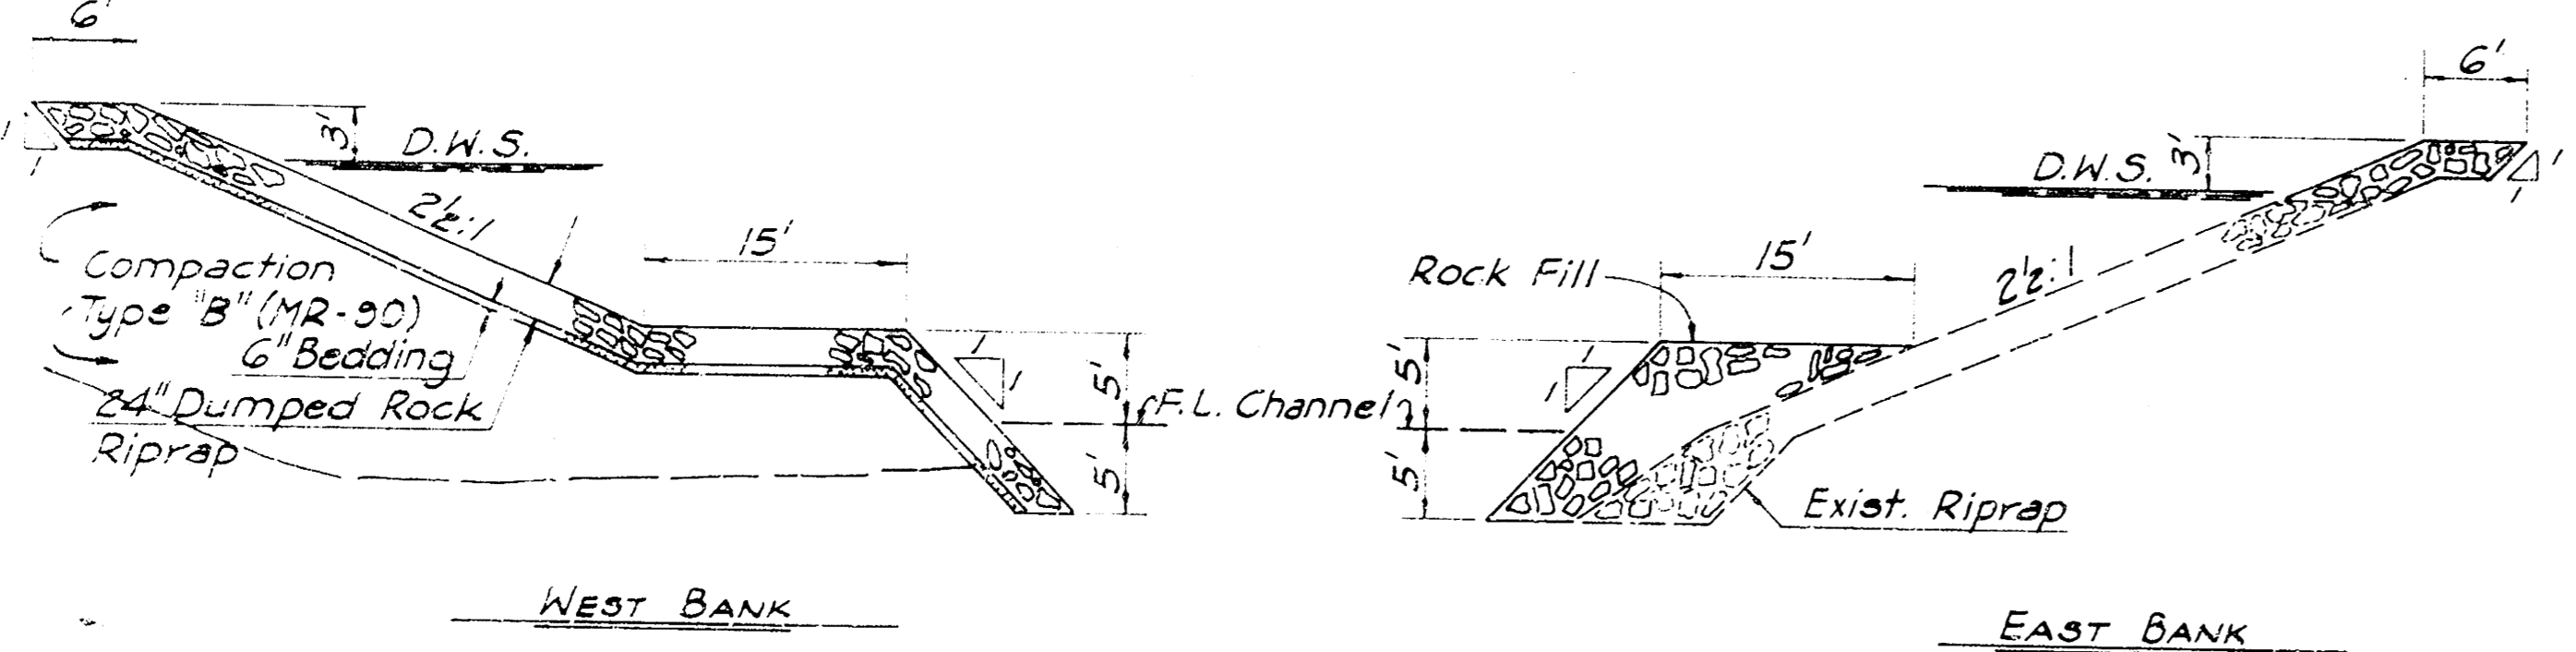

As Built Nov. 1972 C.P.S./K.H.	
CITY OF WICHITA, KANSAS	
B. E. SMITH, P.E., CITY ENGINEER	
TWENTY-FIRST STREET BRIDGE OVER THE BIG ARKANSAS RIVER	
CONTOUR MAP	
R. S. DELAMATER CONSULTING ENGINEER WICHITA, KANSAS	DRAWN BY SCALE DATE

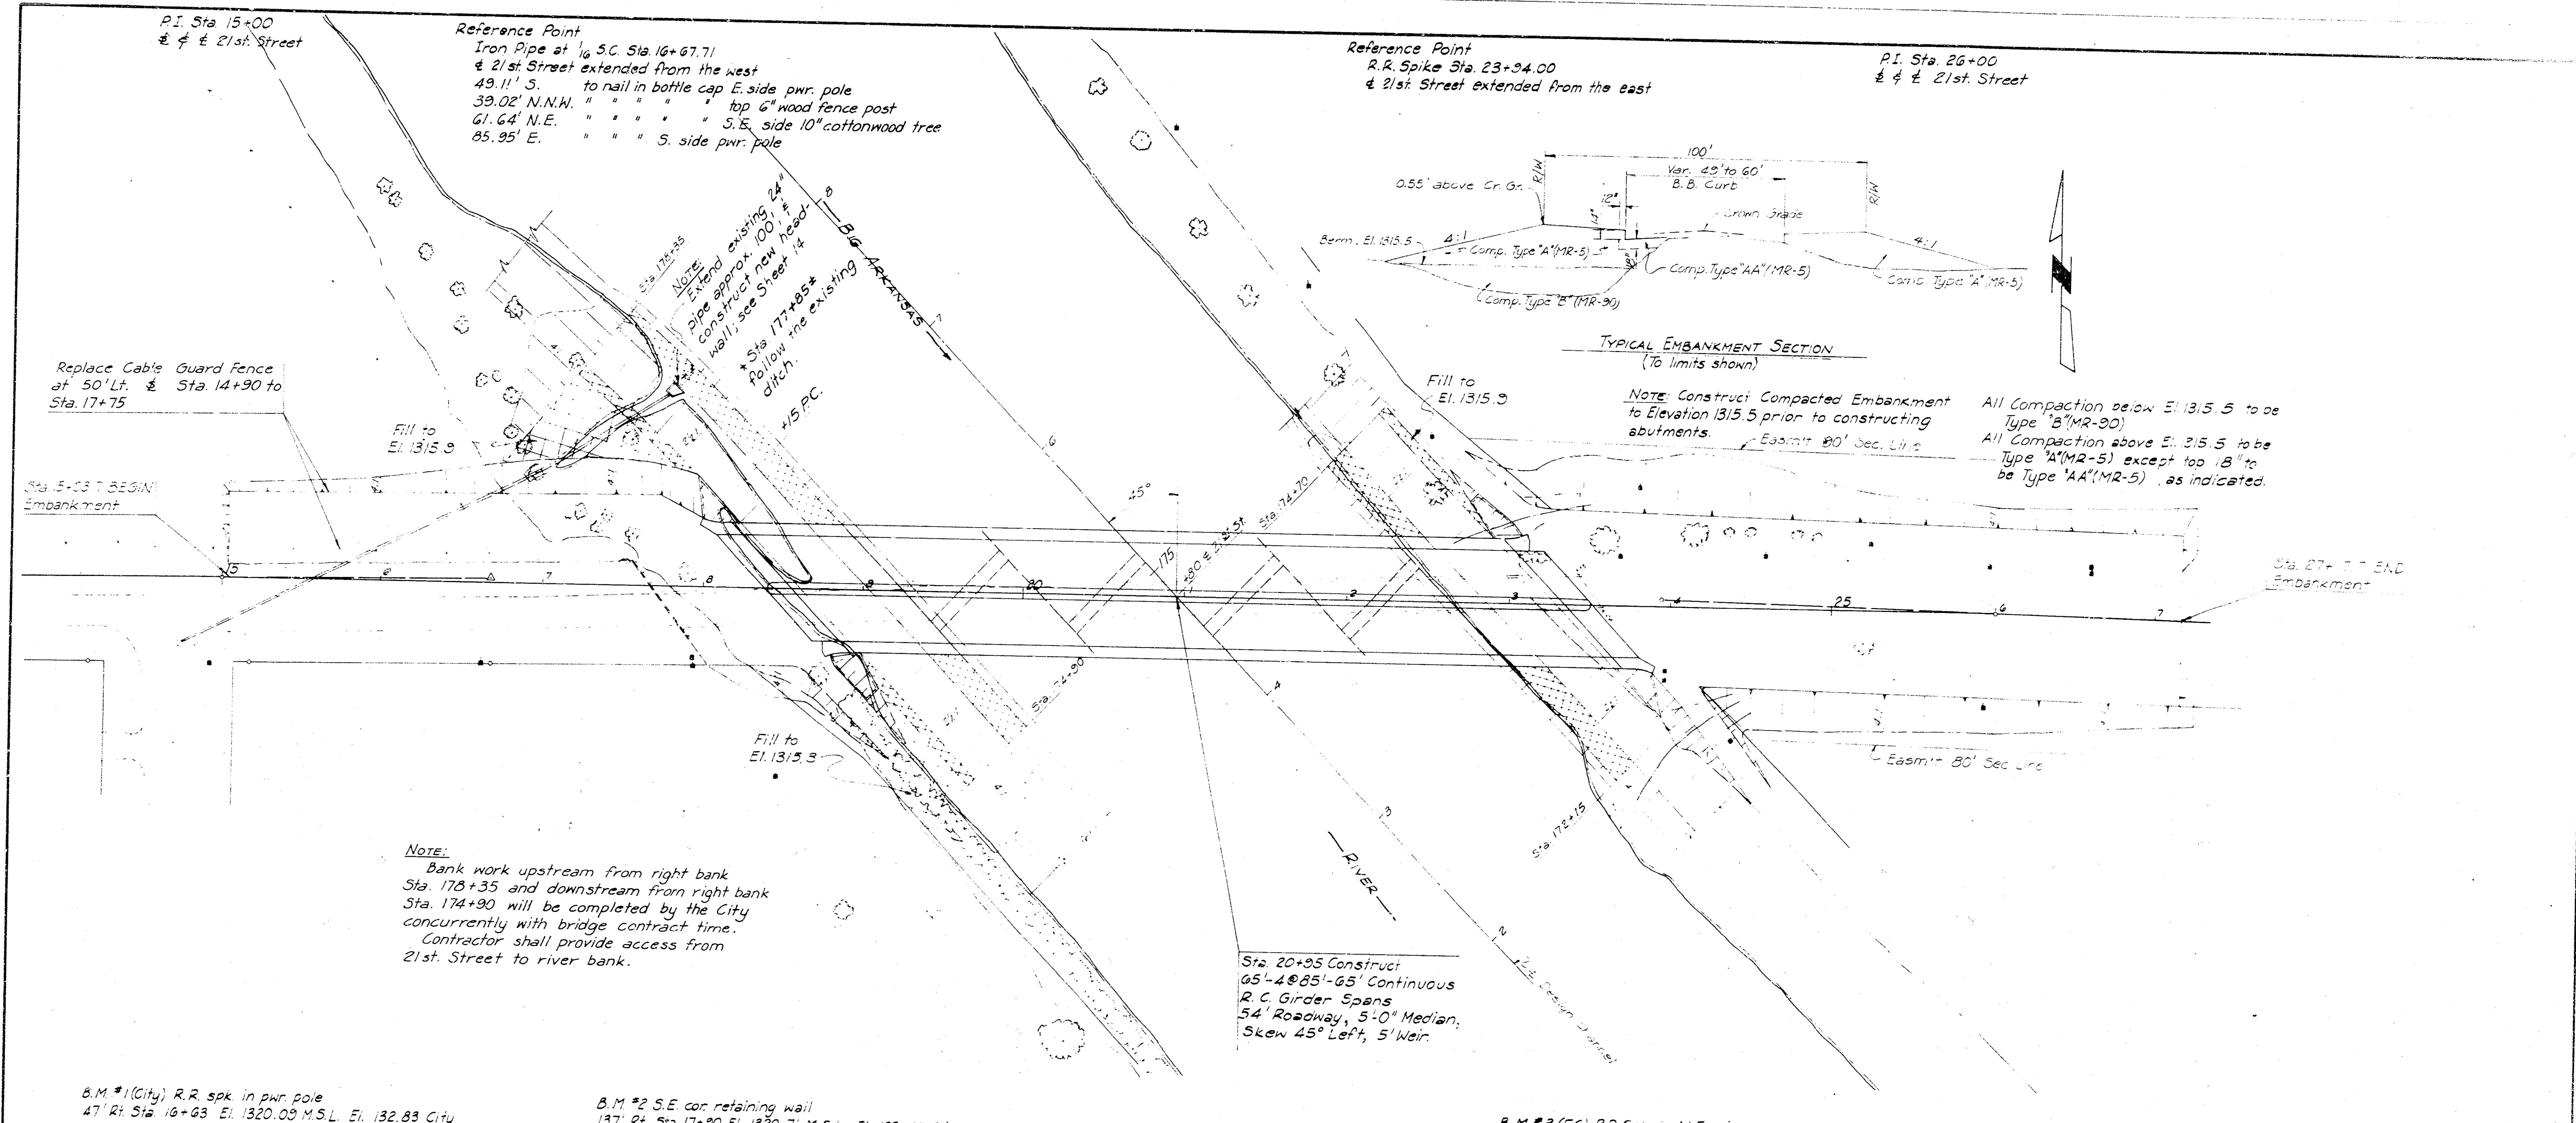


As Built		Nov. 1972		C.P.S. K.H.	
CITY OF WICHITA, KANSAS					
B. E. SMITH, P.E., CITY ENGINEER					
TWENTY-FIRST STREET BRIDGE OVER THE BIG ARKANSAS RIVER					
PLAN - PROFILE					
R. S. DELAMATER		DATE	BY	SCALE	REV.
CONSULTING ENGINEER					
WICHITA, KANSAS					89-F

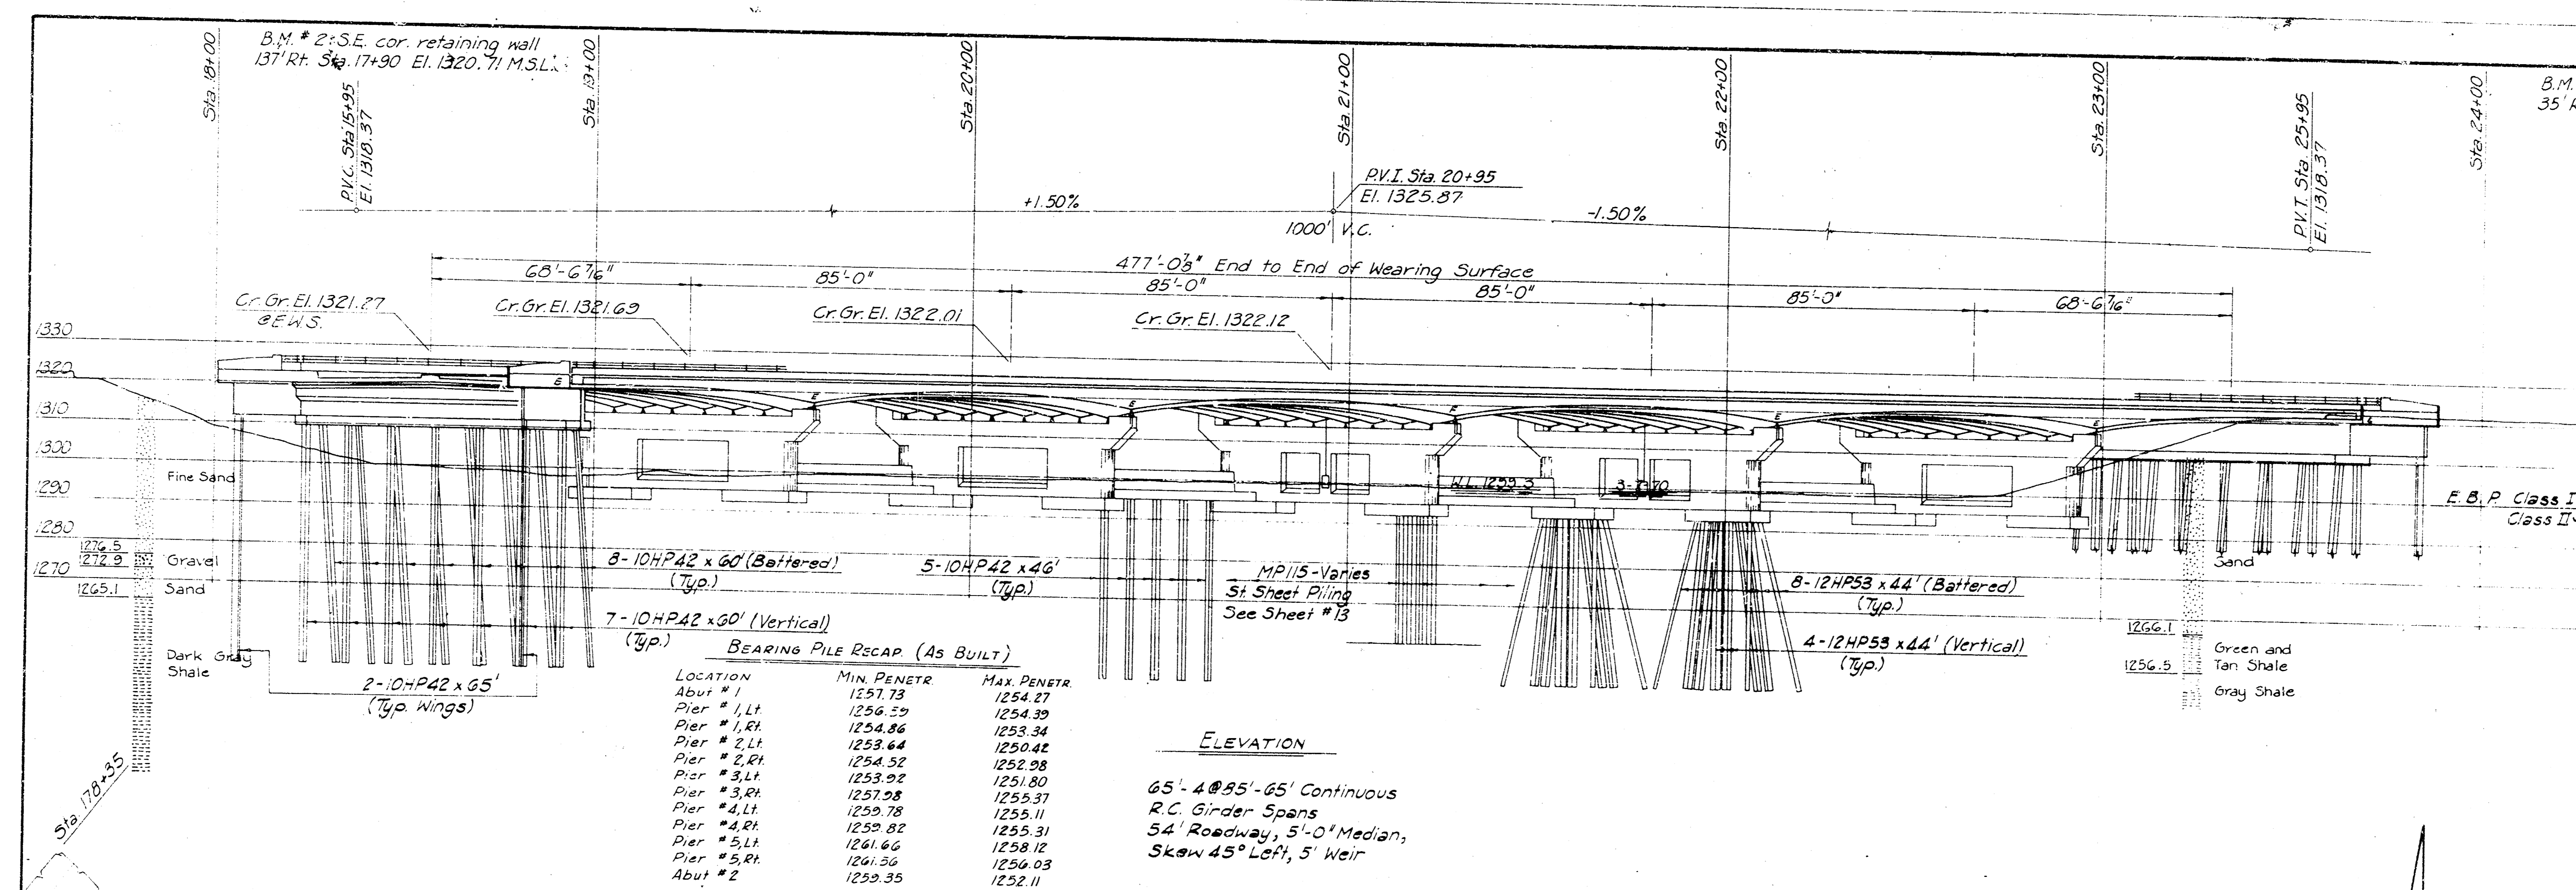

ELEVATION

65'-4" @ 85'-65' Continuous
 R.C. Girder Spans
 54' Roadway, 5'-0" Median,
 Skew 45° Left, 5' Weir

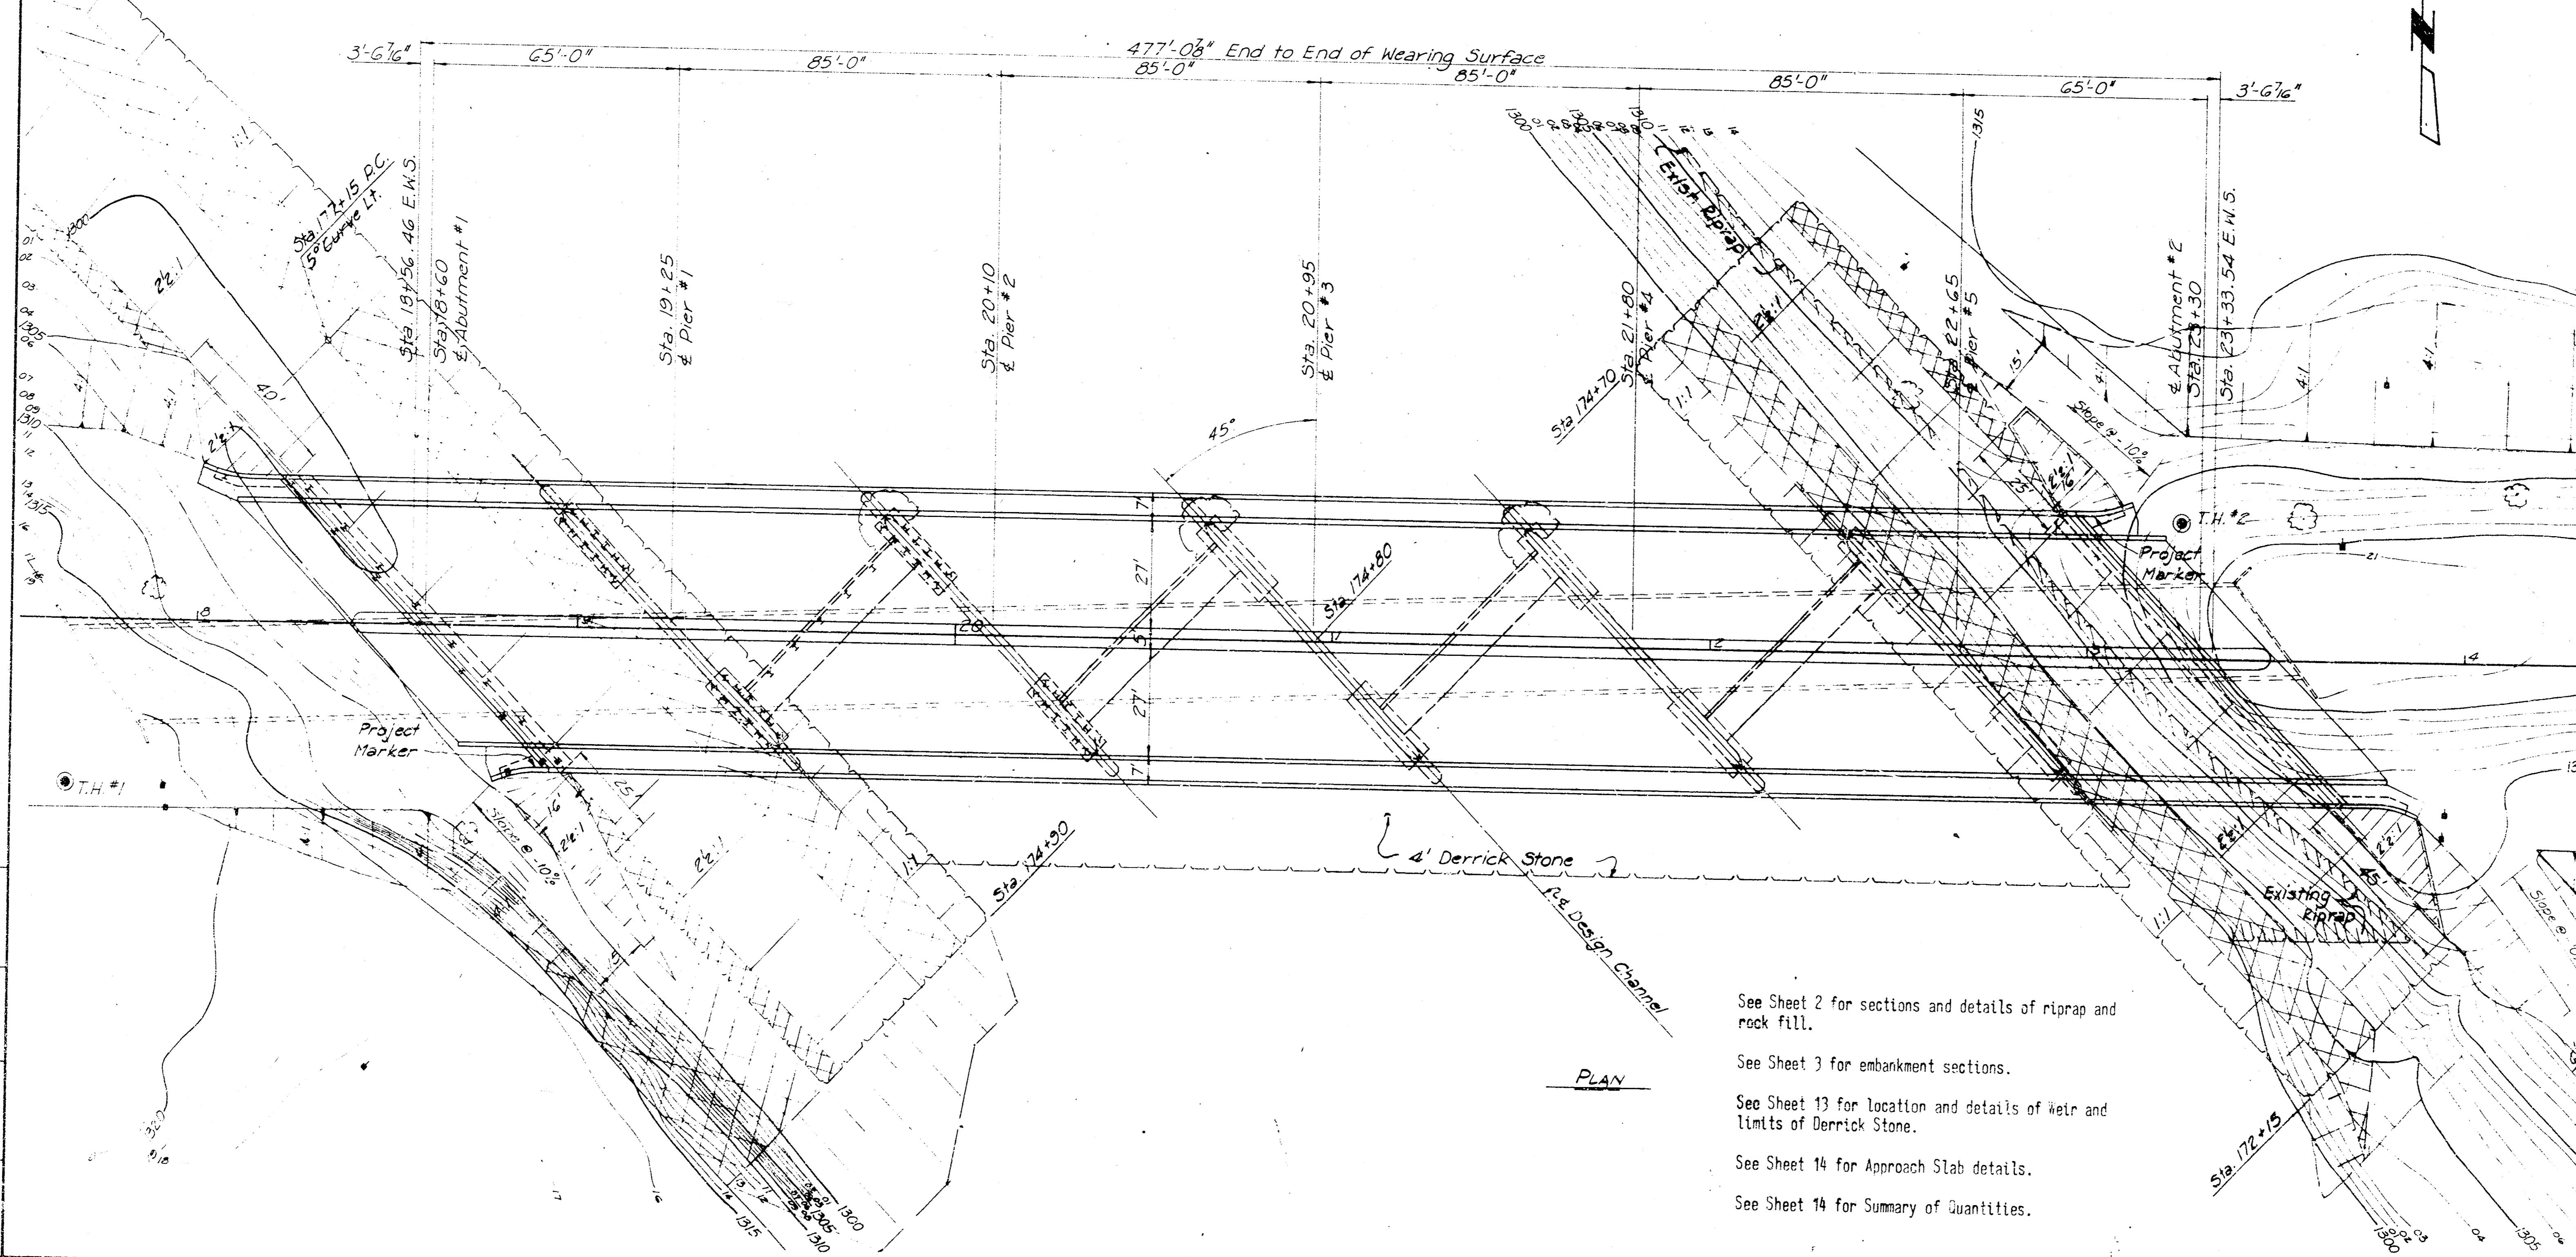

B.M. #4 (City) R.R. spk. in pwr. pole
 35' Rt. Sta. 24+00 El. 1316.78 M.S.L.

GENERAL NOTES

COMMON EXCAVATION: There will be no excavation for Common Excavation, or borrow, or such, unless it will be for material in place, as directed by the Engineer.

EMBANKMENTS: The Contractor shall construct embankments and grade the same to the elevations shown at the abutments as given on the Profile, Sheet No. 3, prior to construction of the bridge.

EXCAVATION: Elevation 1300.0 constitutes the Excavation Boundary Plane for estimating quantities for Class I and Class II Bridge Excavation and Slab Excavation, Class I above, Class II and Slab Excavation below; see Sheet 14 for limits of pay excavation.

SOILINGS: Soil information shown on Sheet 14 is as obtained from borings made in the field and represents the best information available to the City of Wichita.

PILES: All piles shall be driven to the penetration shown unless in the opinion of the Engineer such penetration cannot be secured without injury to the pile. Piles shall be driven to a minimum computed bearing value, for steel bearing piles, of 70 tons per pile in piers, 45 tons per pile in abutments and 30 tons in weir base, and for steel sheet piles, of 15 tons per pile.

PILE DRIVING: All piles shall be driven with a steam or diesel hammer; if a diesel hammer is used, sufficient hammer data shall be provided to permit rating by the Engineer before driving starts.

EXISTING STRUCTURE: The Contractor will remove the existing structure, consisting of a steel beam bridge on wood pile piers. All material to become the property of the Contractor, to be removed from the site.

FALSEWORK AND FORMING: Falsework under superstructure, including each sidewalk slab, shall be left in place in any span until the concrete in that span and the adjacent span constructed latest shall have attained its design strength; but in no case shall the falsework be removed before 14 days after placing concrete. Handrail parapet walls and traffic rails shall be placed before falsework supporting the walk has been removed. See note on Sheet 3 regarding median curb forming. Camber shall be provided in the amounts shown on the Dead-Load Camber Diagram.

CONCRETE: Class AAA(AE) Concrete shall be used in Superstructure, including sidewalks, rails and parapets, and approach slab. Class A Concrete shall be used in abutments, piers and in dam foundation, weir wall, and reinforced concrete riprap.

REINFORCING STEEL: All dimensions shown relative to reinforcing steel placement are to centerline of bars unless otherwise noted. All dimensions shown in bending diagrams are out to out of bars.

DECK TREATMENT: Bridge deck shall be cured with Linseed Oil emulsion, in accordance with the Specifications.

DESIGN:

Design Loading: HS20-44 A.A.S.H.O. Specifications (1960 Ed.)

Unit Stresses: $f_c = 1,600$ p.s.i. (Class AAA(AE))
 $f'_c = 4,000$ p.s.i. (Class AAA(AE))
 $f_c = 1,200$ p.s.i. (Class A)
 $f'_c = 3,000$ p.s.i. (Class A)
 $f_s = 20,000$ p.s.i. (Reinf.)


Pile Loading: 40 tons per pile in piers
 45 tons per pile in abutments
 30 tons per pile in weir
 15 tons per pile for steel piles

As Built Nov. 1972 C.R.S./K.H.
 CITY OF WICHITA, KANSAS
 B. E. SMITH, P.E., CITY ENGINEER
 TWENTY-FIRST STREET BRIDGE OVER
 THE BIG ARKANSAS RIVER
CONSTRUCTION LAYOUT


R. S. DELAMATER
 CONSULTING ENGINEER
 WICHITA, KANSAS

See Sheet 2 for sections and details of riprap and rock fill.
 See Sheet 3 for embankment sections.
 See Sheet 13 for location and details of weir and limits of Derrick Stone.
 See Sheet 14 for Approach Slab details.
 See Sheet 14 for Summary of Quantities.

PLAN

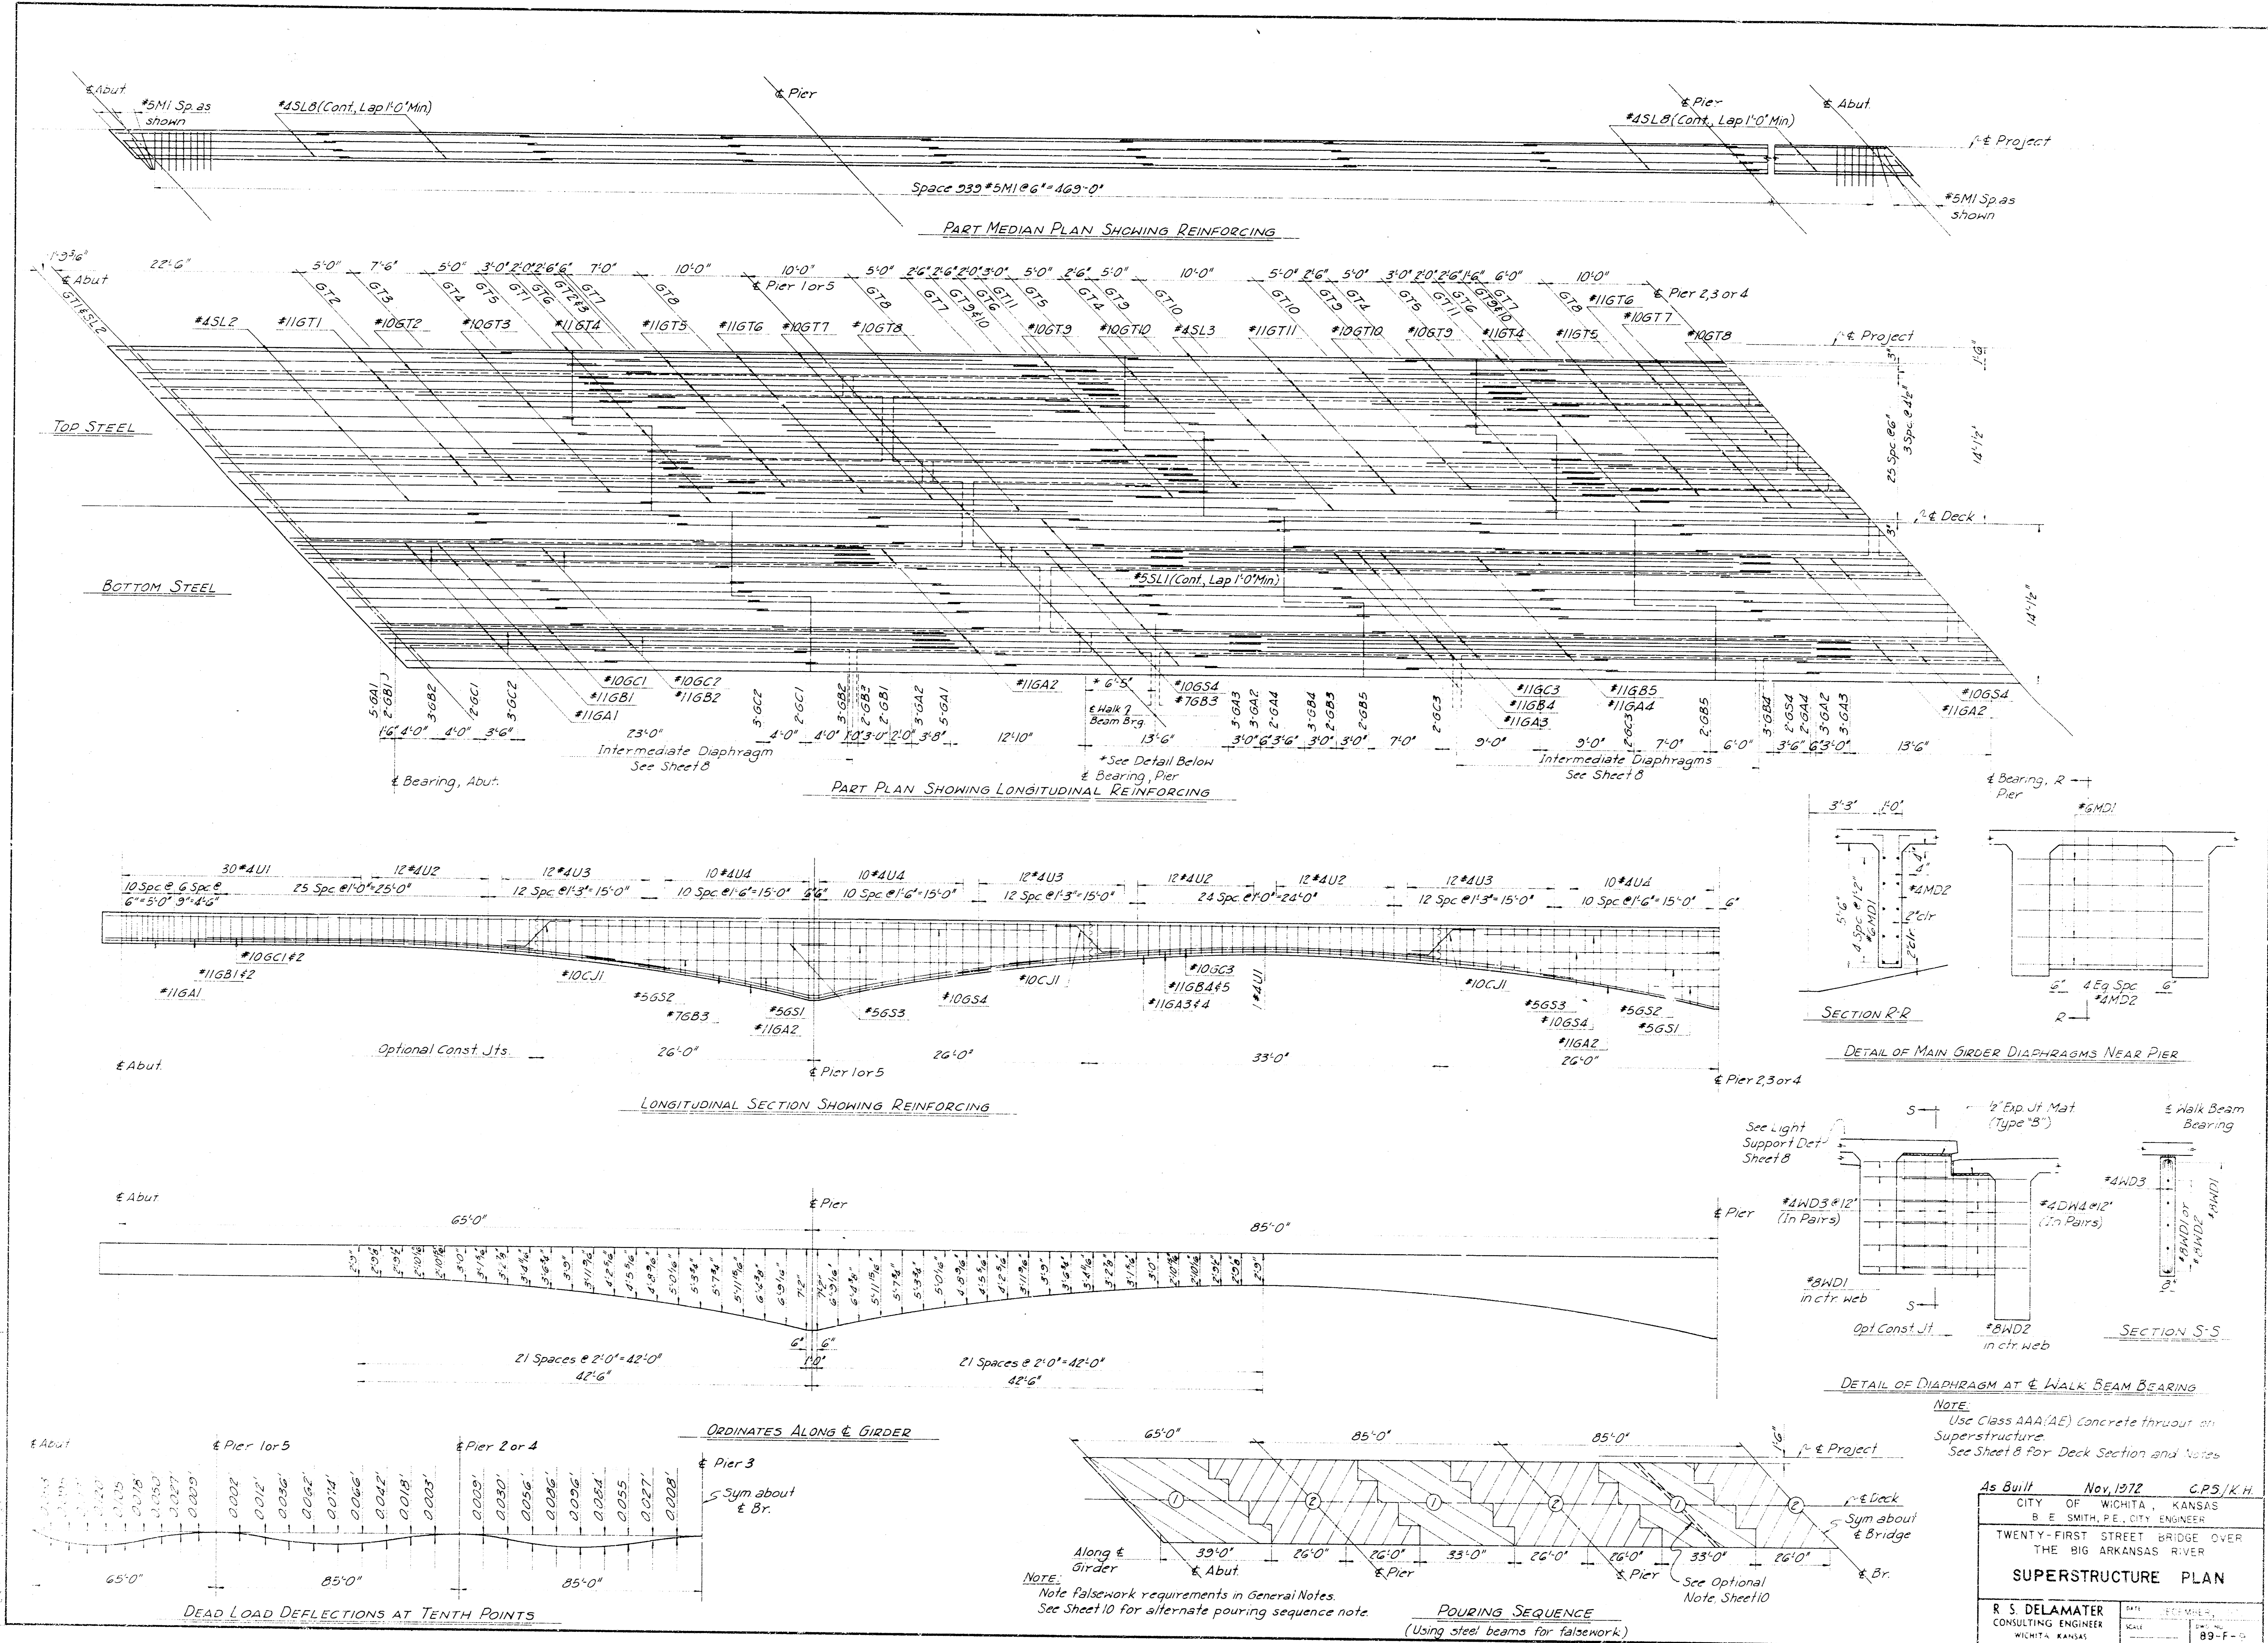

As Built	Nov. 1972	C.P.S./K.H.
CITY OF WICHITA, KANSAS		
B. E. SMITH, P.E., CITY ENGINEER		
TWENTY-FIRST STREET BRIDGE OVER THE BIG ARKANSAS RIVER		
SUPERSTRUCTURE PLAN		
R. S. DELAMATER CONSULTING ENGINEER WICHITA, KANSAS	DATE: 11-1-72 SCALE: AS SHOWN	89-F-0

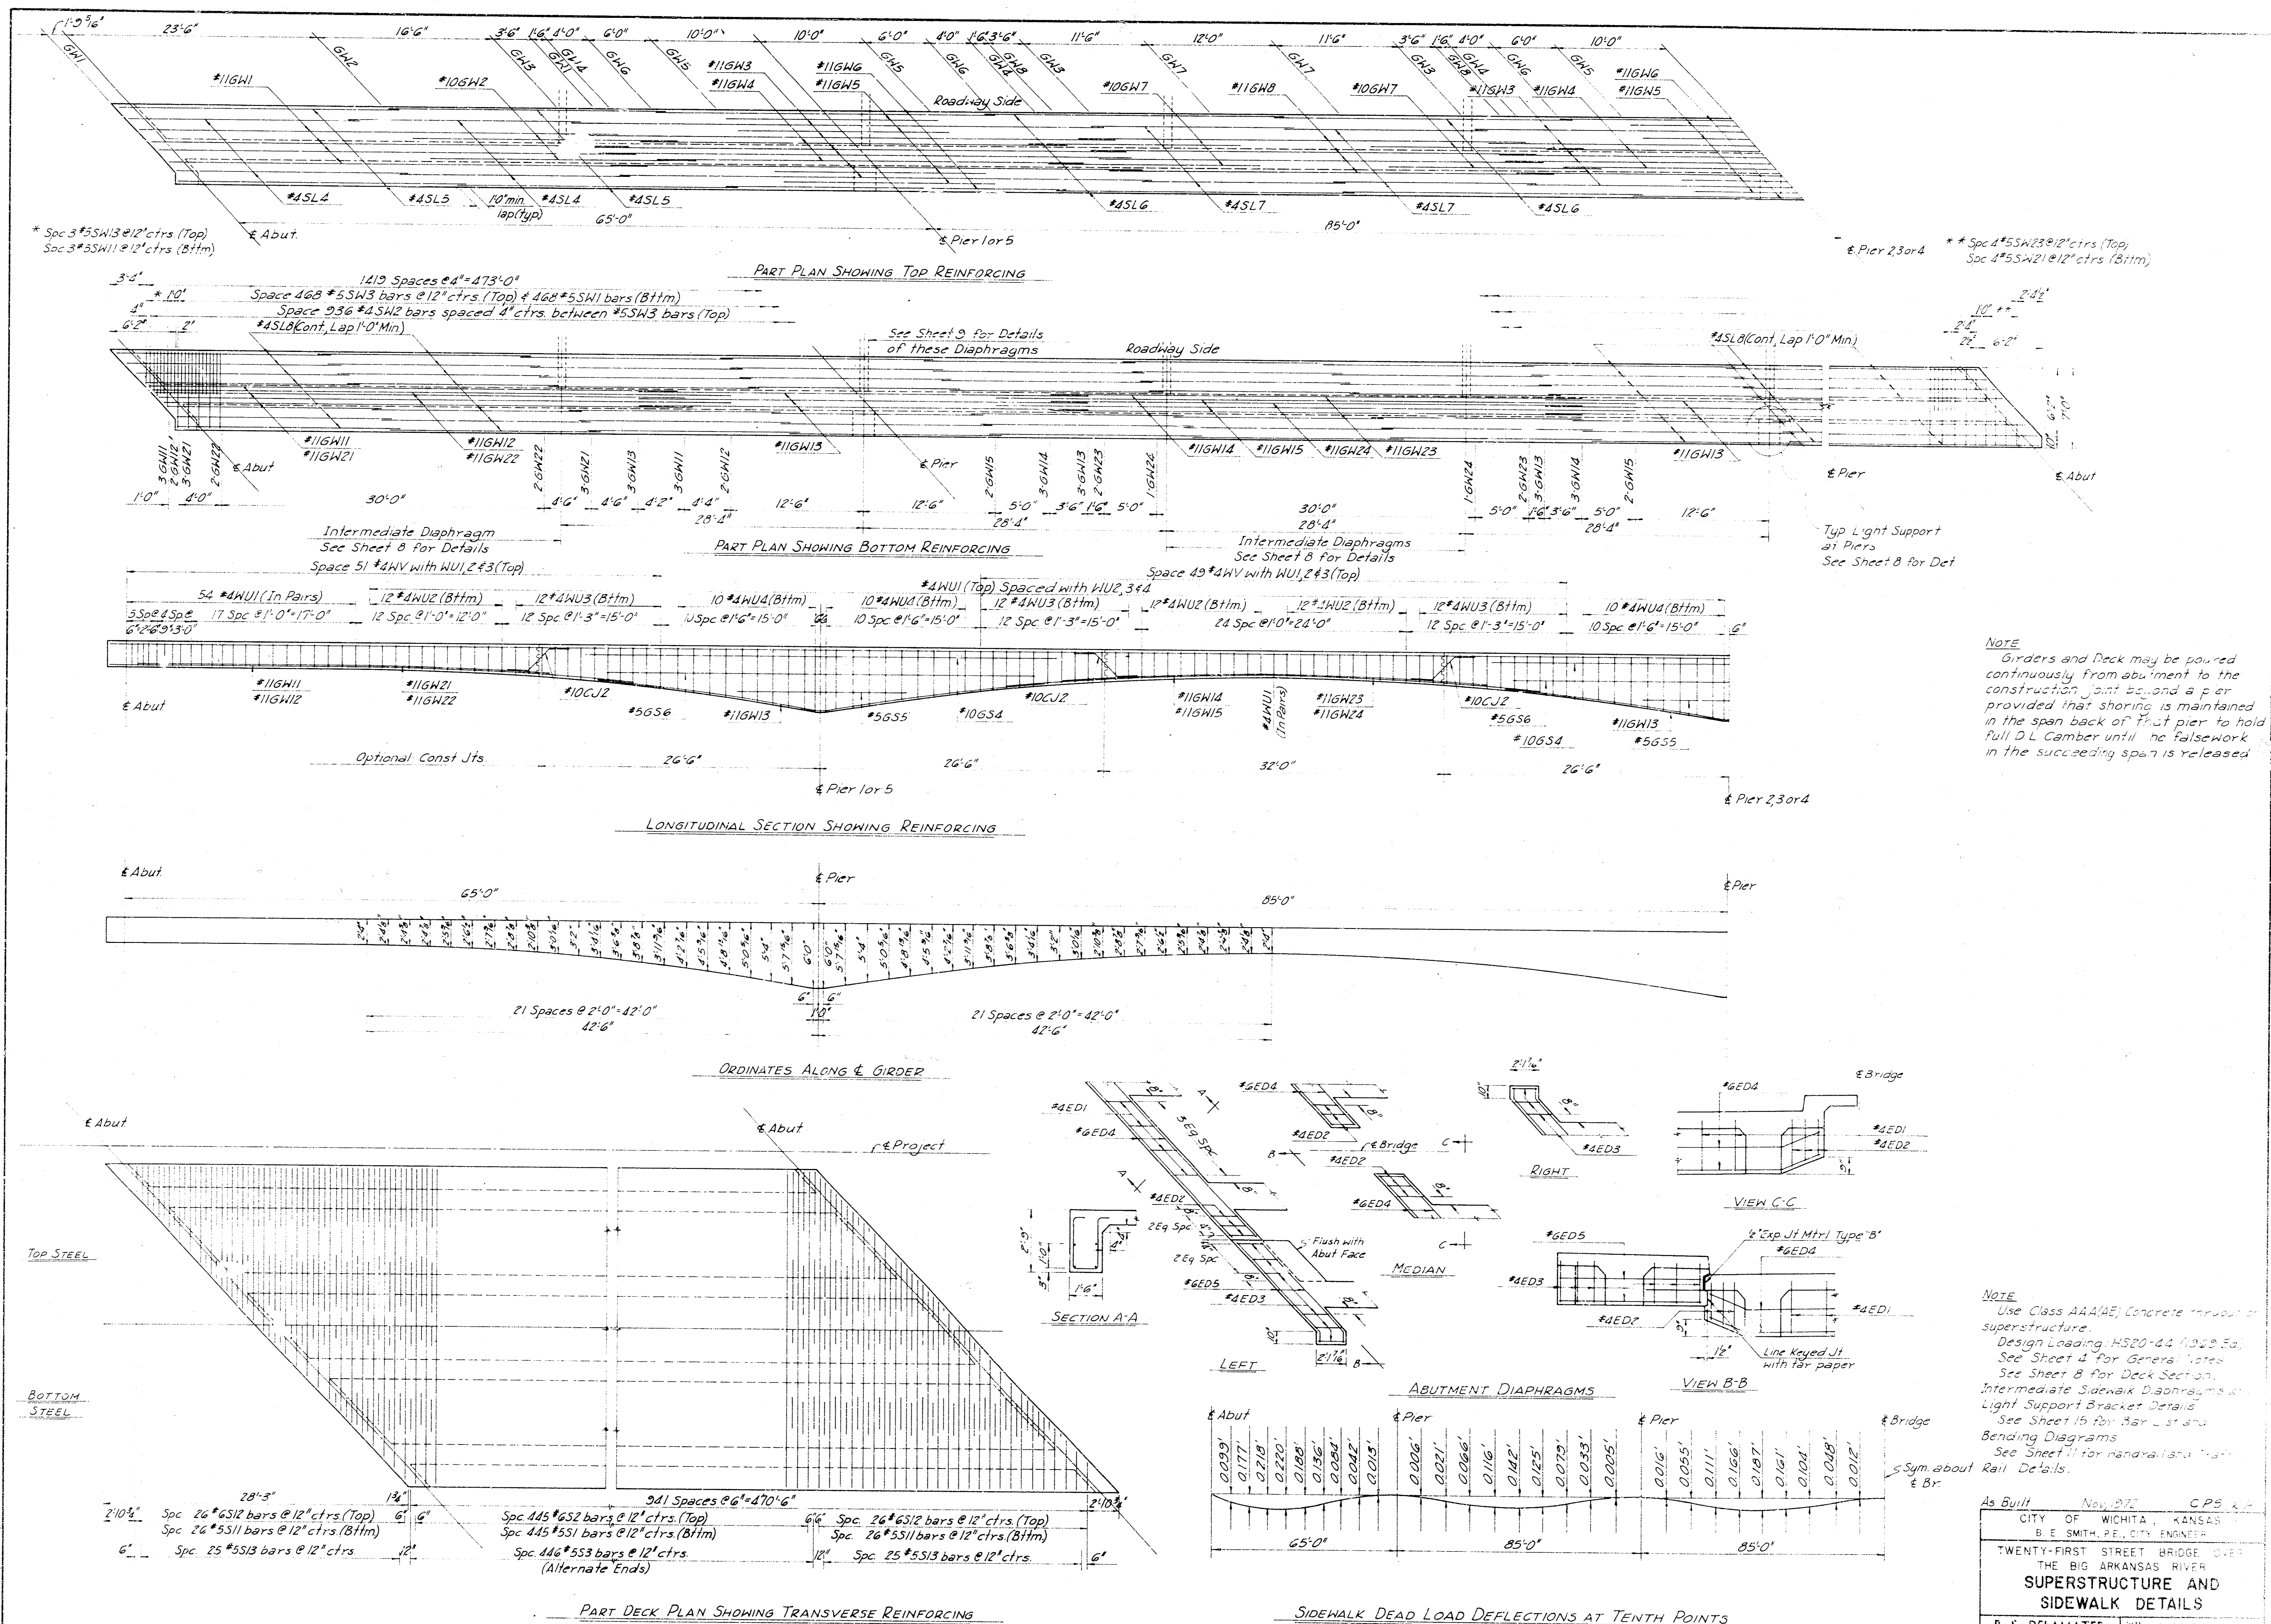

As Built Nov. 1972 CPS 2.7
 CITY OF WICHITA, KANSAS
 B. E. SMITH, P.E., CITY ENGINEER
 TWENTY-FIRST STREET BRIDGE OVER
 THE BIG ARKANSAS RIVER
**SUPERSTRUCTURE AND
 SIDEWALK DETAILS**
 R. S. DELAMATER
 CONSULTING ENGINEER
 WICHITA, KANSAS





SUPERSTRUCTURE					
STRAIGHT BARS			BENT BARS		
Mark	No Req	Size Length	Mark	No Req	Size Length
GA1	80	11 53'-8"	GA2	120	11 33'-8"
GA3	96	11 58'-0"			
GA4	64	11 51'-0"			
GB1	32	11 48'-0"	GB3	32	7 45'-8"
GB2	48	11 58'-6"			
GB4	96	11 44'-0"			
GB5	64	11 32'-0"			
GC1	32	10 30'-6"			
GC2	48	10 23'-0"			
GC3	64	11 18'-0"			
GD1	30	5 12'-0"			
GD2	30	5 32'-0"			
GD3	180	5 30'-0"	CJ1	480	10 8'-0"
GD4	100	10 34'-0"	CJ2	120	10 7'-6"
GD5	20	5 16'-0"			
GD6	20	5 40'-0"	MI	1800	5 5'-0"
GT1	80	11 44'-6"			
GT2	32	10 25'-0"			
GT3	32	10 20'-0"			
GT4	80	11 60'-0"			
GT5	200	11 50'-0"	UI	512	4 7'-6"
GT6	160	11 40'-0"	U2	960	4 ***
GT7	80	10 32'-0"	U3	960	4 ***
GT8	60	10 20'-0"	U4	900	4 ***
GT9	128	10 15'-0"			
GT10	128	10 20'-0"			
GT11	160	11 41'-0"			
GW1	16	11 45'-0"	HU1	912	4 5'-8"
GW2	8	10 25'-0"	HU2	240	4 ***
GW3	60	11 50'-0"	HU3	240	4 ***
GW4	20	11 40'-0"	HU4	200	4 ***
GW5	40	11 20'-0"			
GW6	20	11 32'-0"			
GW7	32	10 20'-0"	HV	596	4 5'-6"
GW8	32	11 42'-0"			
GW11	12	11 49'-8"			
GW12	8	11 52'-0"	GW13	30	11 42'-8"
GW14	24	11 50'-0"			
GW15	16	11 60'-0"			
GW21	12	11 38'-6"			
GW22	8	11 30'-0"			
GW23	16	11 40'-0"			
GW24	8	11 30'-0"			
SW1	936	5 6'-8"	SW3	936	5 7'-3"
SW11	6	5 ***	SW13	6	5 ***
SW21	8	5 ***	SW23	8	5 ***
SI	800	5 28'-0"	S2	800	6 29'-4"
SI1	104	5 ***	S3	800	5 30'-0"
SI2	104	5 ***	SI3	100	5 ***
SL1	1100	5 20'-0"	CR1	736	7 2'-11 1/2"
SL2	32	4 38'-0"	CR2	496	6 2'-4 1/2"
SL3	64	4 27'-0"	CR11	52	7 3'-6"
SL4	16	4 22'-0"			
SL5	16	4 26'-6"			
SL6	32	4 28'-0"	CR12	52	6 2'-11"
SL7	32	4 19'-0"	CR23	8	7 18'-2"
SL8	550	4 20'-0"	CR24	8	6 17'-2"
CR12	52	6 2'-11"	CR25	8	7 18'-2"
CR13	232	7 7'-9"	CR26	8	7 18'-2"
CR14	232	6 7'-9"	CR27	8	7 18'-2"
CR23	8	7 18'-2"	CR28	8	6 17'-2"
CR24	8	6 17'-2"			
AR1	24	4 4'-4"	VR1	338	4 6'-0"
AR2	112	4 4'-0"	VR2	666	4 4'-6"
AR3	24	4 15'-8"			
AR4	8	4 6'-0"			
AR5	20	4 2'-9"			
HR13	8	4 9'-8"	LB	60	5 4'-3"
HR23	32	4 7'-11"			
HR33	52	4 8'-11"	SU	90	4 ***
HR43	32	4 8'-10"			
WD1	140	8 4'-0"	WD3	60	4 5'-8"
WD2	50	8 6'-0"	WD4	40	4 5'-0"
MD1	300	6 7'-0"	MD2	150	4 15'-4"
			ED1	48	4 7'-4"
			ED2	24	4 ***
			ED3	24	4 6'-6"
			ED4	16	6 30'-10"
			ED5	16	6 9'-2"
SD1	80	8 3'-6"	SD2	80	6 4'-0"
			SD3	40	4 6'-6"
			SD4	50	6 5'-0"
			SD5	40	4 8'-3"

ABUTMENT (ONE)					
STRAIGHT BARS			BENT BARS		
Mark	No Req	Size Length	Mark	No Req	Size Length
AH1	54	7 37'-0"	AH11	5	6 ***
AH2	39	6 36'-0"	AH13	4	4 11'-0"
AH3	6	4 30'-0"	AH21	5	6 ***
AH4	21	4 32'-0"	AH23	2	4 5'-6"
			AU1	36	4 10'-0"
			AU2	36	4 8'-6"
			AU3	101	5 6'-11"
			AU4	13	4 15'-8"
			AU5	13	4 5'-2"
			AU6	5	4 ***
			AU7	5	4 ***
			AU8	8	5 6'-0"
			AU13	11	4 ***
			AU15	11	4 ***
AV1	202	6 4'-6"	AV4	78	6 6'-6"
AV2	172	5 5'-6"	AV6	28	5 4'-0"
AV3	28	5 5'-0"	AV14	23	6 7'-2"
AV5	23	5 4'-6"	AB1	102	5 8'-6"
AV12	30	5 6'-9"			
AV13	10	5 5'-9"			
			AF1	2	5 9'-11"
			AF2	2	5 11'-6"
			AW1	7	6 21'-6"
			AW2	7	6 25'-5"
			AW3	1	4 17'-6"
			AW4	7	5 20'-8"
			AW5	3	5 4'-0"
			AW11	7	6 17'-7"
			AW12	7	6 4'-3"
			AW13	1	4 12'-6"
			AW14	7	5 15'-8"
			AW15	3	5 4'-0"

PIERS 2, 3 & 4 (ONE PIER)					
STRAIGHT BARS			BENT BARS		
Mark	No Req	Size Length	Mark	No Req	Size Length
PC1	878	8 17'-6"	PU1	8	5 6'-6"
PC2	14	8 10'-6"	PU2	8	5 8'-0"
PC3	8	8 15'-6"	PU3	42	5 16'-0"
PC4	8	5 3'-9"	PU4	8	5 ***
PC5	8	5 2'-6"	PU5	14	5 ***
PC6	8	5 9'-6"	PU6	104	5 6'-9"
PC7	864	5 20'-0"	PU7	10	4 4'-0"
			PC8	24	5 11'-8"
			PC9	20	5 8'-0"
PH1	6	10 43'-0"	PH6	16	10 2'-0"
PH2	24	6 36'-0"	PH7	16	11 25'-6"
PH3	5	11 43'-0"	PH8	12	9 15'-9"
PH4	10	5 33'-0"	PH9	16	5 12'-0"
PH5	6	11 54'-0"	PH10	4	5 12'-0"
PH6	16	5 33'-0"	PH11	4	5 11'-0"
PH7	16	11 25'-6"			
PH8	12	9 15'-9"			
PH9	16	5 12'-0"			
PH10	4	5 12'-0"			
PH11	4	5 11'-0"			
PF2	28	5 23'-6"	PF1	76	6 11'-0"
PV2	64	6 13'-6"	PV1	64	5 6'-3"
PV3*	8	4 6'-6"	AB1*	26	5 4'-6"
AV5*	7	5 4'-6"			

APPROACH SLAB (ONE)					
STRAIGHT BARS			BENT BARS		
Mark	No Req	Size Length	Mark	No Req	Size Length
AS1	12	8 16'-6"	C1	34	4 3'-3"
AS2	86	8 11'-8"	C2	31	4 2'-7"
AS3	18	5 40'-9"			
AS12	36	9 ***			
AS13	3	5 ***			
AS22	4	8 2'-2"			
AS23	5	5 ***			
AS32	6	8 ***			
AX2	12	8 45'-0"	AX1	86	4 7'-8"
CT1	4	6 16'-6"	CT2	1	6 17'-6"
			CT3	1	6 16'-4"

WEIR (EACH)					
STRAIGHT BARS			BENT BARS		
Mark	No Req	Size Length	Mark	No Req	Size Length
WL2	20	9 7'-0"	WT1	57	5 11'-3"
WL11	6	9 40'-0"	WT2	57	5 11'-1"
WL12	12	9 15'-6"	WT3	30	4 6'-9"
WL21	26	5 40'-0"			
WL22	52	5 11'-0"	WV1	57	8 10'-0"
WPT	10	8 2'-0"	WVP	57	5 9'-3"

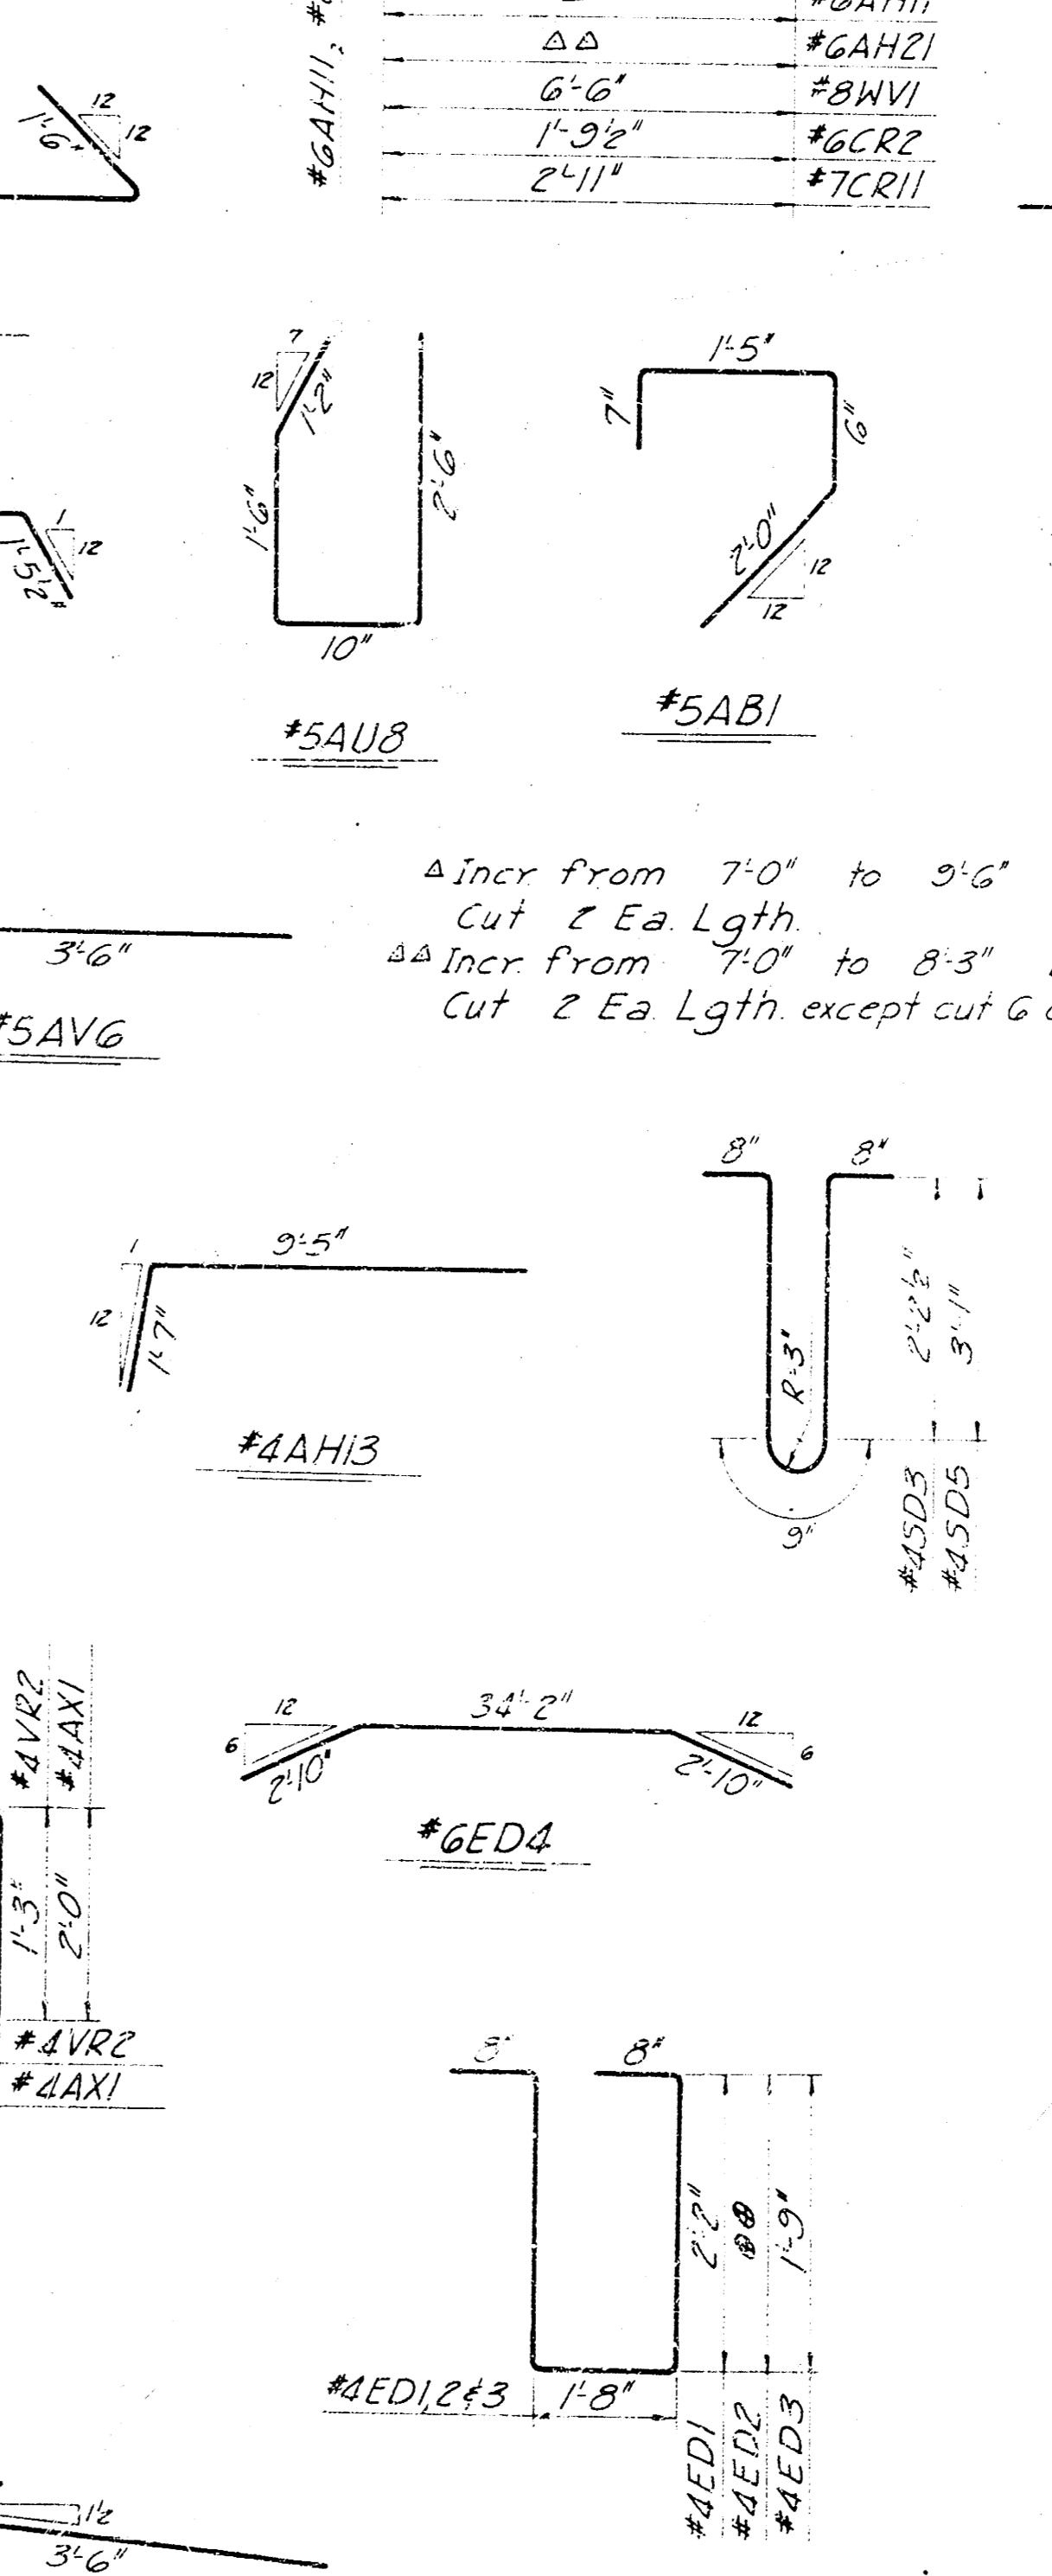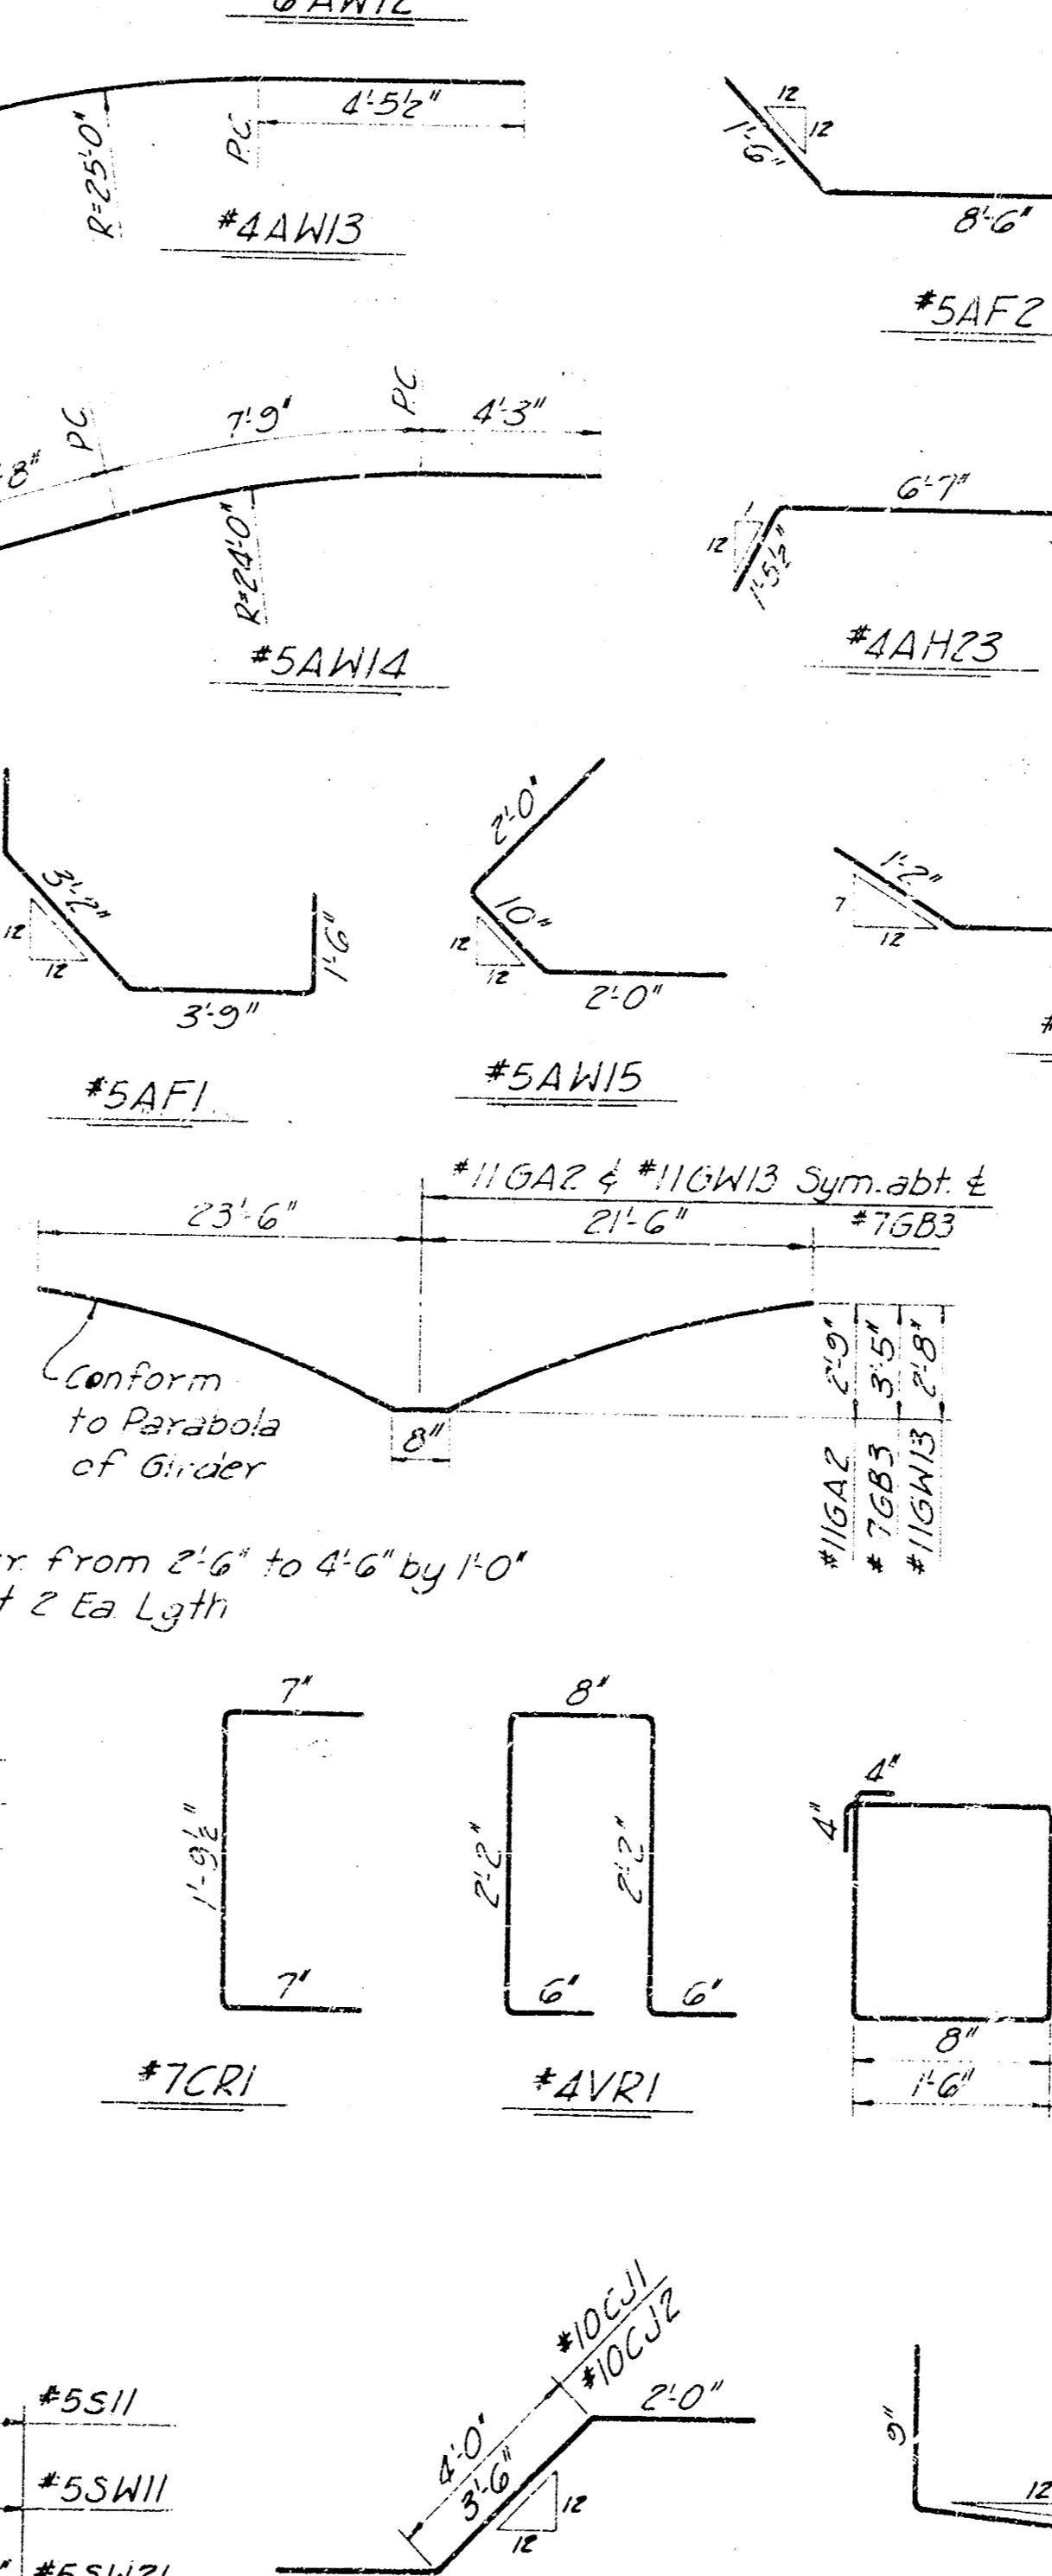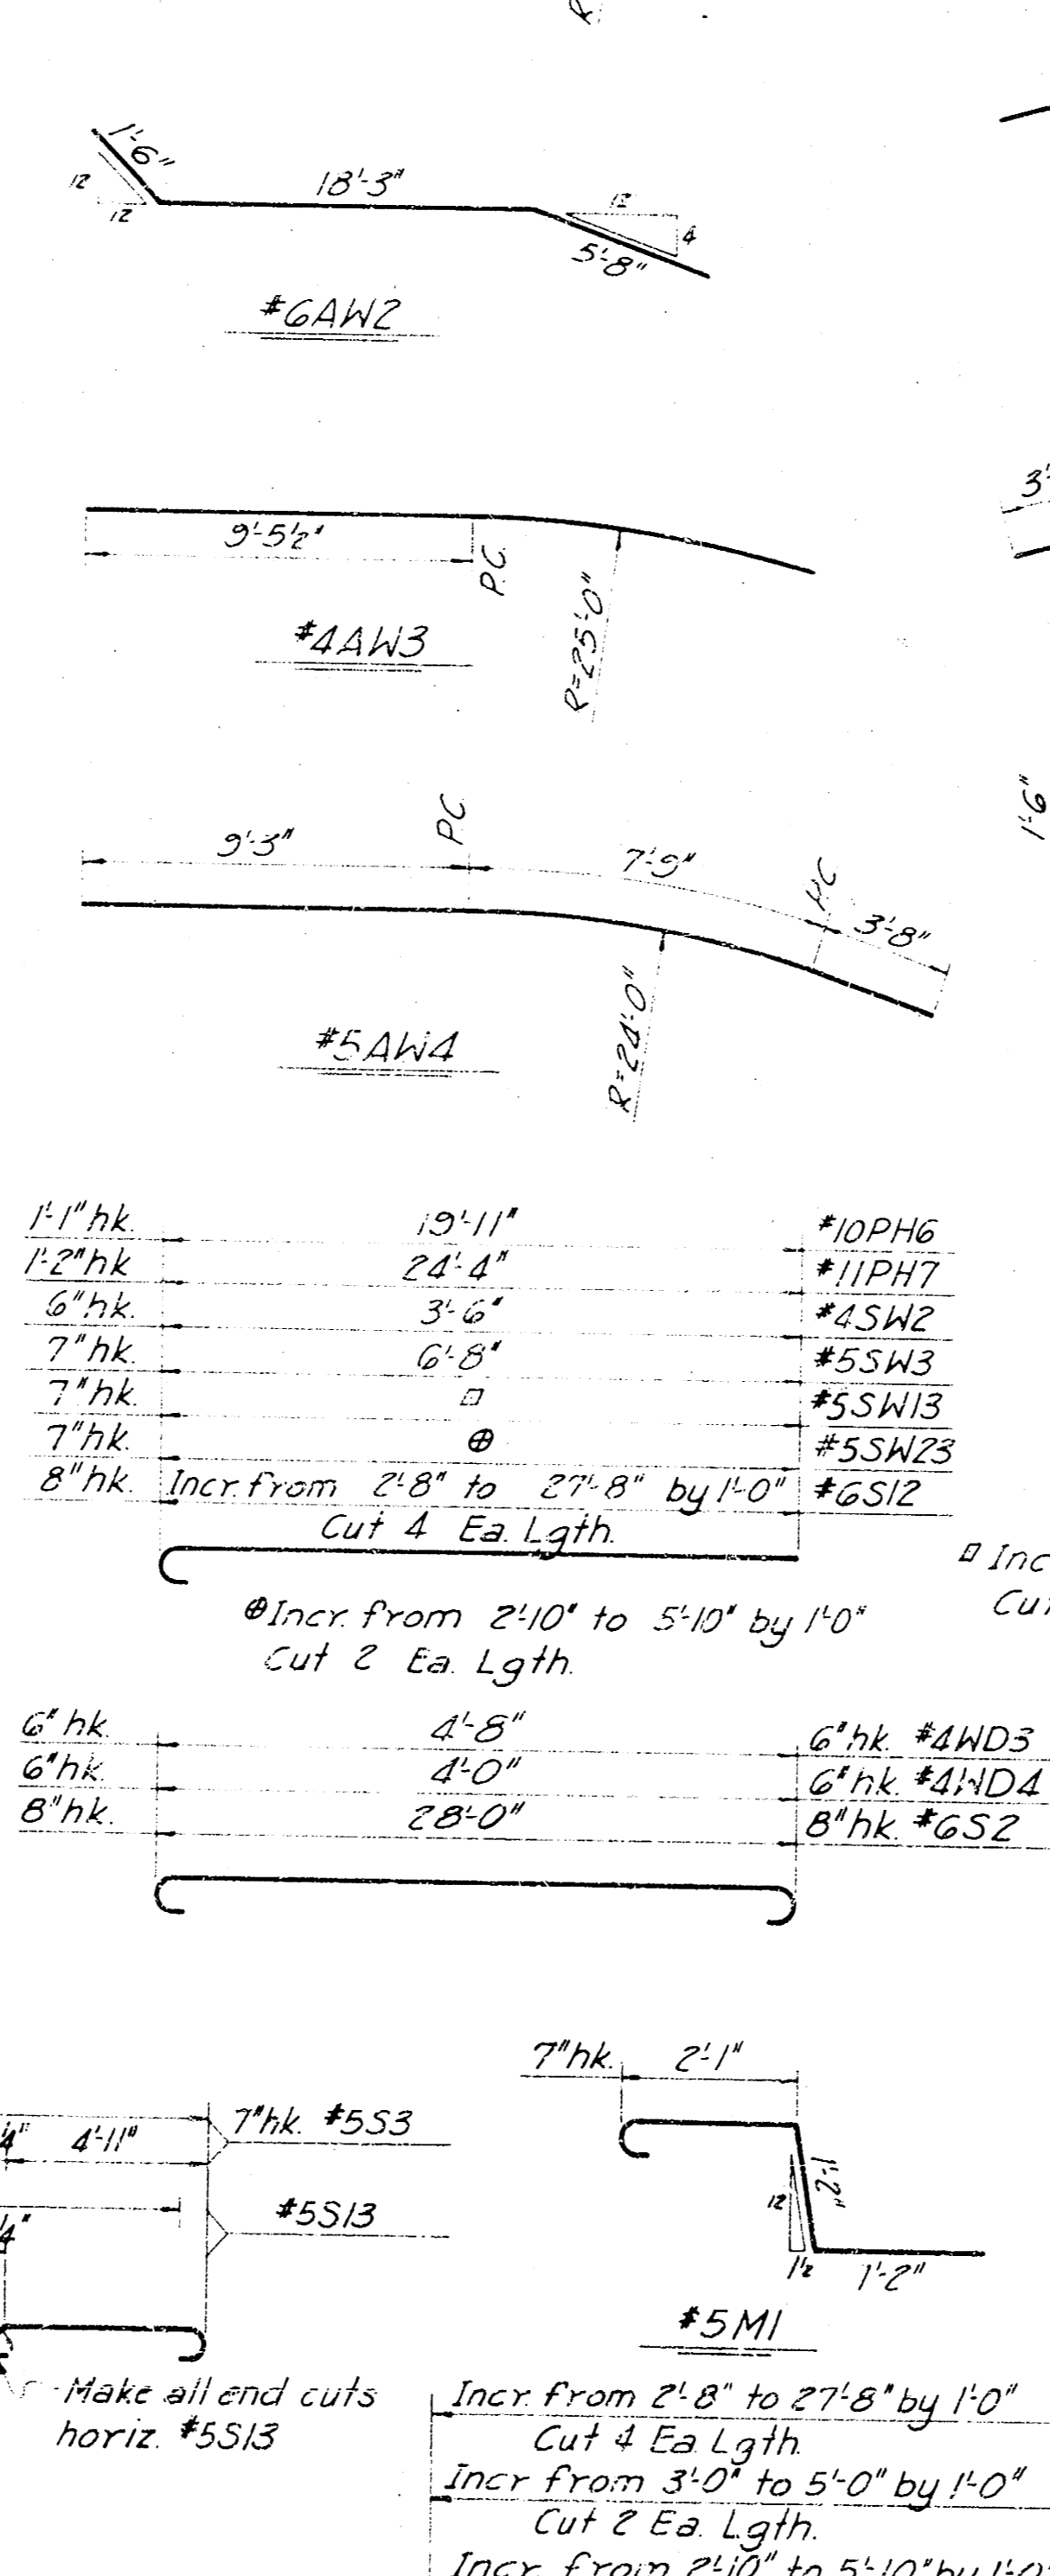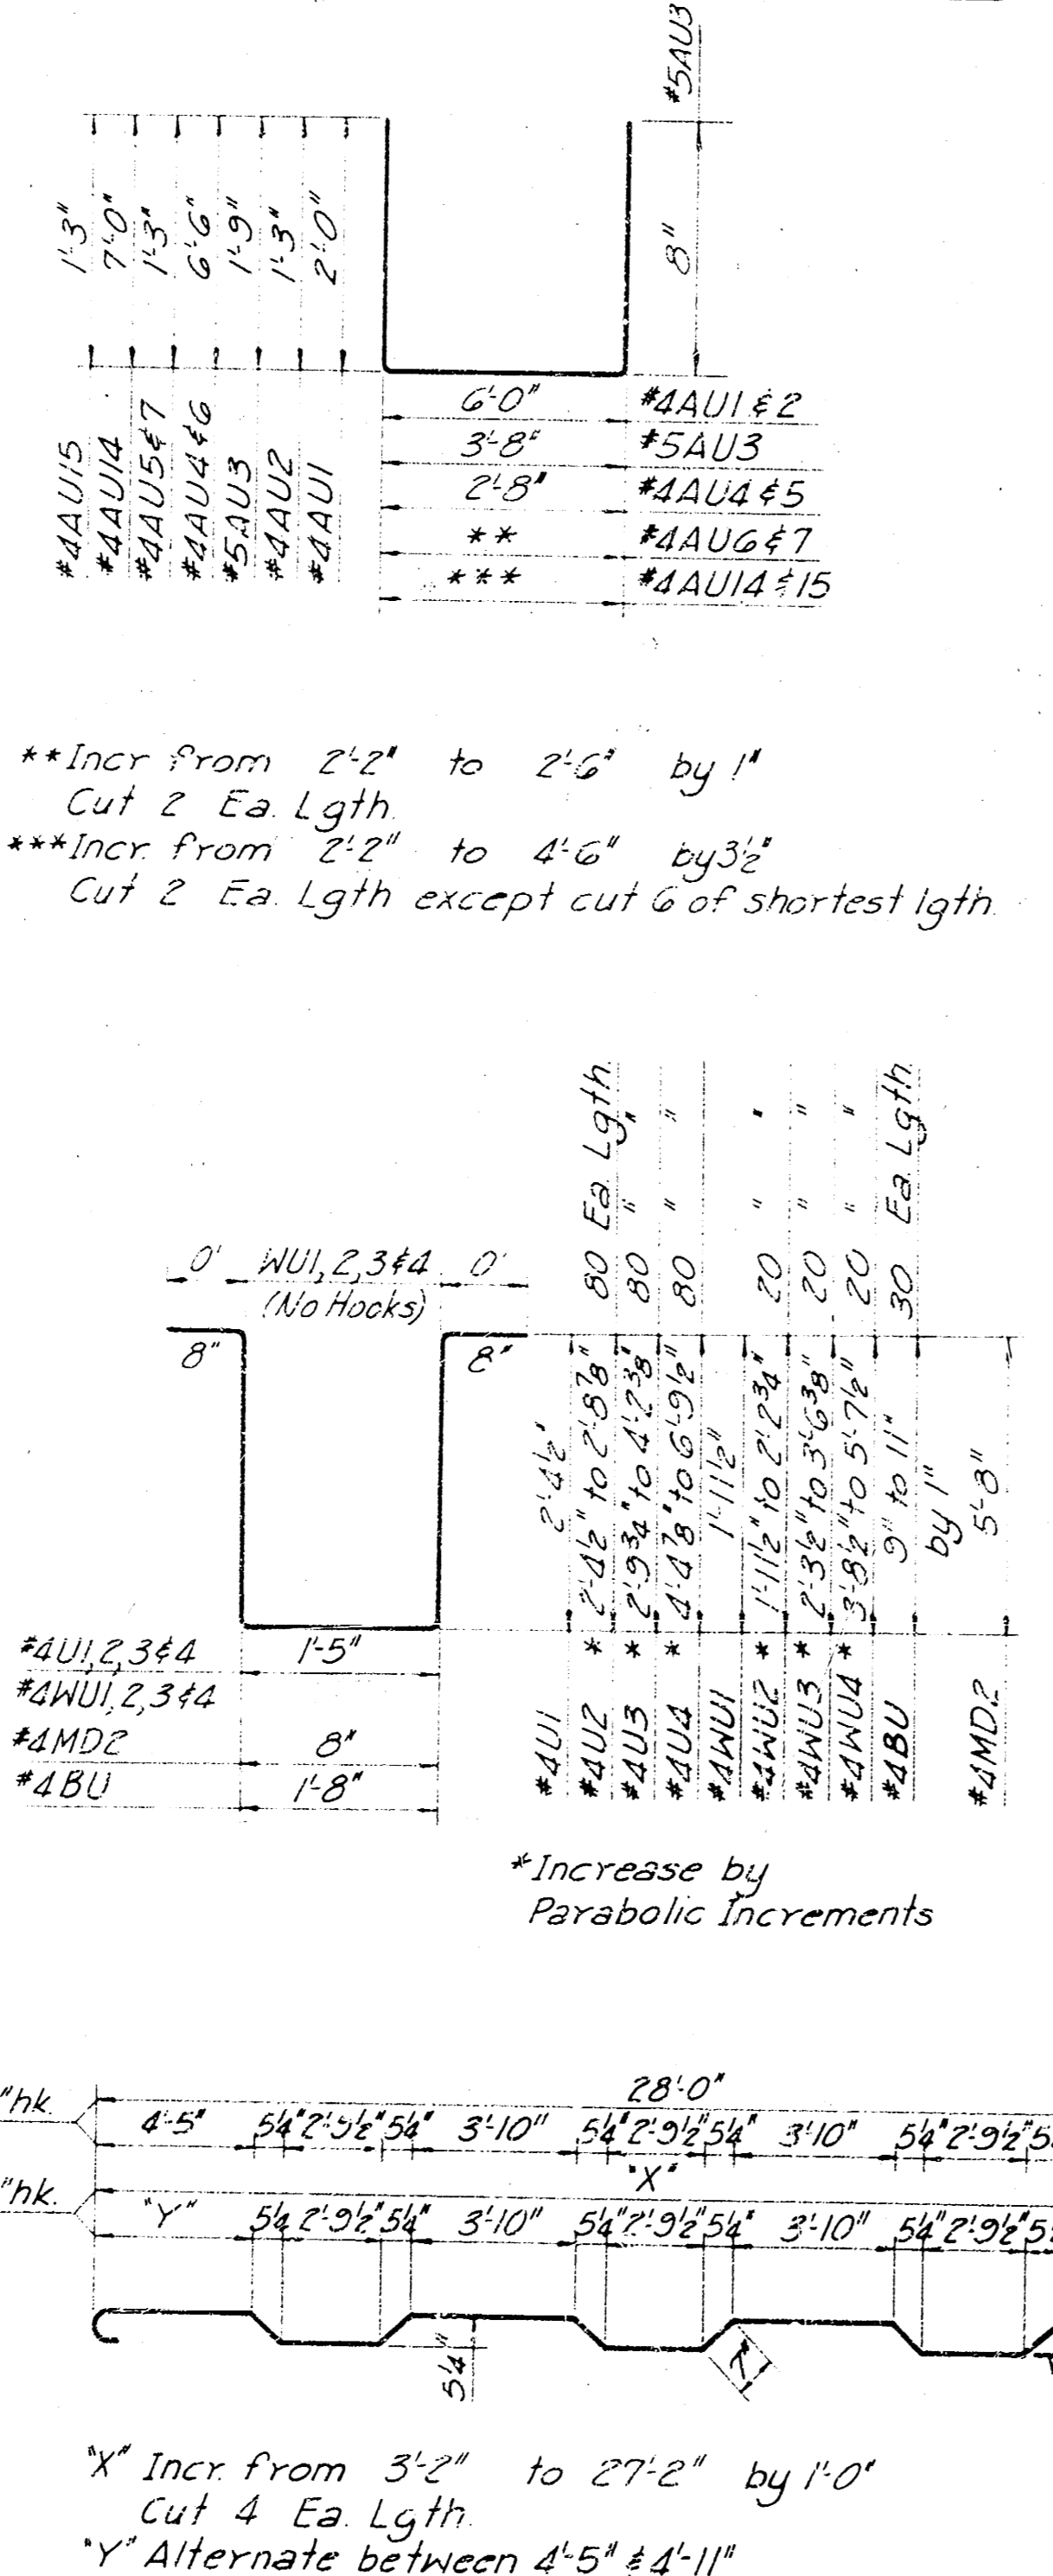

Incr from 40'-9" to 42'-9" by 2'-0" #5PC9
Cut 2 Ea Lgth
Incr from 7'-3" to 11'-9" by 4'-6" #5PC10
Cut 20 Ea Lgth
Incr from 2'-8" to 10'-11" by 8'-3" #5PC11
Cut 6 Ea Lgth
Incr from 4'-9" to 45'-9" by 41'-0" #5PC12
Cut 2 Ea Lgth
Incr from 2'-0" to 5'-9" by 3'-9" #5PC13
Cut 2 Ea Lgth

*Except Cut 4 @ 43'-9"
#4WT3
#4WT4
#4WT5
#4WT100

As Built Nov. 972 CDS
CITY OF WICHITA, KANSAS
B. E. SMITH, P.E., CITY ENGINEER
TWENTY-FIRST STREET BRIDGE OVER
THE BIG ARKANSAS RIVER
BAR LIST & BENDING DIAGRAMS
R. S. DELAMATER
CONSULTING ENGINEER
WICHITA, KANSAS