
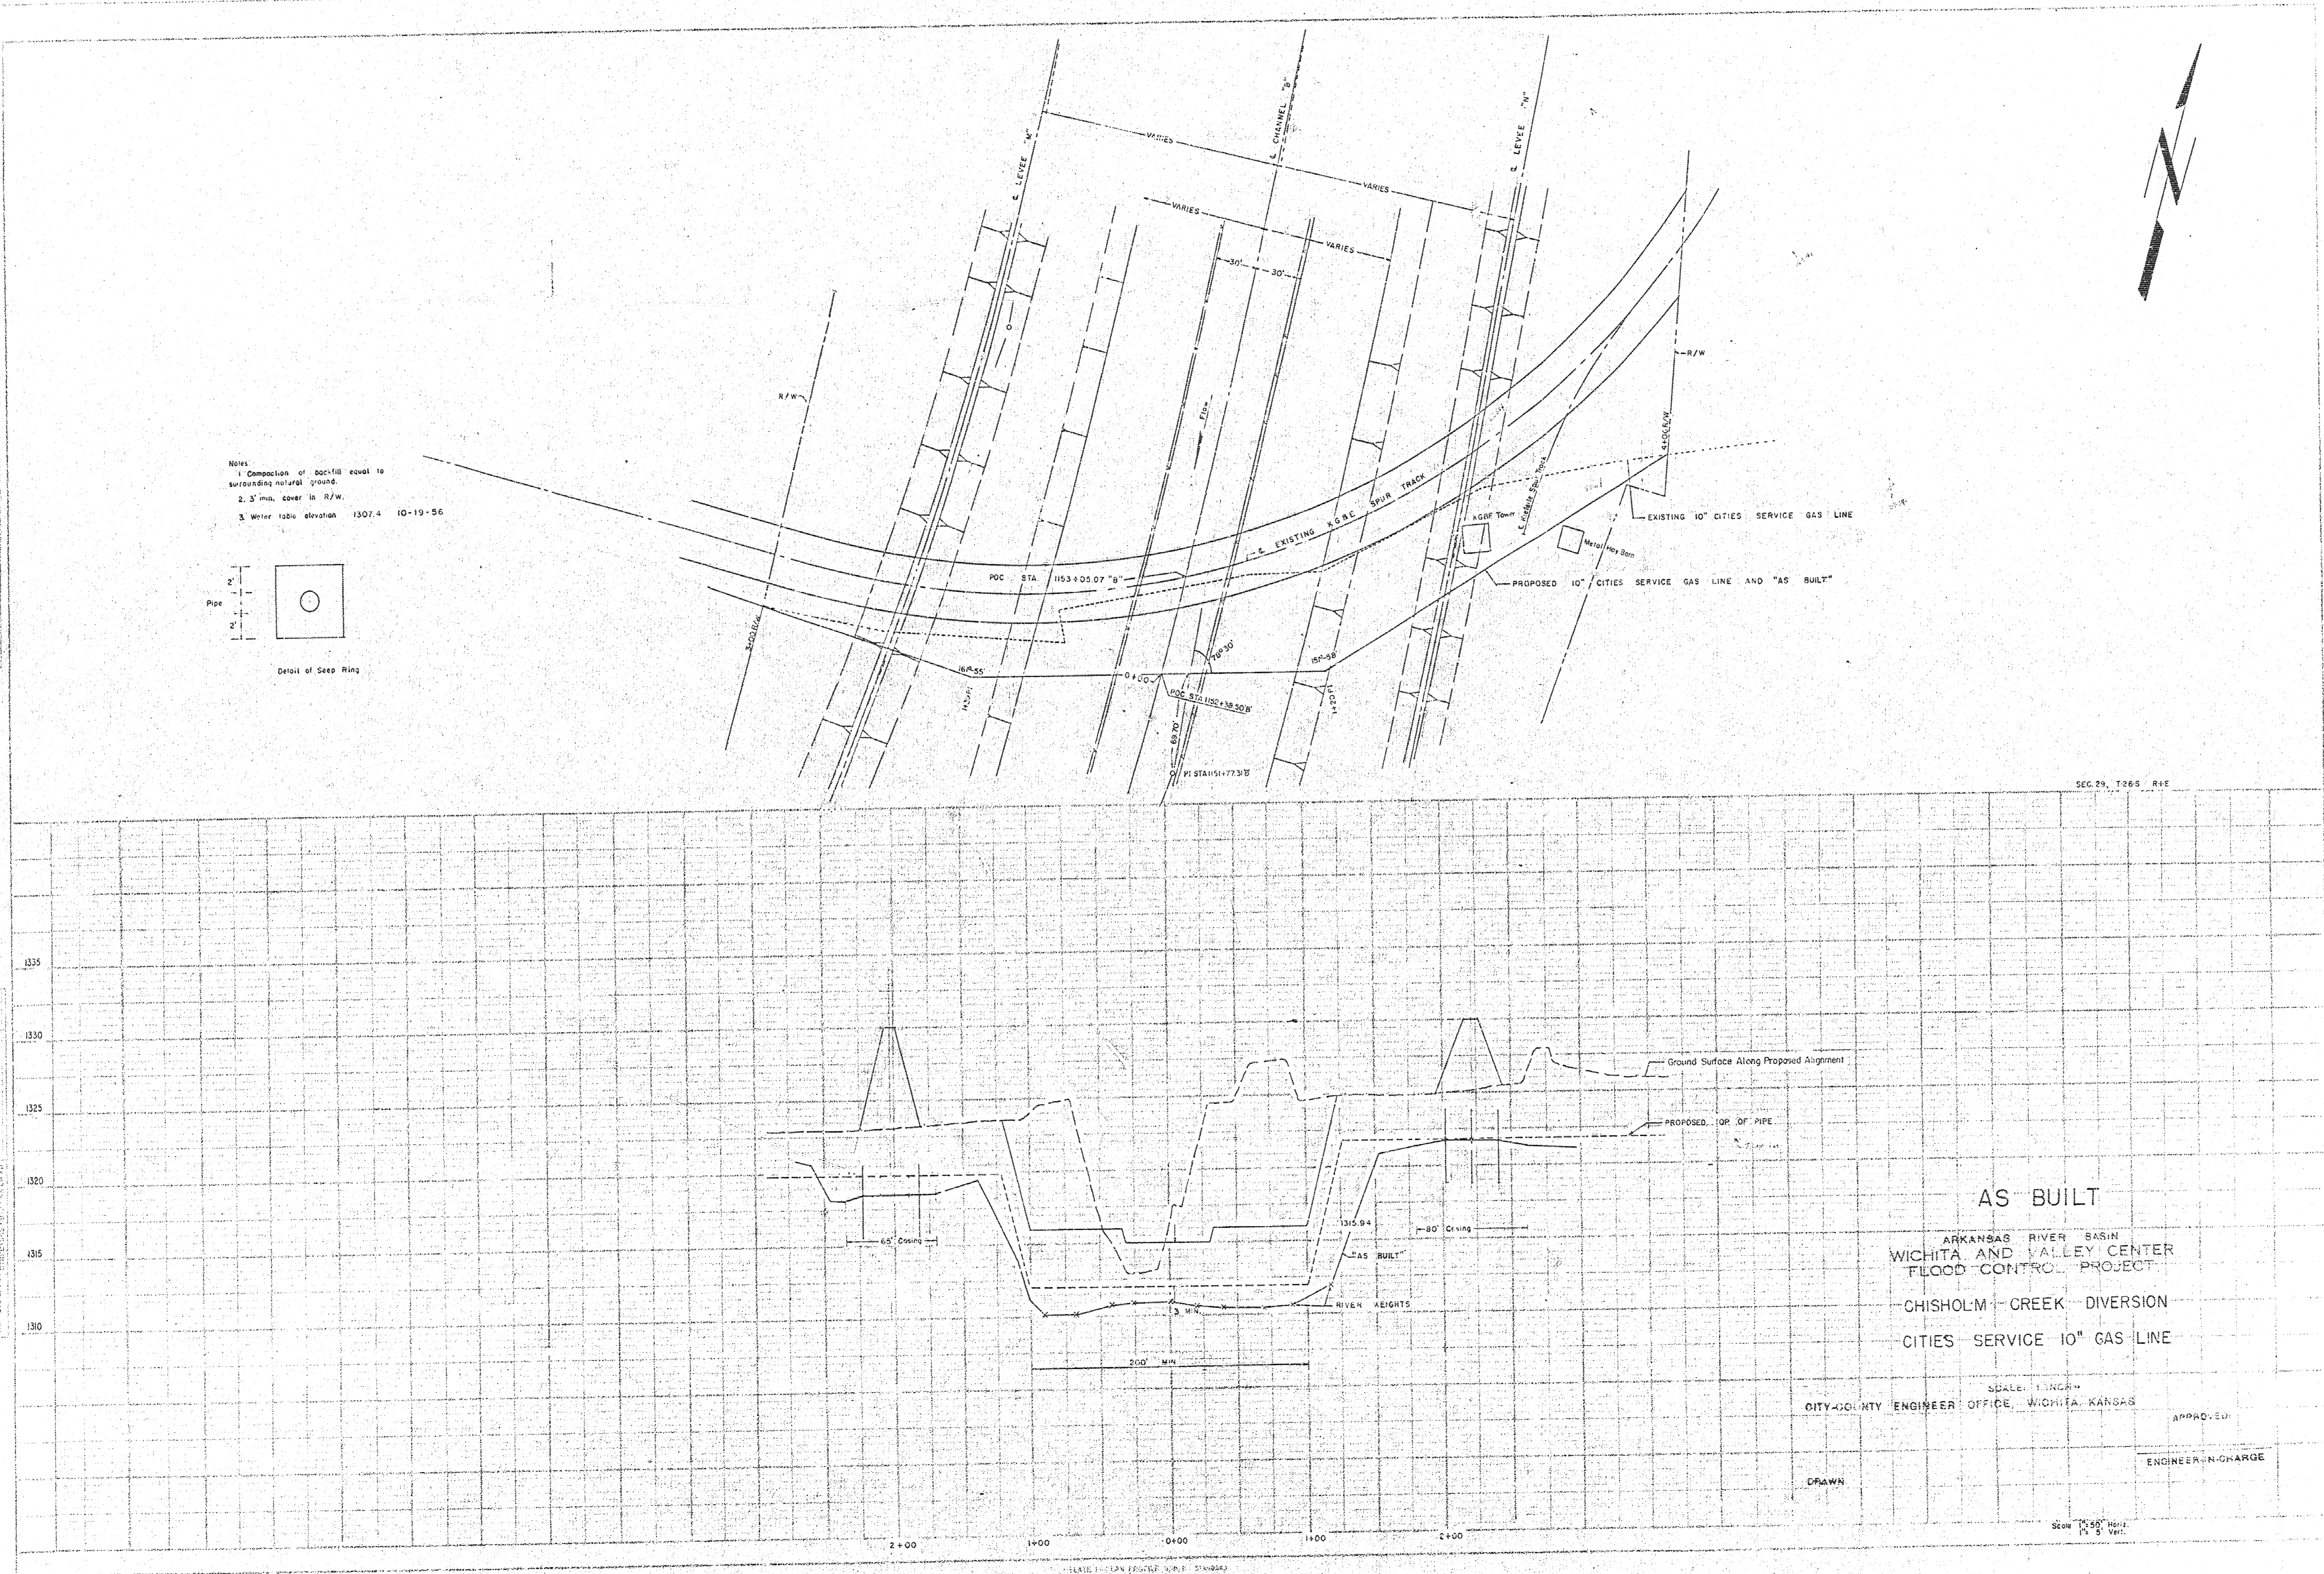


PROJECT: ARKANSAS RIVER BASIN  
 WICHITA AND VALLEY CENTER  
 FLOOD CONTROL PROJECT  
 CHISHOLM CREEK DIVERSION  
 CITIES SERVICE 10" GAS LINE  
 DATE: 10-19-56  
 DRAWN BY: [Name]  
 CHECKED BY: [Name]

Notes:  
 1. Composition of backfill equal to  
 surrounding natural ground.  
 2. 3" min. cover to R/W.  
 3. Winter 1956 elevation 1307.4 10-19-56

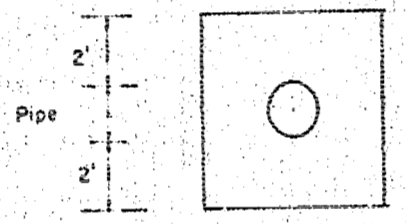

AS BUILT  
 ARKANSAS RIVER BASIN  
 WICHITA AND VALLEY CENTER  
 FLOOD CONTROL PROJECT  
 CHISHOLM CREEK DIVERSION  
 CITIES SERVICE 10" GAS LINE

SCALE: 1"=100'  
 CITY AND COUNTY ENGINEER OFFICE, WICHITA, KANSAS  
 APPROVED: [Signature]  
 ENGINEER-IN-CHARGE

DRAWN

SHEET NO. 10  
 OF 15 SHEETS

DATE: 10-19-56  
 DRAWN BY: [Name]  
 CHECKED BY: [Name]