



PLAN
 1. Scale: 1" = 40'
 2. Date: 10/15/62
 3. Drawn by: J. J. [illegible]
 4. Checked by: [illegible]
 5. Approved by: [illegible]

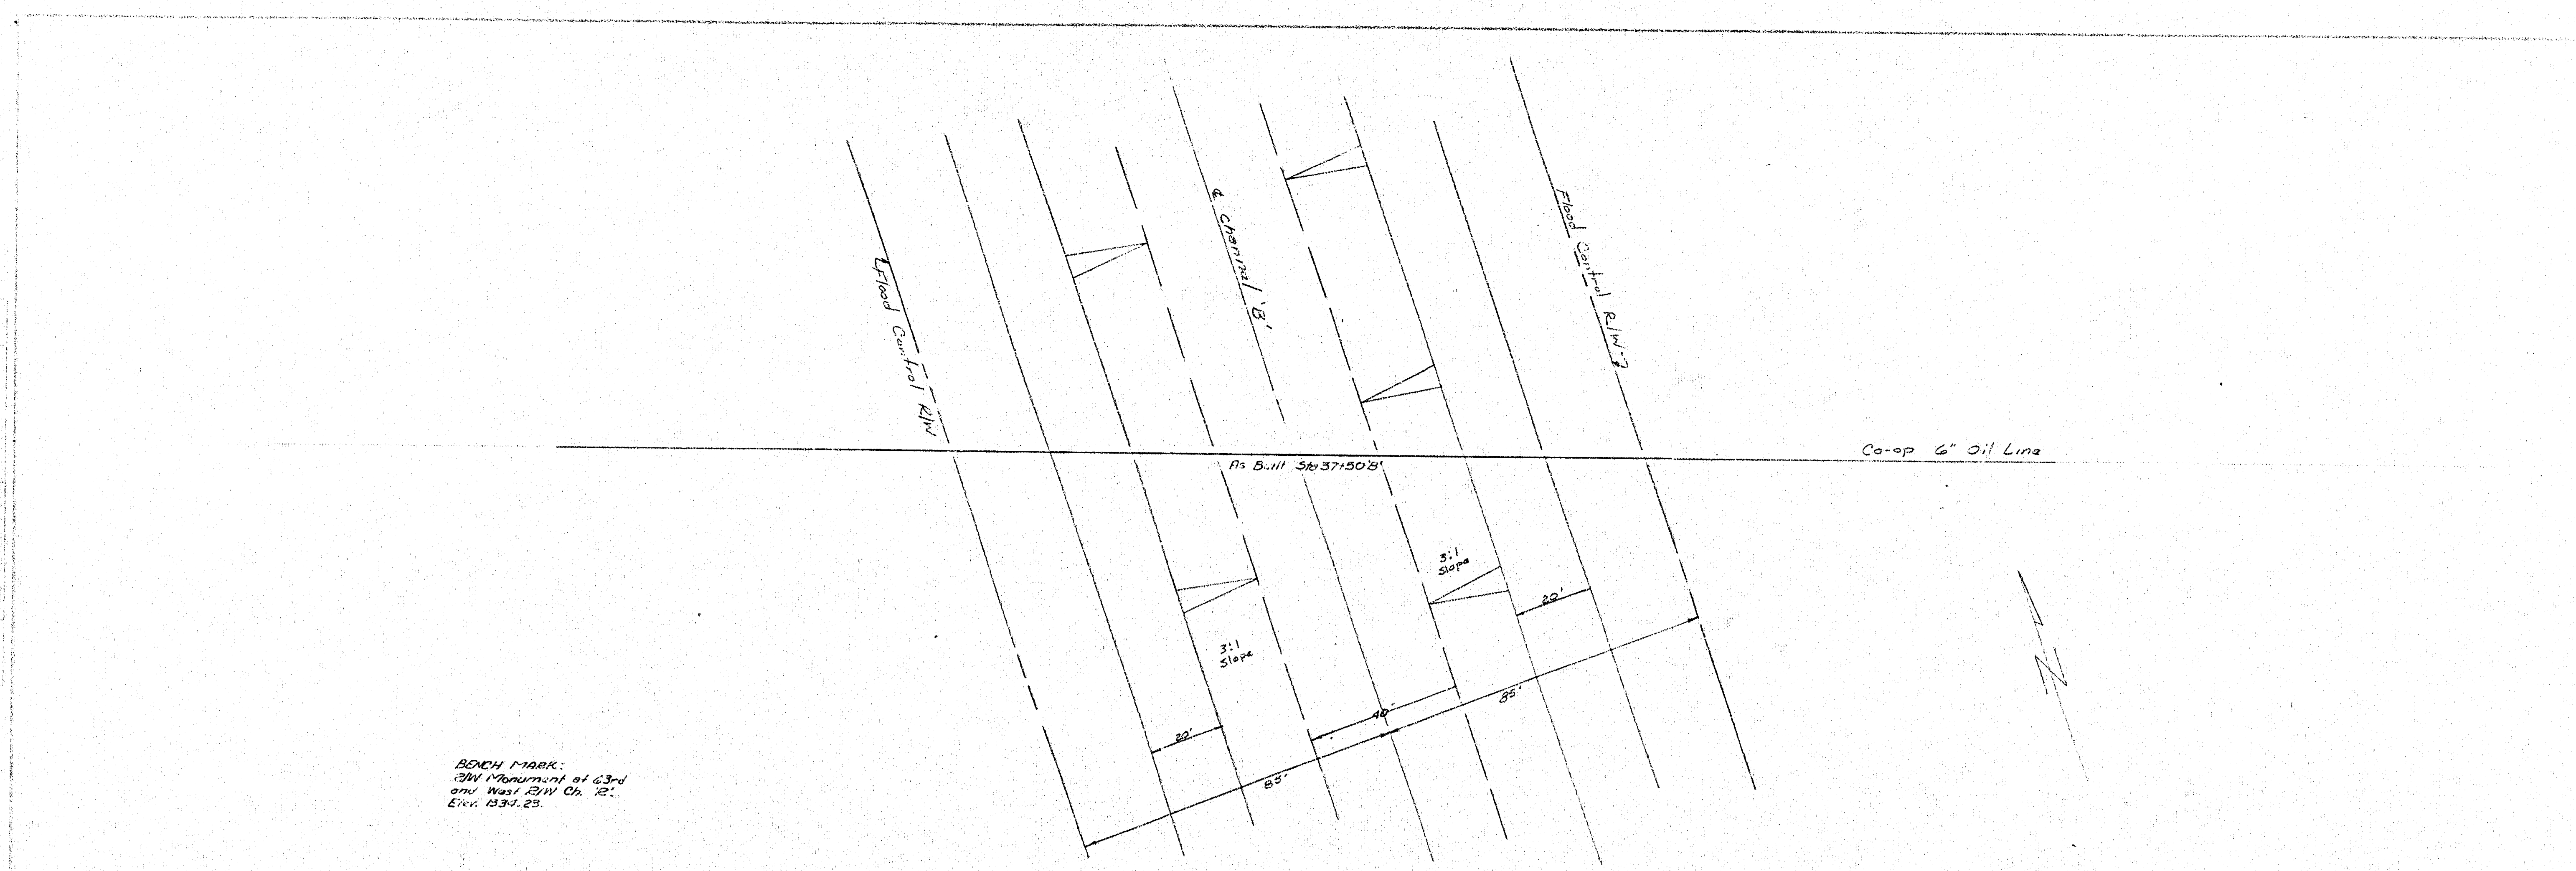


BENCH MARK:
 2nd Monument at 63rd
 and West 2nd St. 12'
 Elev. 1331.25


PROFILE
 1. Scale: 1" = 20' Horiz.
 2. Scale: 1" = 5' Vert.
 3. Date: 10/15/62
 4. Drawn by: J. J. [illegible]
 5. Checked by: [illegible]
 6. Approved by: [illegible]

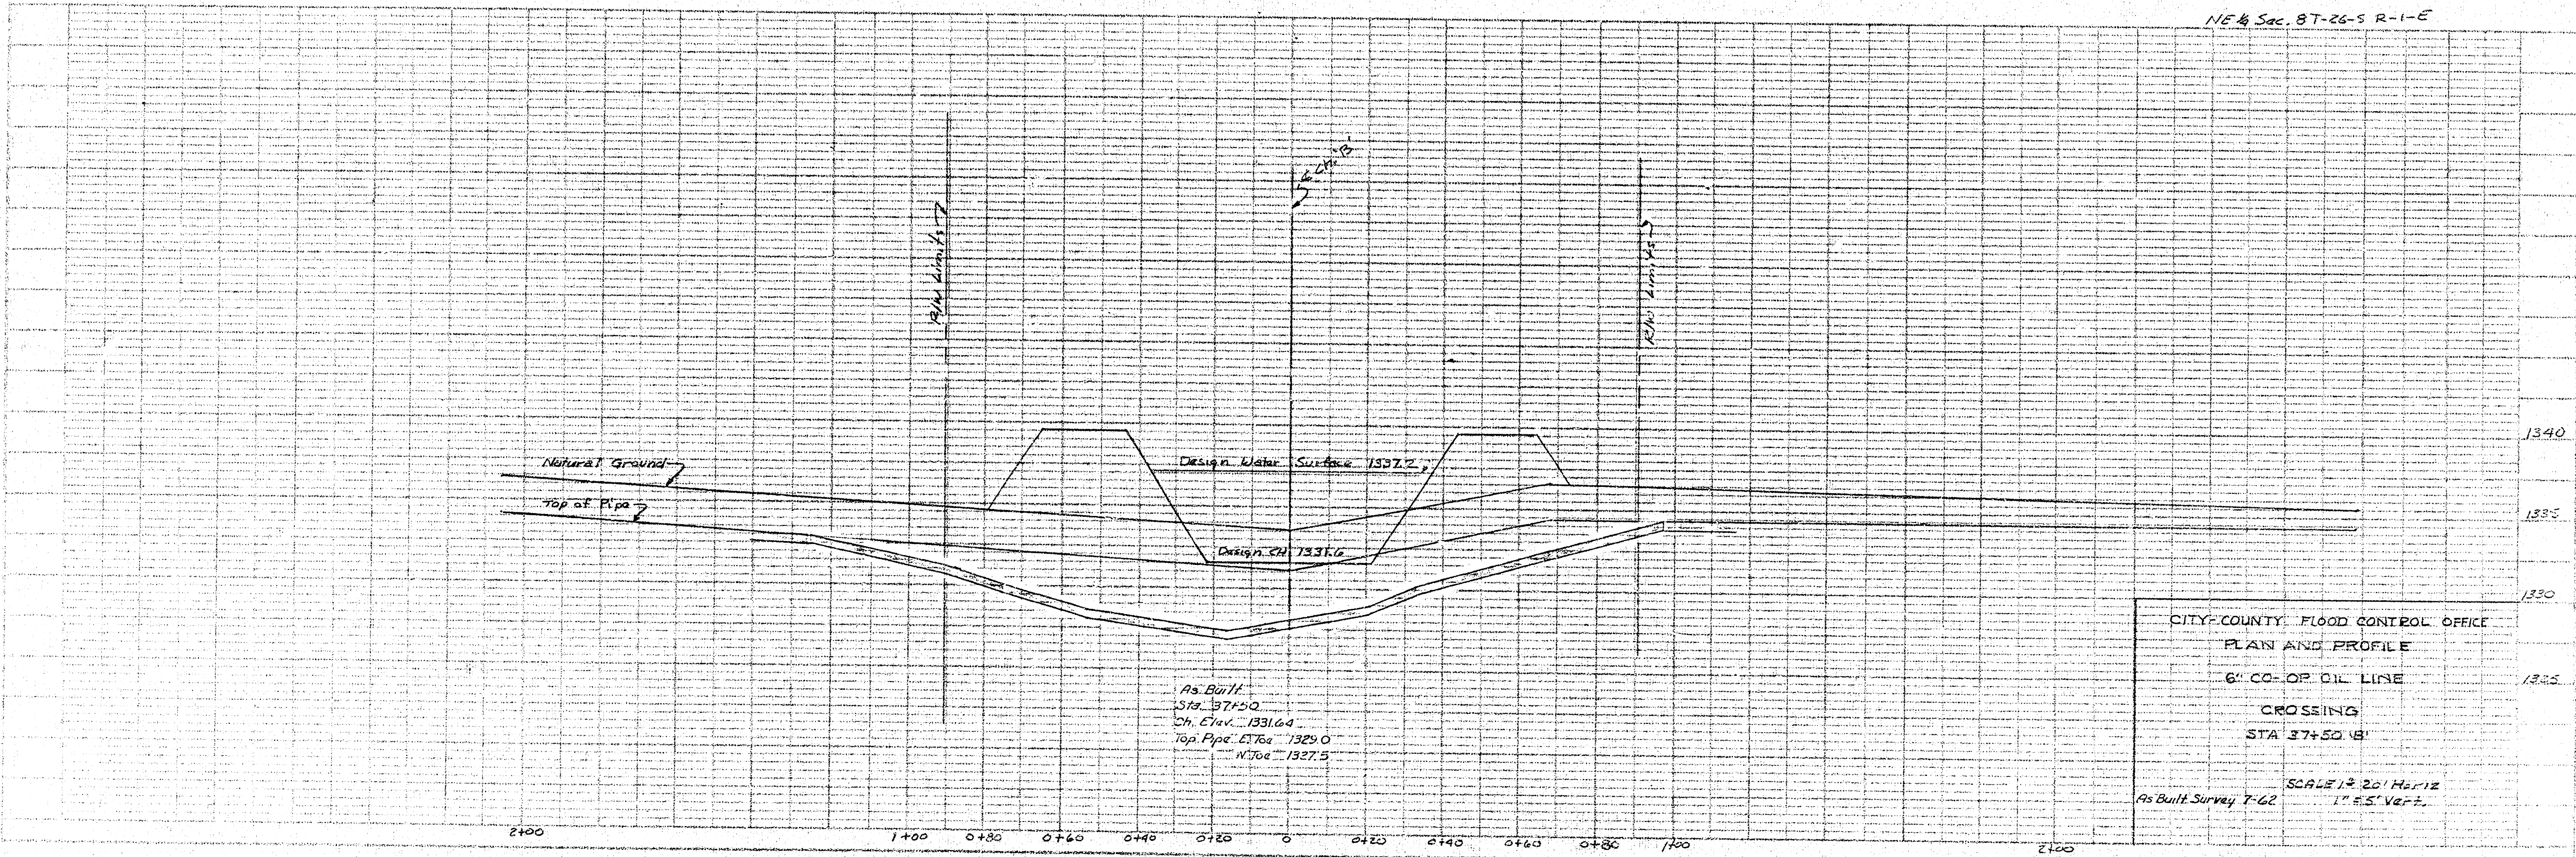

As Built
 Sta. 37+50.0
 Ch. Elev. 1331.64
 Top Pipe 6762 1325.0
 W. 764 1327.5

CITY-COUNTY FLOOD CONTROL OFFICE
 PLAN AND PROFILE
 6" CO-OP OIL LINE
 CROSSING
 STA 37+50.18'
 SCALE 1" = 20' Horiz.
 1" = 5' Vert.
 As Built Survey T-62

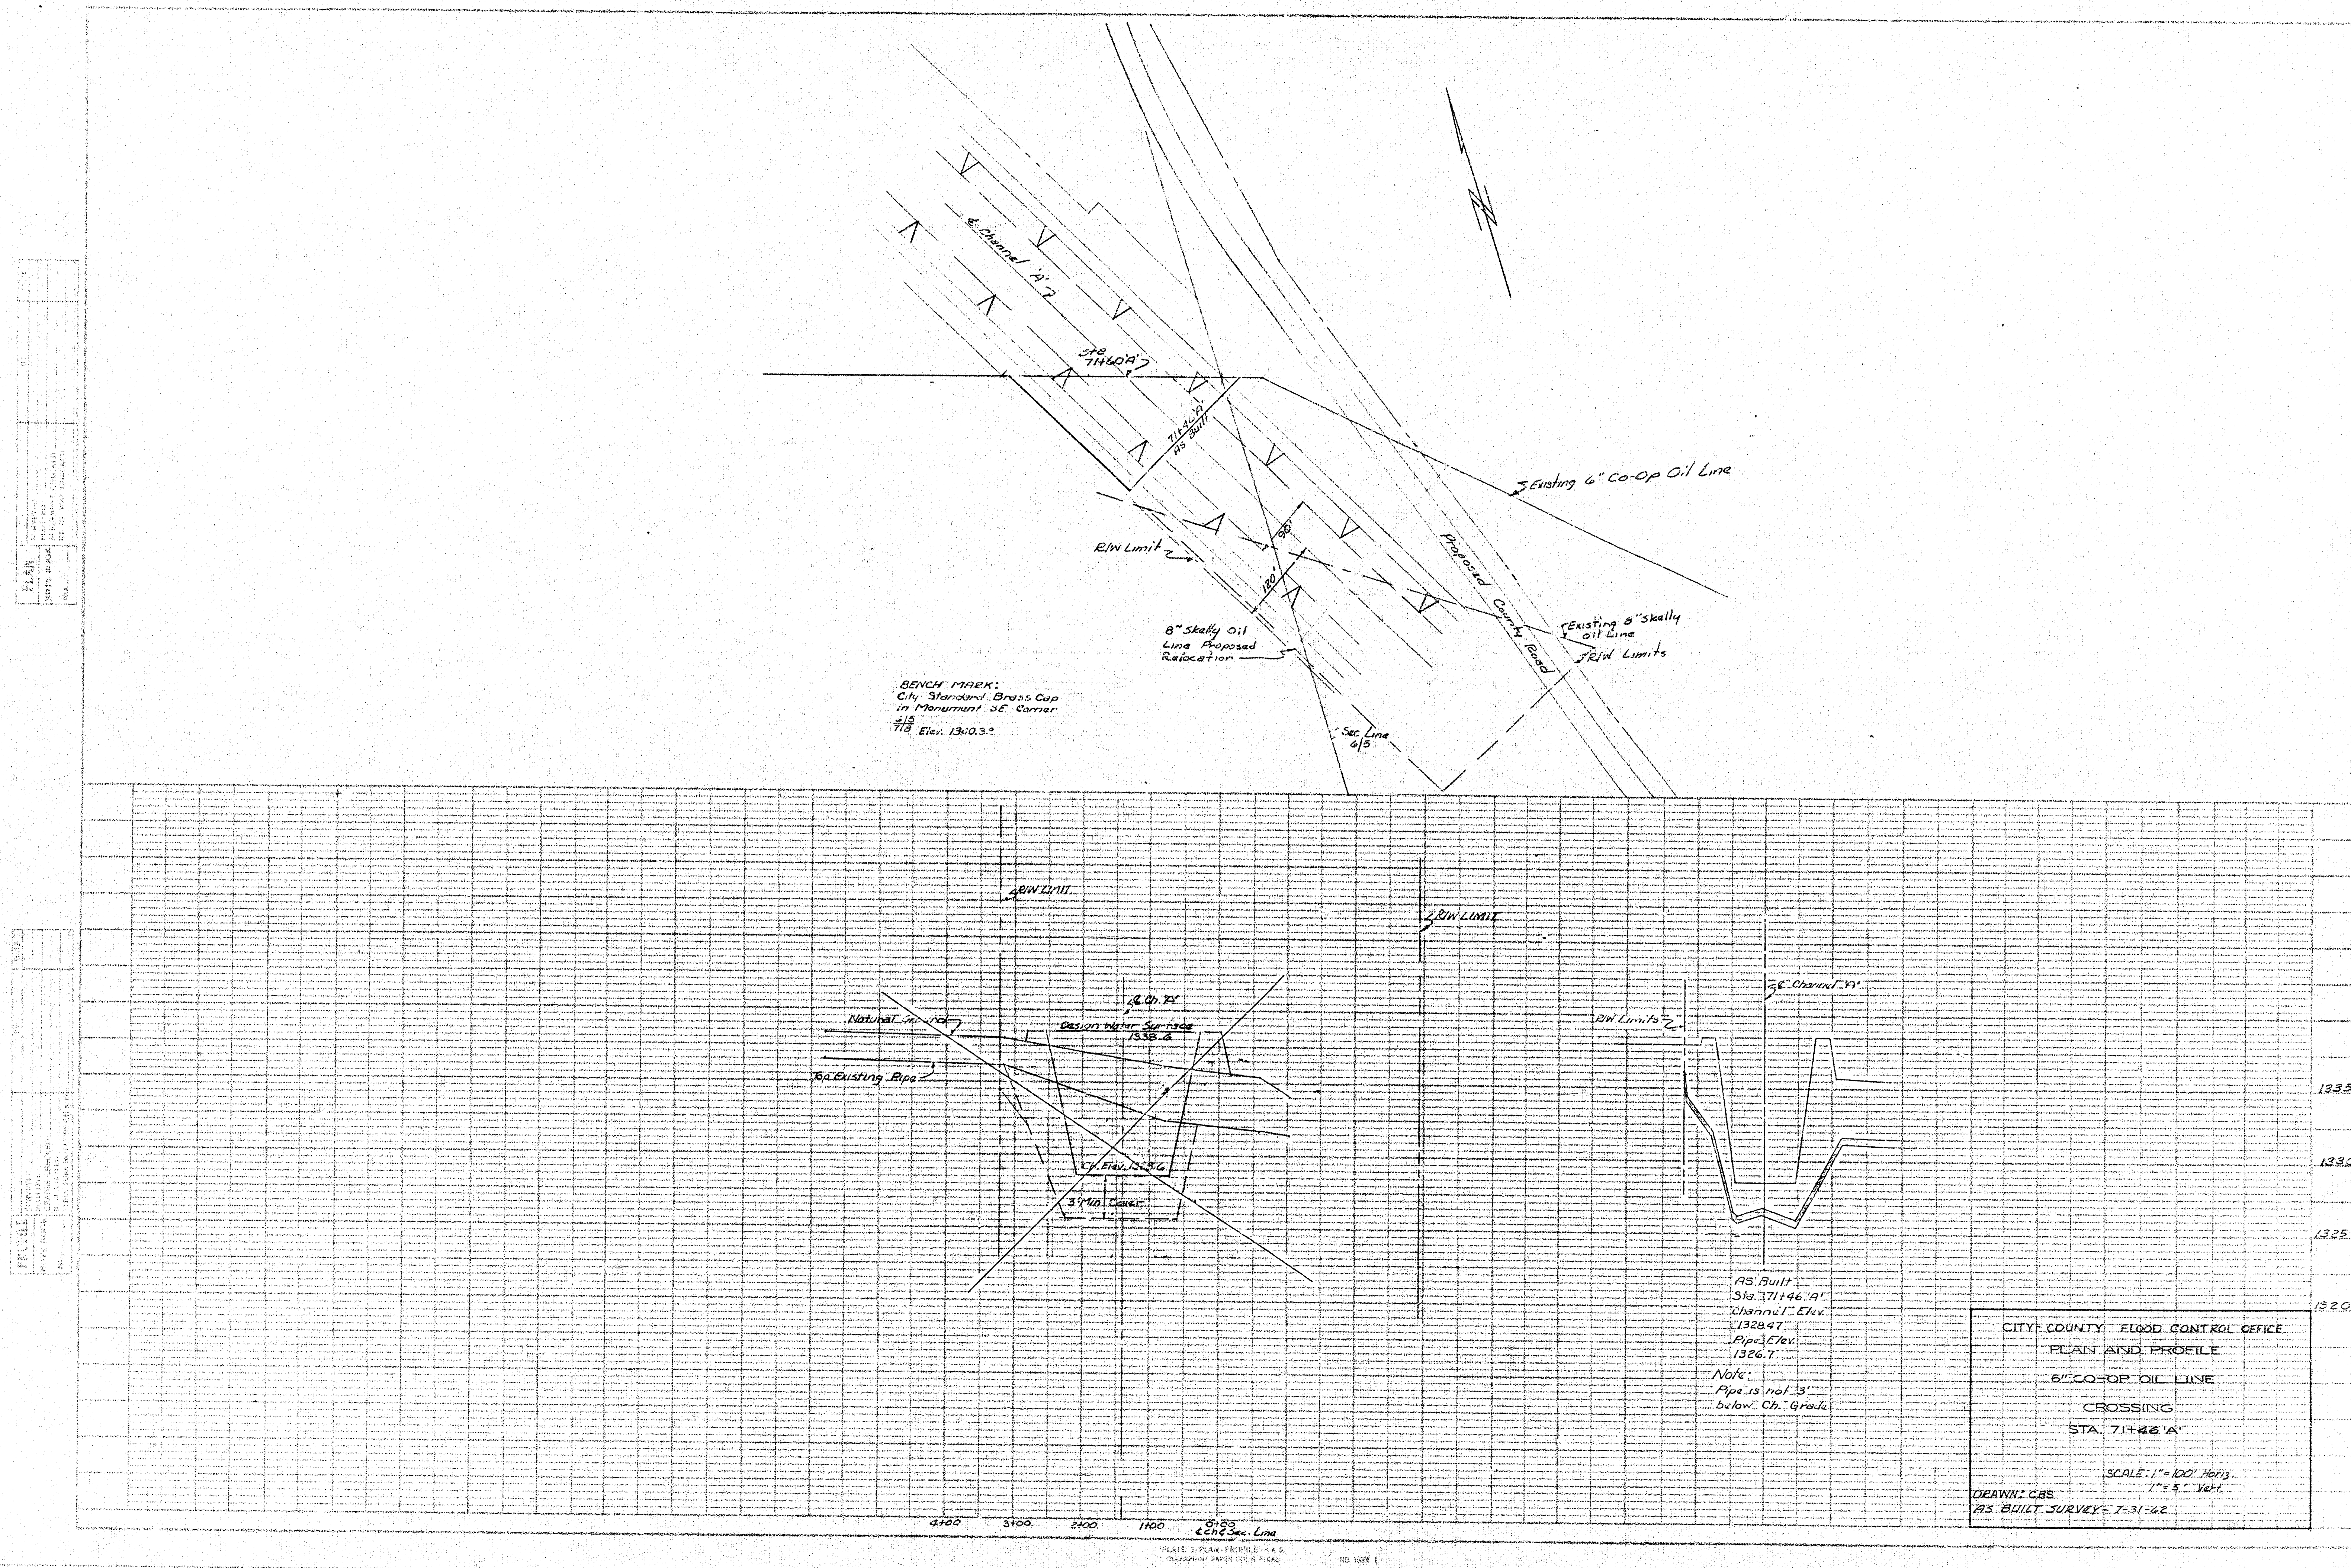

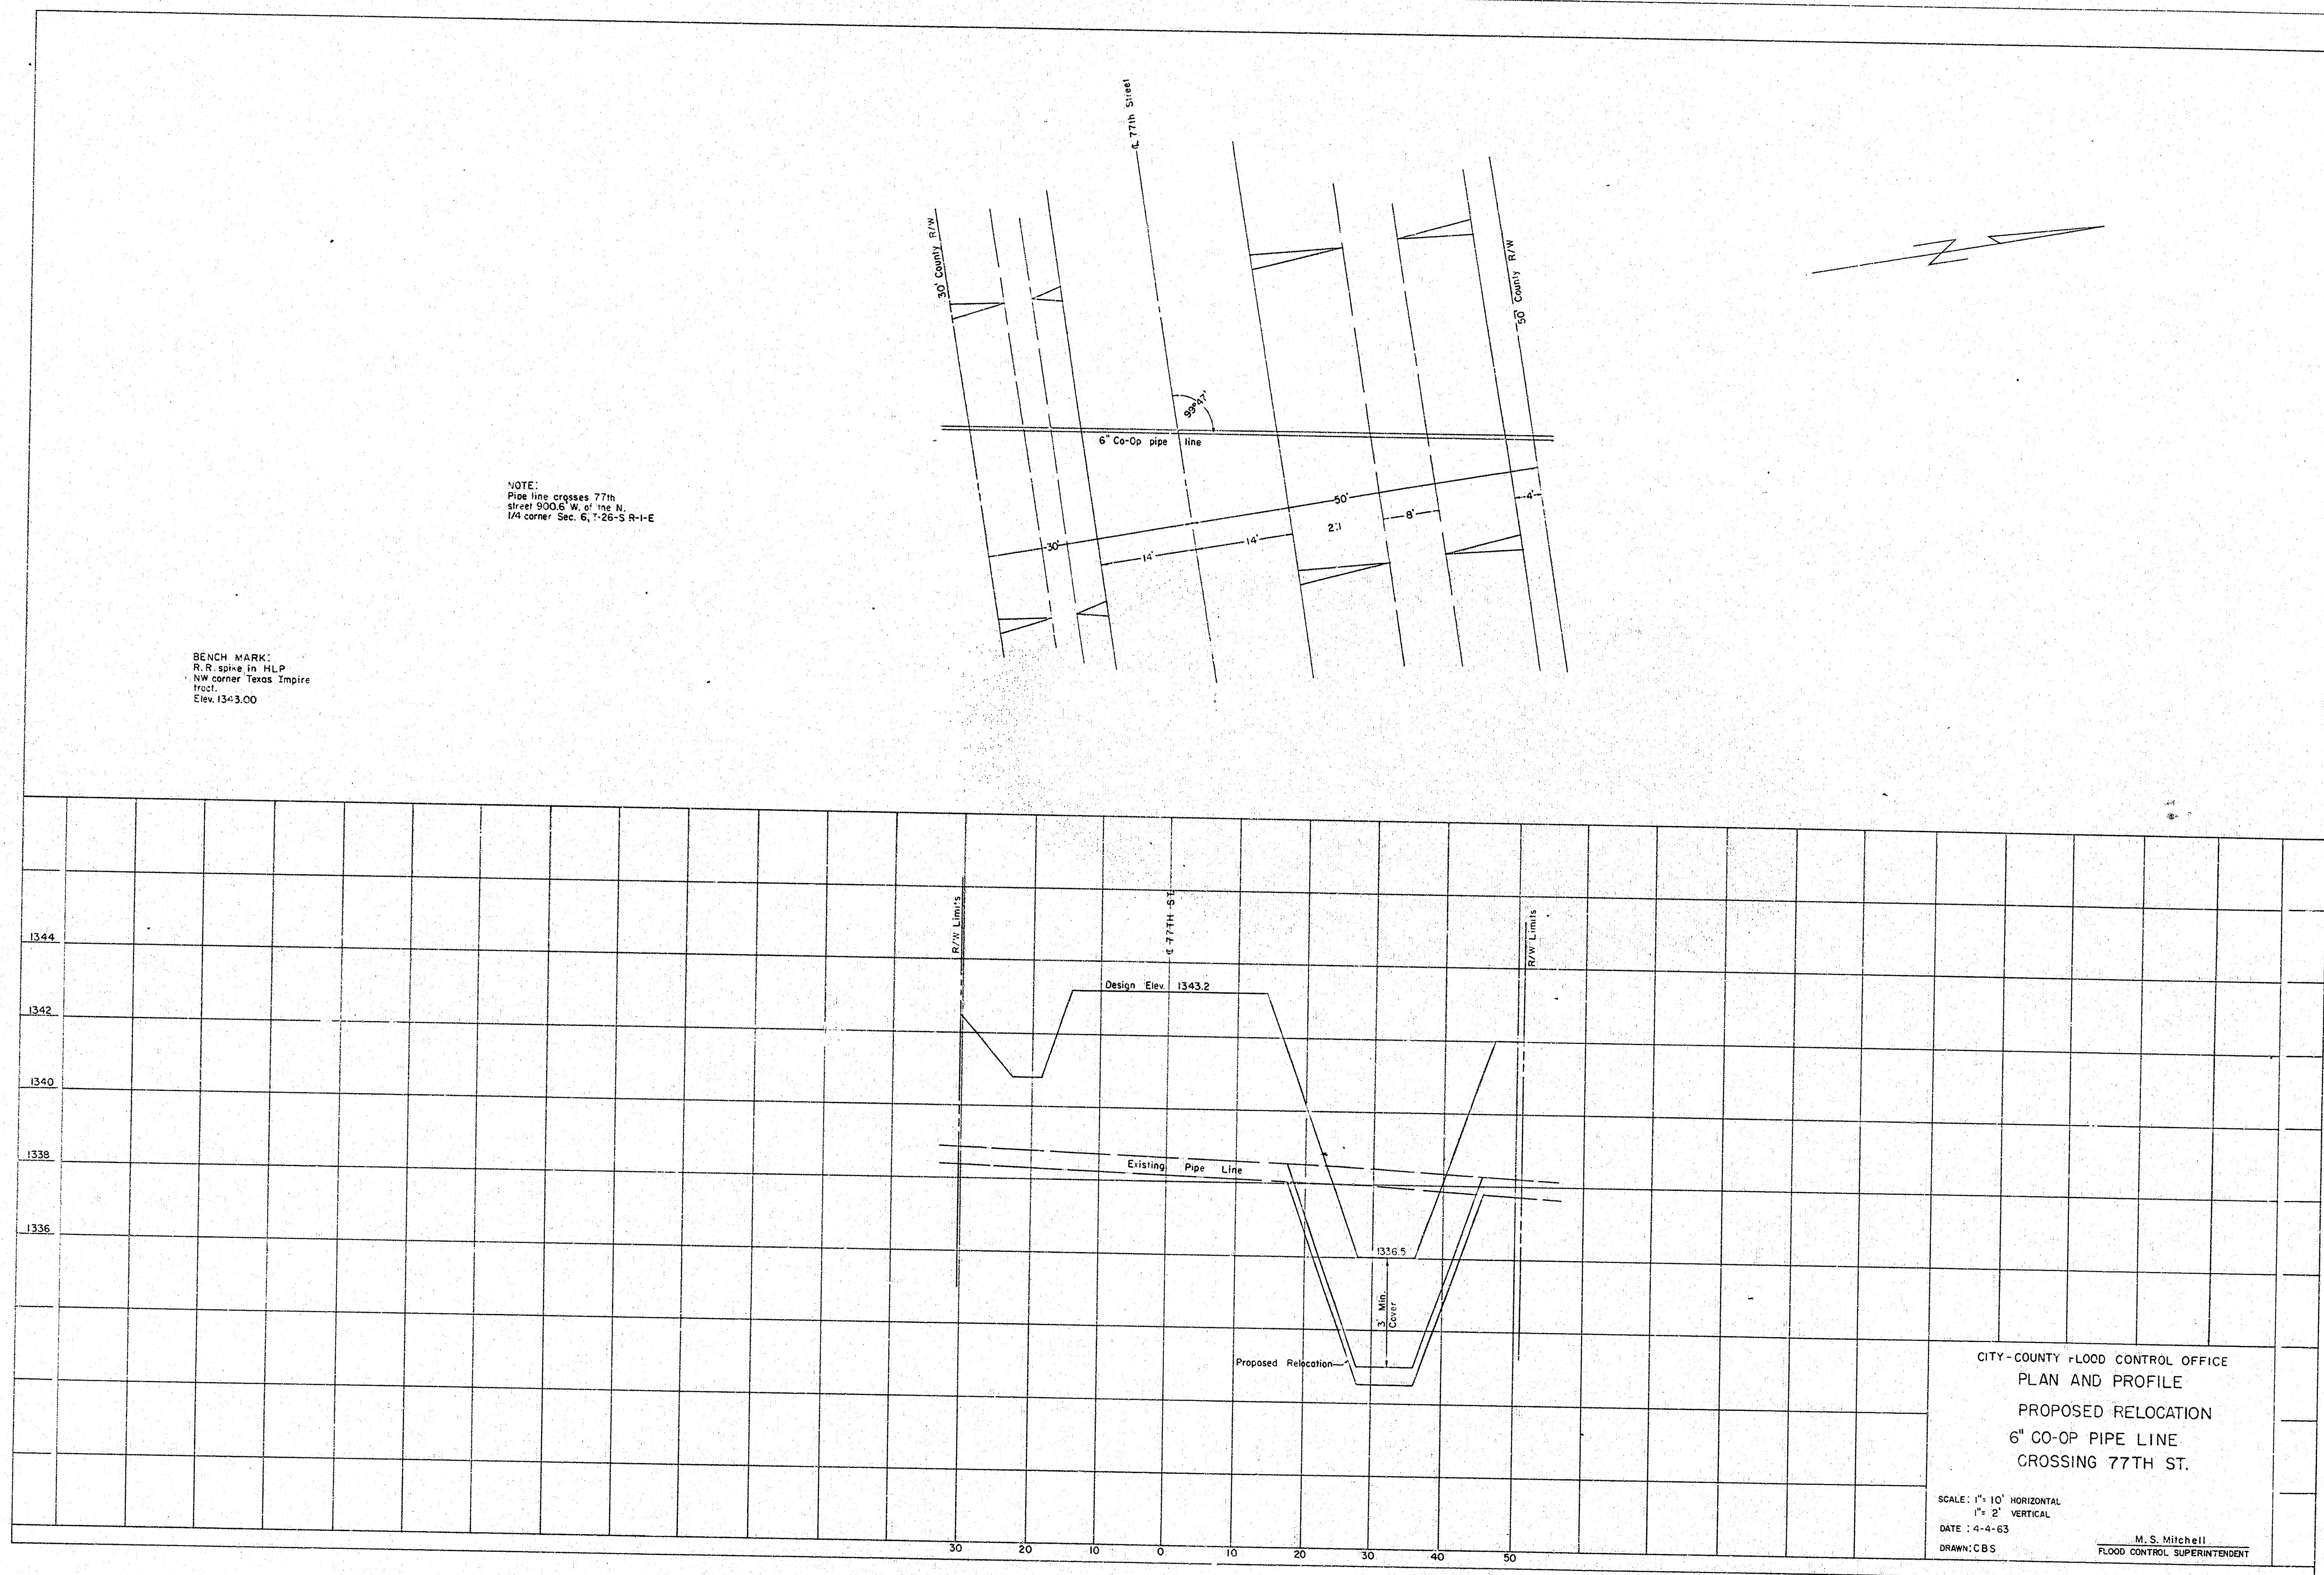

PLAN	DATE	BY
	3/12/54	W.H. HARRIS
NOTE BOOK	ALIGNED CURVE	
	PT. OF WAY CURVE	
NO. 16		

PROFILE	DATE	BY
	3/12/54	W.H. HARRIS
NOTE BOOK	ALIGNED CURVE	
	PT. OF WAY CURVE	
NO. 16		

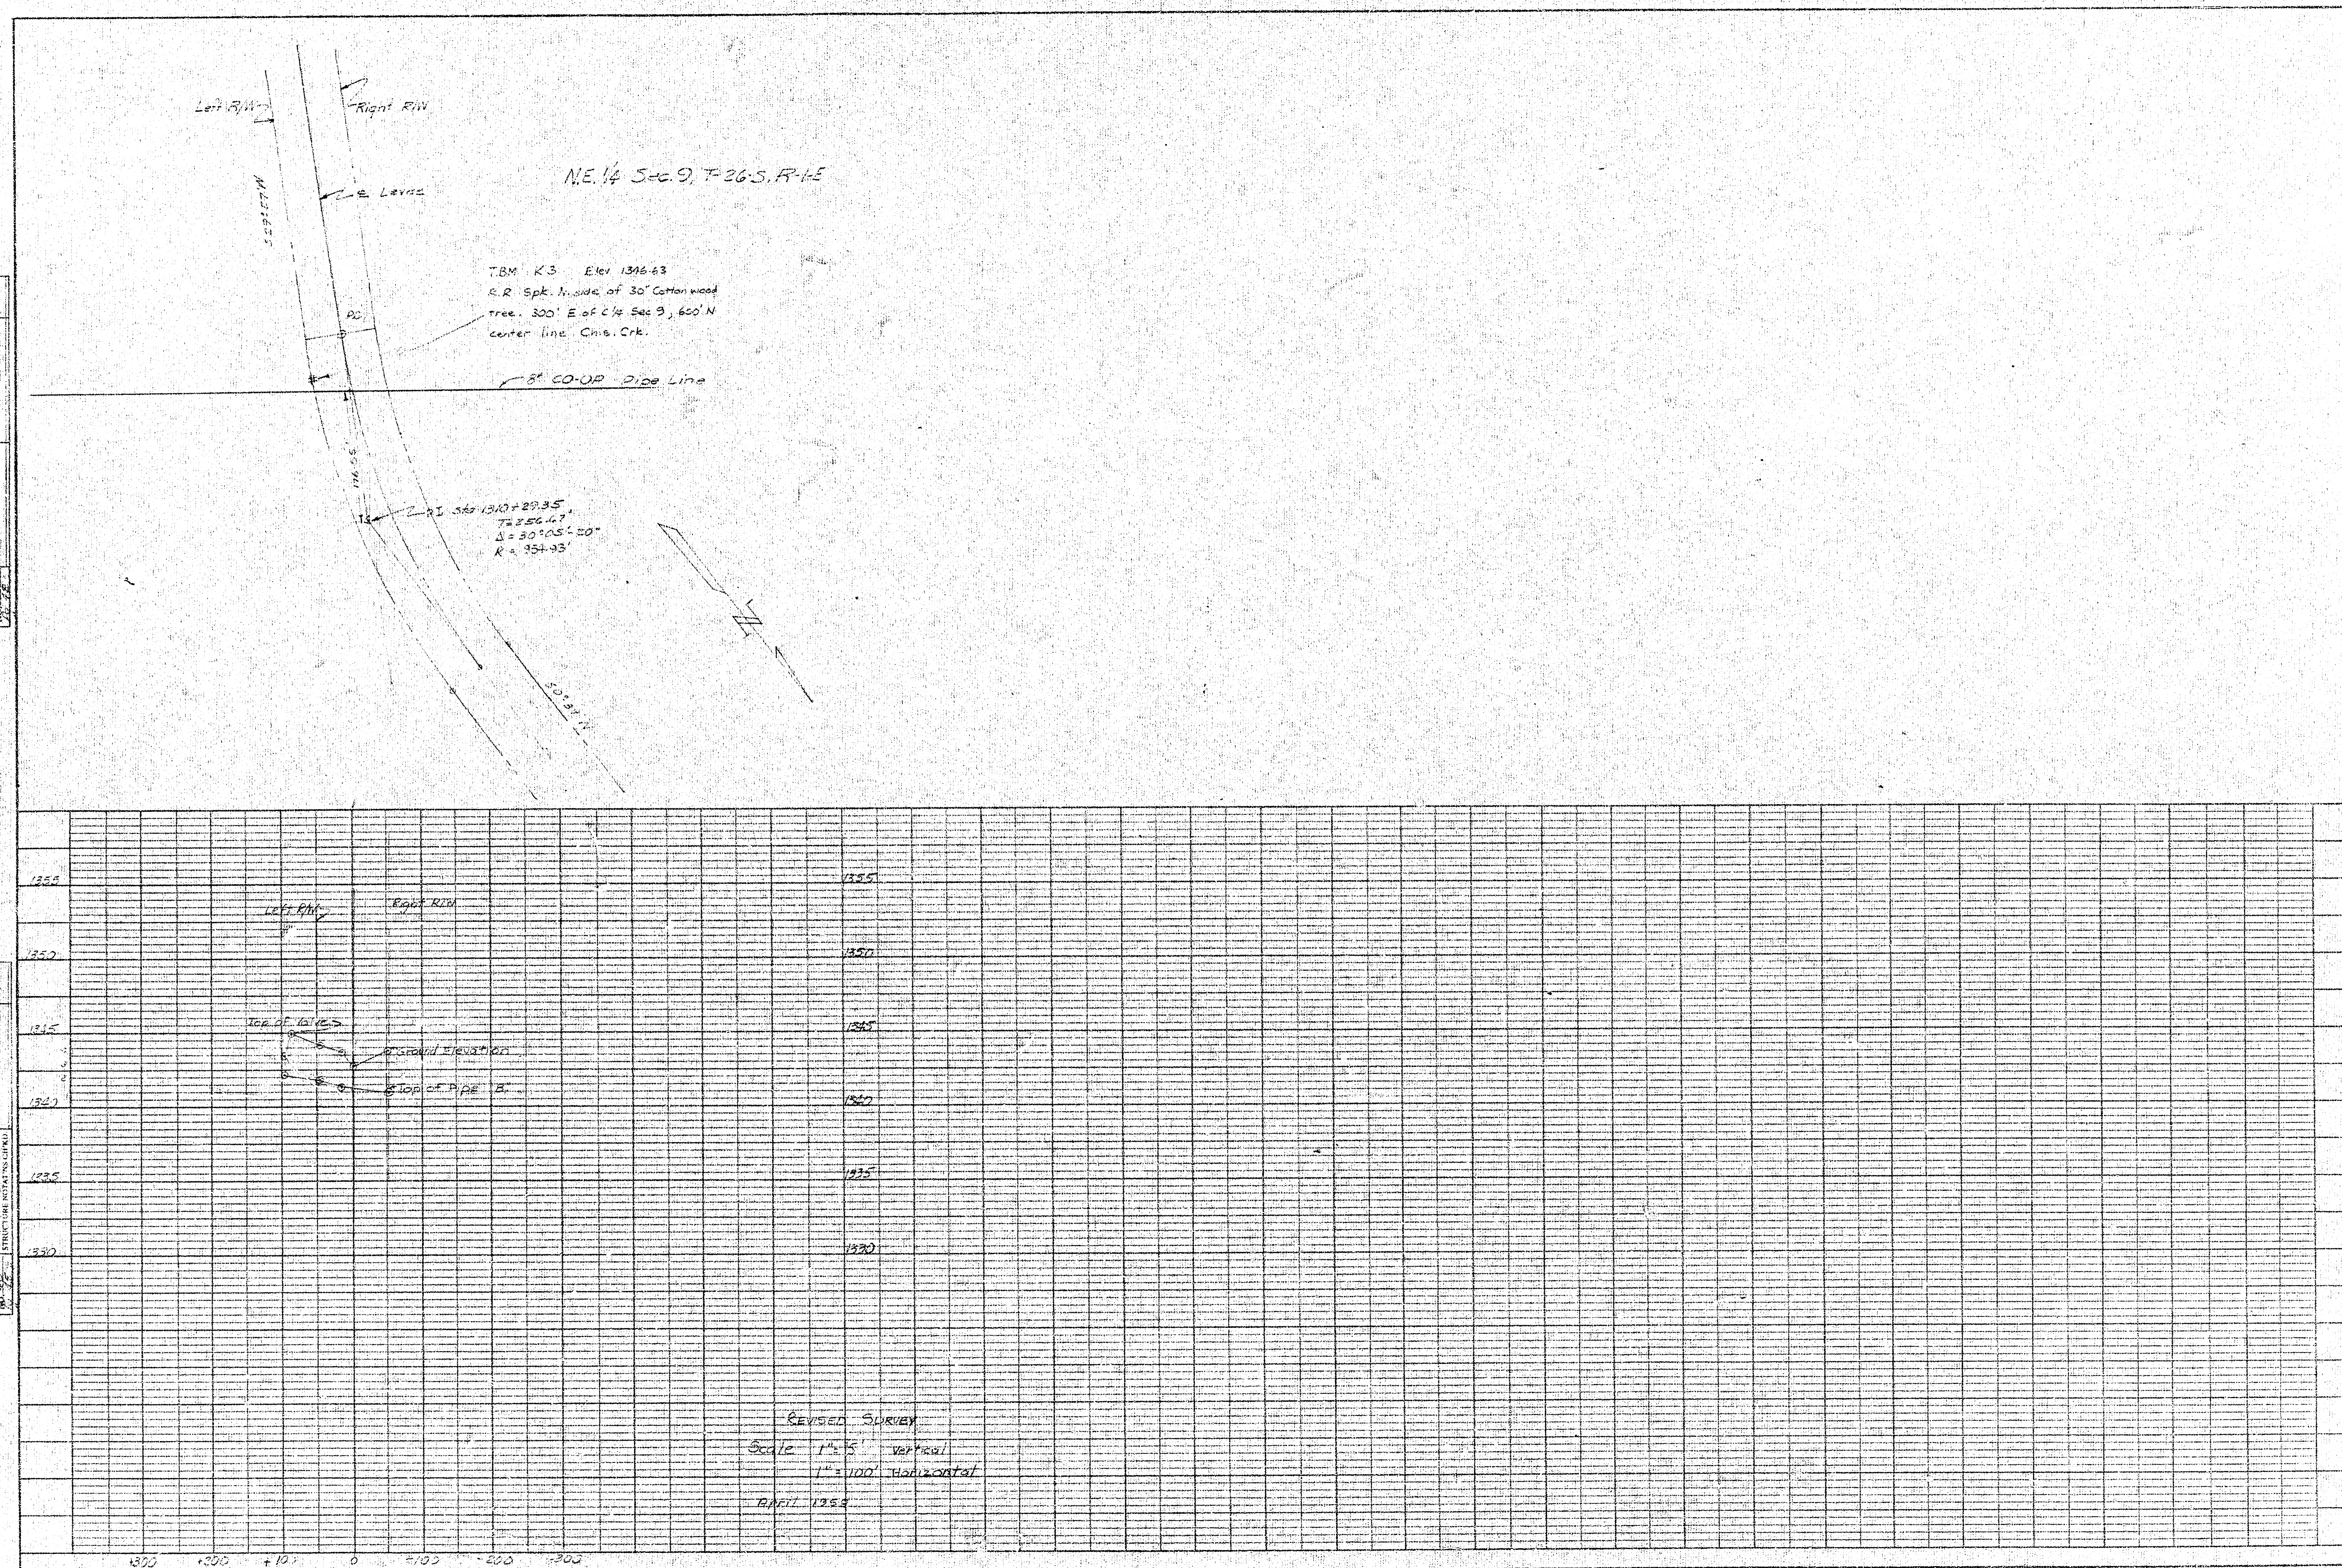


PLATE 1. PLAN - PROFILE & P. & R. E.
SURVEYING ENGINEER, S. F. H.

CO-OP