



PLAN
 1. Scale
 2. Date
 3. Name
 4. Title
 5. Location
 6. Notes

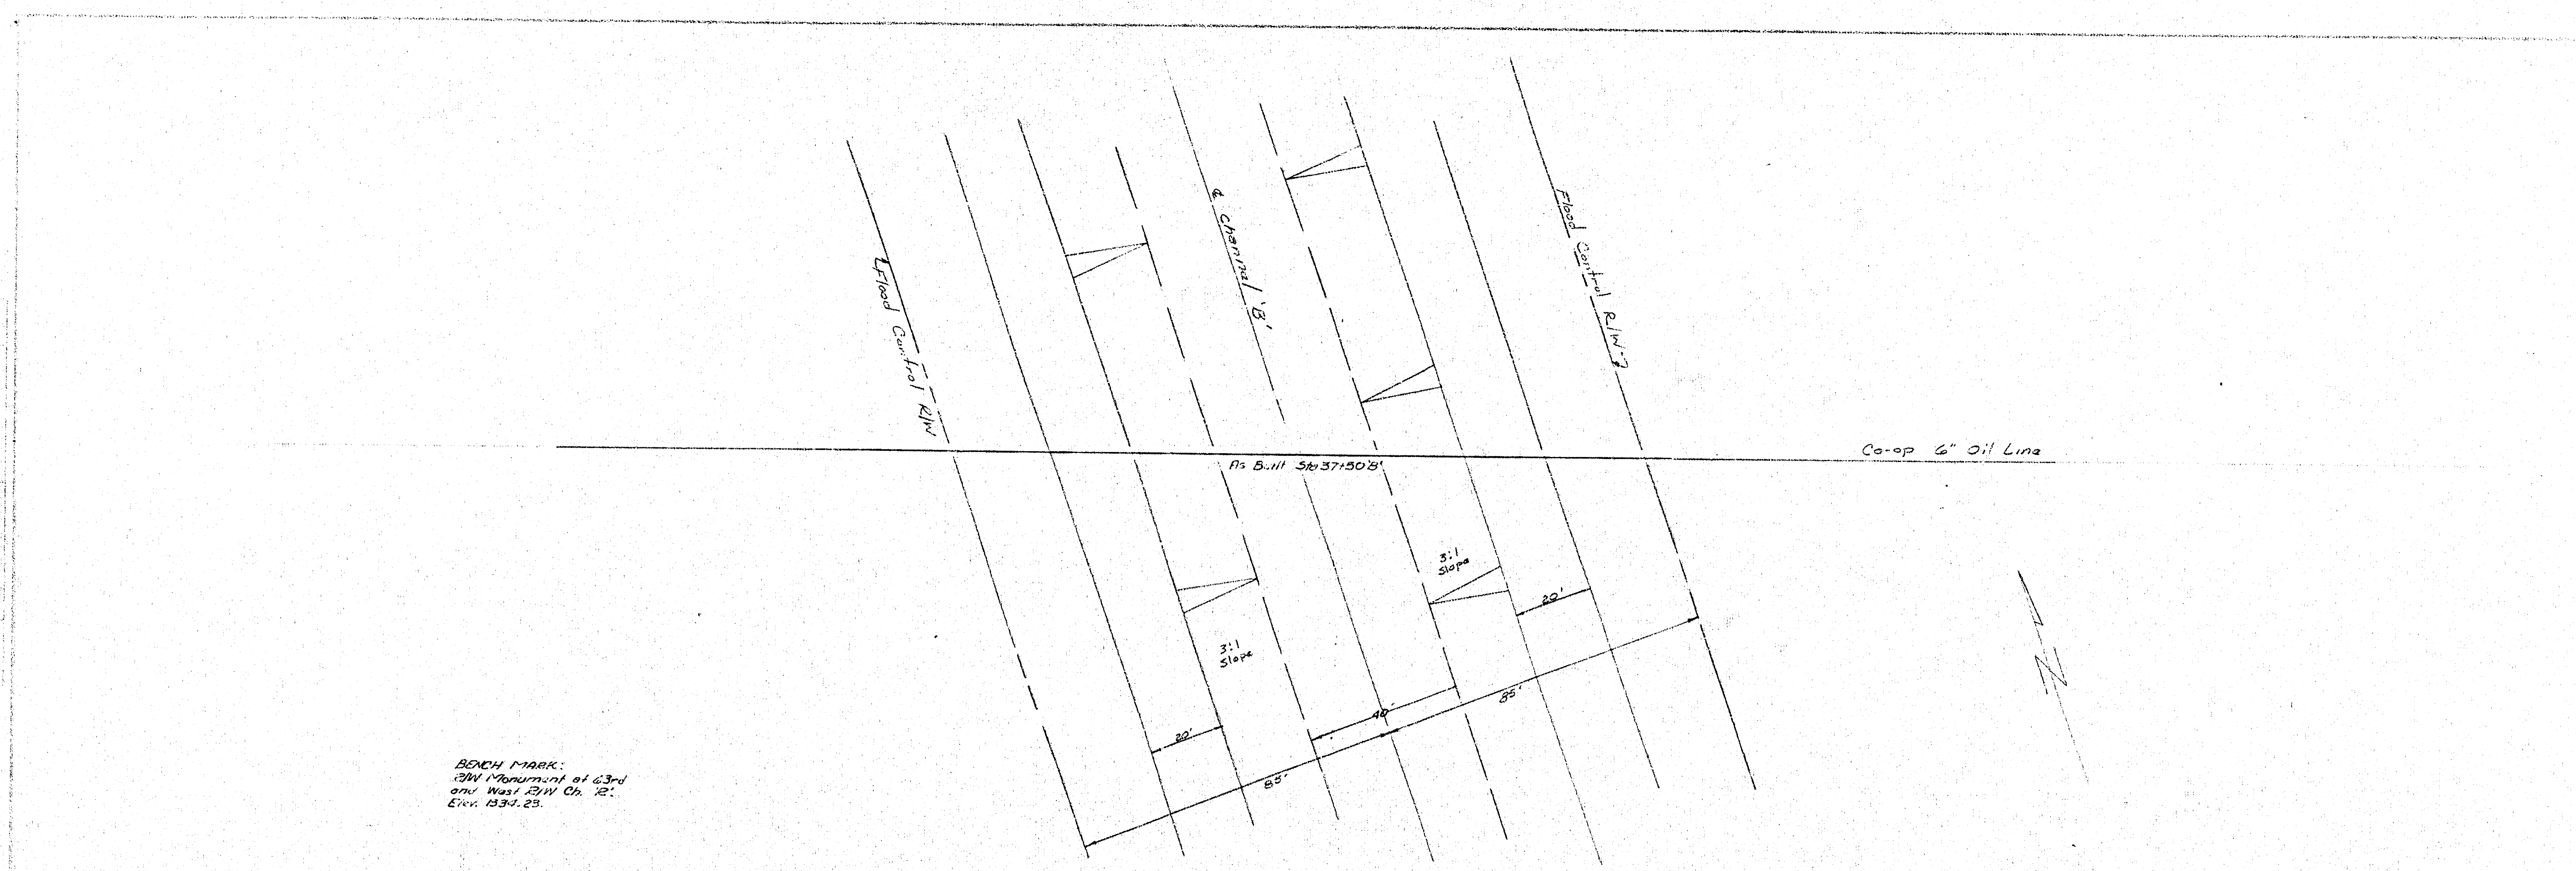


BENCH MARK:
 2nd Monument at 63rd
 and West 2nd St. 12.
 Elev. 1331.25


PROFILE
 1. Scale
 2. Date
 3. Name
 4. Title
 5. Location
 6. Notes

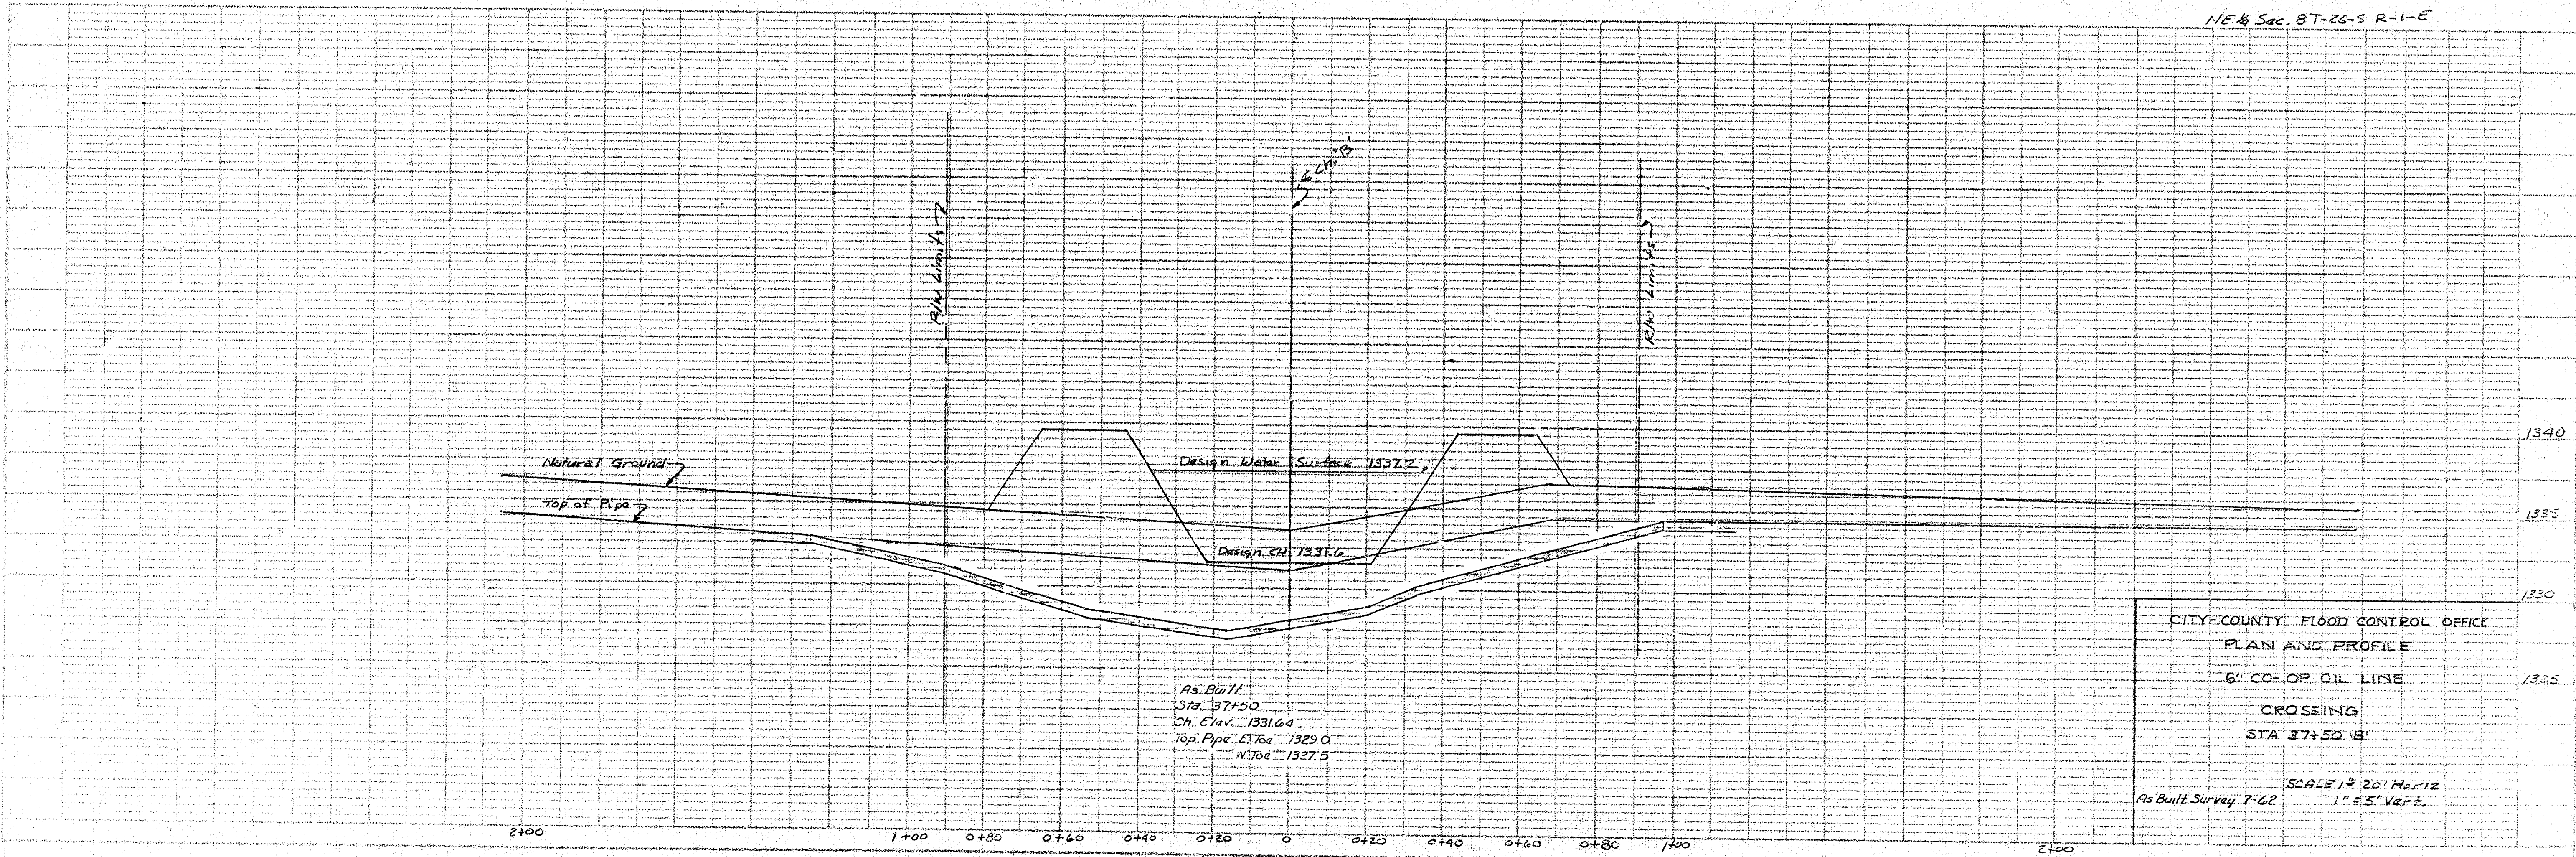

As Built
 Sta. 37+50.0
 Ch. Elev. 1331.64
 Top Pipe 6762 1325.0
 W. 764 1327.5


CITY-COUNTY FLOOD CONTROL OFFICE
 PLAN AND PROFILE
 6\"/>

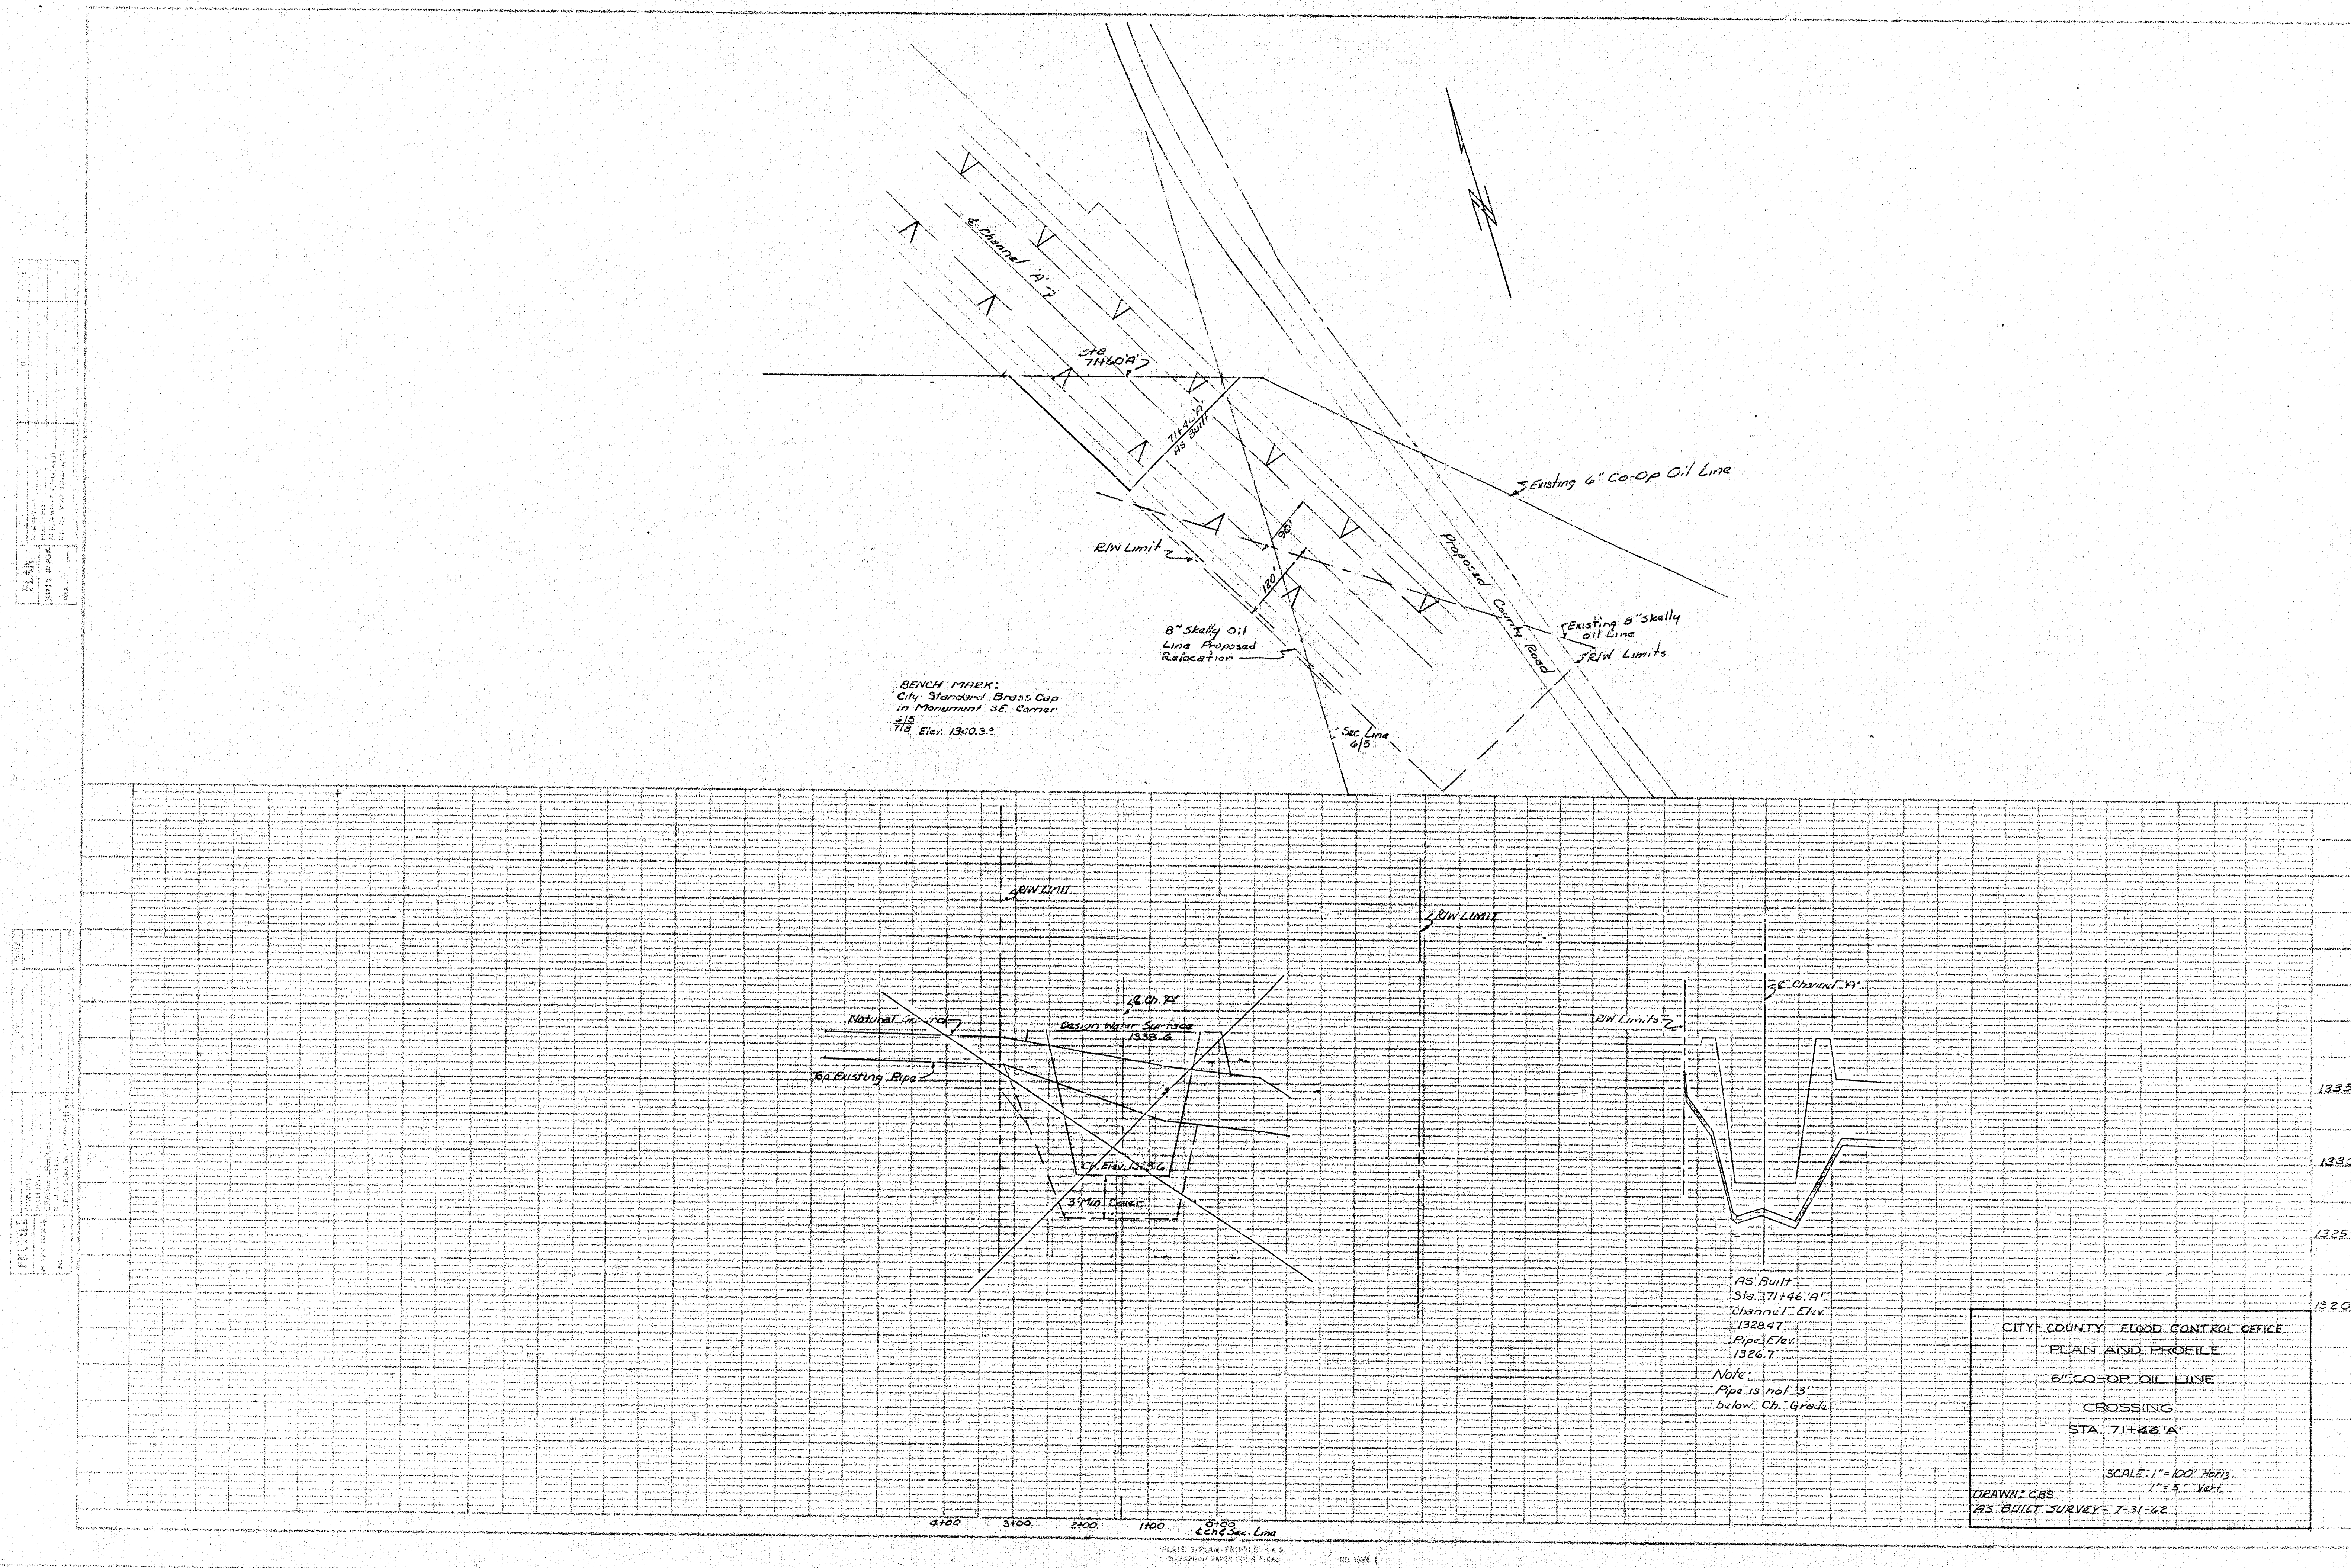

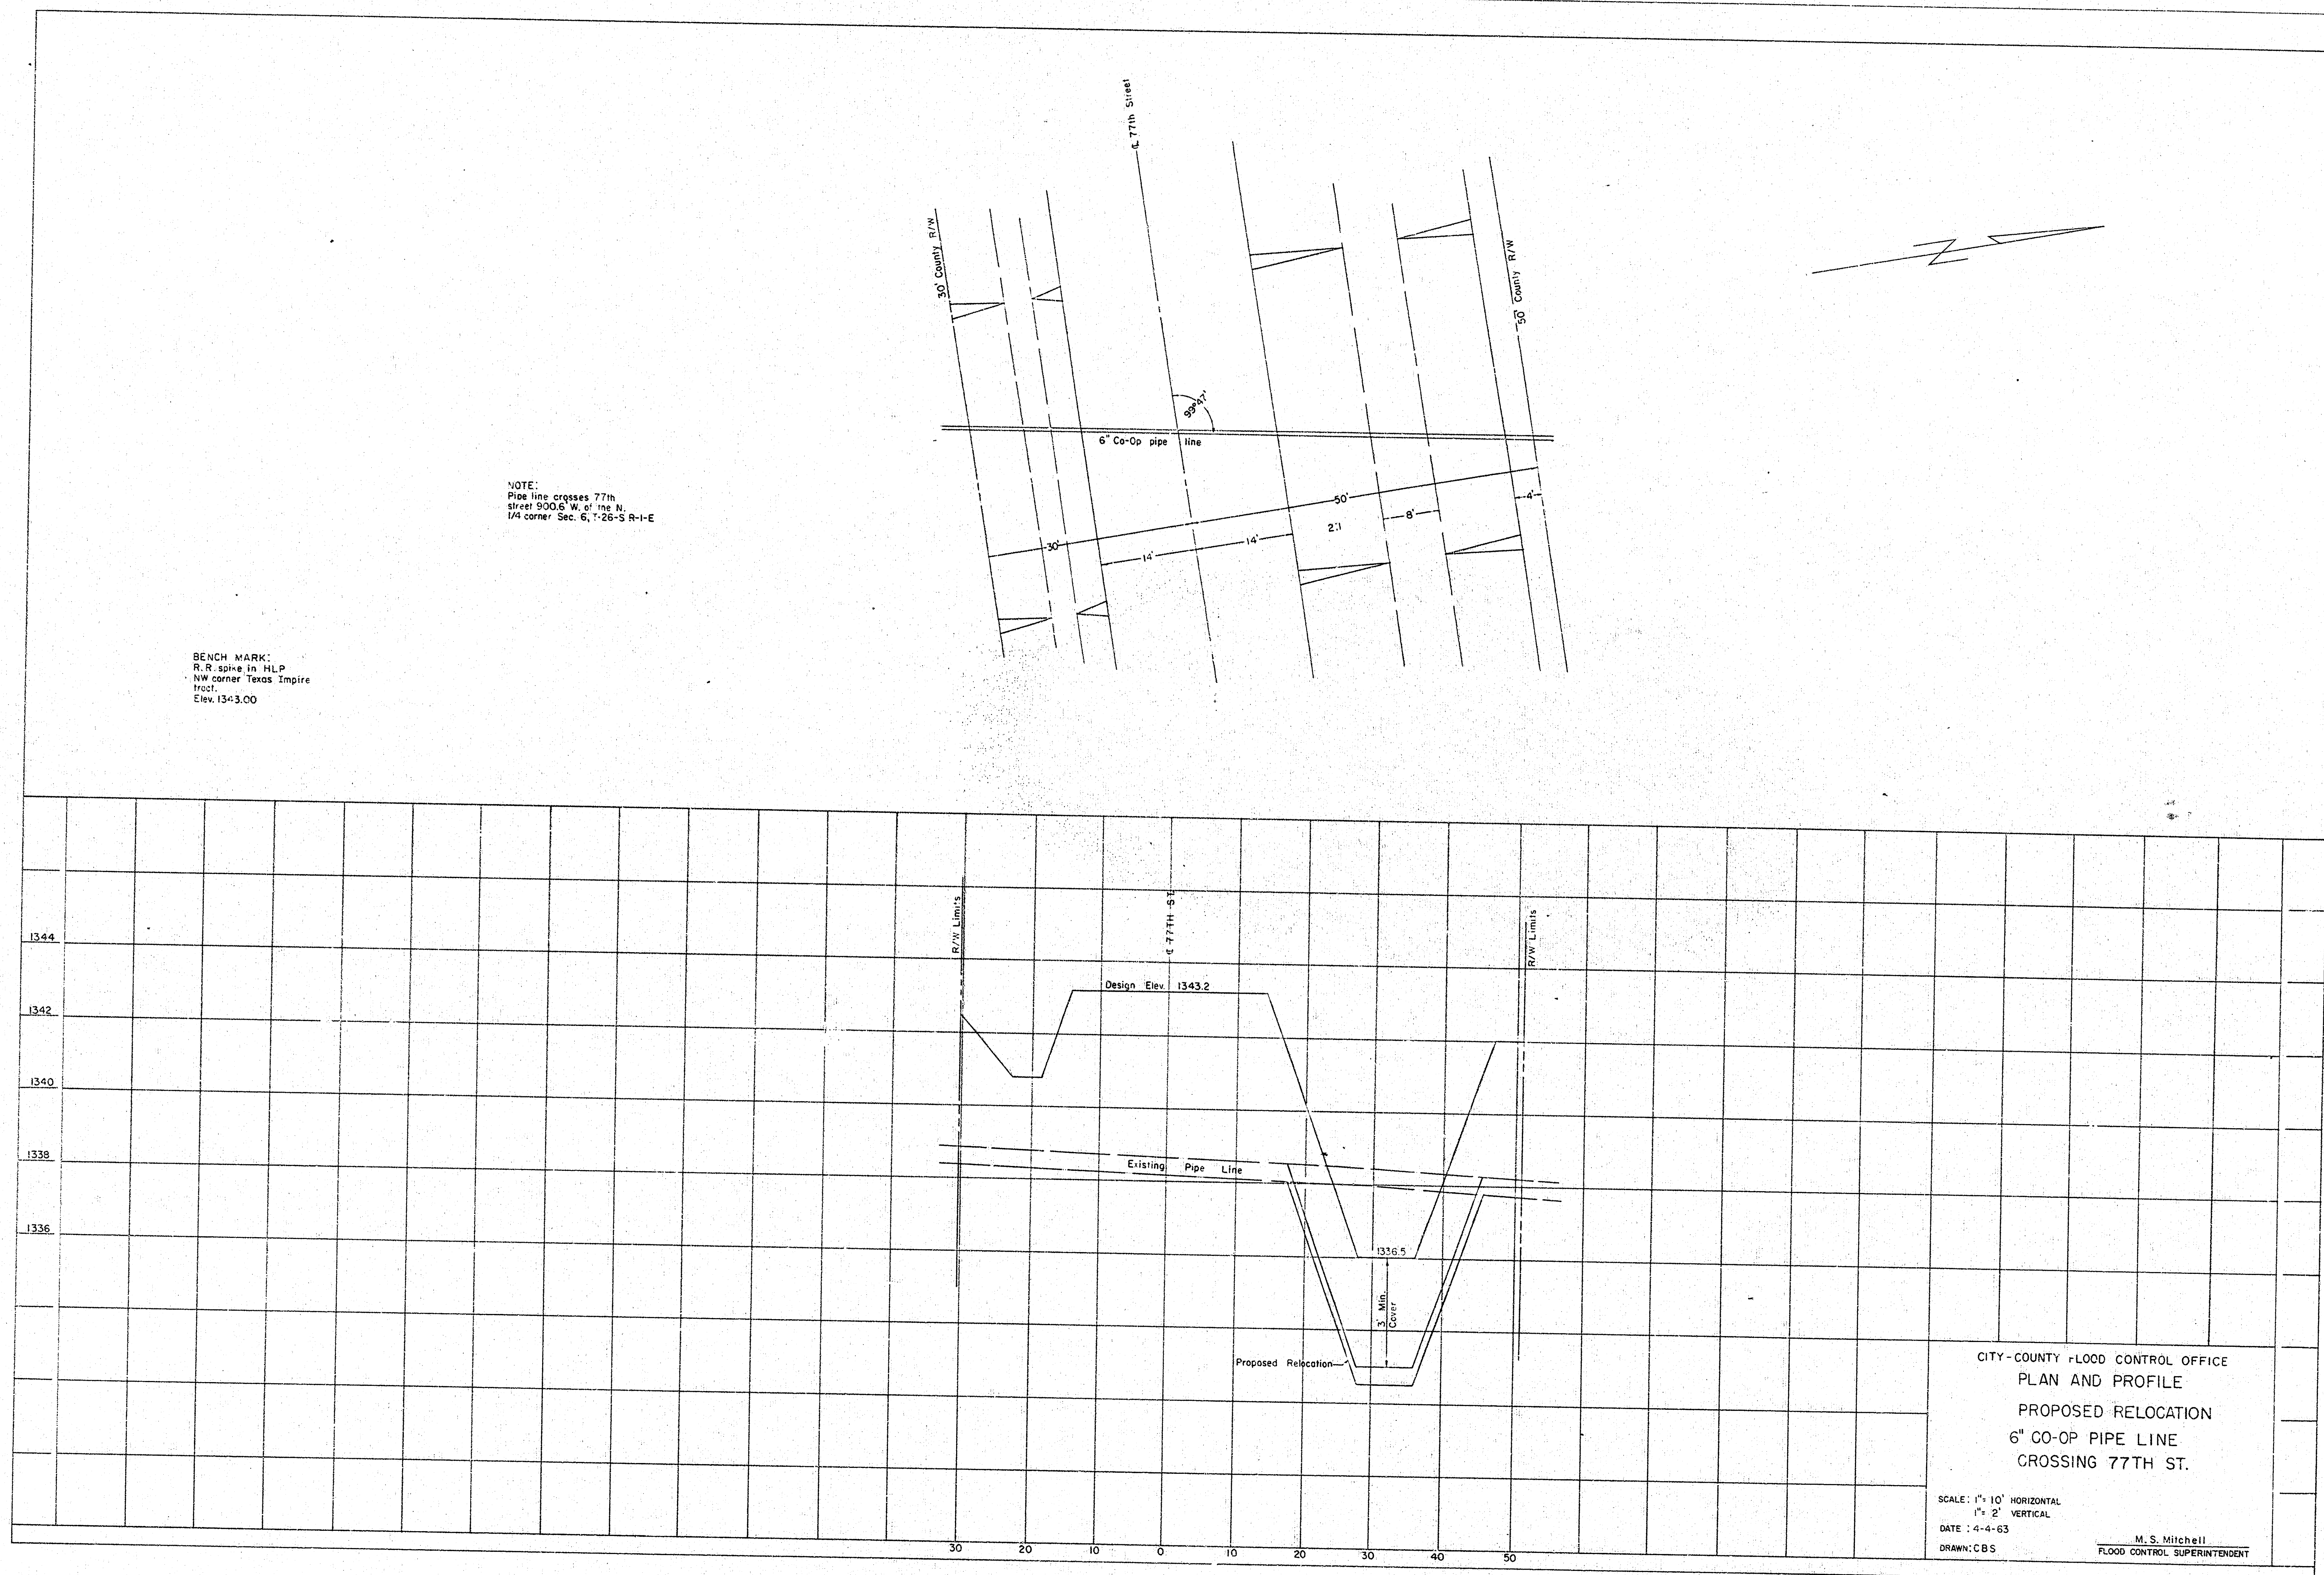

PLAN	DATE	BY
	3/12/54	W.H. HARRIS
NOTE BOOK	ALIGNED CURVE	
	PT. OF WAY CURVE	
NO. 16		

PROFILE	DATE	BY
	3/12/54	W.H. HARRIS
NOTE BOOK	ALIGNED CURVE	
	PT. OF WAY CURVE	
NO. 16		

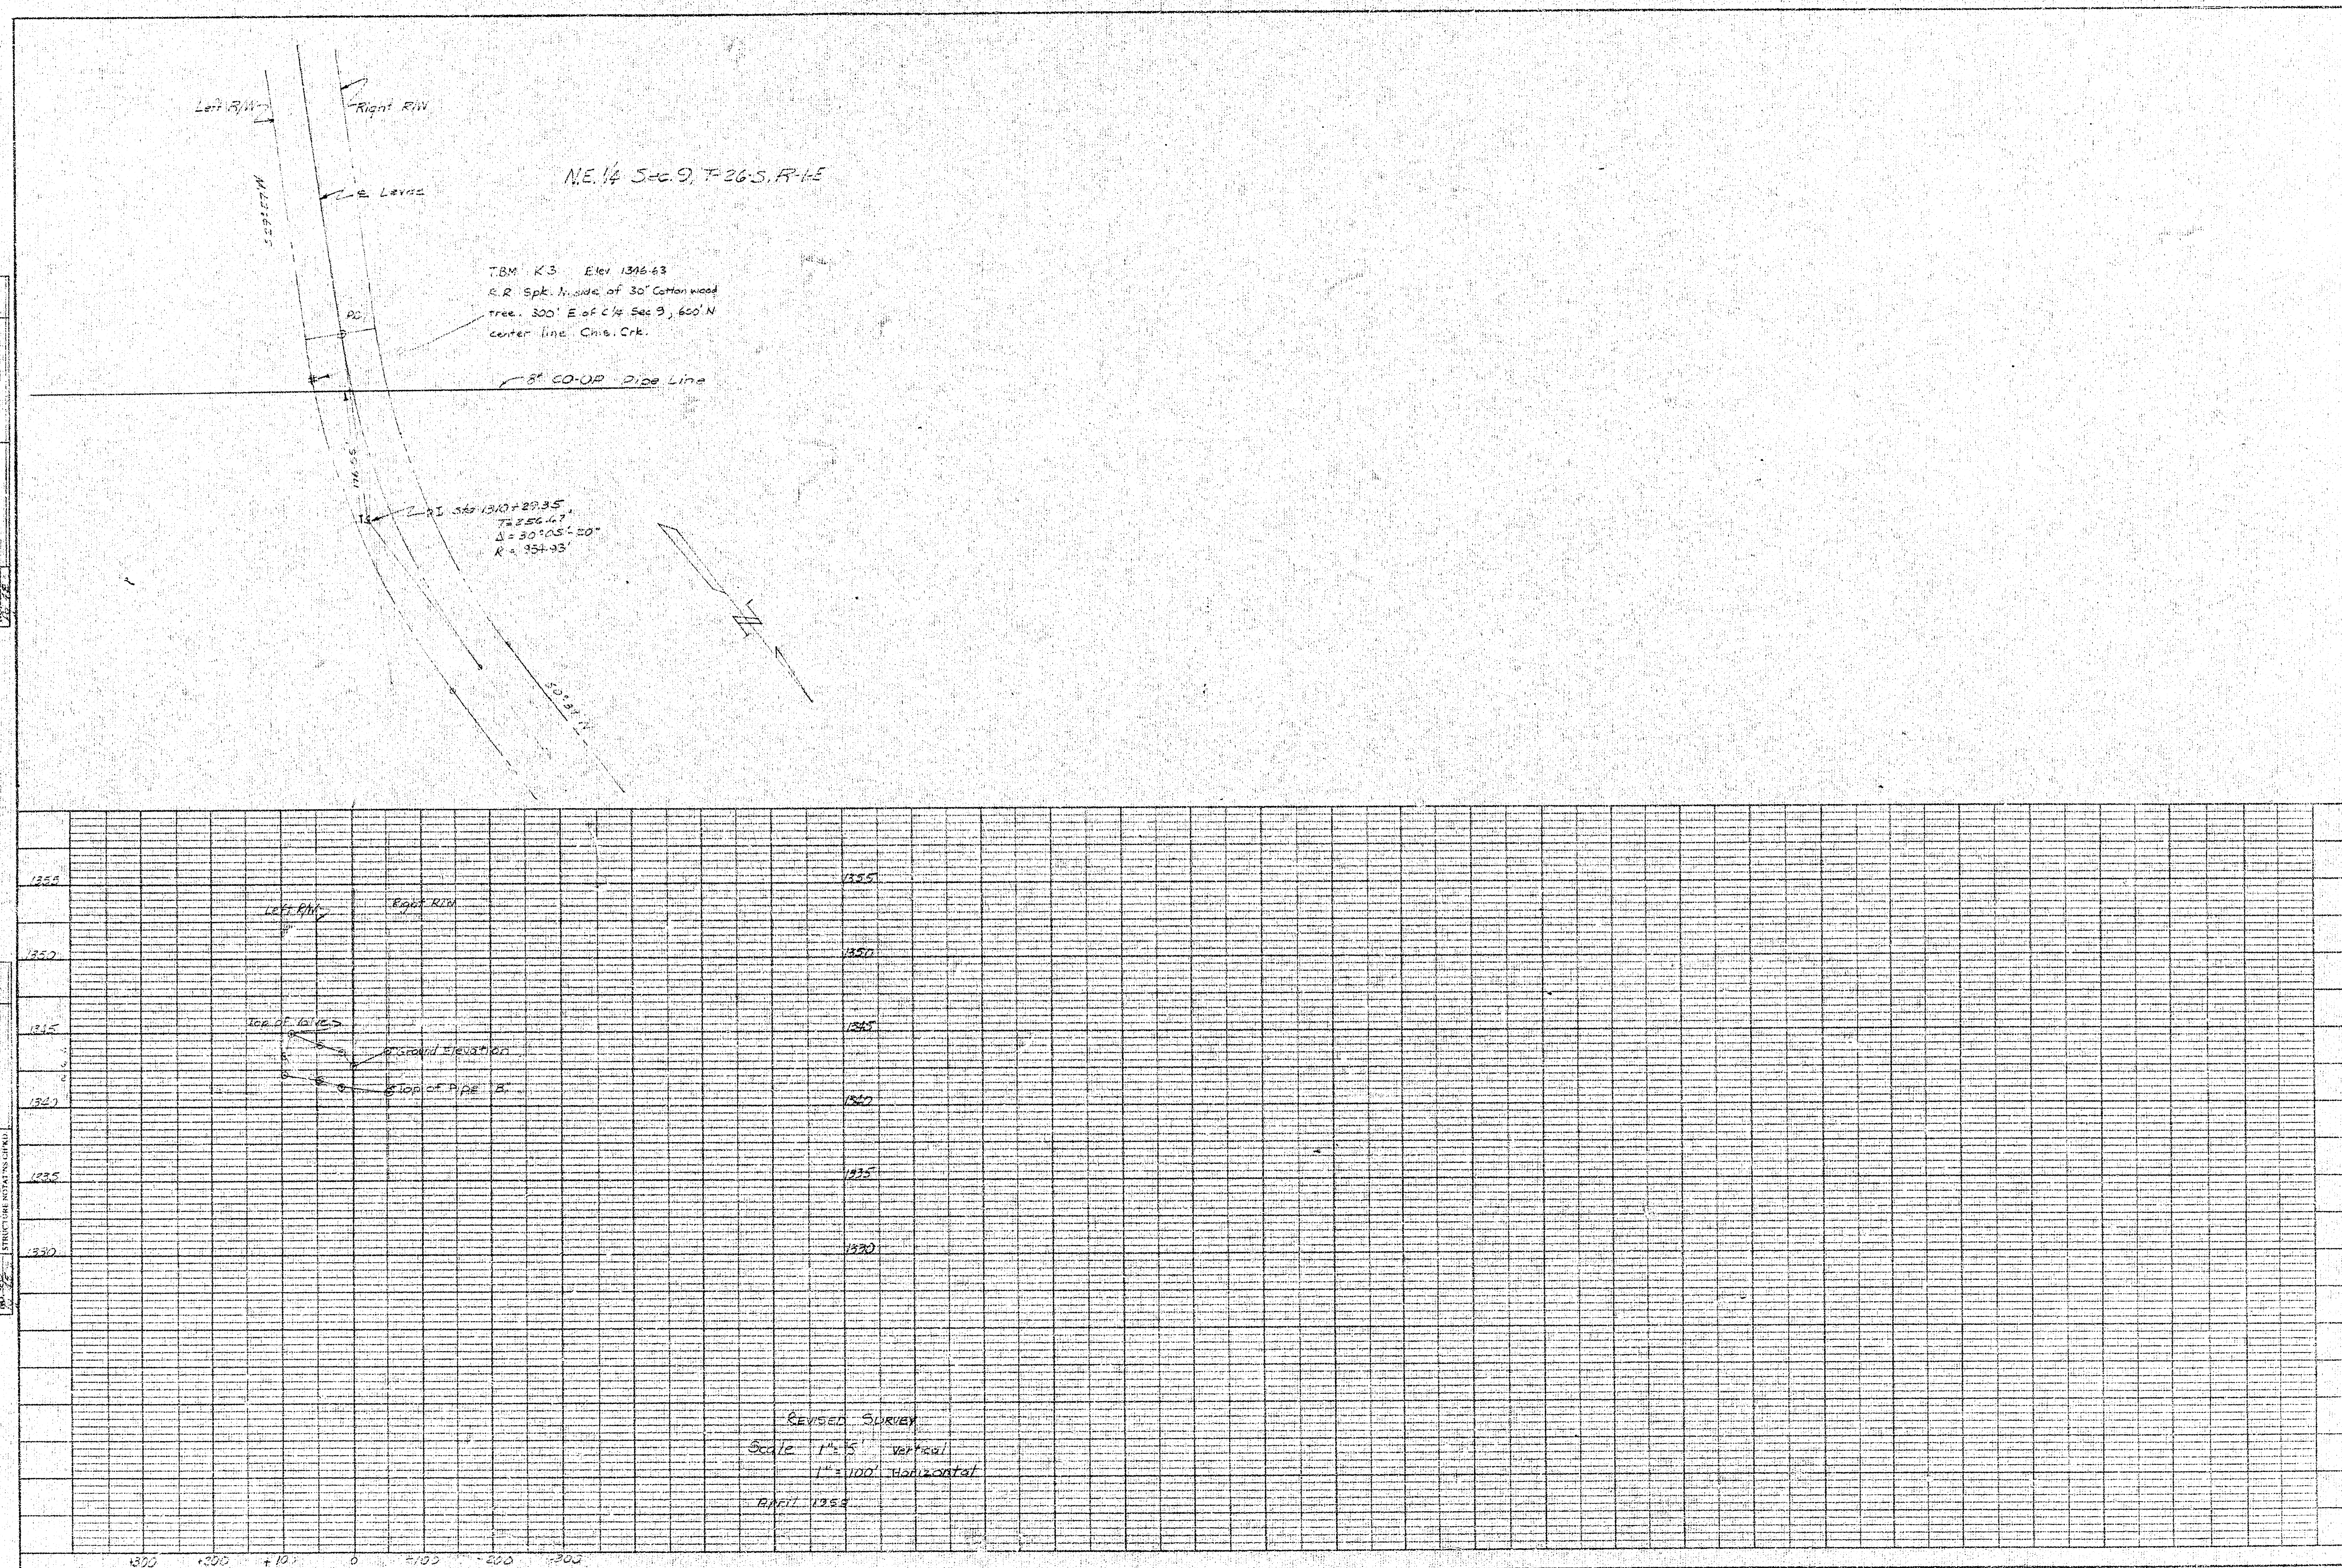

CO-OP