

SCALE  
1" = 40'

CONSTRUCT STD. CITY OF WICHITA  
TYPE 1A CURB INLET  
L = 6'4" W = 4'4"  
TOP ELEV. = 74.60  
FLOOR ELEV. = 70.53

BOOKED  
7-18-97  
MCL  
D-352

REVISED AS BUILT 1-22-97 SCR (PHASE 2 S.W.S. ONLY)

**SITE GRADING PLAN - PHASE II**  
**RIVER OAKS MOBILE HOME PARK**  
**WICHITA, KANSAS**

**SRB** 924 NORTH MAIN 318-264-8004  
WICHITA, KANSAS 67203 FAX 264-4623

**SAVOY, RUGGLES & BOHM, P. A.**  
ENGINEERING & SURVEYING


PROJECT NUMBER

DESIGN KWE	DATE 7-12-96	UTILITY TCR	SRB JOB 531E
---------------	-----------------	----------------	-----------------

NOTE: Low edge curbs to be constructed on the south side of Campus. See detail, Sheet 5.

TYPICAL DITCH CROSS-SECTION



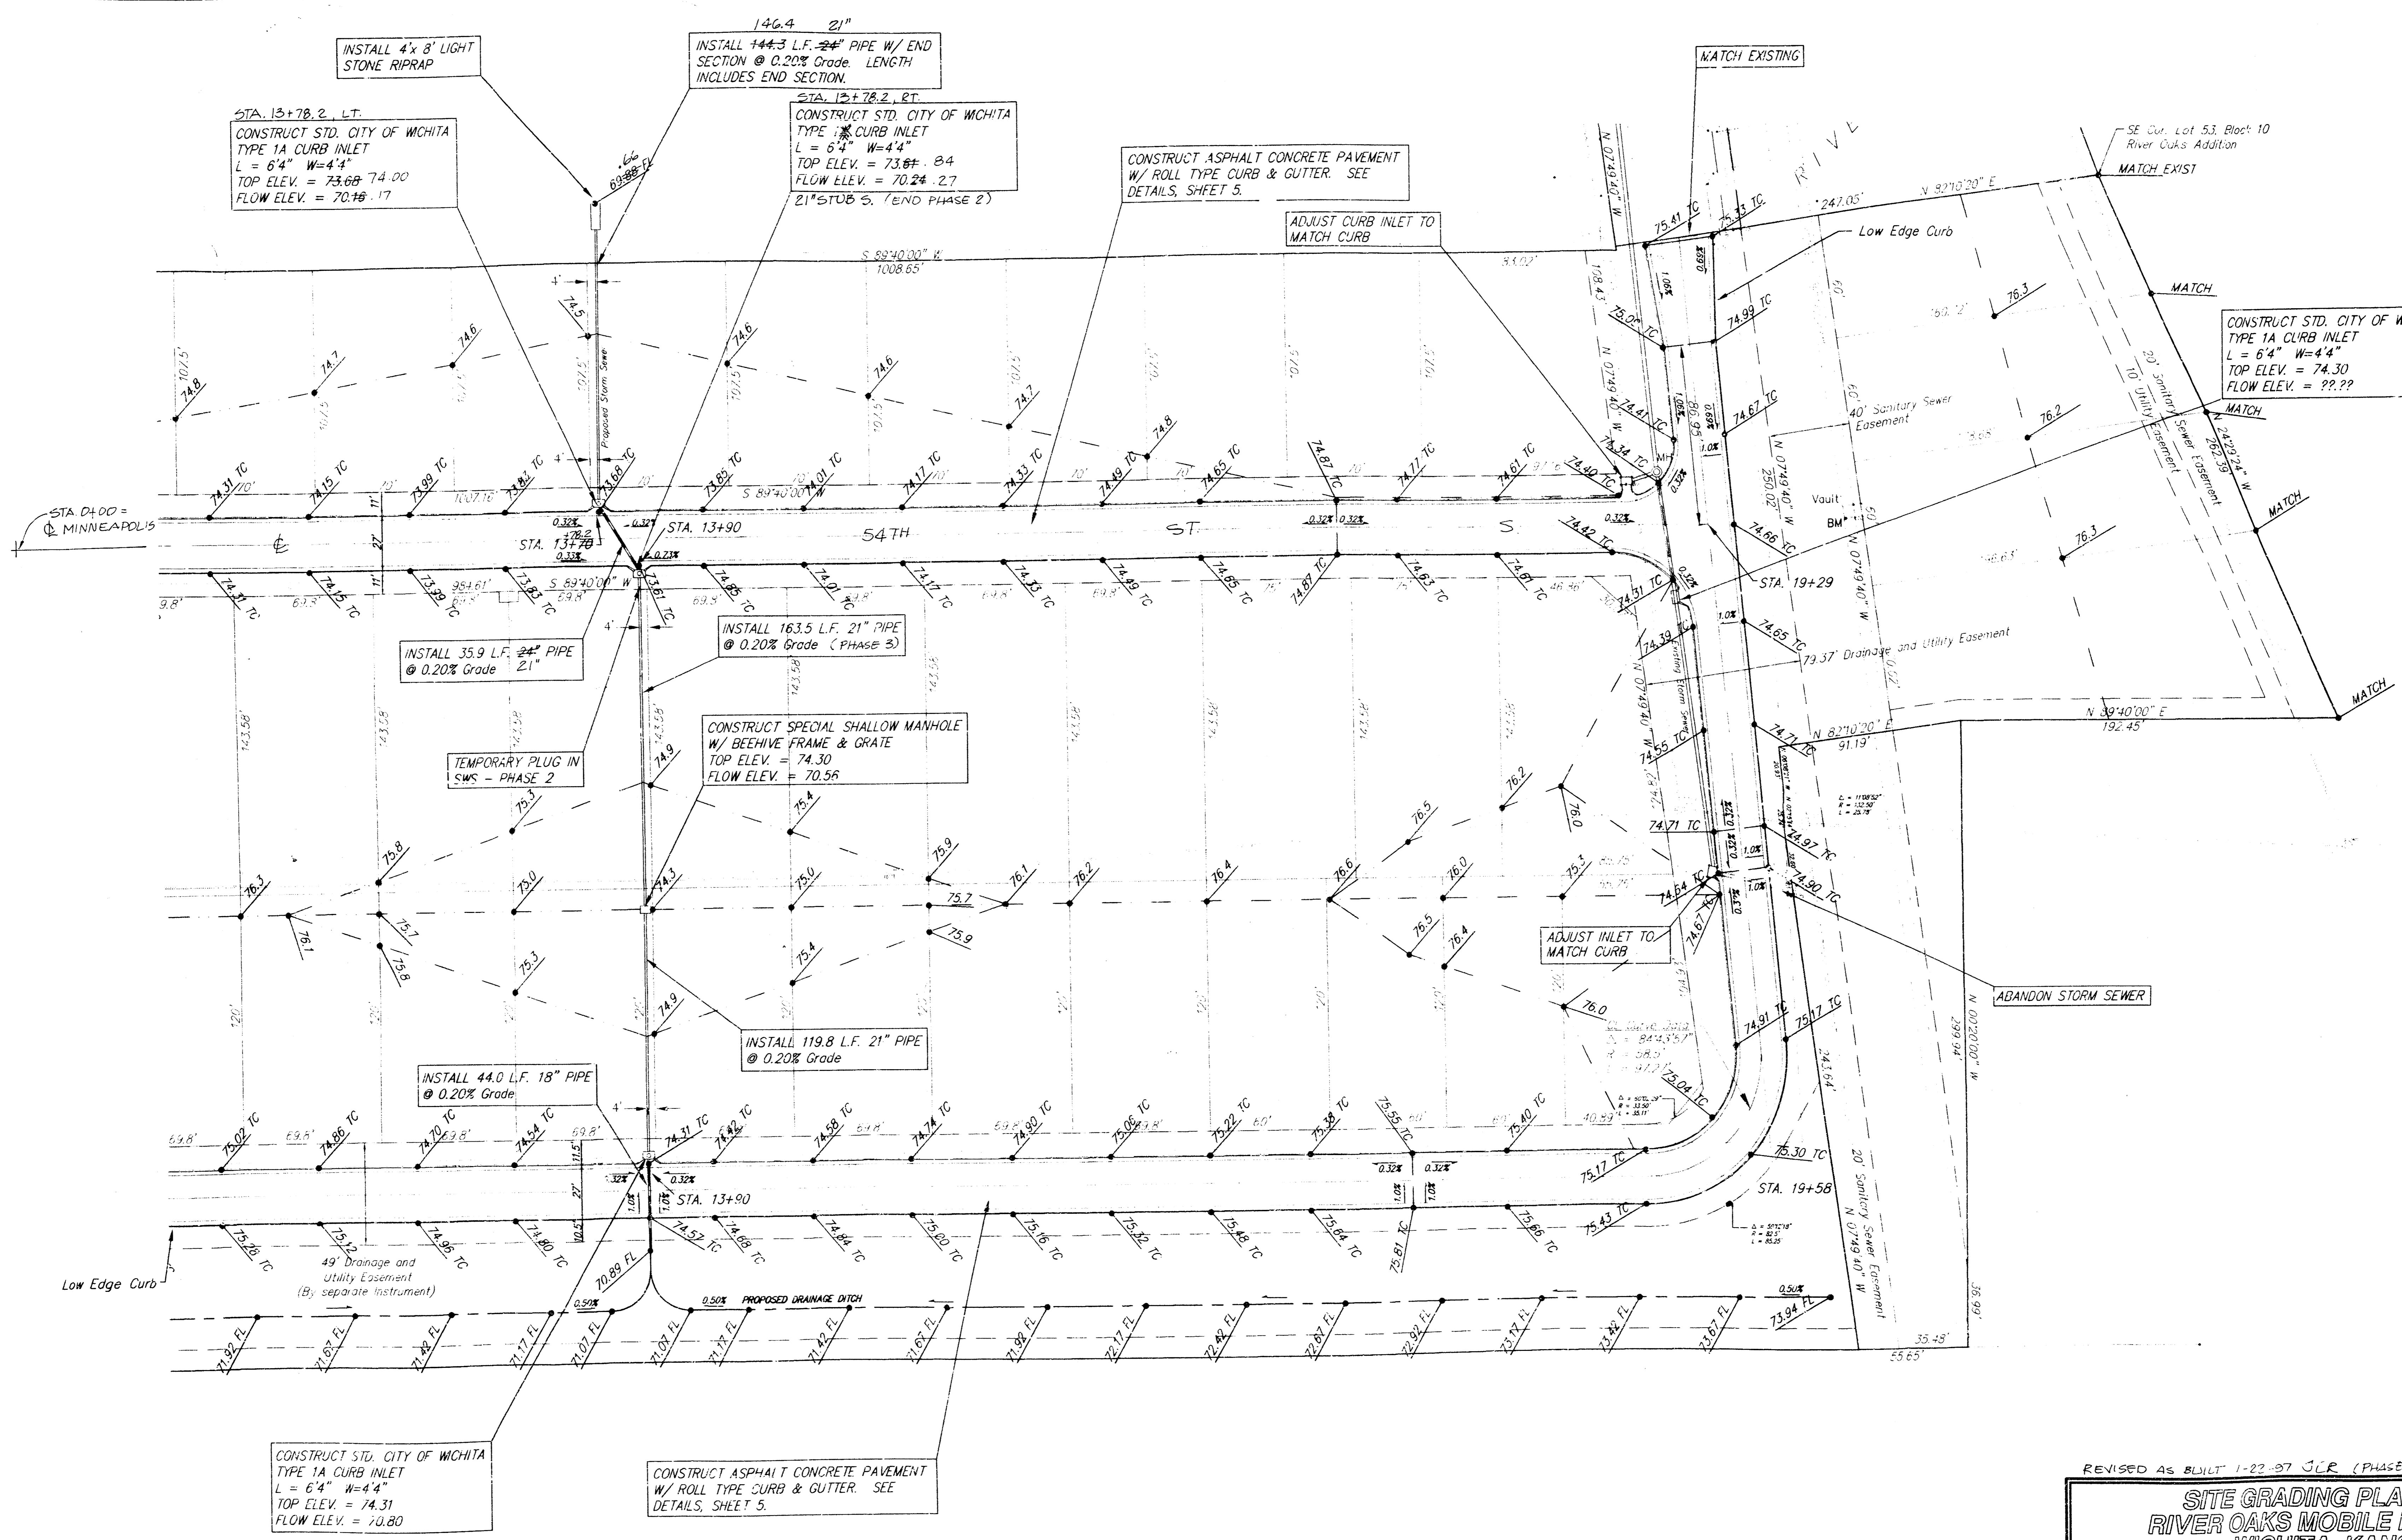

NOTE: Low edge curb to be constructed on the south side of Campus and east side of Spruce. See detail, Sheet 5.

REVISED AS BUILT 1-22-97 J.L.R. (PHASE 2 SWS ONLY)

**SITE GRADING PLAN - PHASE II**  
**RIVER OAKS MOBILE HOME PARK**  
**WICHITA, KANSAS**

**SRB** 924 N 4TH MAIN 316-264-8303  
 107 N KANSAS 87233 FAX 316-264-4621

**SAVOY, RUGGLES & BOHM, P.A.**  
 ENGINEERING & SURVEYING

PROJECT NUMBER

DRAWN K.M.	DATE 7-12-96	UTILITY	SCALE 1" = 40'
REVIEW K.M.	DATE	UTILITY	SCALE

REVISIONS

2
5