



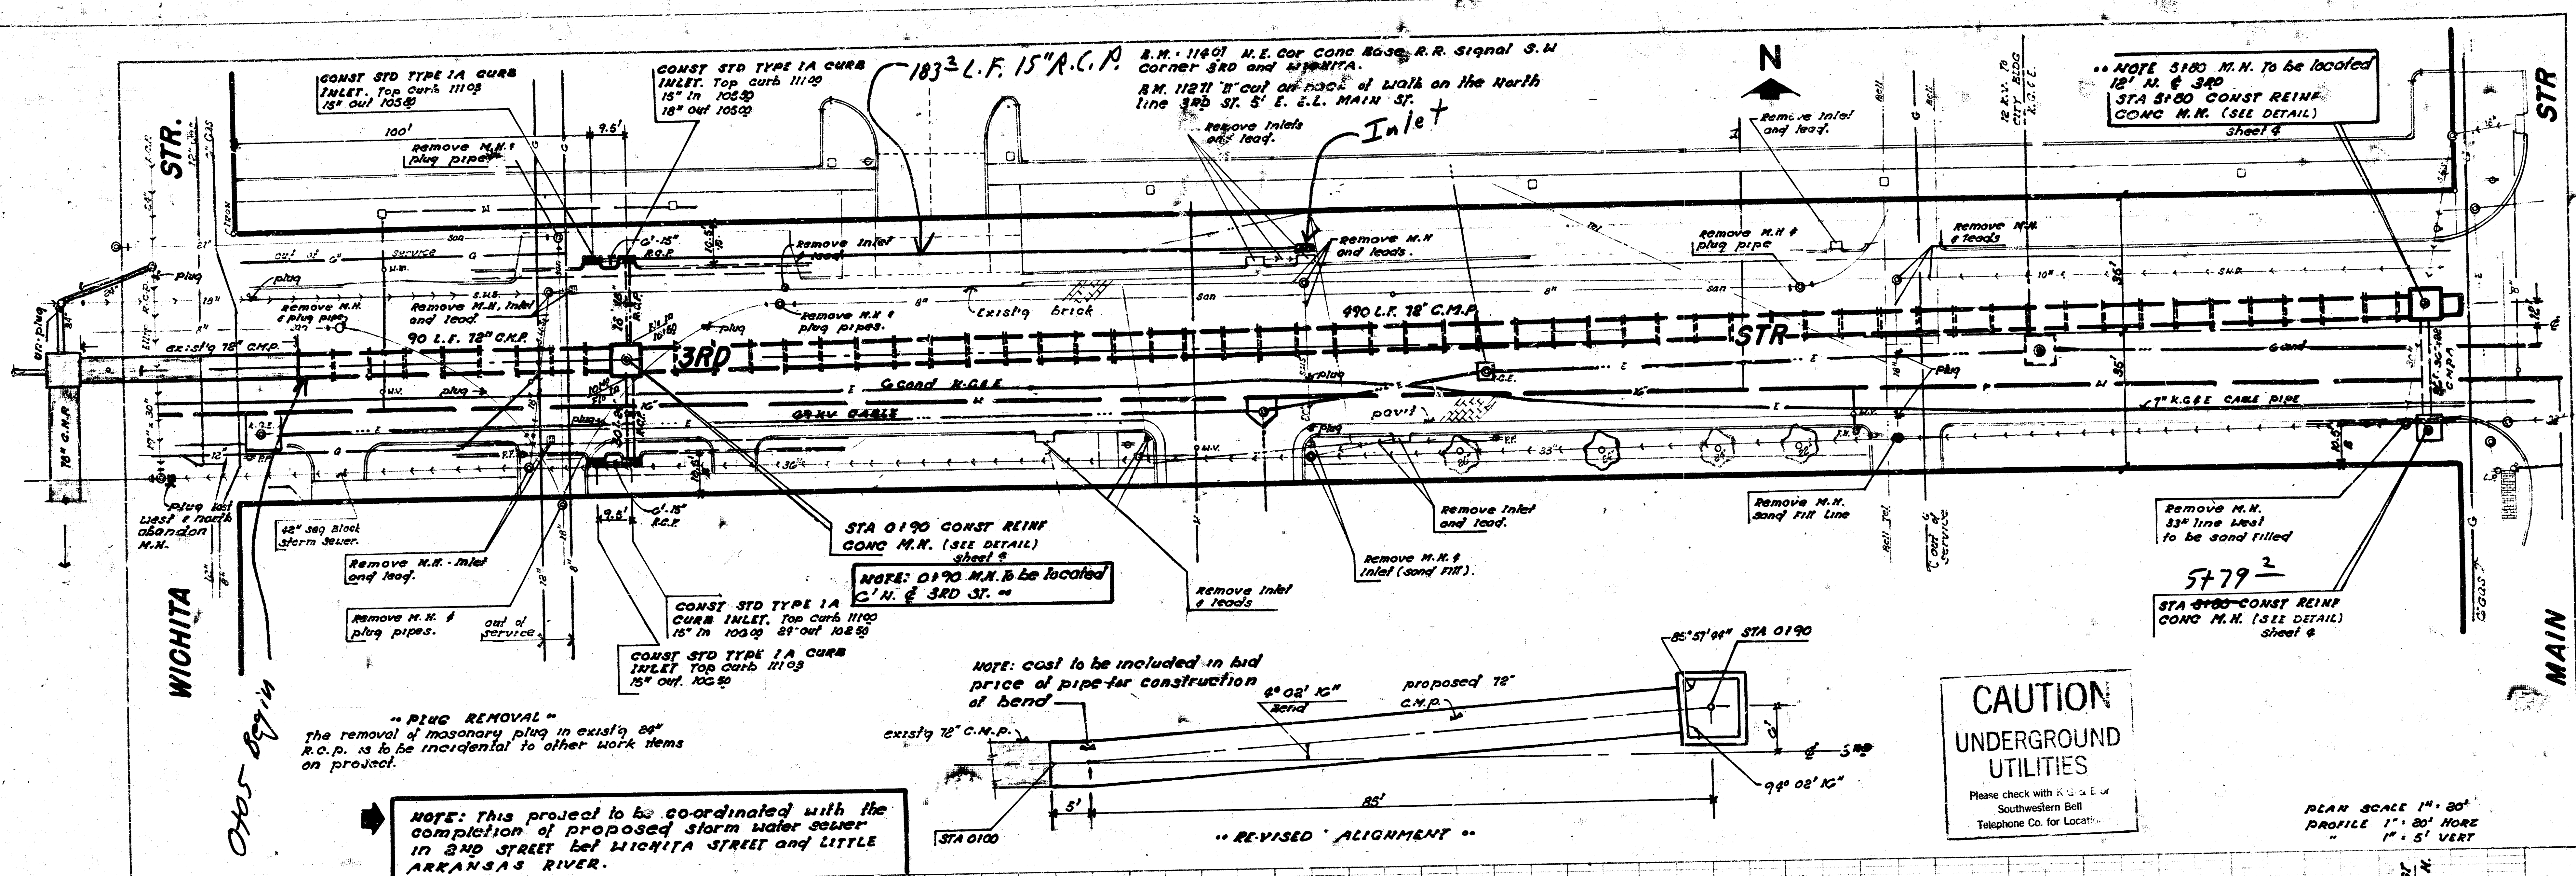


CAUTION
UNDERGROUND
UTILITIES
 Please check with K & E or
 Southwestern Bell
 Telephone Co. for Location.



PLAN SCALE 1" = 20'
 PROFILE 1" = 20' HORIZ
 " 1" = 5' VERT

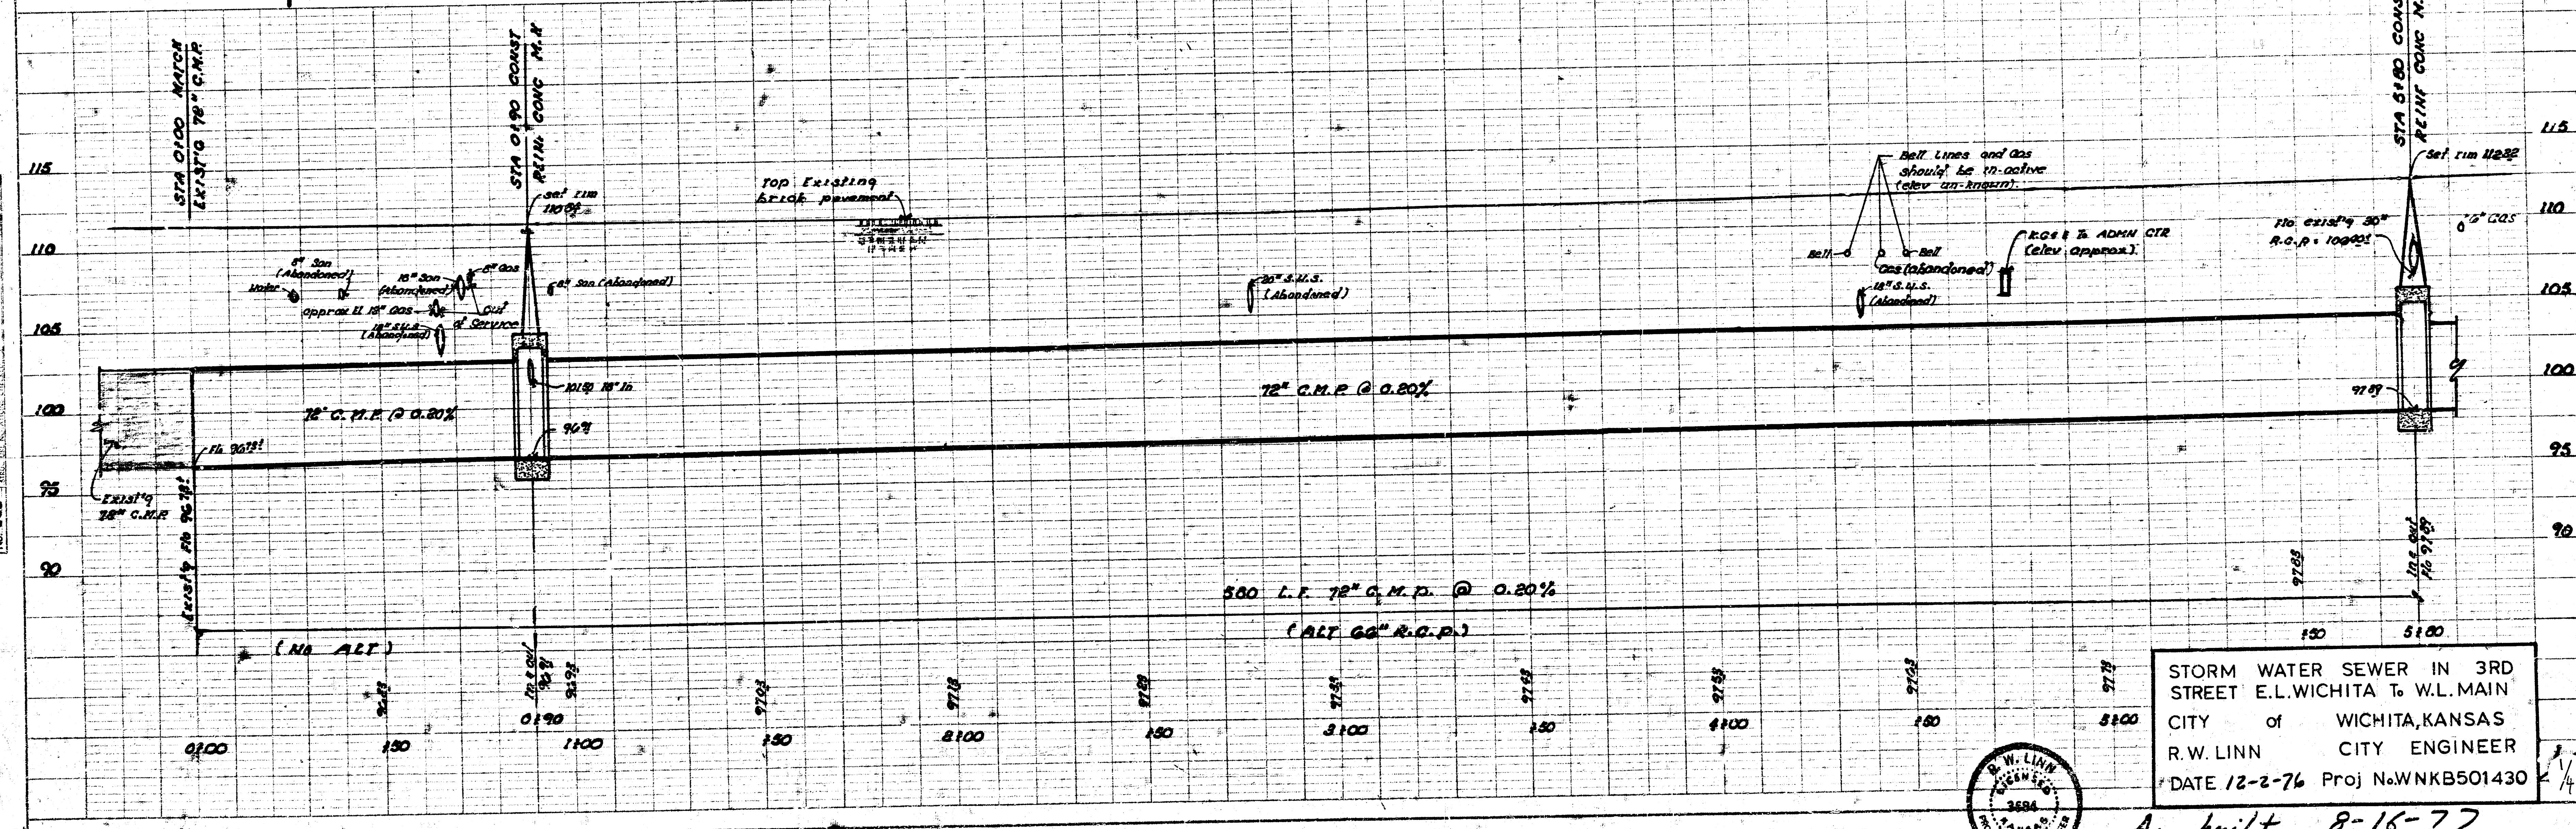

STORM WATER SEWER IN 3RD
 STREET E.L. WICHITA TO W.L. MAIN
 CITY of WICHITA, KANSAS
 R.W. LINN CITY ENGINEER
 DATE 12-2-76 Proj No. WNK501430


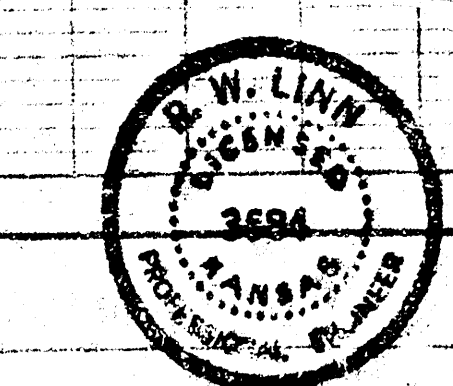


As built 8-16-77

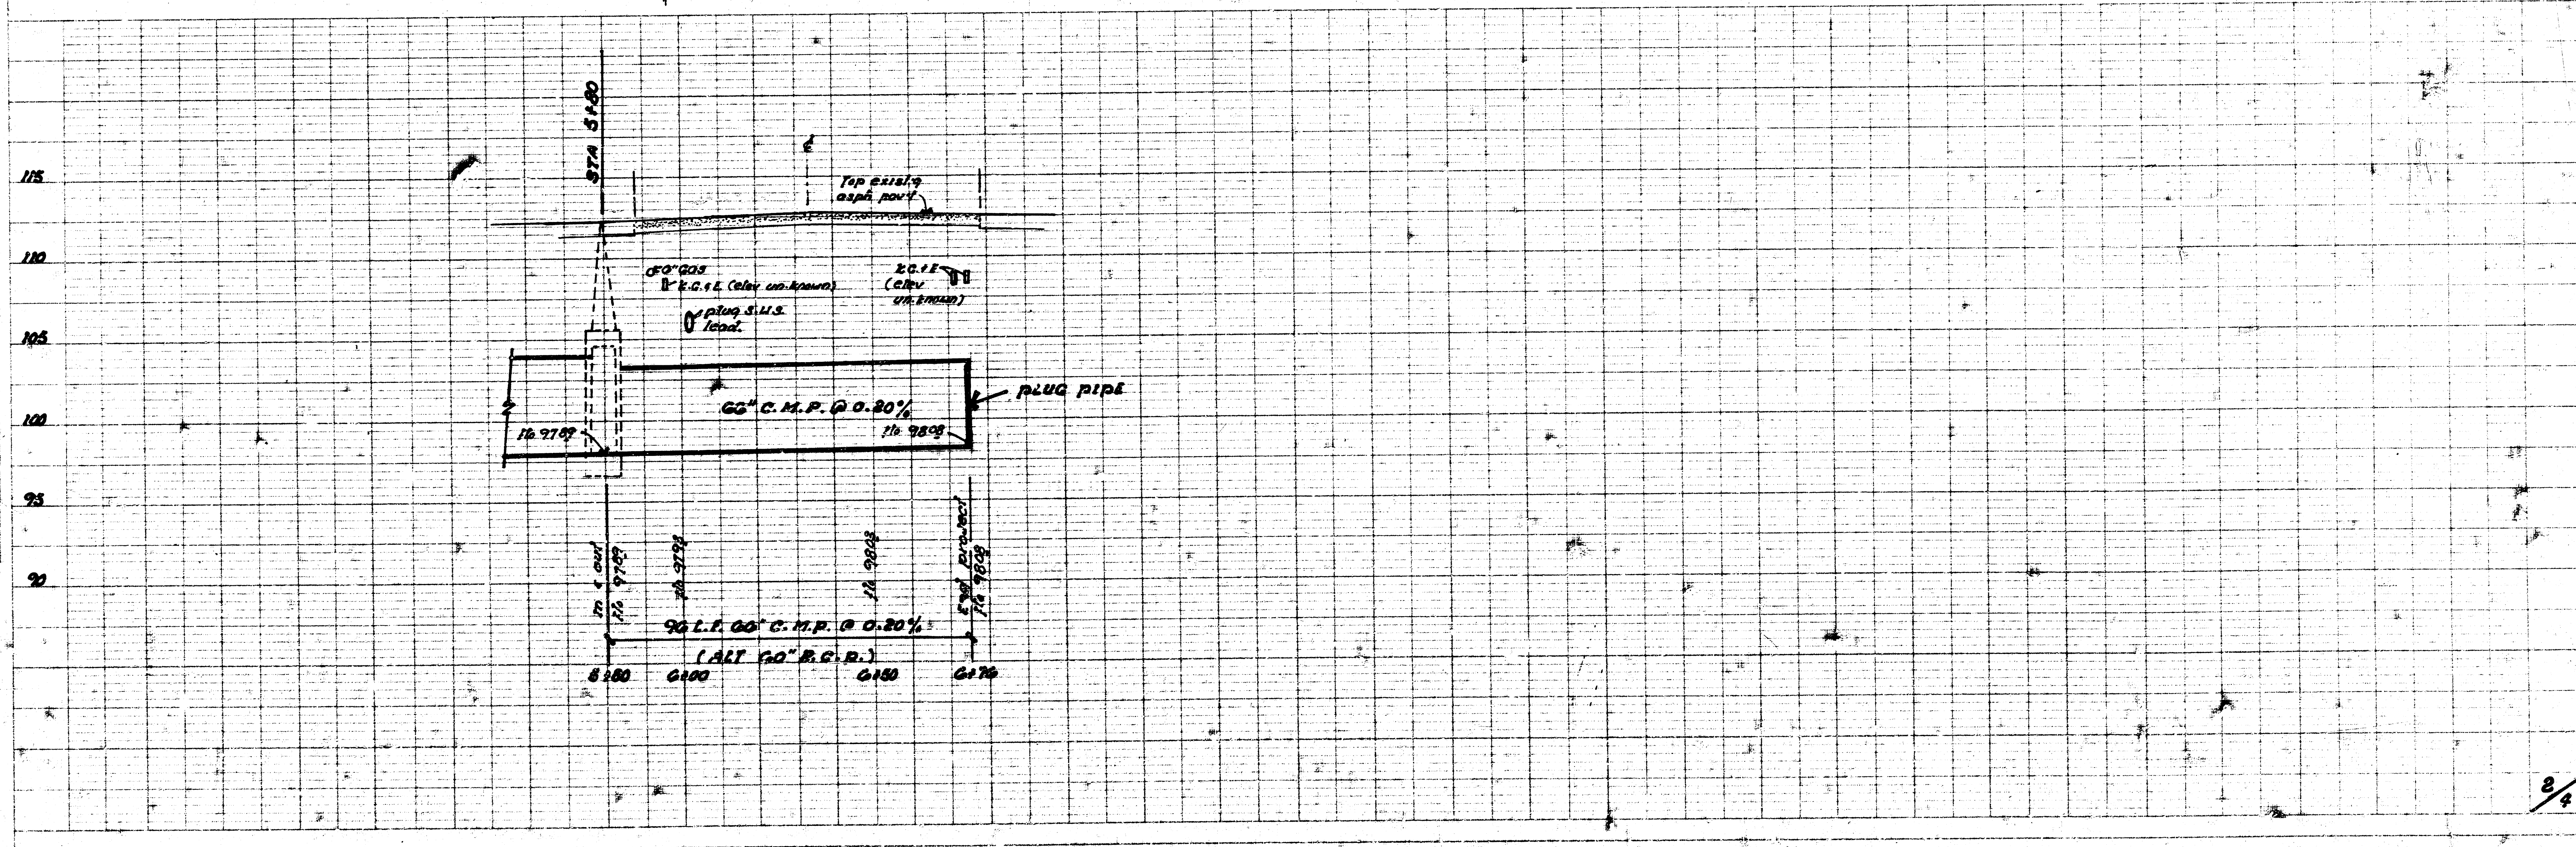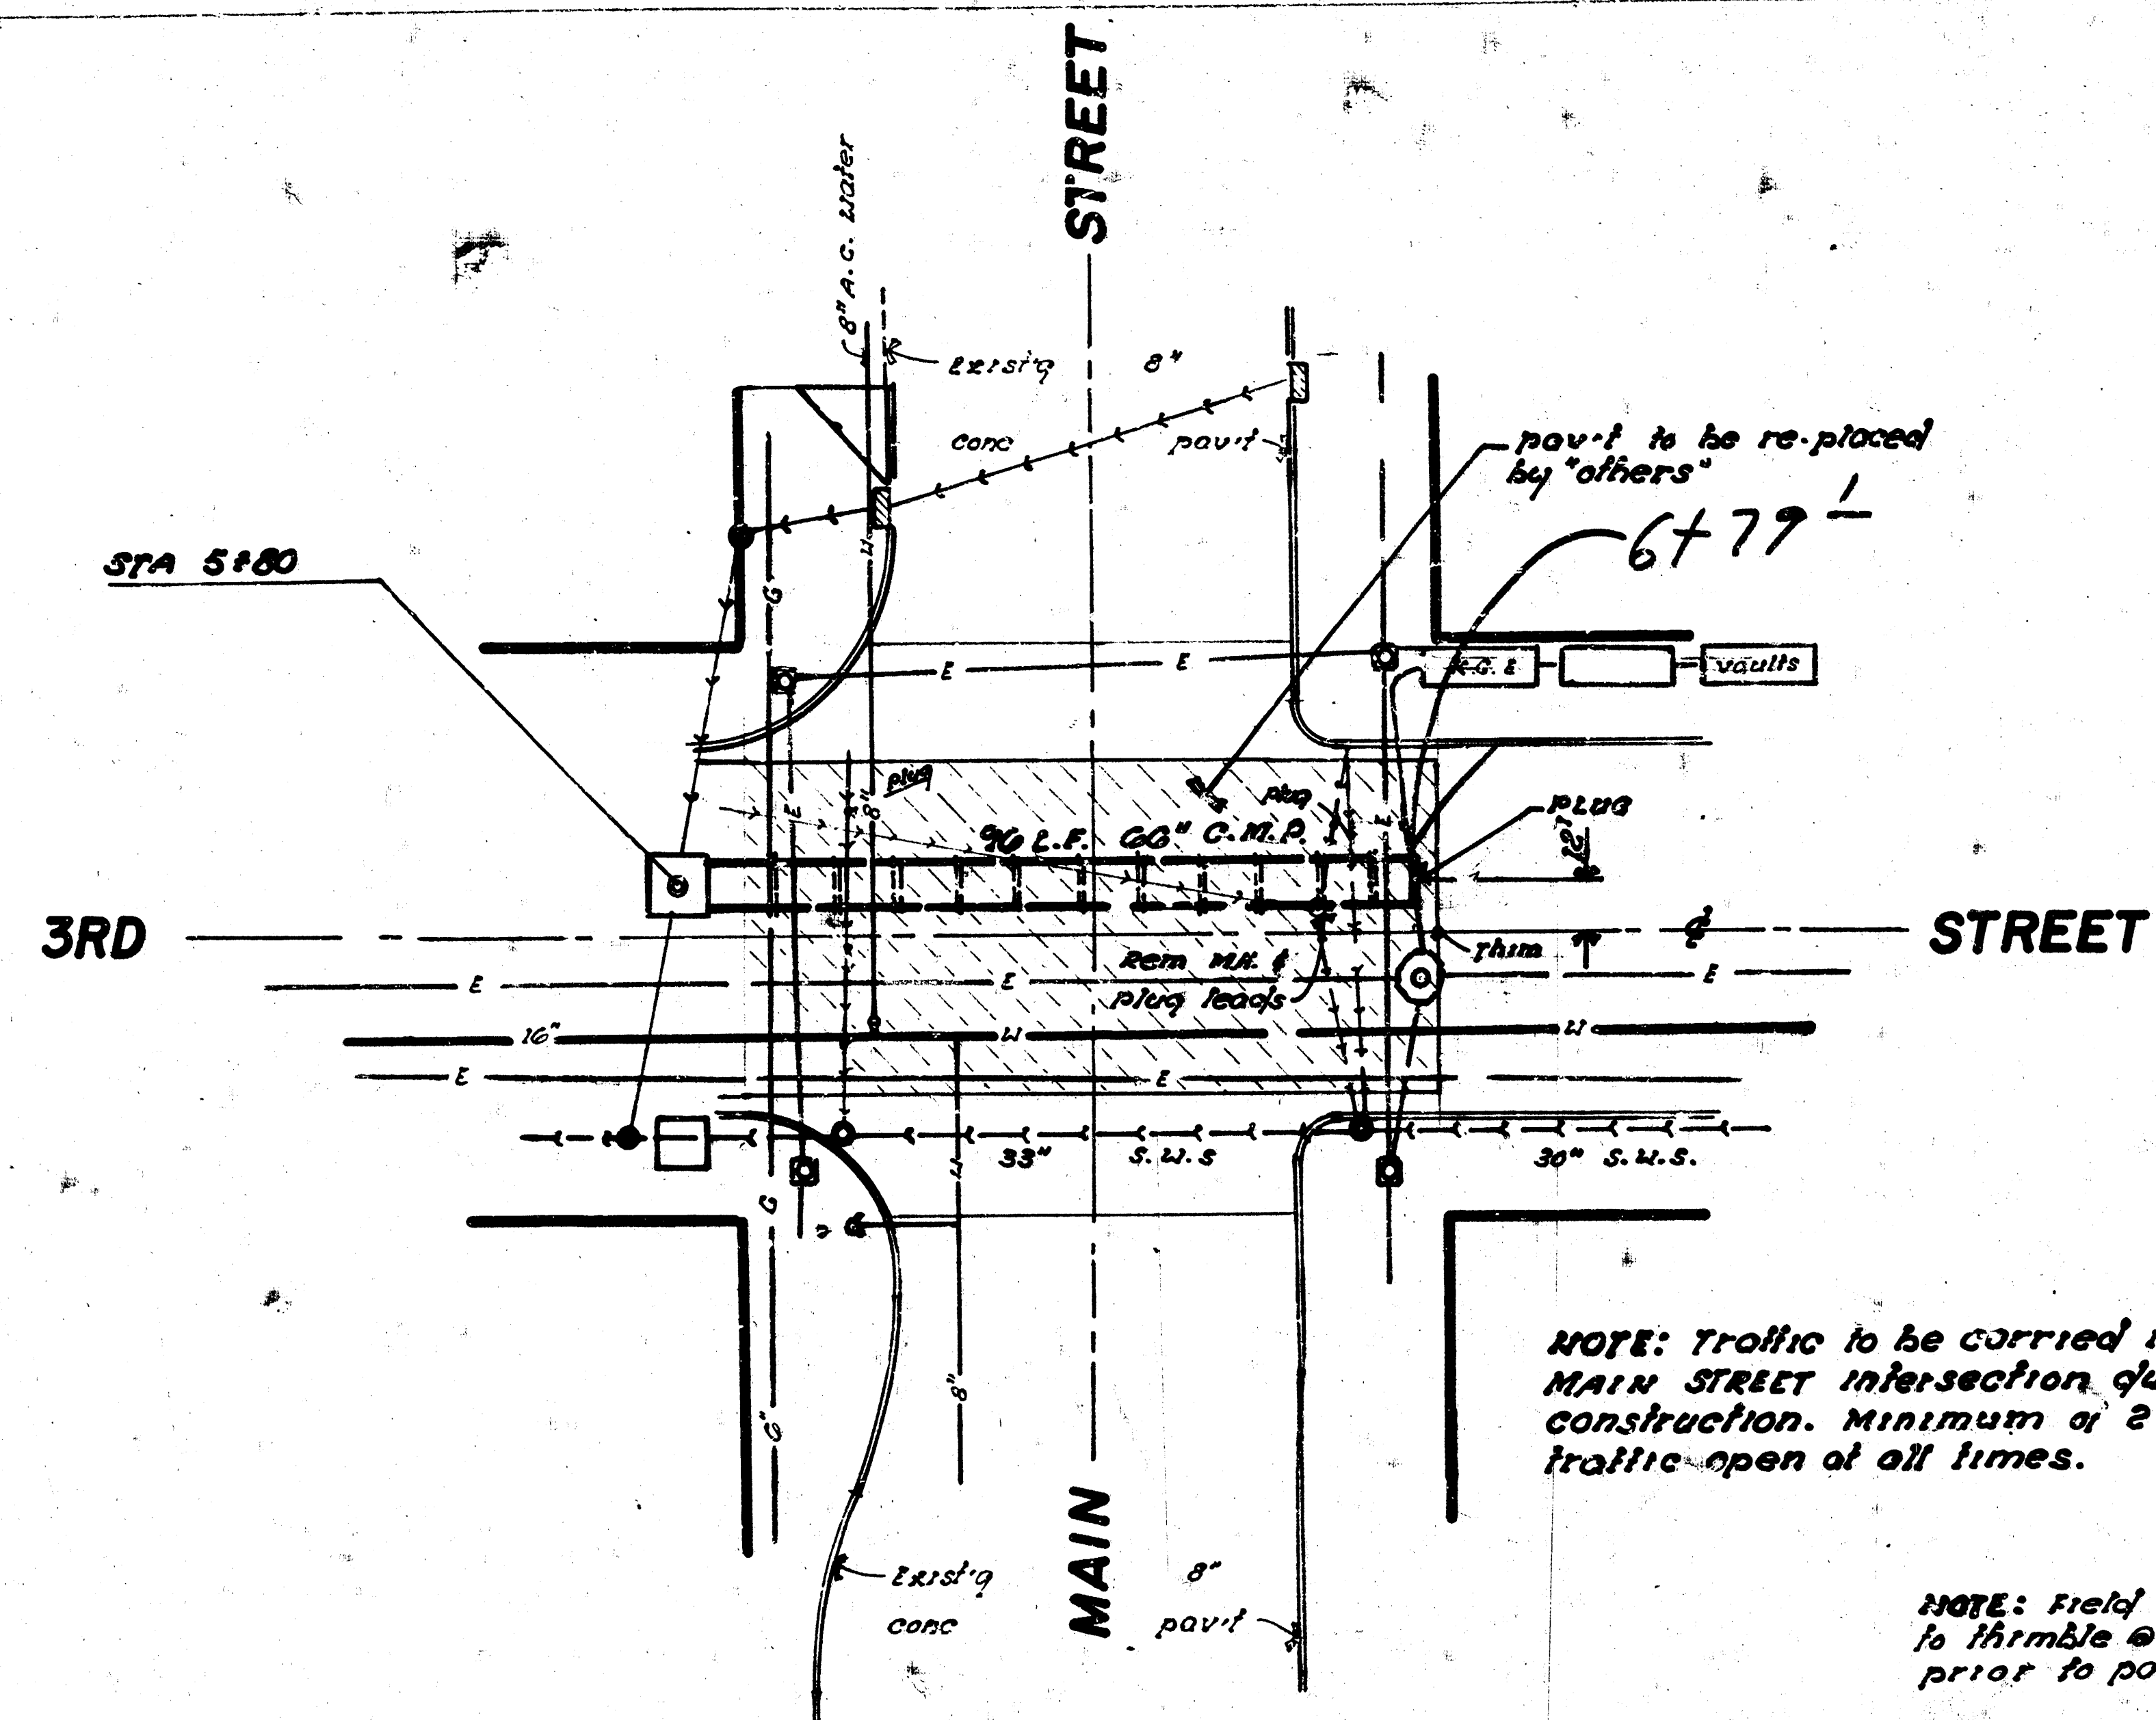


FEBRUARY 1975
R. W. LINN-CITY ENGINEER
CITY OF WICHITA, KANSAS
STANDARD TYPE 1A CURB INLET
(SET BACK LOCATION)
DETAIL

PAVEMENTS HAVE ROLL CURB
THIS TYPE INLET TO BE USED WHEN
PAVEMENT IS ASPHALT PAVEMENT WITH
SEE SEWER APPURTENANCES DETAIL
SHEET FOR MANHOLE COVER.

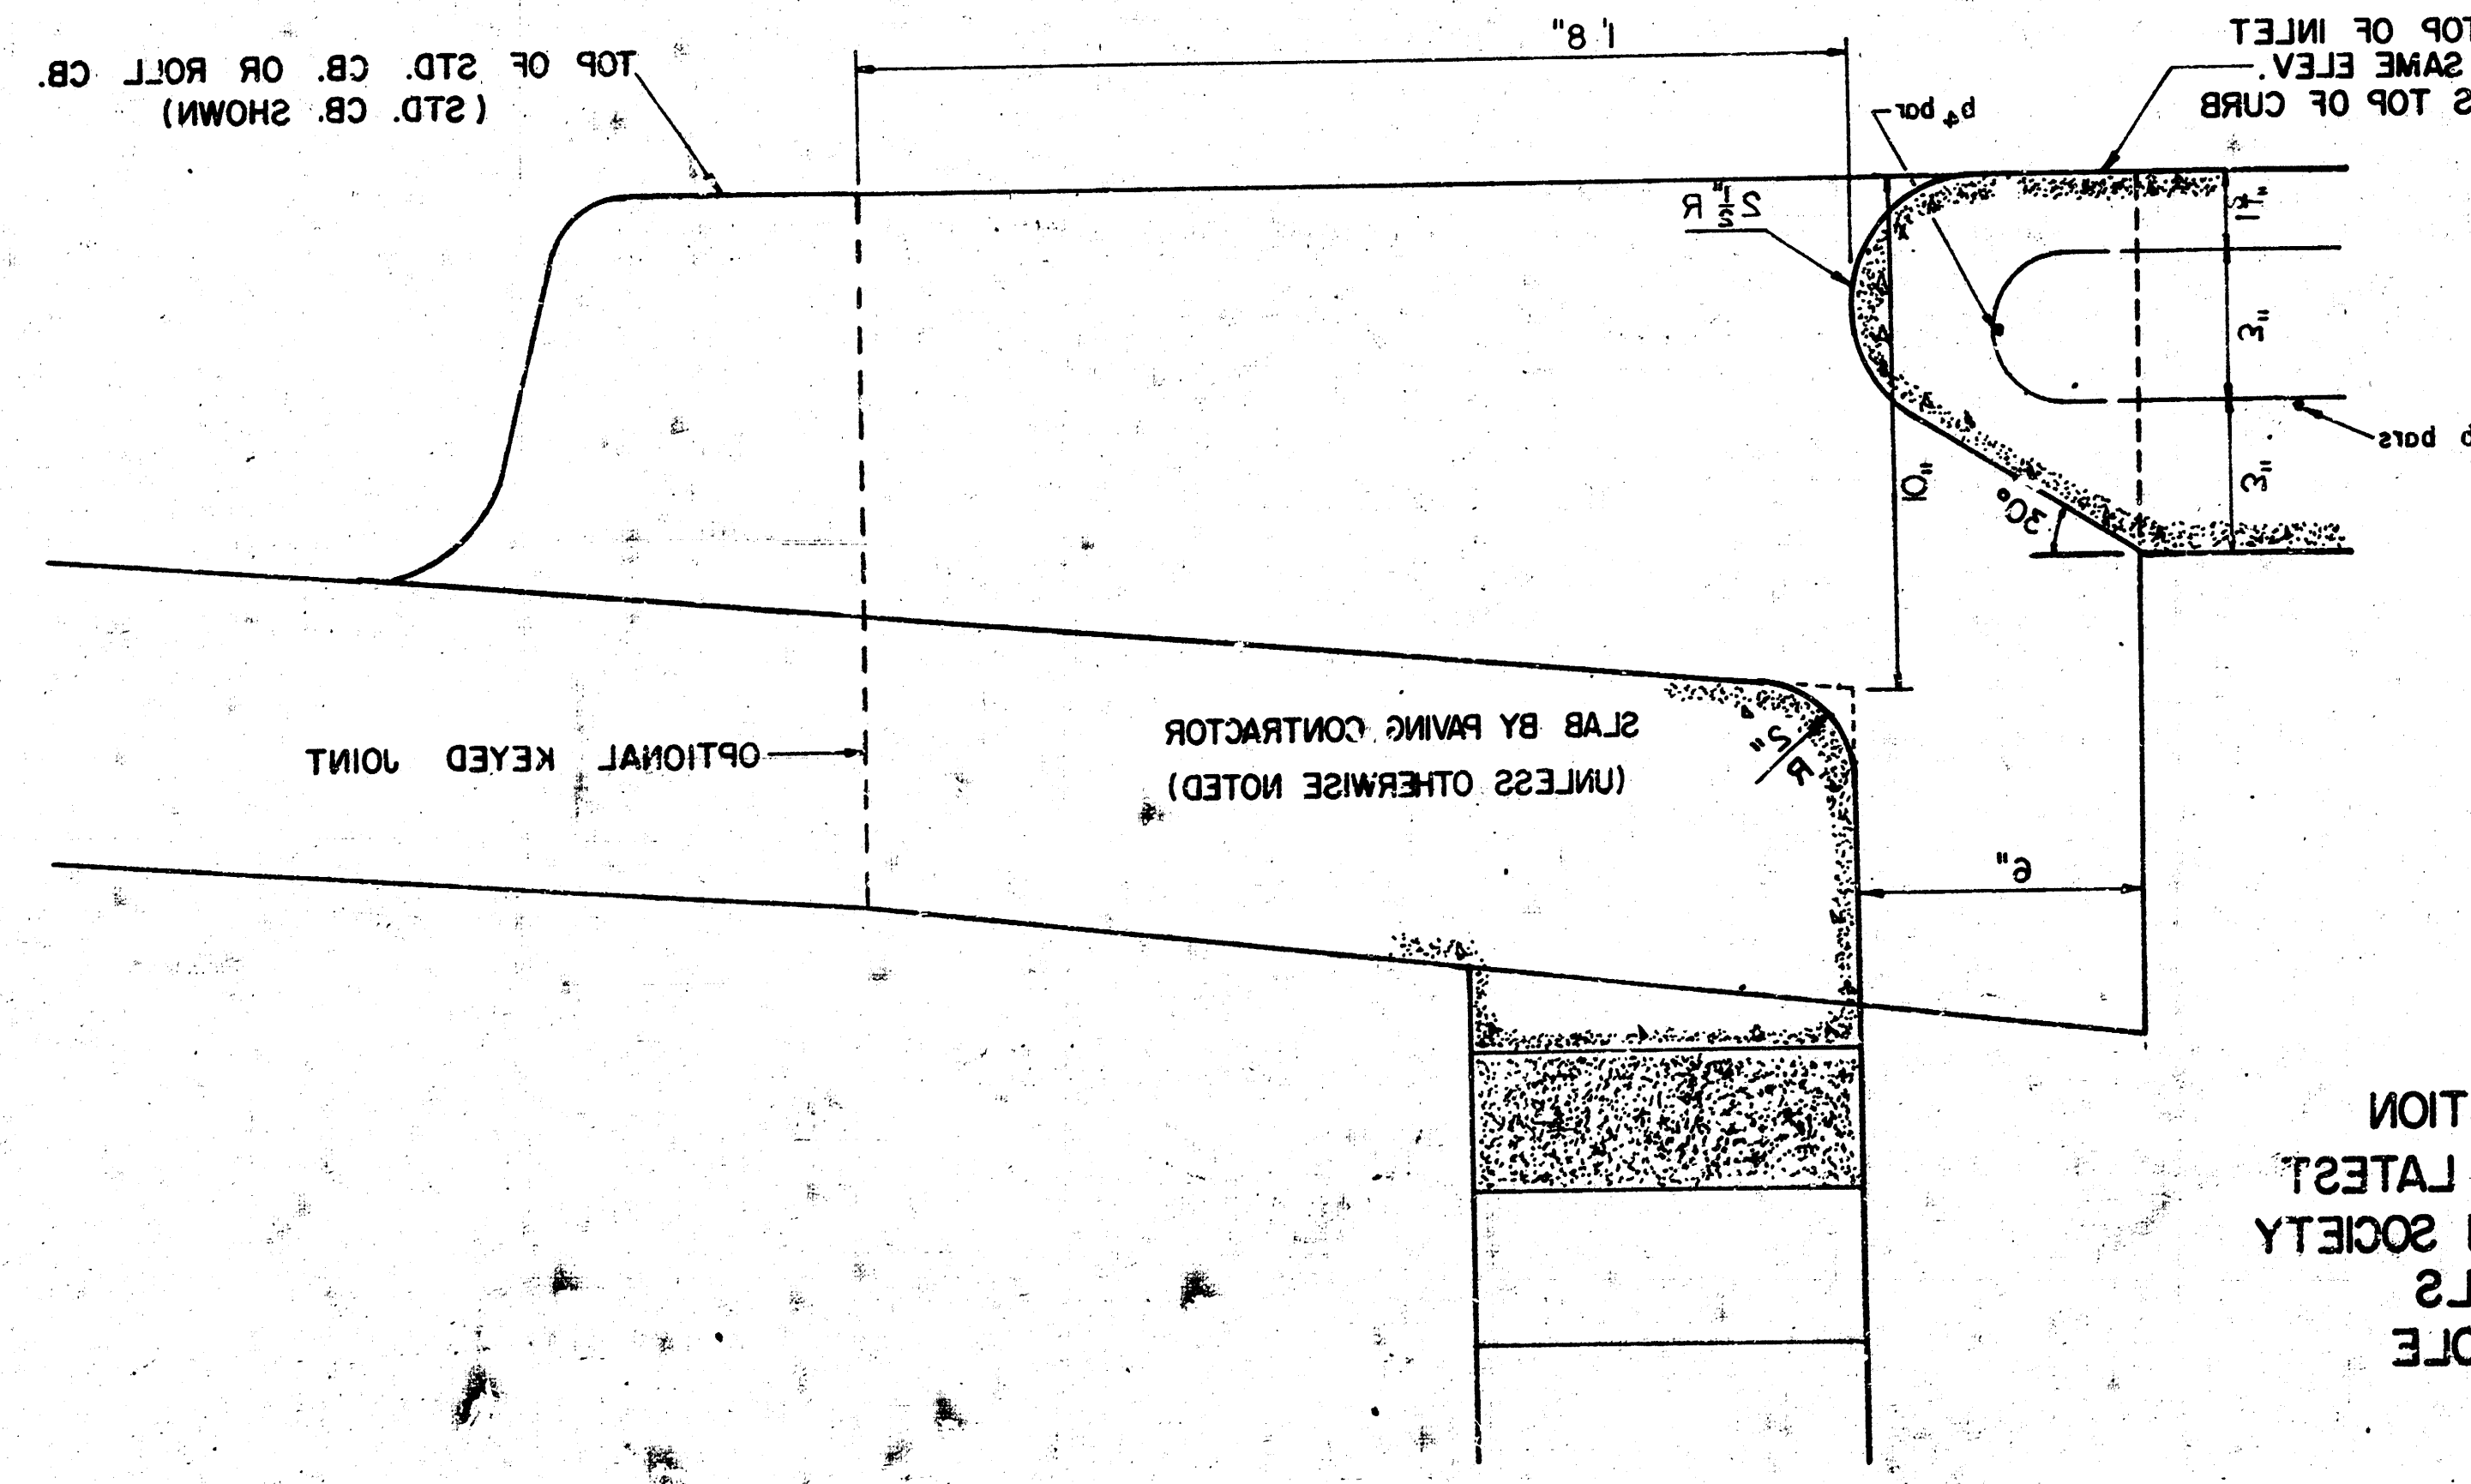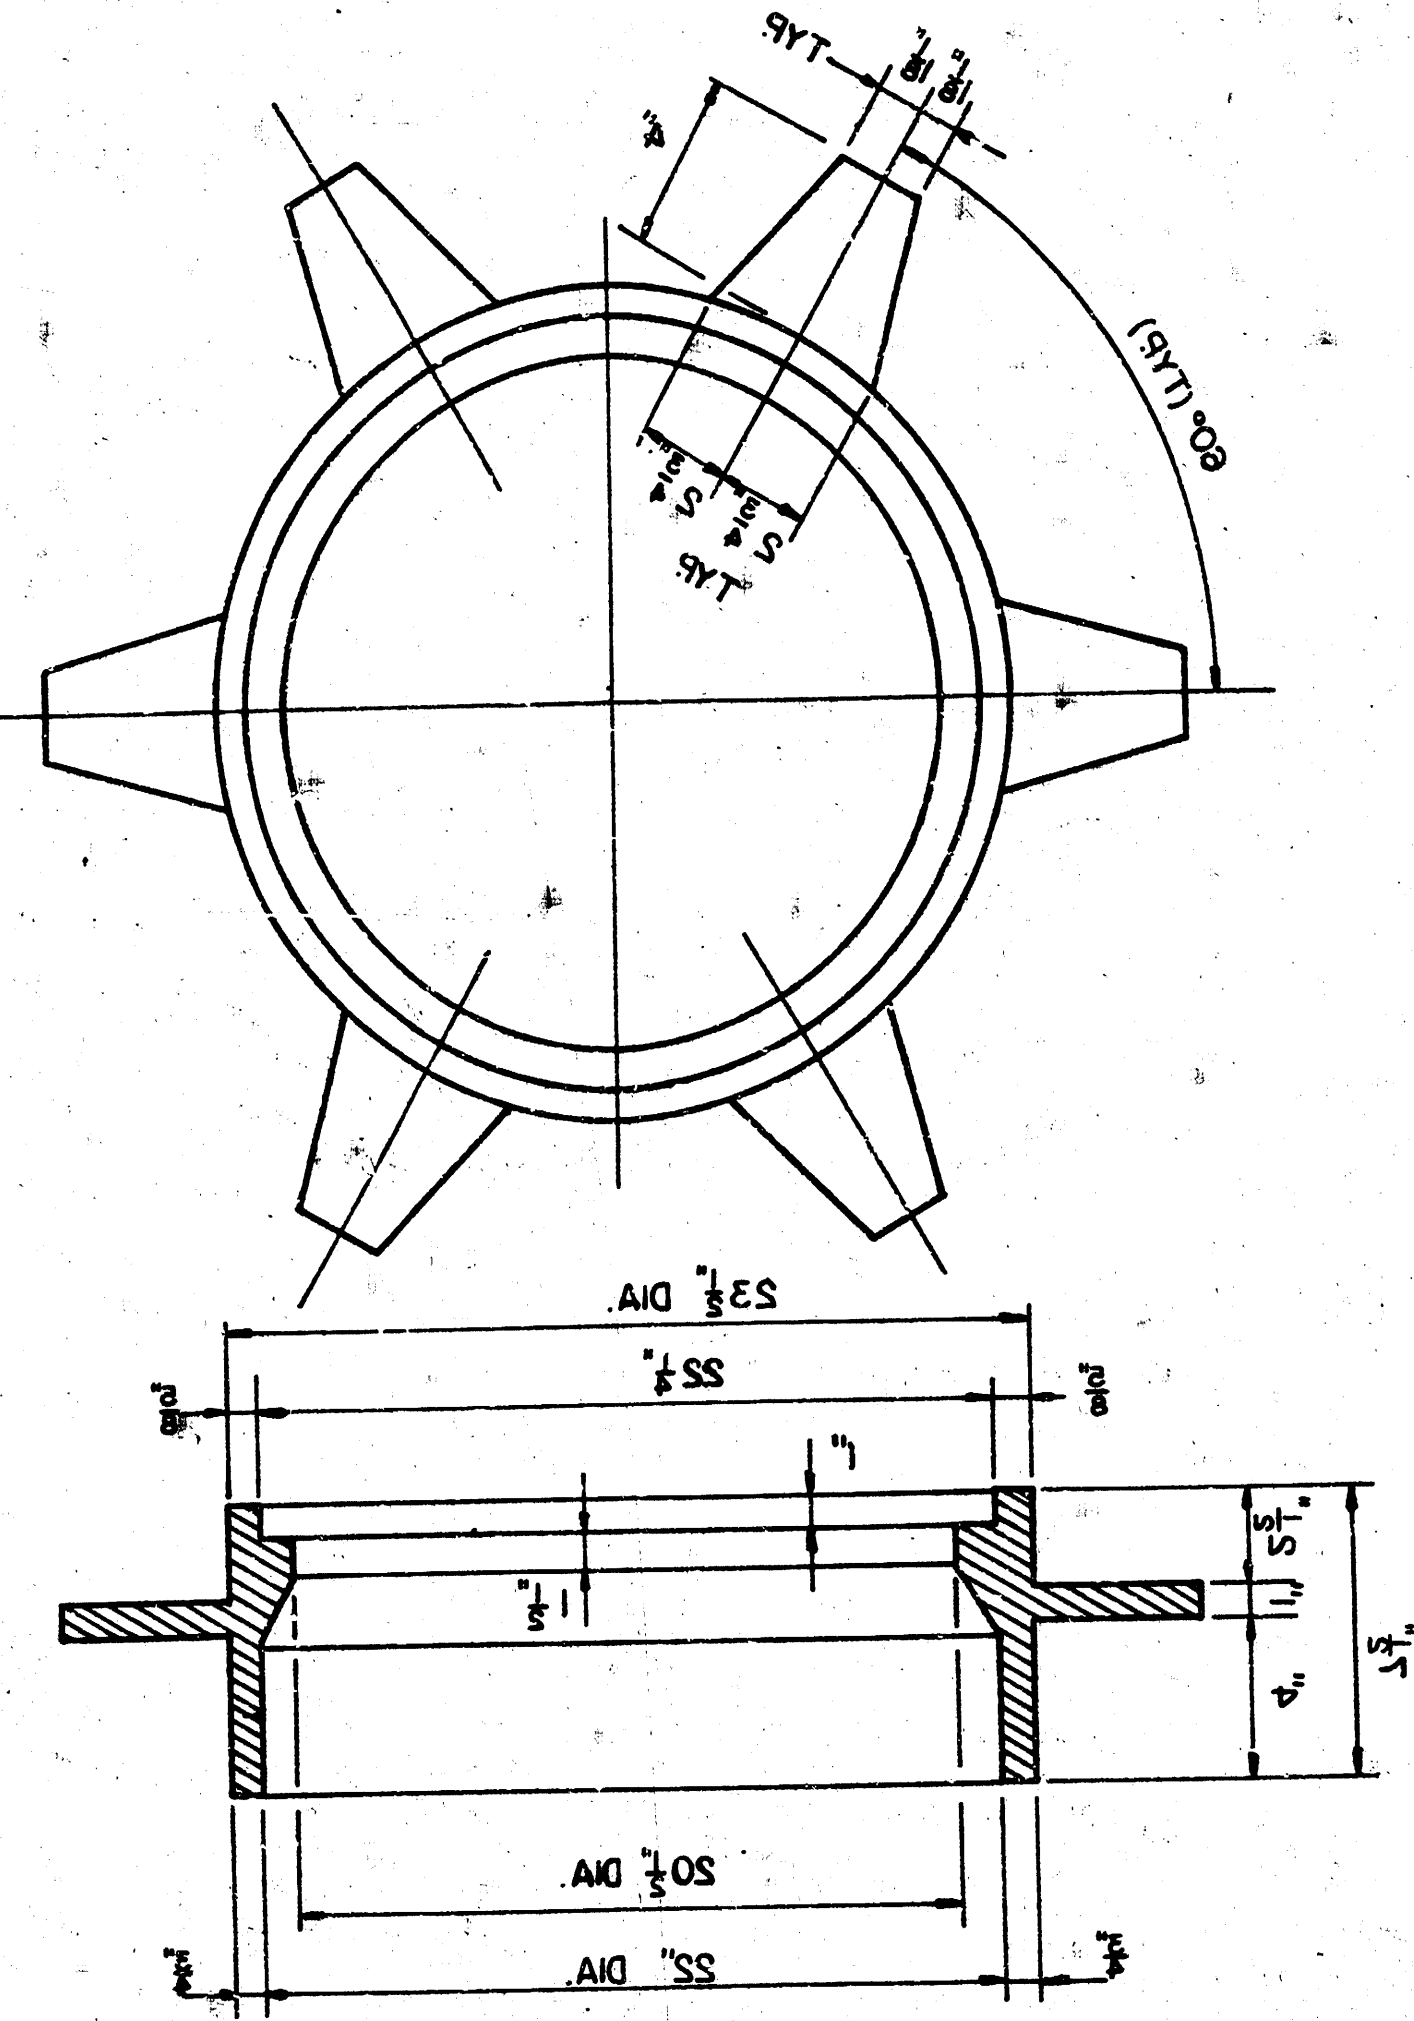


SECTION B-B
(SCALE 3\"/>

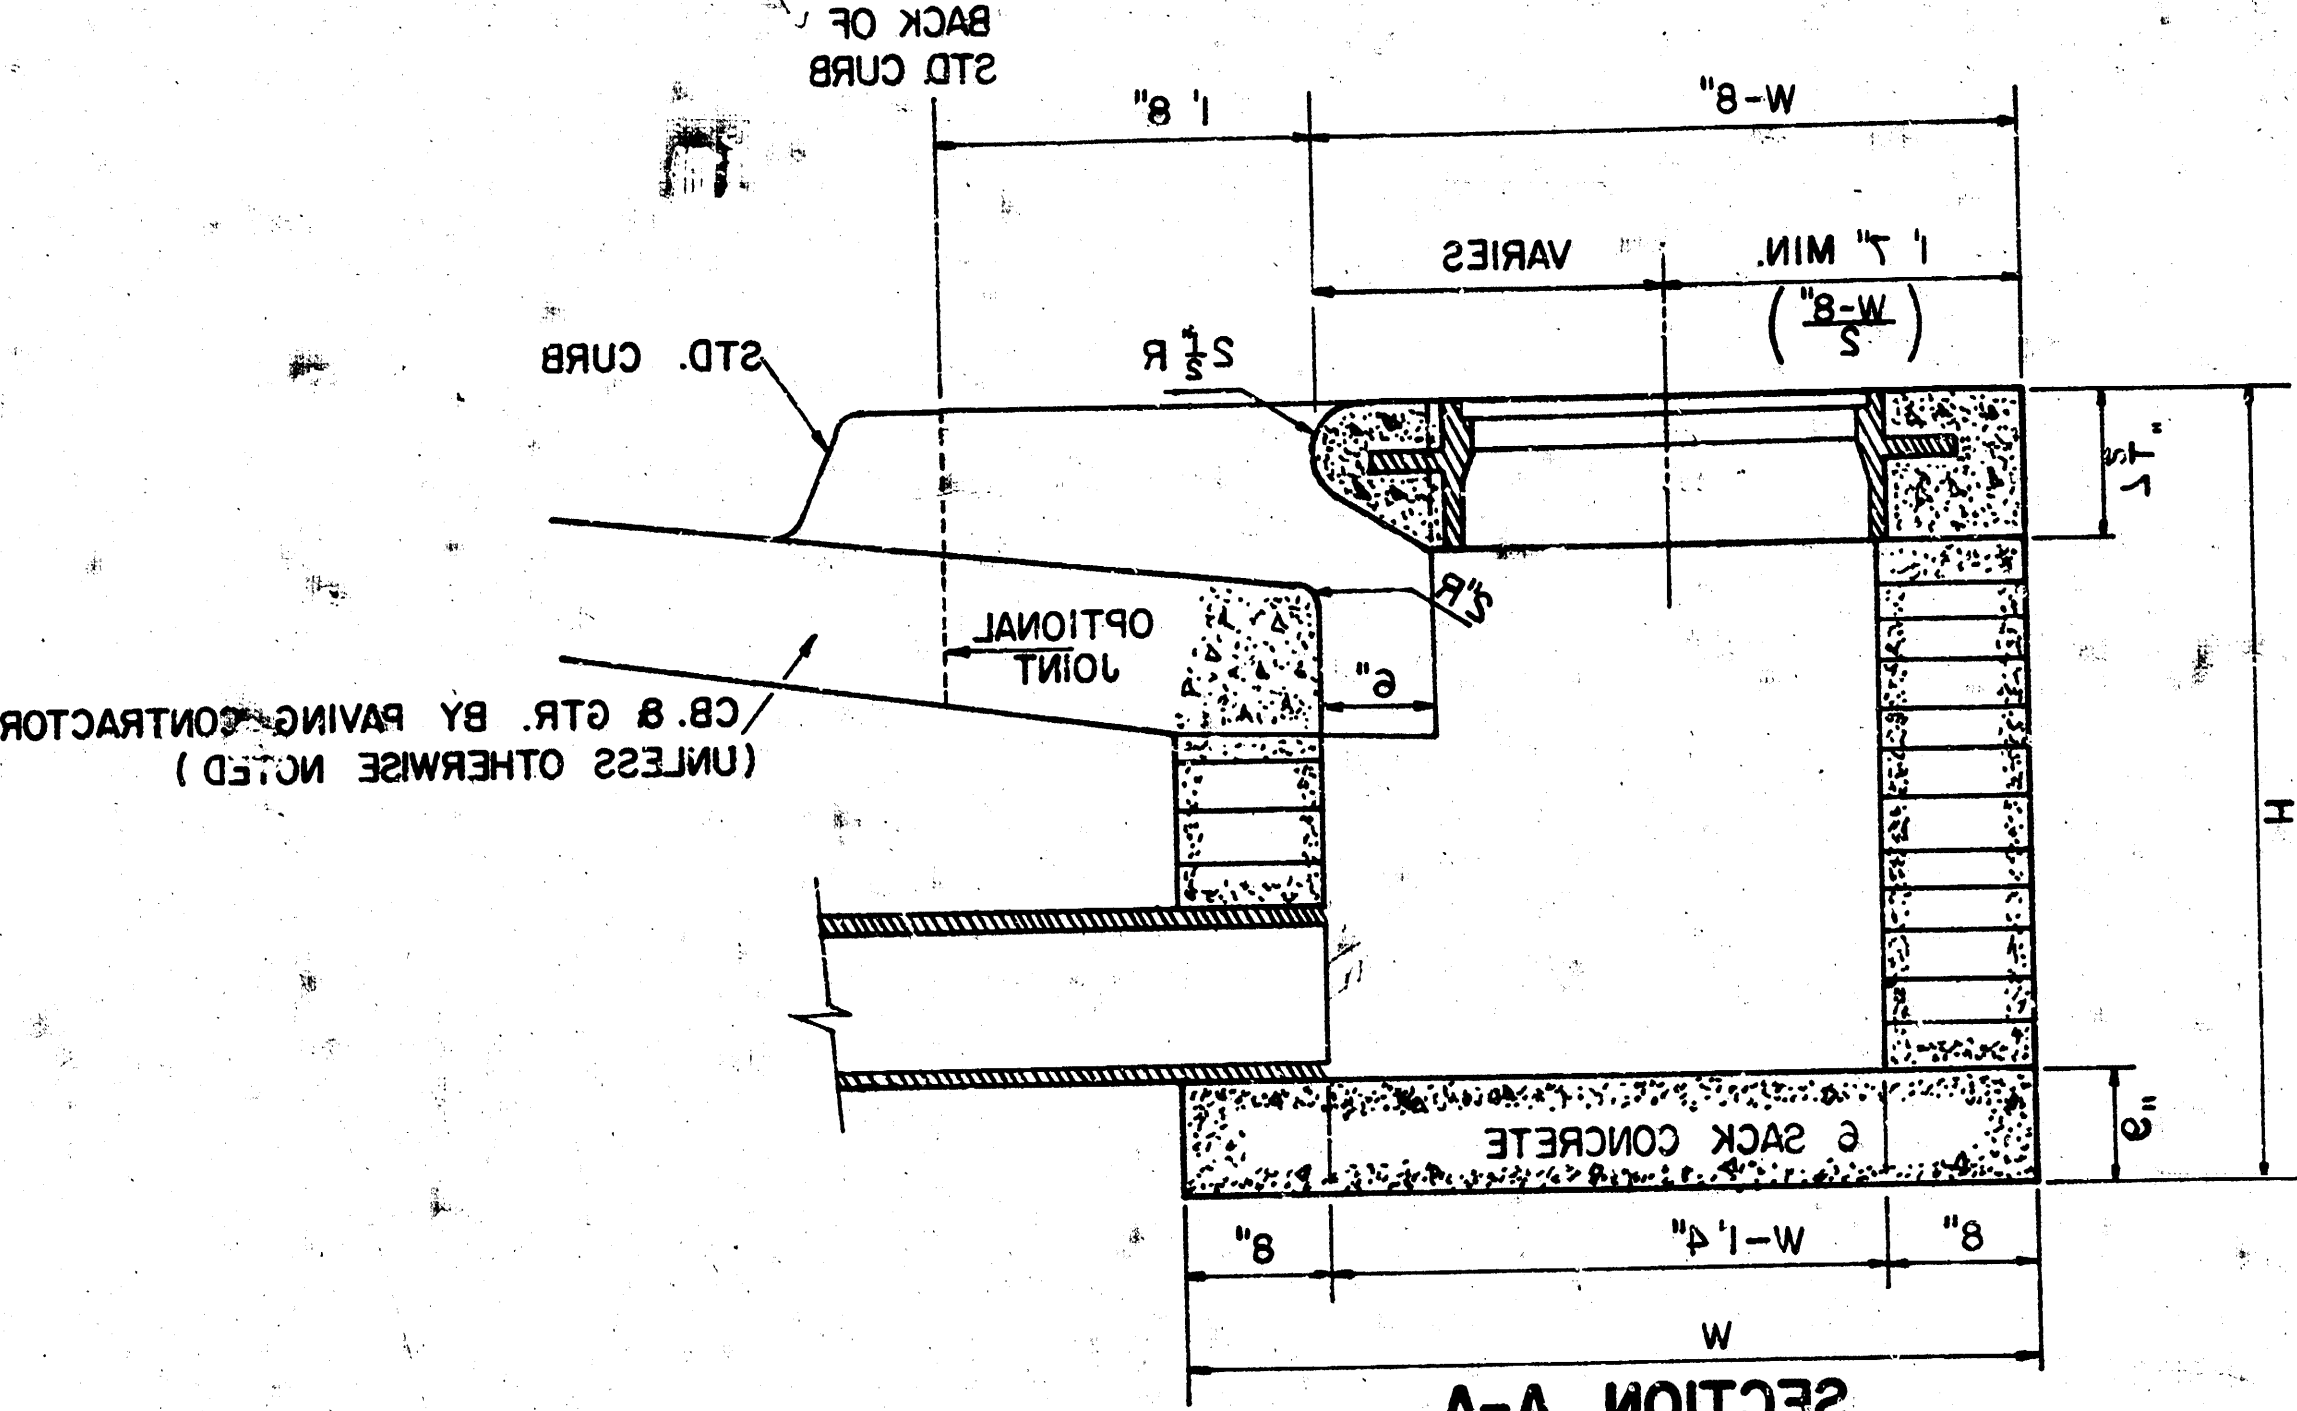


NOTE: CONCRETE TOPS TO BE INSTALLED ON
THIN MORTAR CUSHION TO INSURE FULL
SUPPORT ALONG BRICK WALLS. CONCRETE
TOPS MAY BE CAST IN PLACE OR
PRECAST CONCRETE FOR INLET TOPS
AND FLOORS SHALL BE E-SACK
PAVING MIX.

STANDARD CURB INLET PRECAST TOPS		
W	PRE-CAST TOP SIZE	PRE-CAST TOP RISE
30"	30" X 30" X 1 1/2"	30" X 30" X 1 1/2"
42"	42" X 30" X 1 1/2"	30" X 30" X 1 1/2"
48"	48" X 30" X 1 1/2"	30" X 30" X 1 1/2"
60"	60" X 30" X 1 1/2"	30" X 30" X 1 1/2"

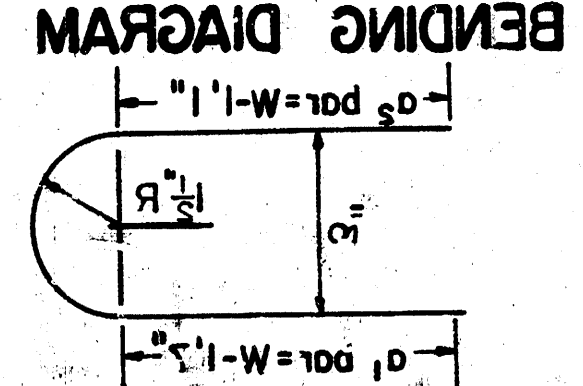


BRICK GRADE M2.
DESIGNATION C23 FOR MANHOLE
FOR TESTING AND MATERIALS
REVISION OF THE AMERICAN SOCIETY
SHALL CONFORM WITH THE LATEST
BRICK FOR INLET CONSTRUCTION

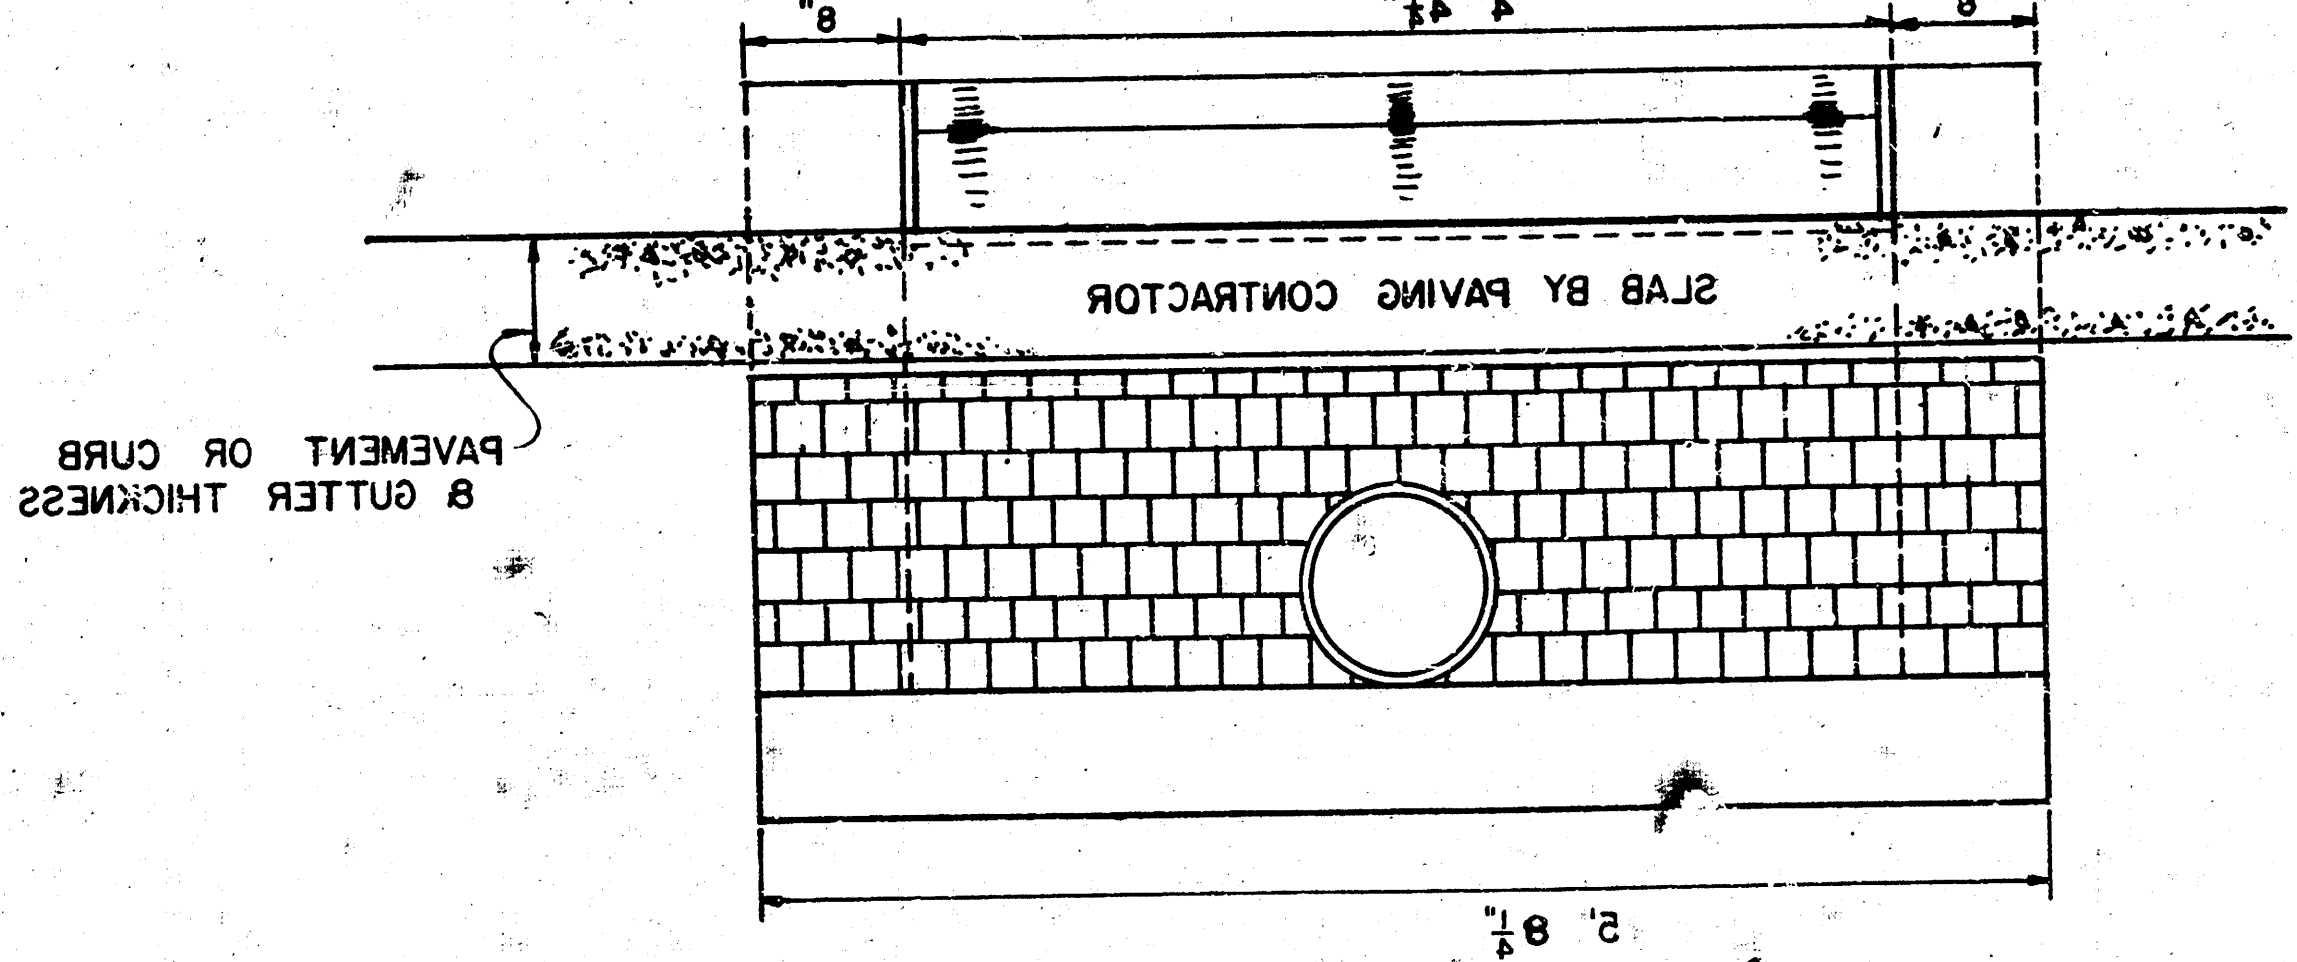

SECTION C-C
(SCALE 1\"/>

NOTE: #3 BARS TO BE PLACED APPROX. 2\"/>

NUMBER	SIZE	HORIZONTAL				VERTICAL	BAR
		W-10'	W-12'	W-14'	W-16'		
1	#4	1	1	1	1	1	W-10'
2	#4	2	2	2	2	2	W-12'
3	#4	3	3	3	3	3	W-14'
4	#4	4	4	4	4	4	W-16'

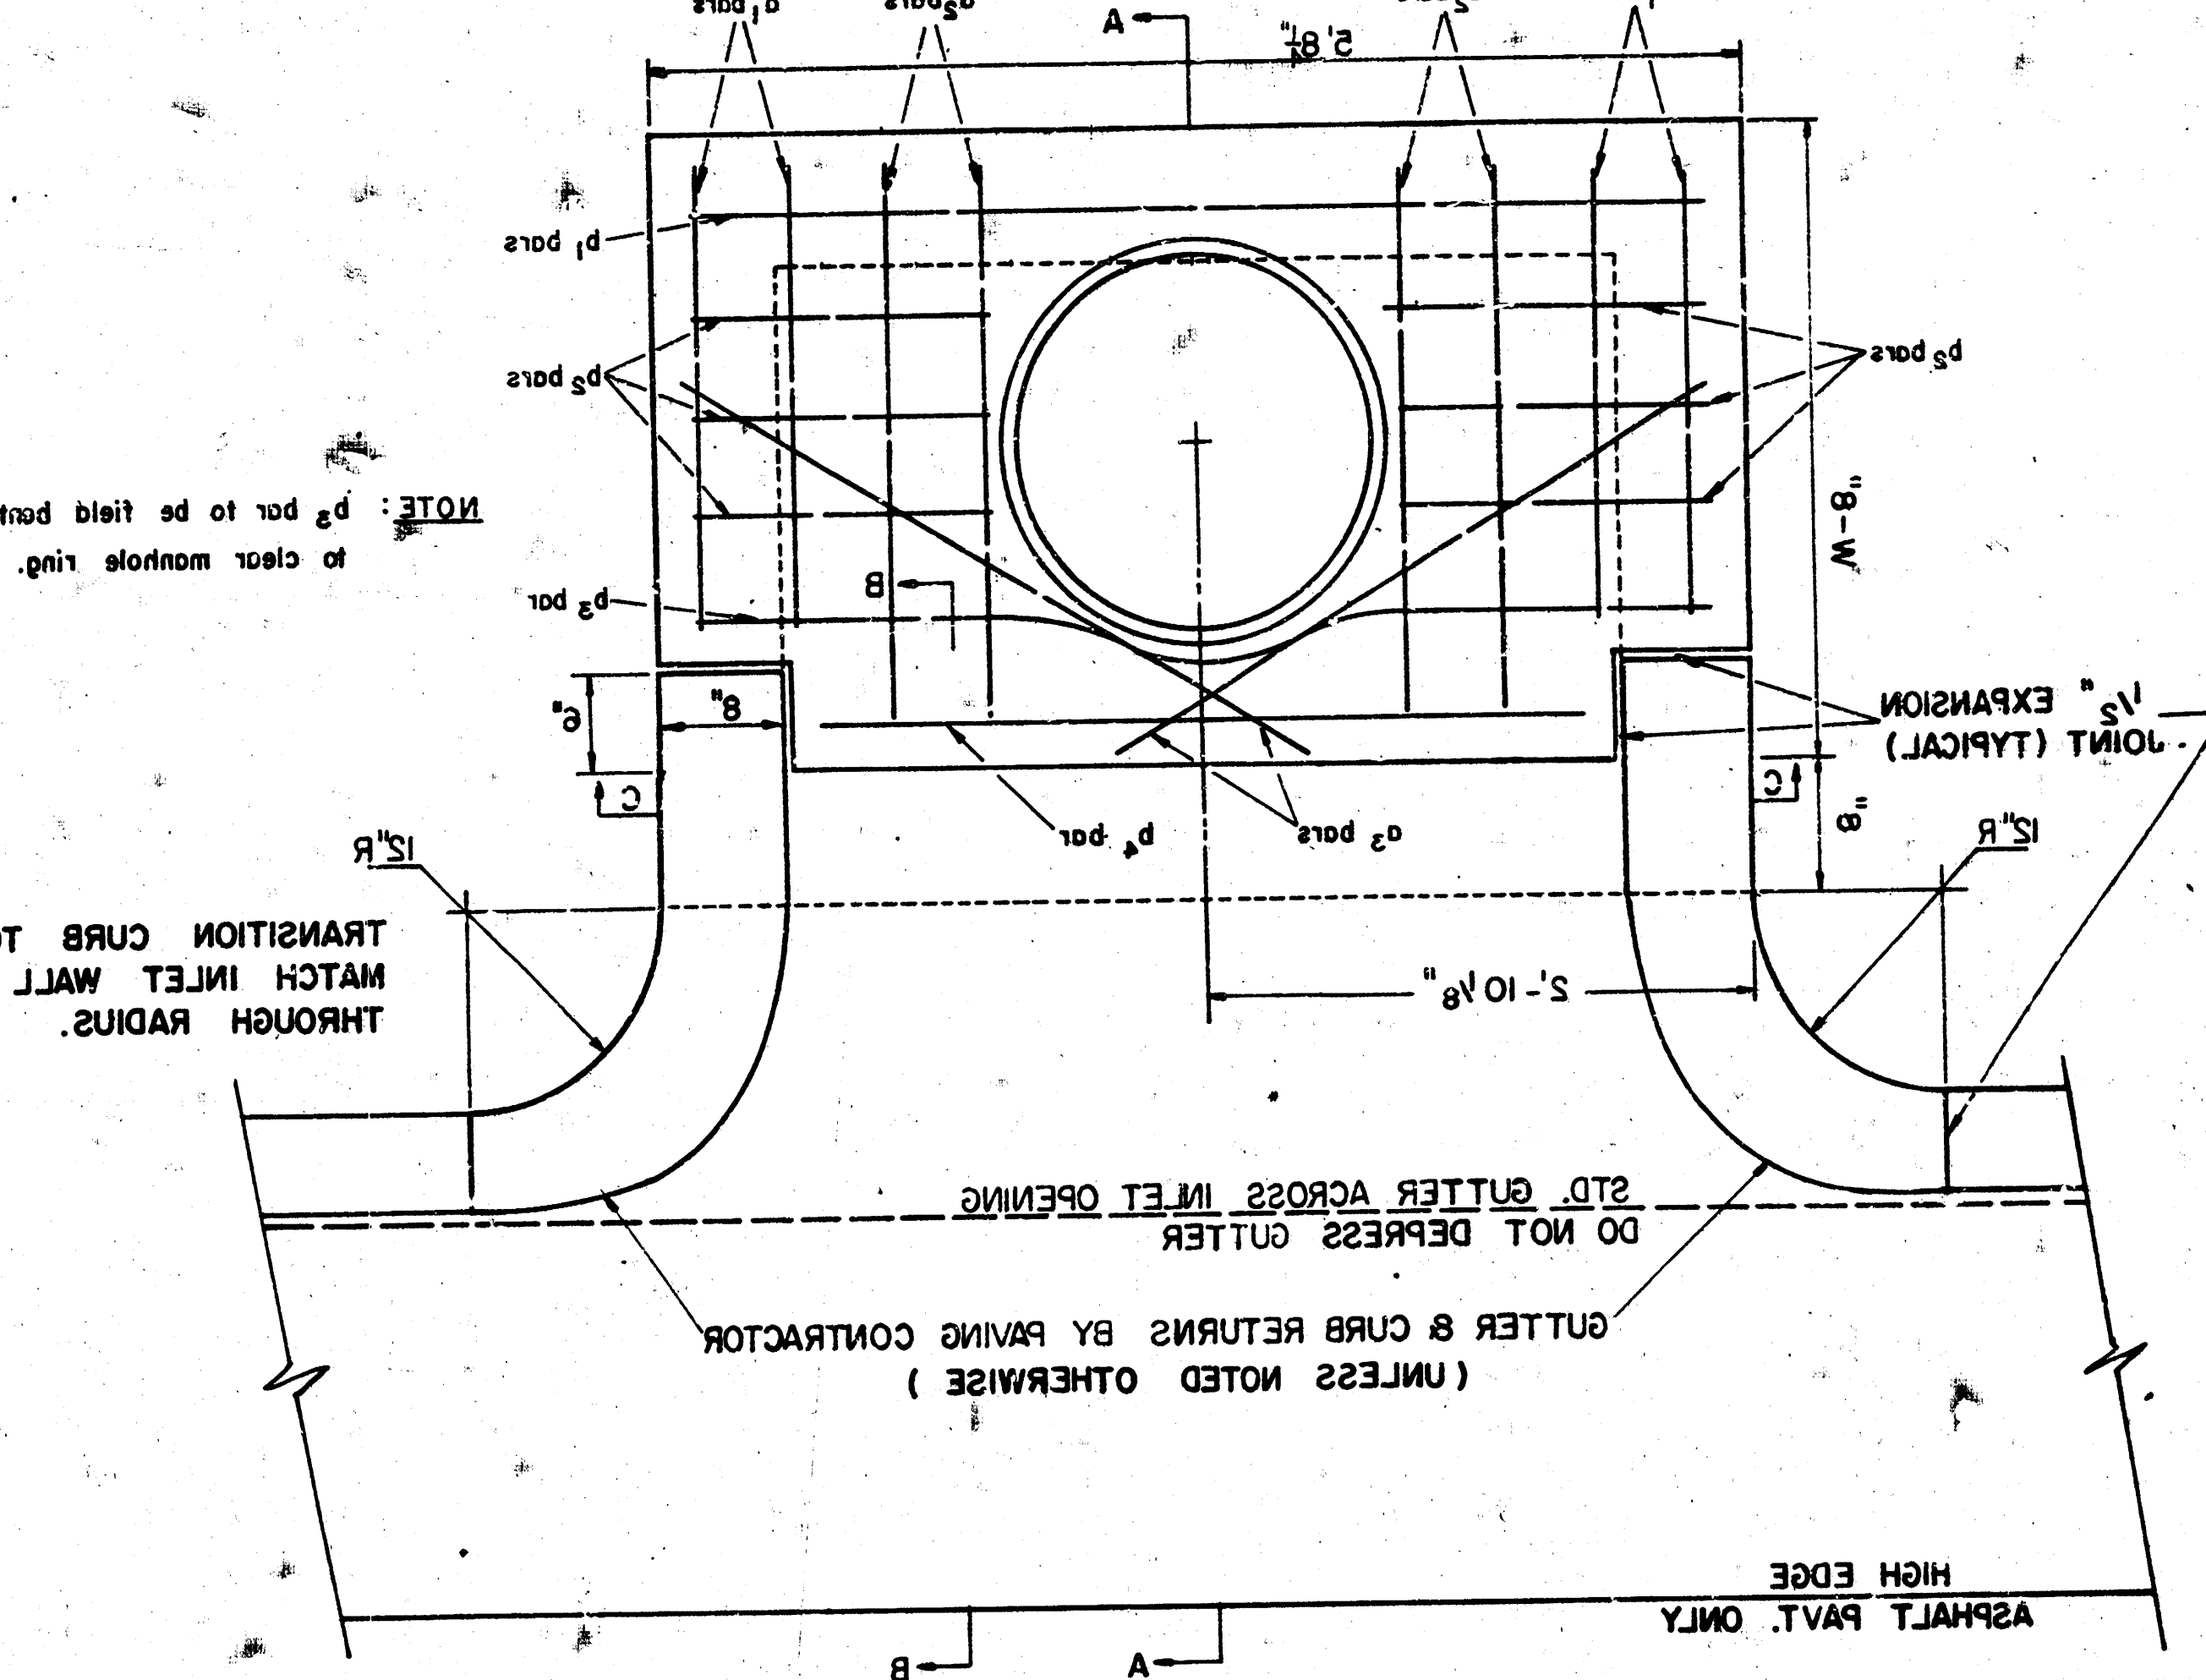

PLAN (SCALE 1\"/>

PROFILE	SHAWNEE	DATE
NOTE BOOK	PO BOX 11111	