

DRAINAGE


BONNIE BRAE SECOND ADD.
WICHITA KANS.

FOR

BUILDERS INC.

NOTE TO CONTRACTOR
This project will be constructed under the supervision of the CITY ENGINEER and conform to the SPECIFICATIONS of the City of WICHITA. The CONTRACTOR shall reimburse the City of Wichita for the cost of engineering, plan, and inspection.

APPROVED AS NOTED
By CITY ENGINEER OF WICHITA
Sanitary Sewers _____
Storm Sewers _____
Driveway Approaches _____

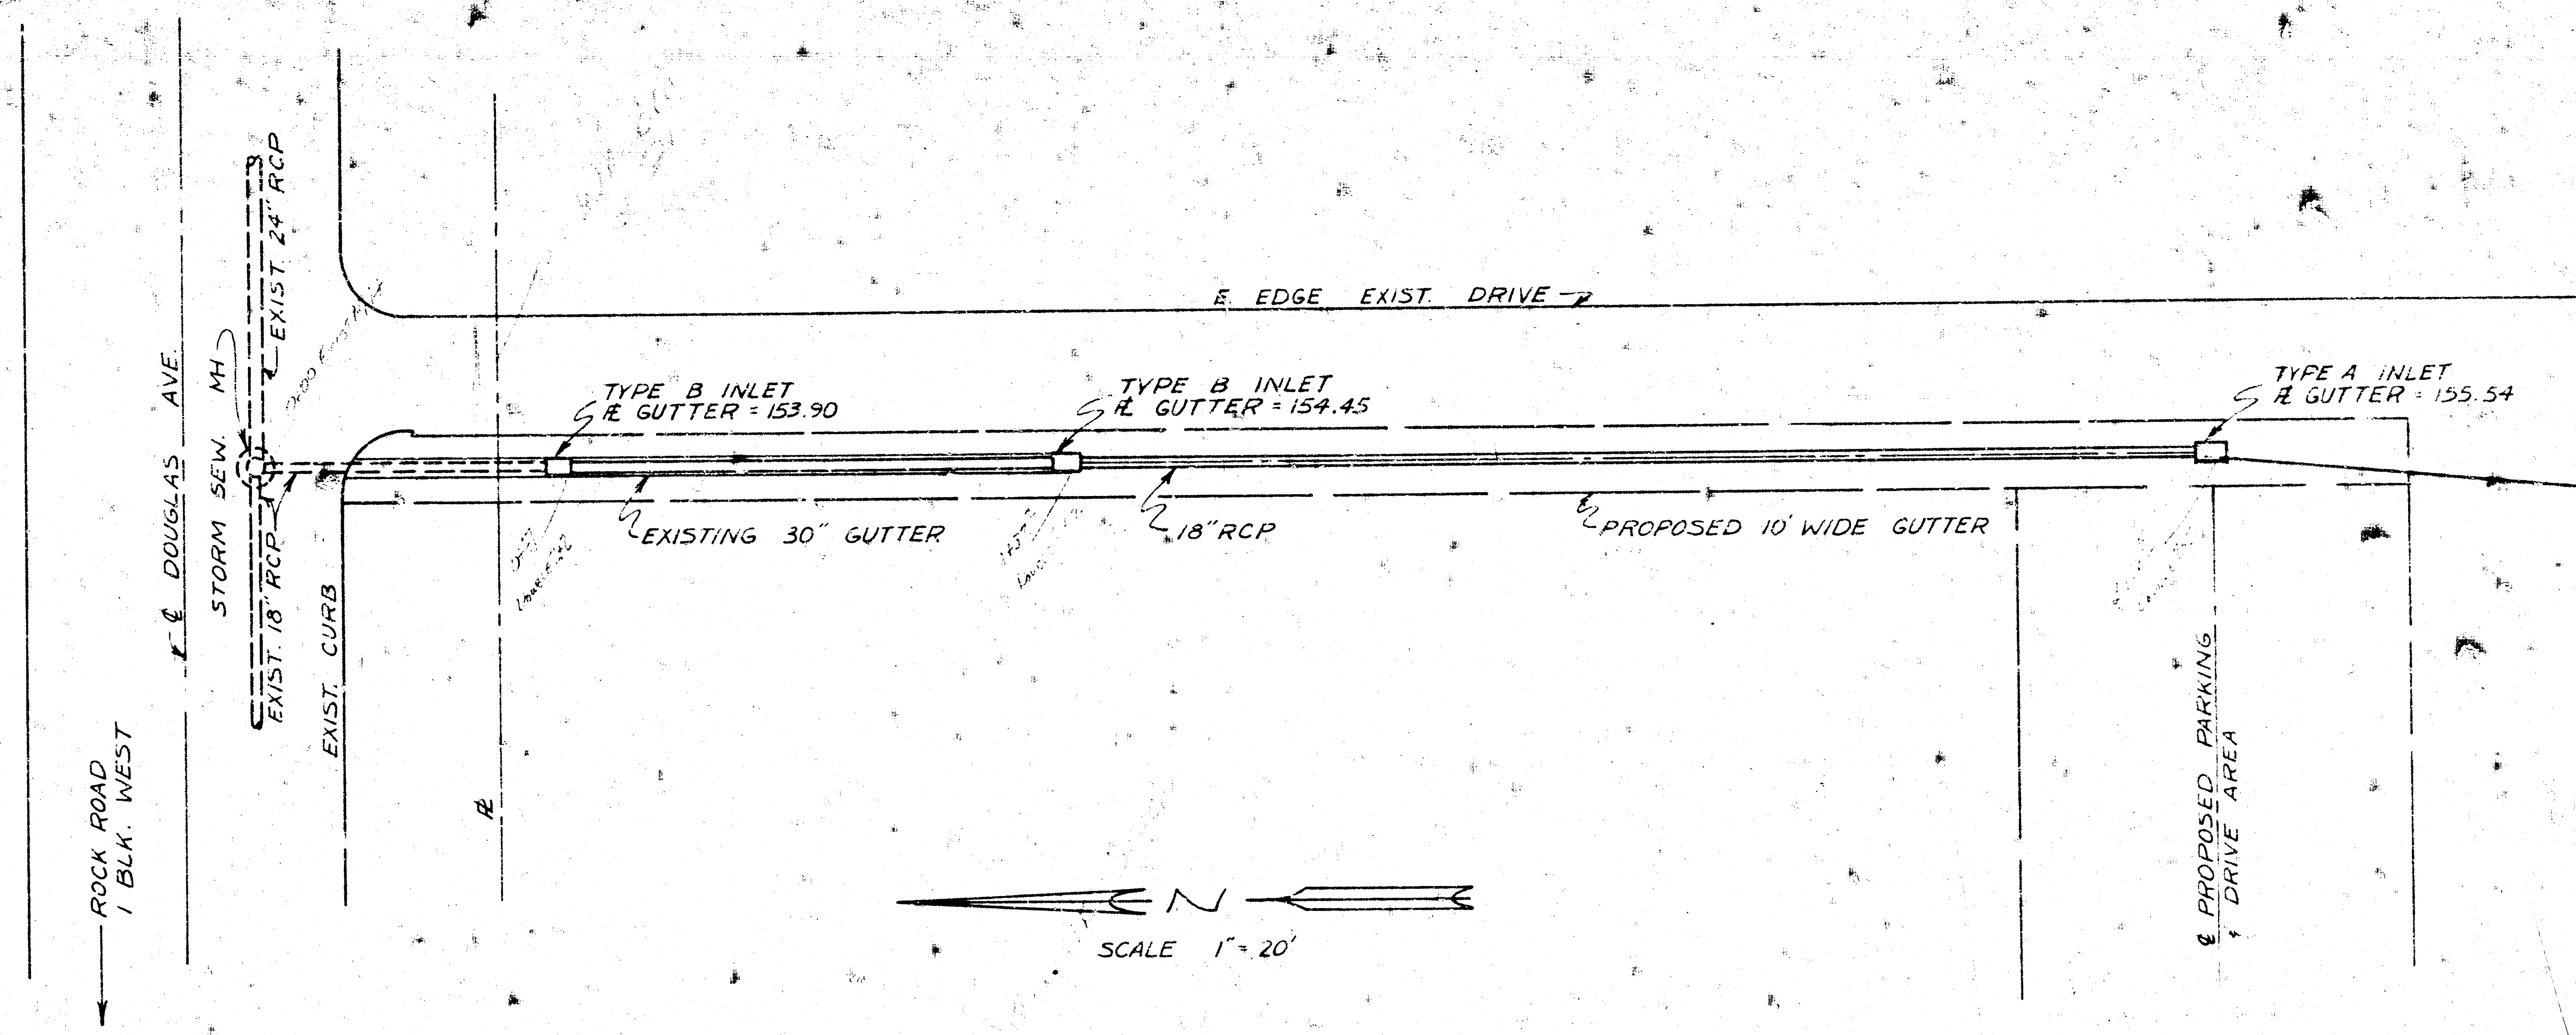


APPROVED AS NOTED
 BY CITY ENGINEER OF WICHITA

Sanitary Sewers _____
 Storm Sewers _____
 Driveway Approaches _____

NOTE TO CONTRACTOR
 This project will be constructed under the supervision of the CITY ENGINEER and conform to the SPECIFICATIONS of the CITY OF WICHITA. The CONTRACTOR shall reimburse the City of Wichita for the cost of engineering, planing and inspection.


B.M. (CITY OF WICHITA)
 BRASS PLUG IN CONCRETE MONUMENT
 52' E & 42' S OF E. OF INTERSECTION
 DOUGLAS AVE AND ROCK ROAD.
 ELEV 163.26

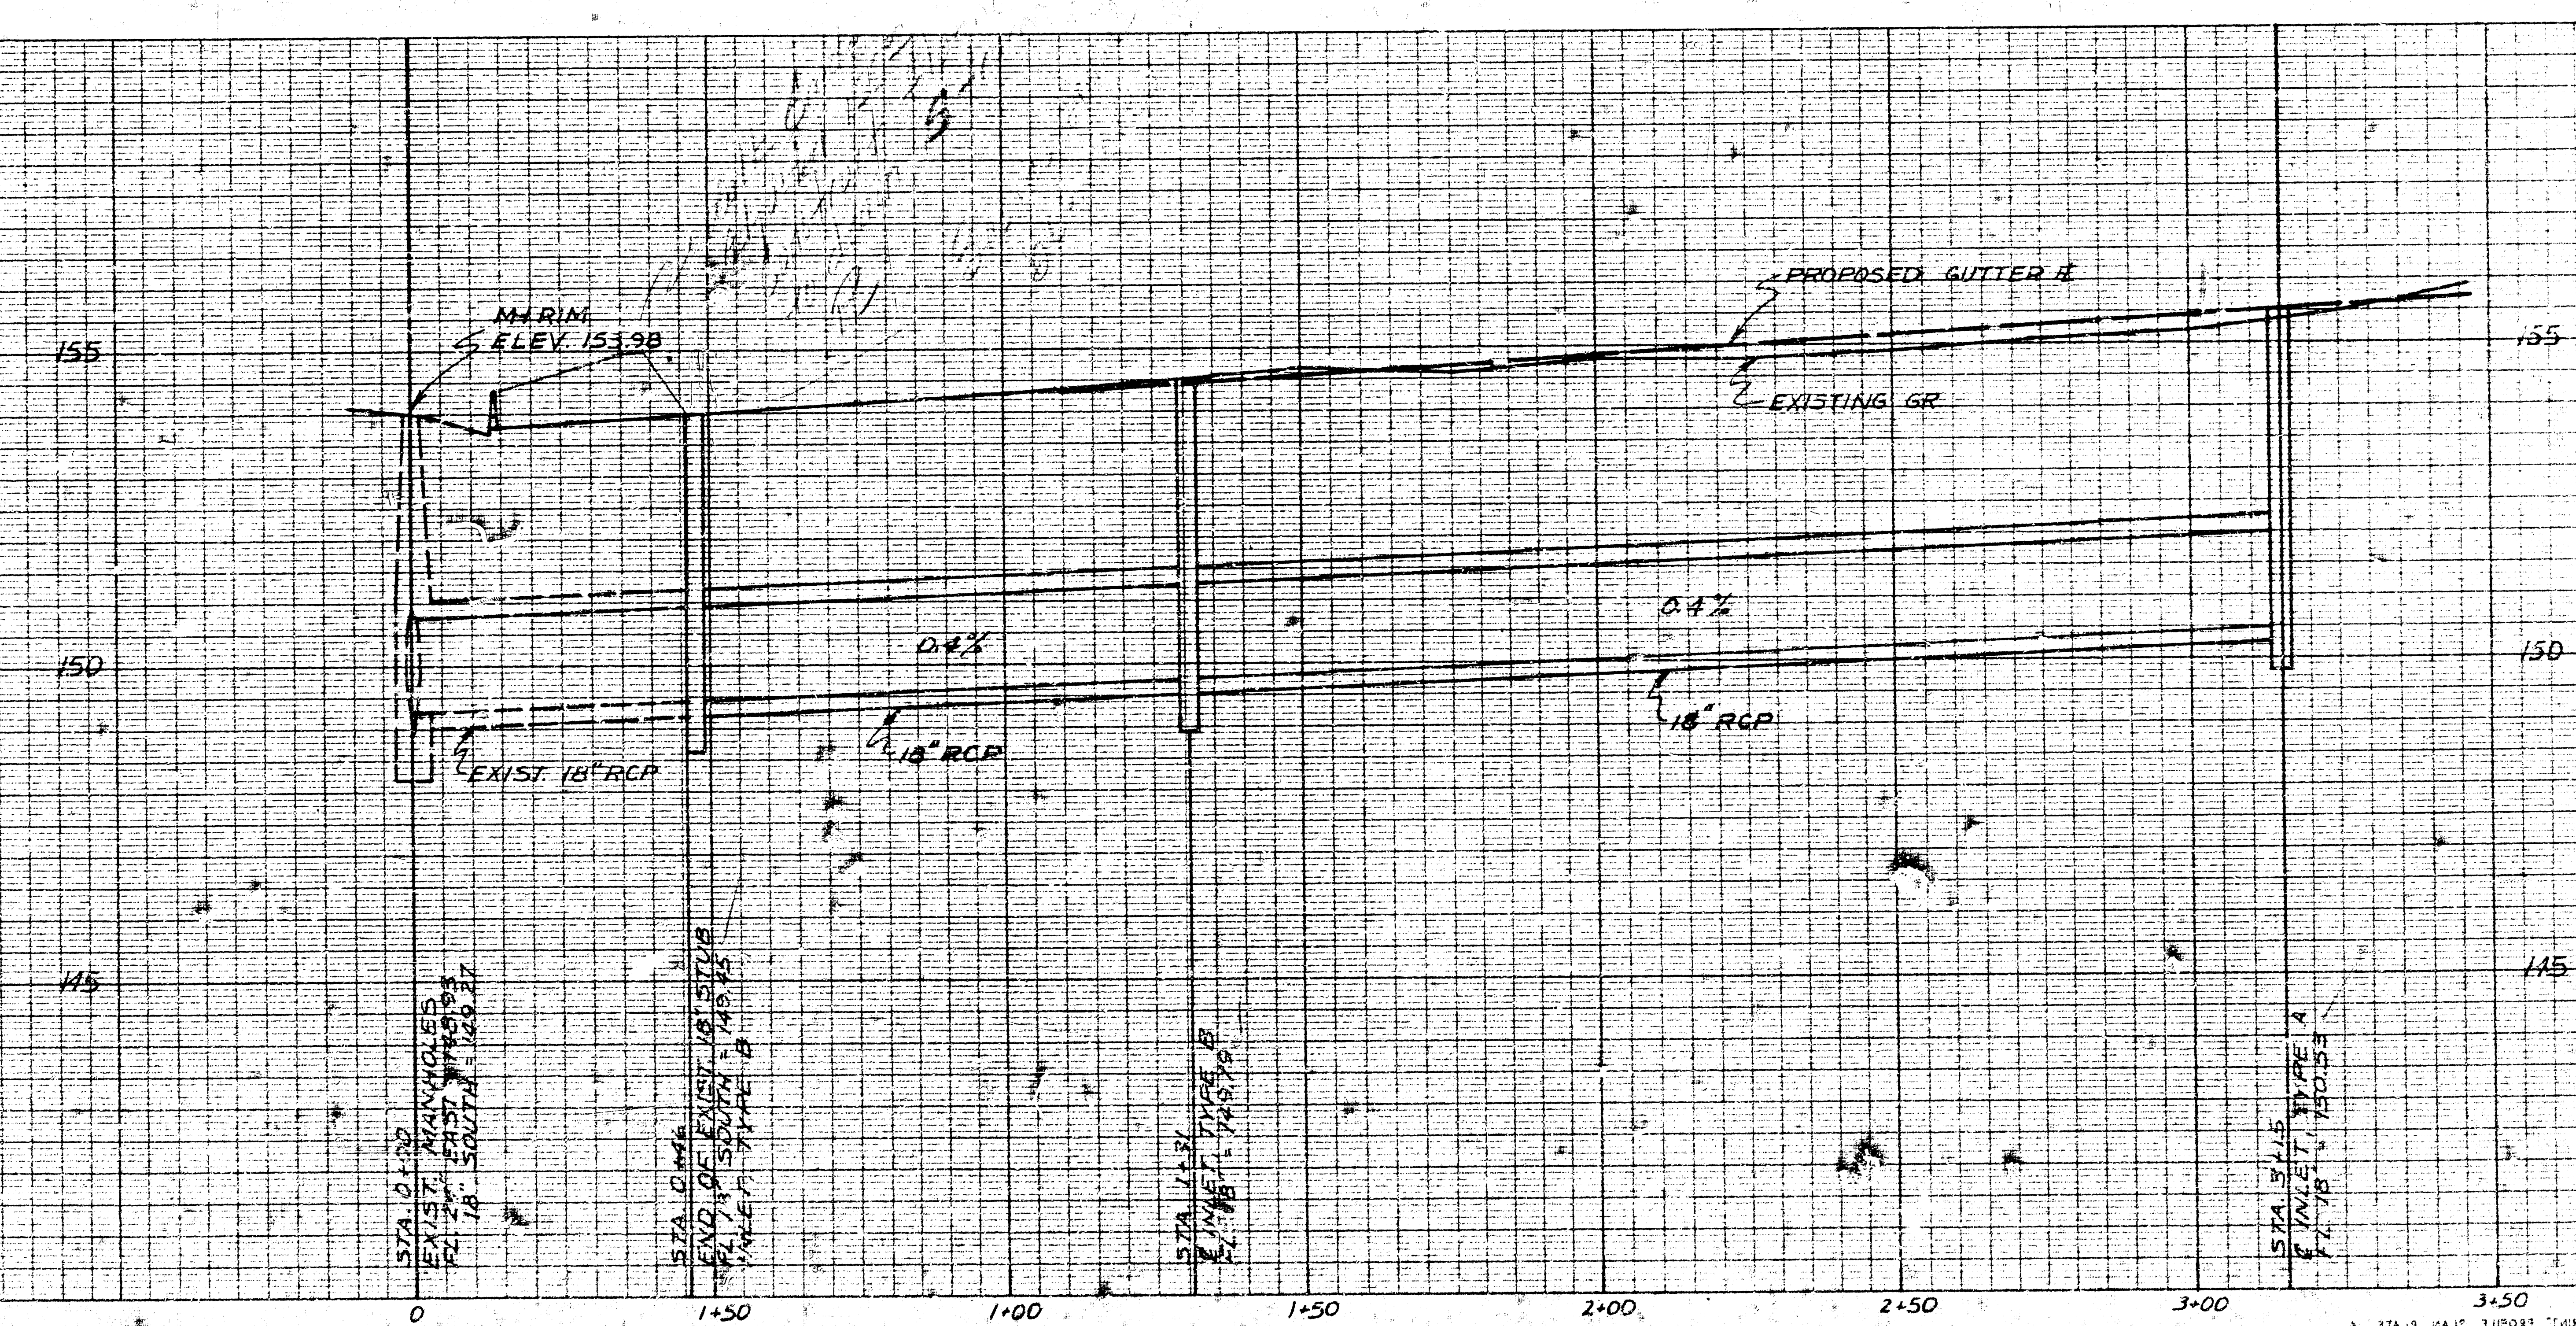

AAKB50201B

R-3341 R-3355 Series Concave Gutter Inlet Frames and Grates

Heavy Duty
Specify:
1. Catalog number

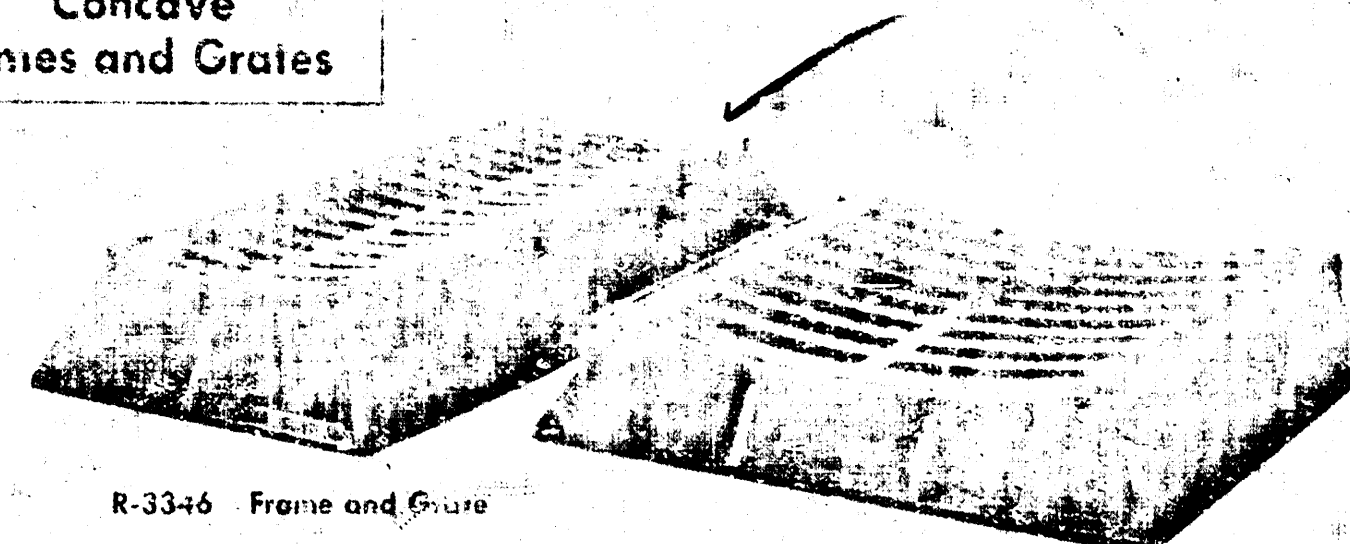

R-3346 Frame and Grate


R-3350 Frame and Grate

Catalog No.	A	AA	D	DD	E	EE	F	FF	Wt.
R-3341	7 1/2	11	3	11 1/4	15 1/4	19	6	7 1/4	95
R-3342	11	15	5	15 1/4	19 1/4	23	9 1/4	11 1/4	220
R-3343	13 1/2	17 1/2	7	17 1/4	21 1/4	25	11 1/4	13 1/4	275
R-3344	15	19	9	19 1/4	23 1/4	27	13 1/4	15 1/4	360
R-3345	17 1/2	21 1/2	11	21 1/4	25 1/4	29	15 1/4	17 1/4	415
R-3346	19	23	13	23 1/4	27 1/4	31	17 1/4	19 1/4	470
R-3347	21 1/2	25 1/2	15	25 1/4	29 1/4	33	19 1/4	21 1/4	525
R-3348	23 1/2	27 1/2	17	27 1/4	31 1/4	35	21 1/4	23 1/4	580
R-3349	25 1/2	29 1/2	19	29 1/4	33 1/4	37	23 1/4	25 1/4	635
R-3350	27 1/2	31 1/2	21	31 1/4	35 1/4	39	25 1/4	27 1/4	690
R-3351	29 1/2	33 1/2	23	33 1/4	37 1/4	41	27 1/4	29 1/4	745
R-3352	31 1/2	35 1/2	25	35 1/4	39 1/4	43	29 1/4	31 1/4	800
R-3353	33 1/2	37 1/2	27	37 1/4	41 1/4	45	31 1/4	33 1/4	855
R-3354	35 1/2	39 1/2	29	39 1/4	43 1/4	47	33 1/4	35 1/4	910
R-3355	37 1/2	41 1/2	31	41 1/4	45 1/4	49	35 1/4	37 1/4	965

** Also available with flat grate.
*** Also available with flat grate.
**** Also available with openings per inch in gutter.
†† Grate supported by legs.





R-3341 Frame and Grate

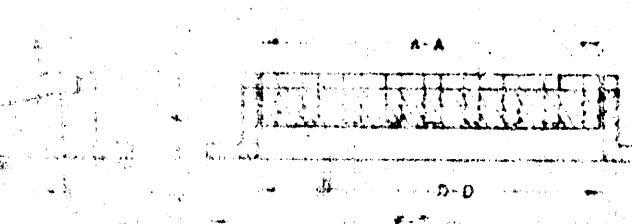

R-3341 Frame and Grate



R-3349 Concave Gutter Inlet Frame and Grate







Heavy Duty
Total Weight 810 Pounds

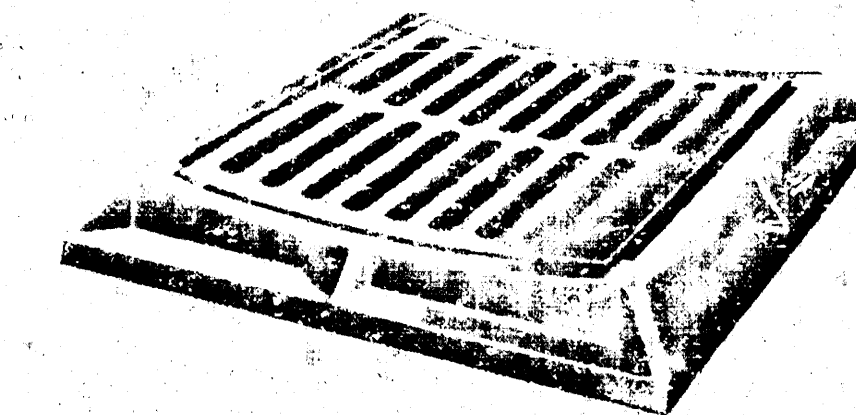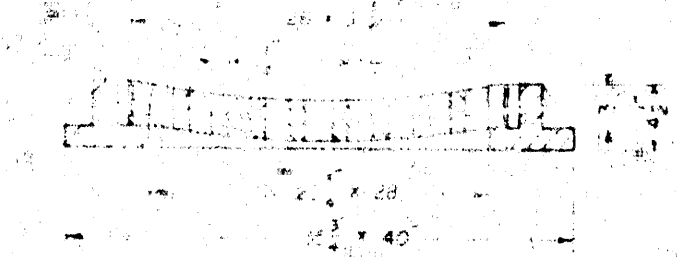

R-3349-A Concave Gutter Inlet Frame and Grate

Heavy Duty
Total Weight 360 Pounds

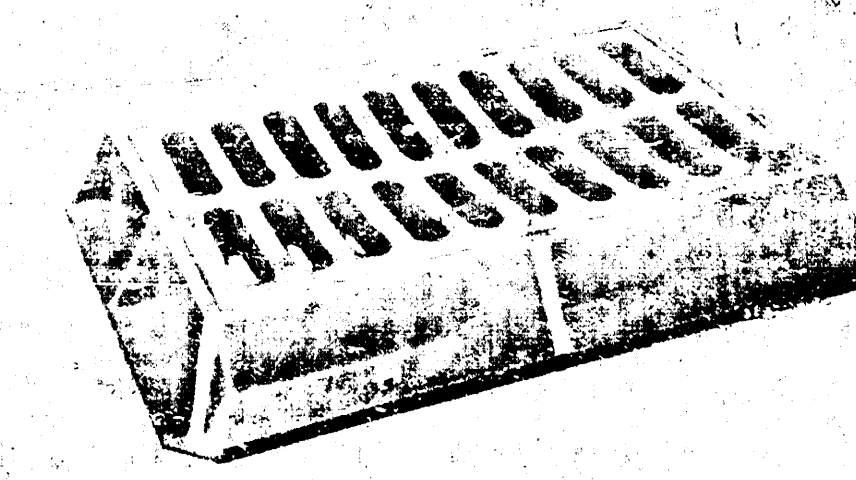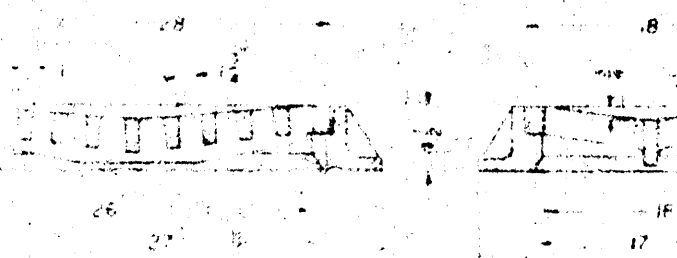

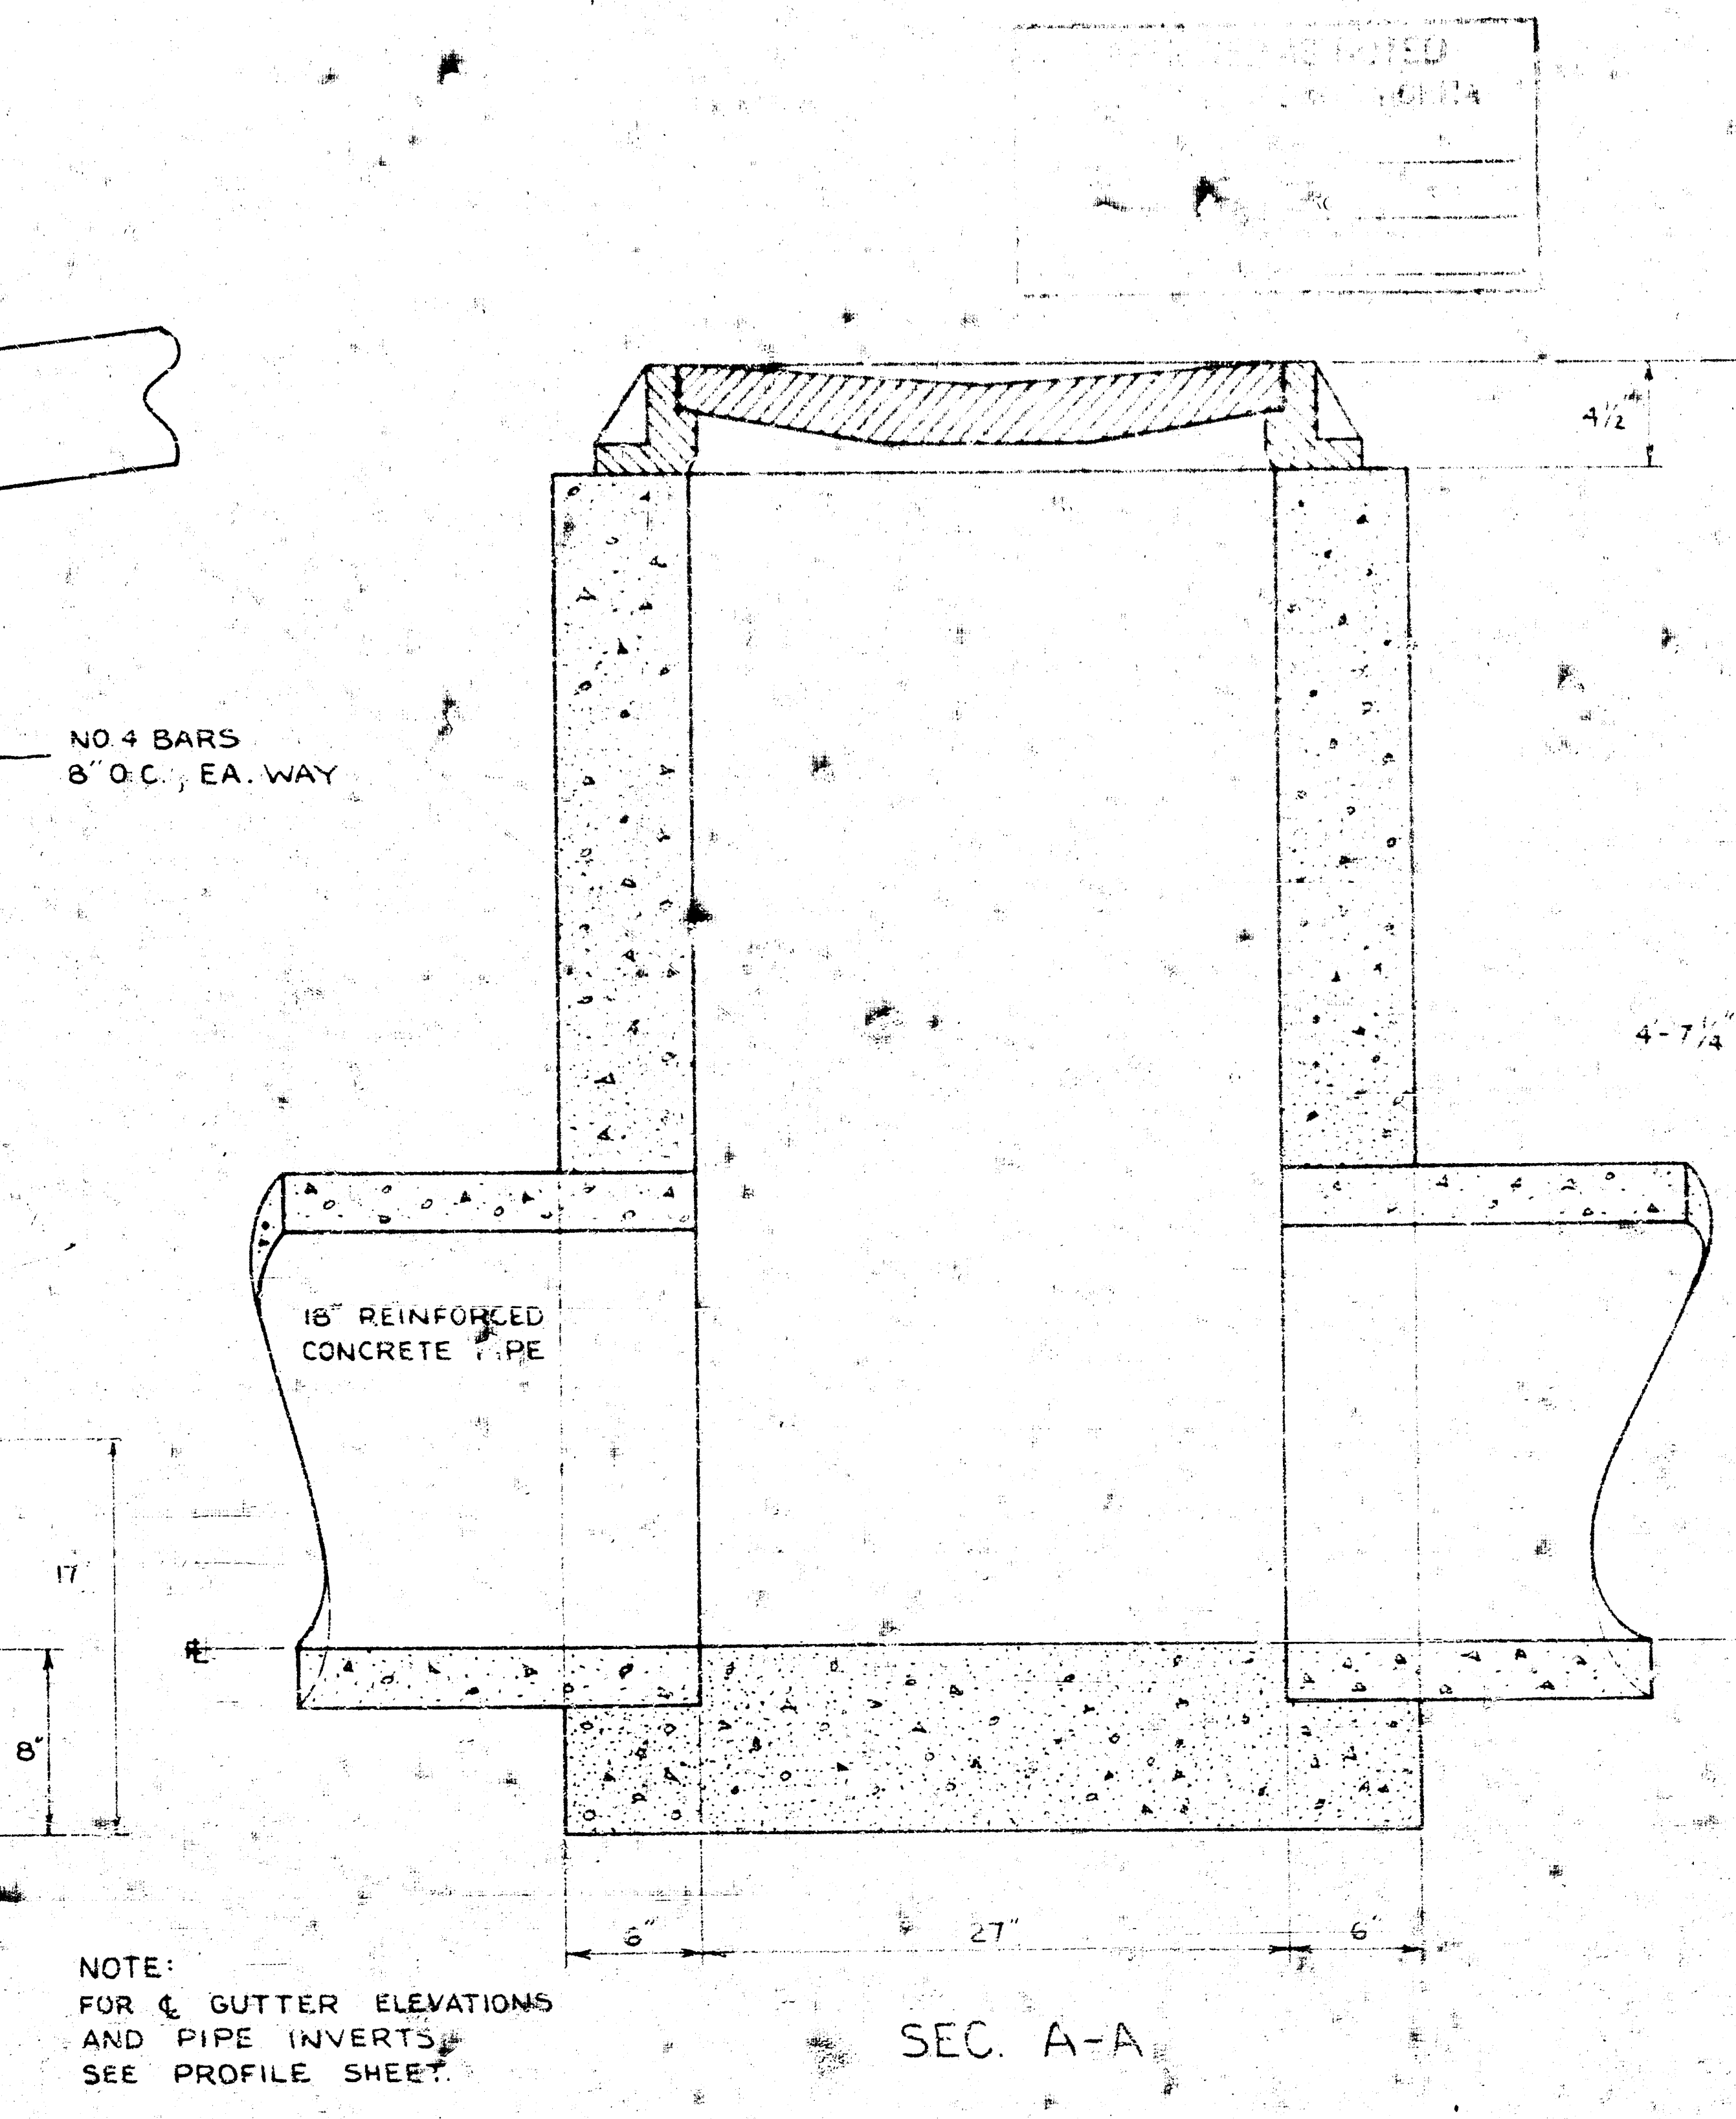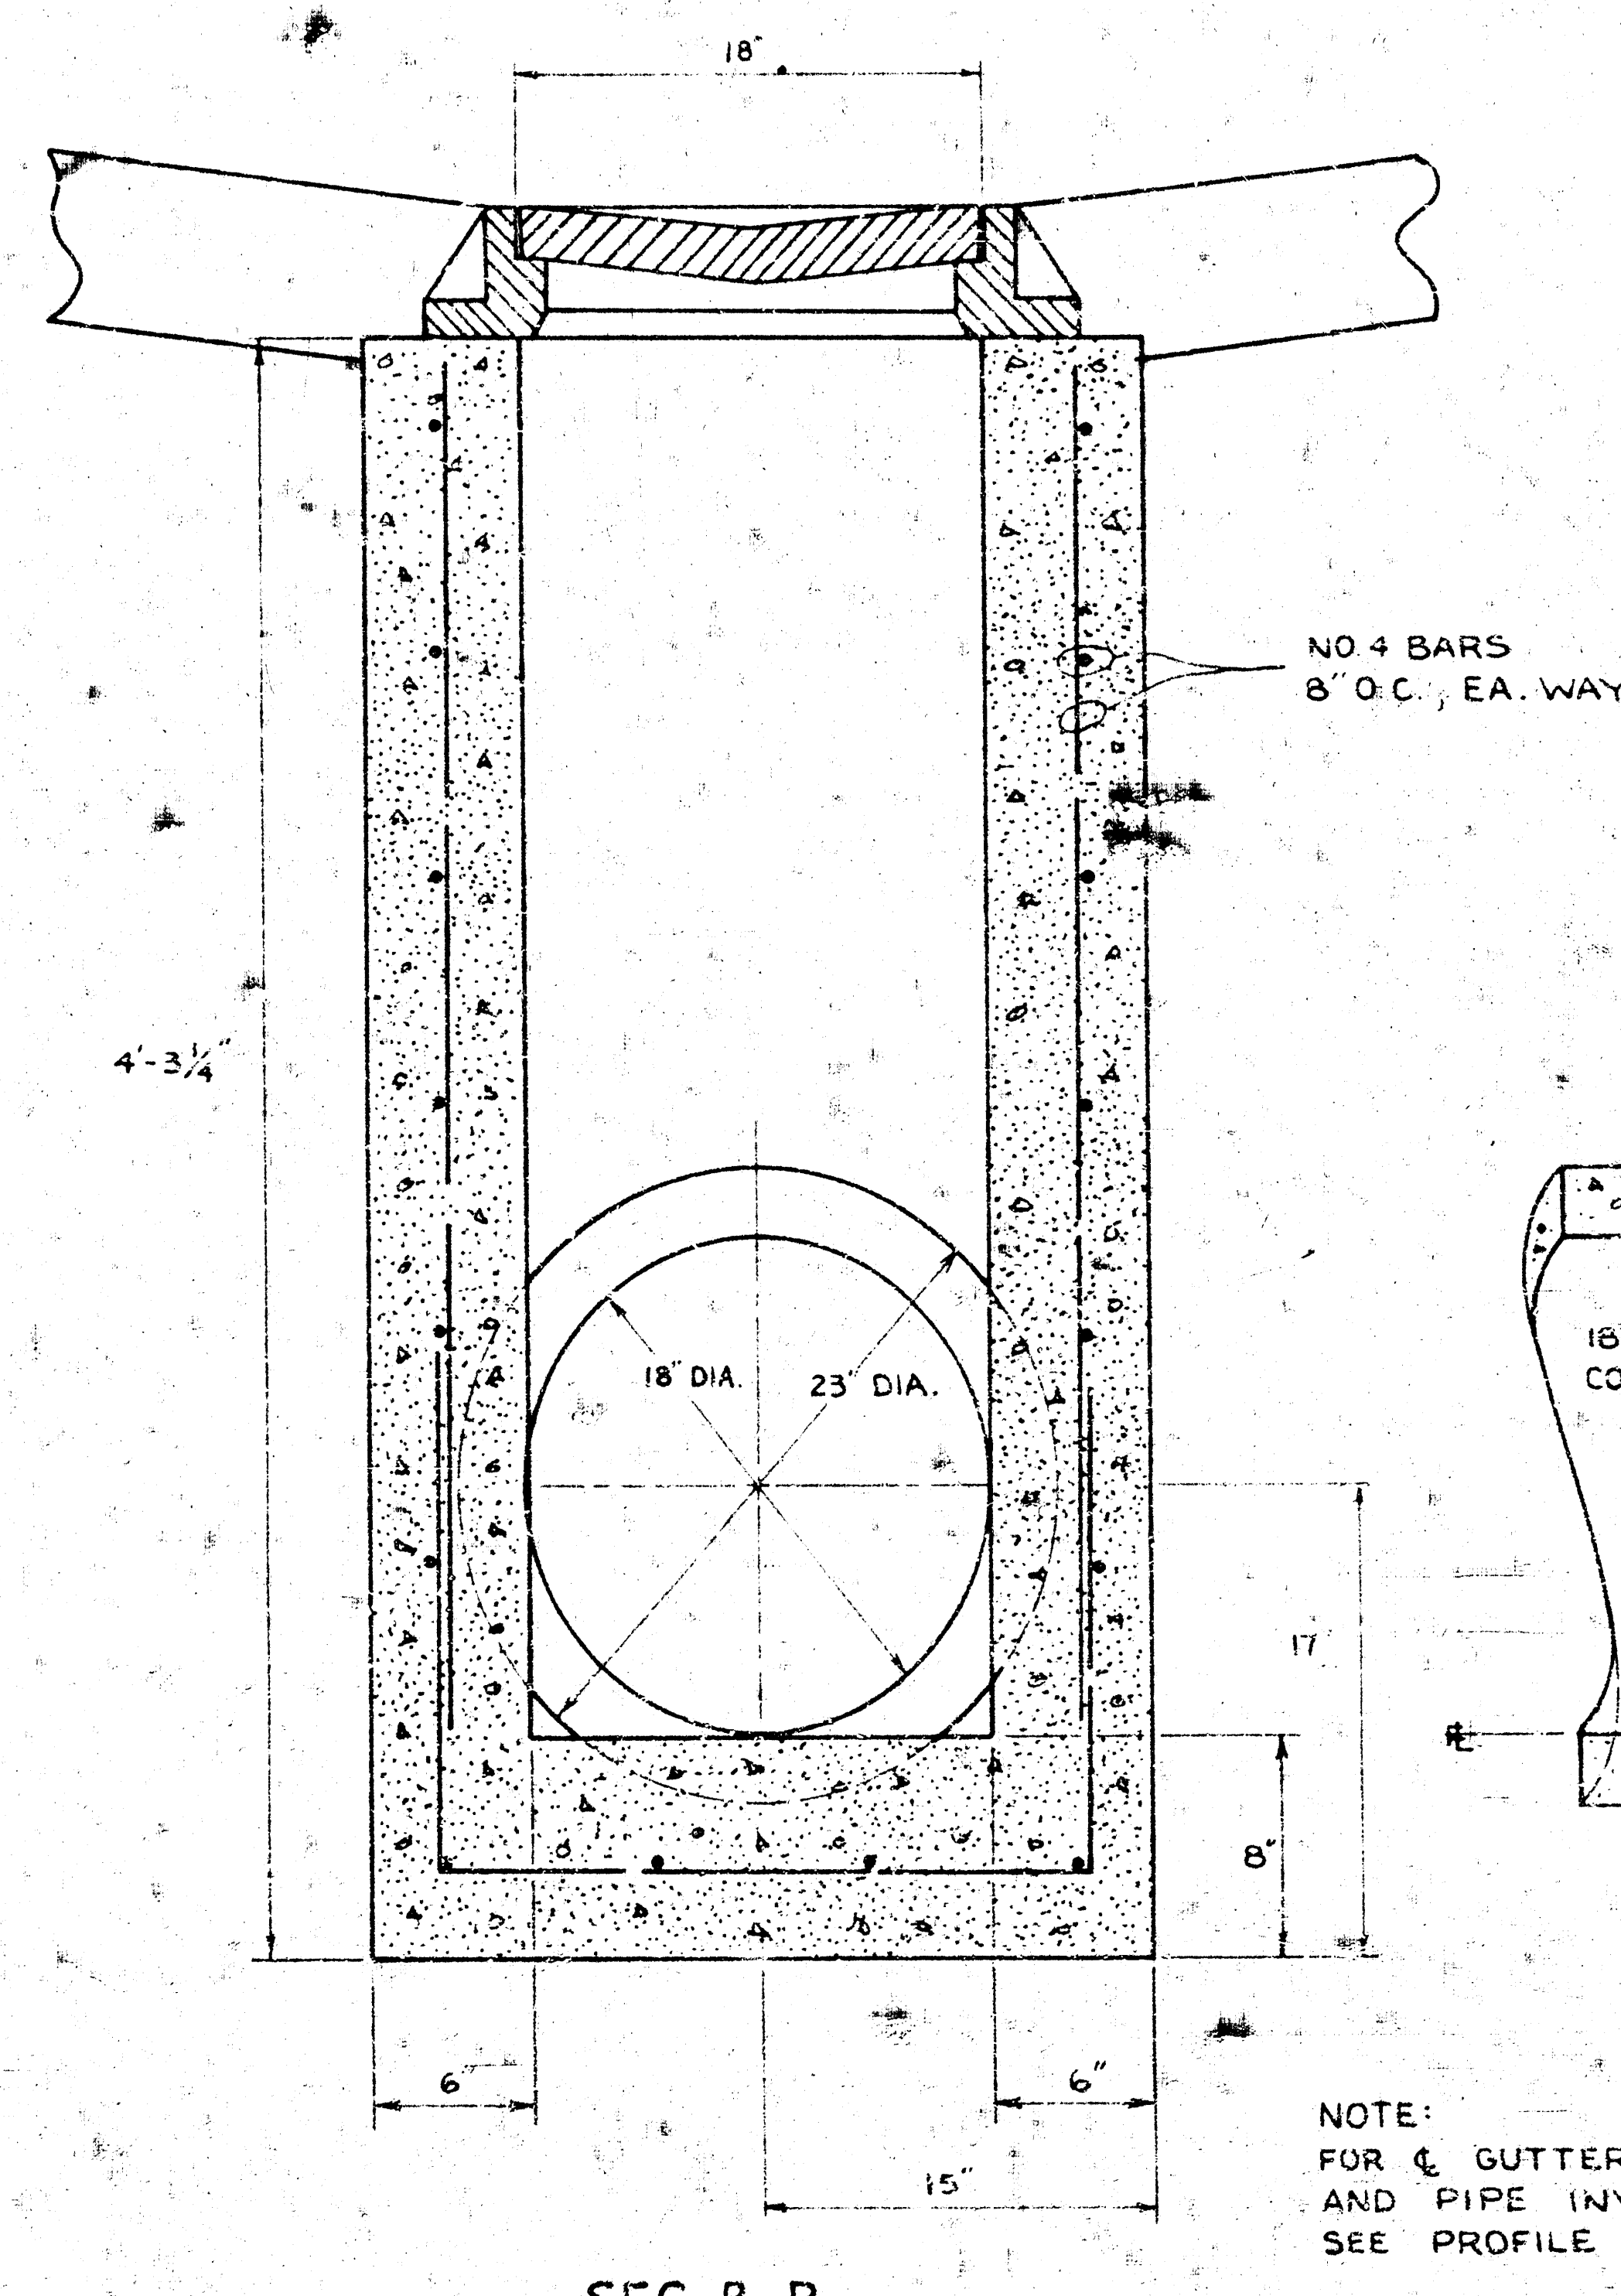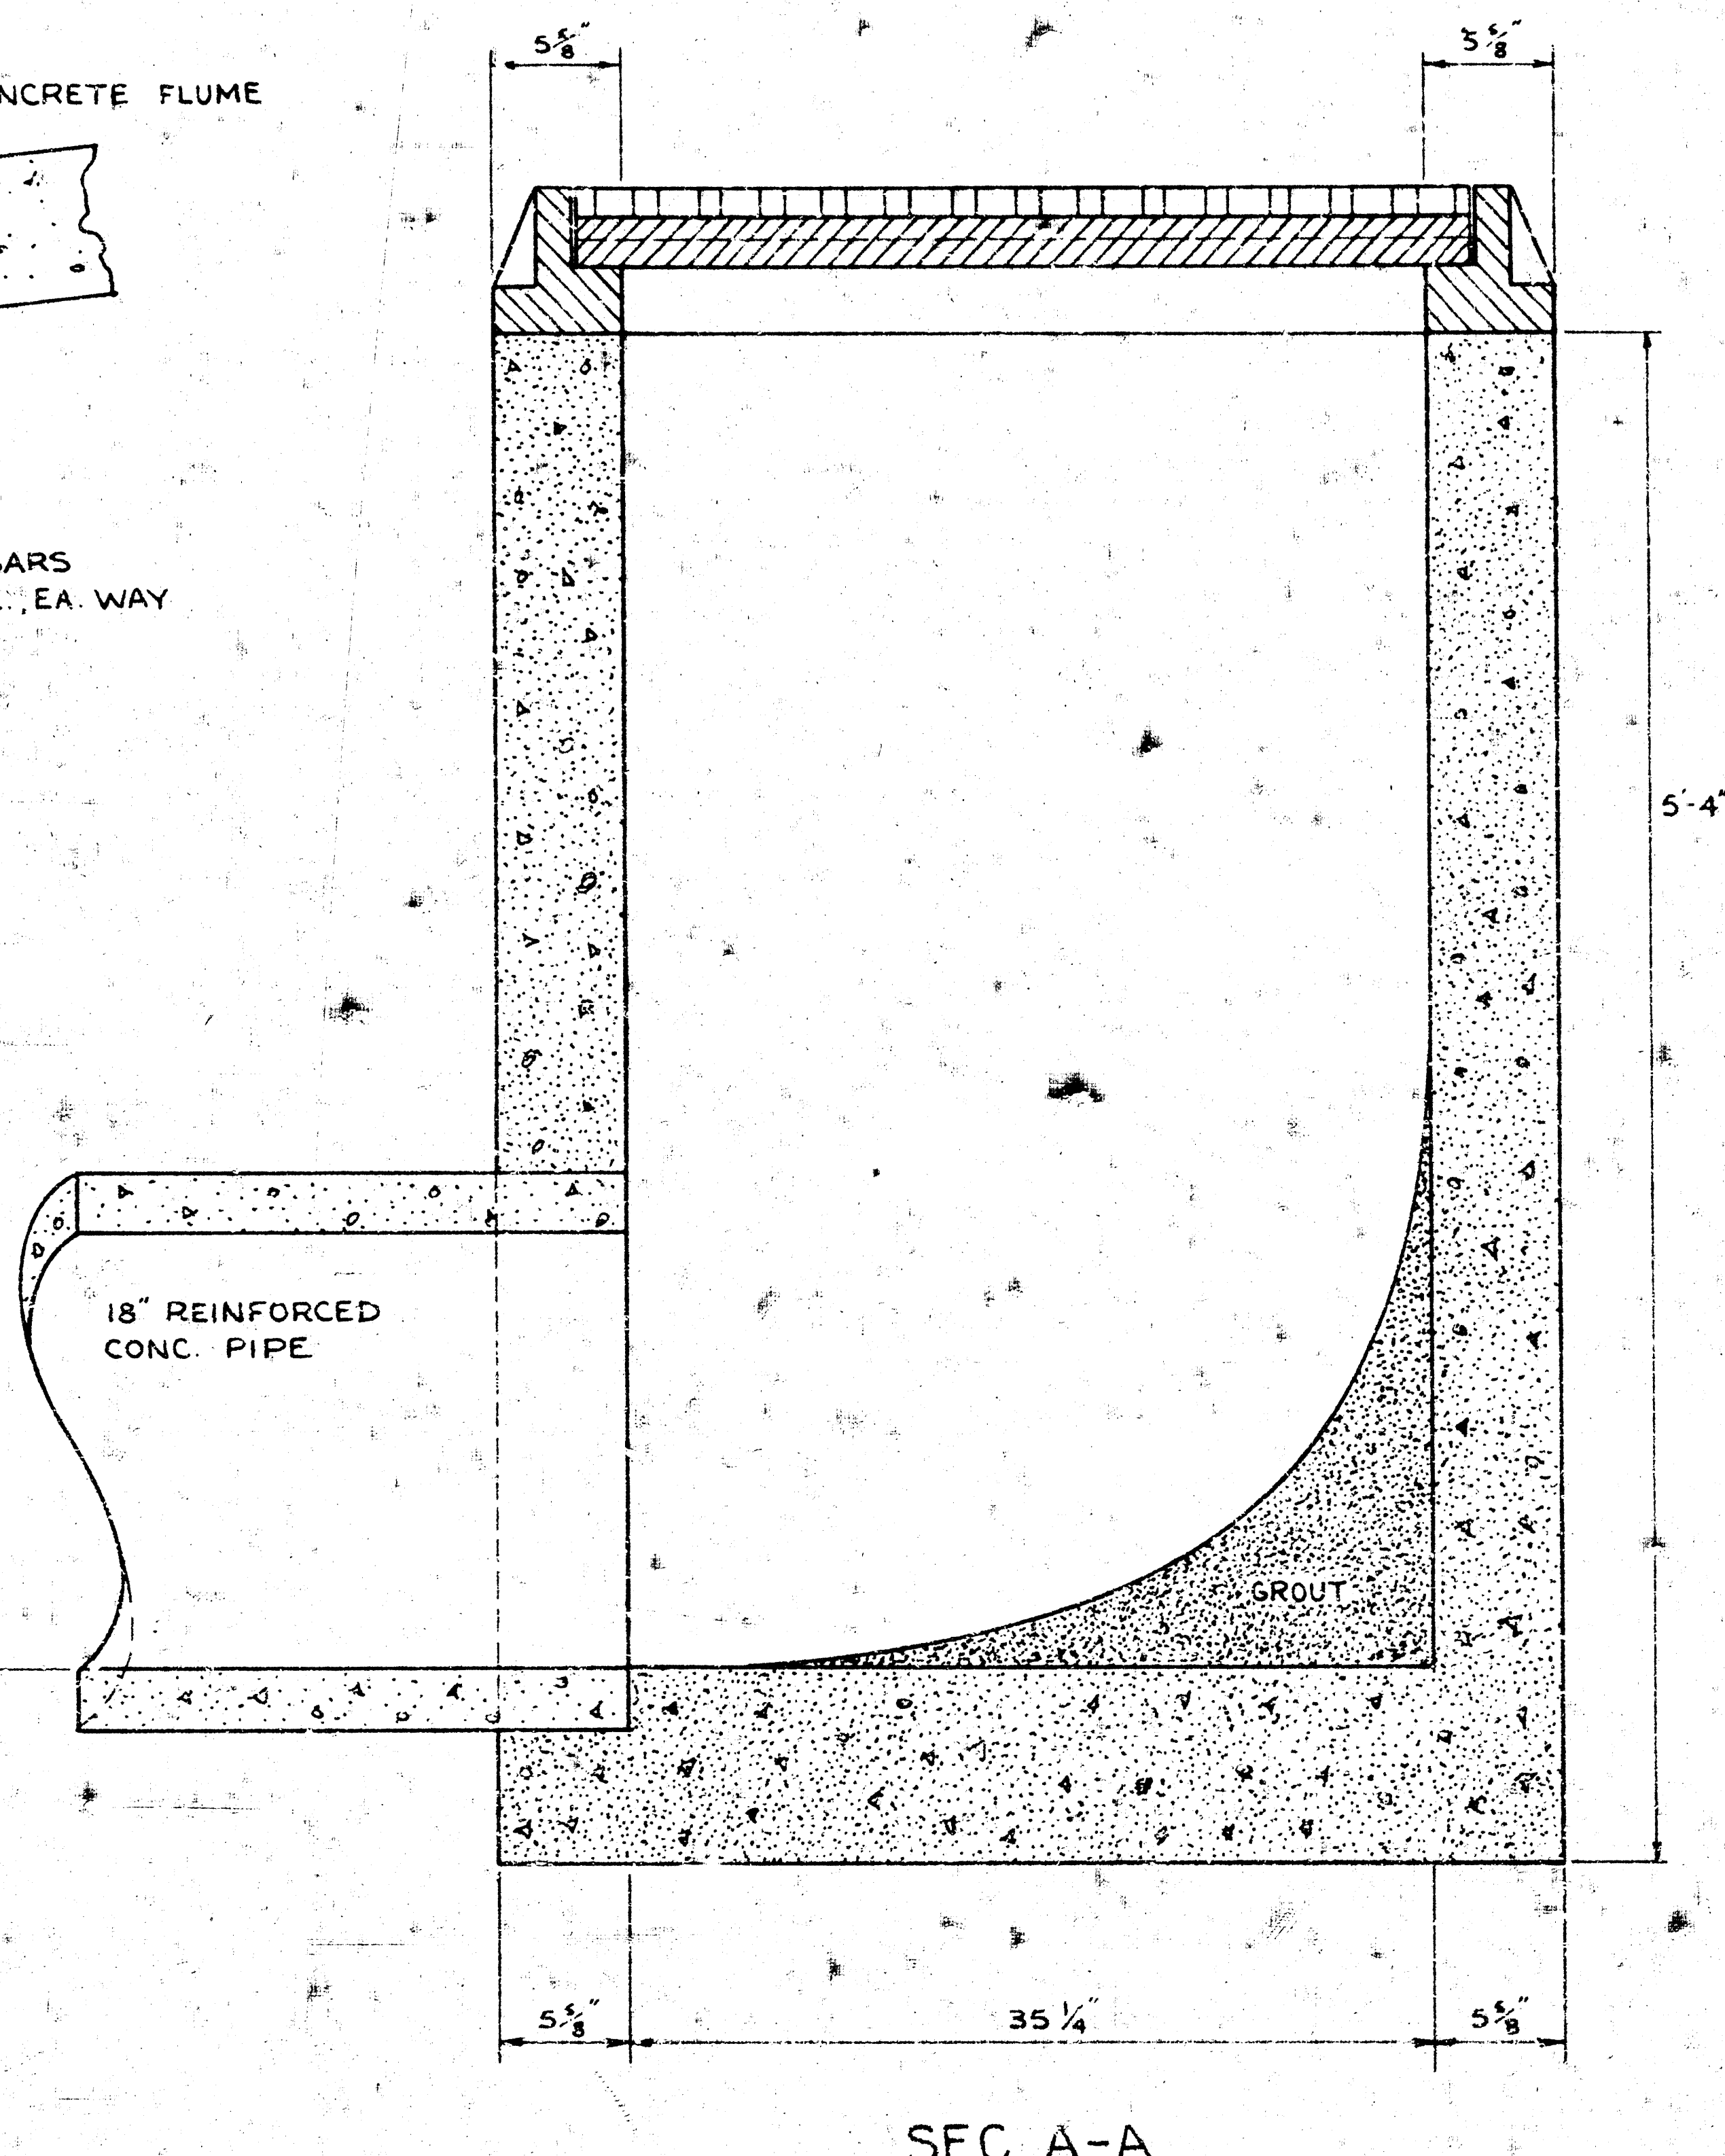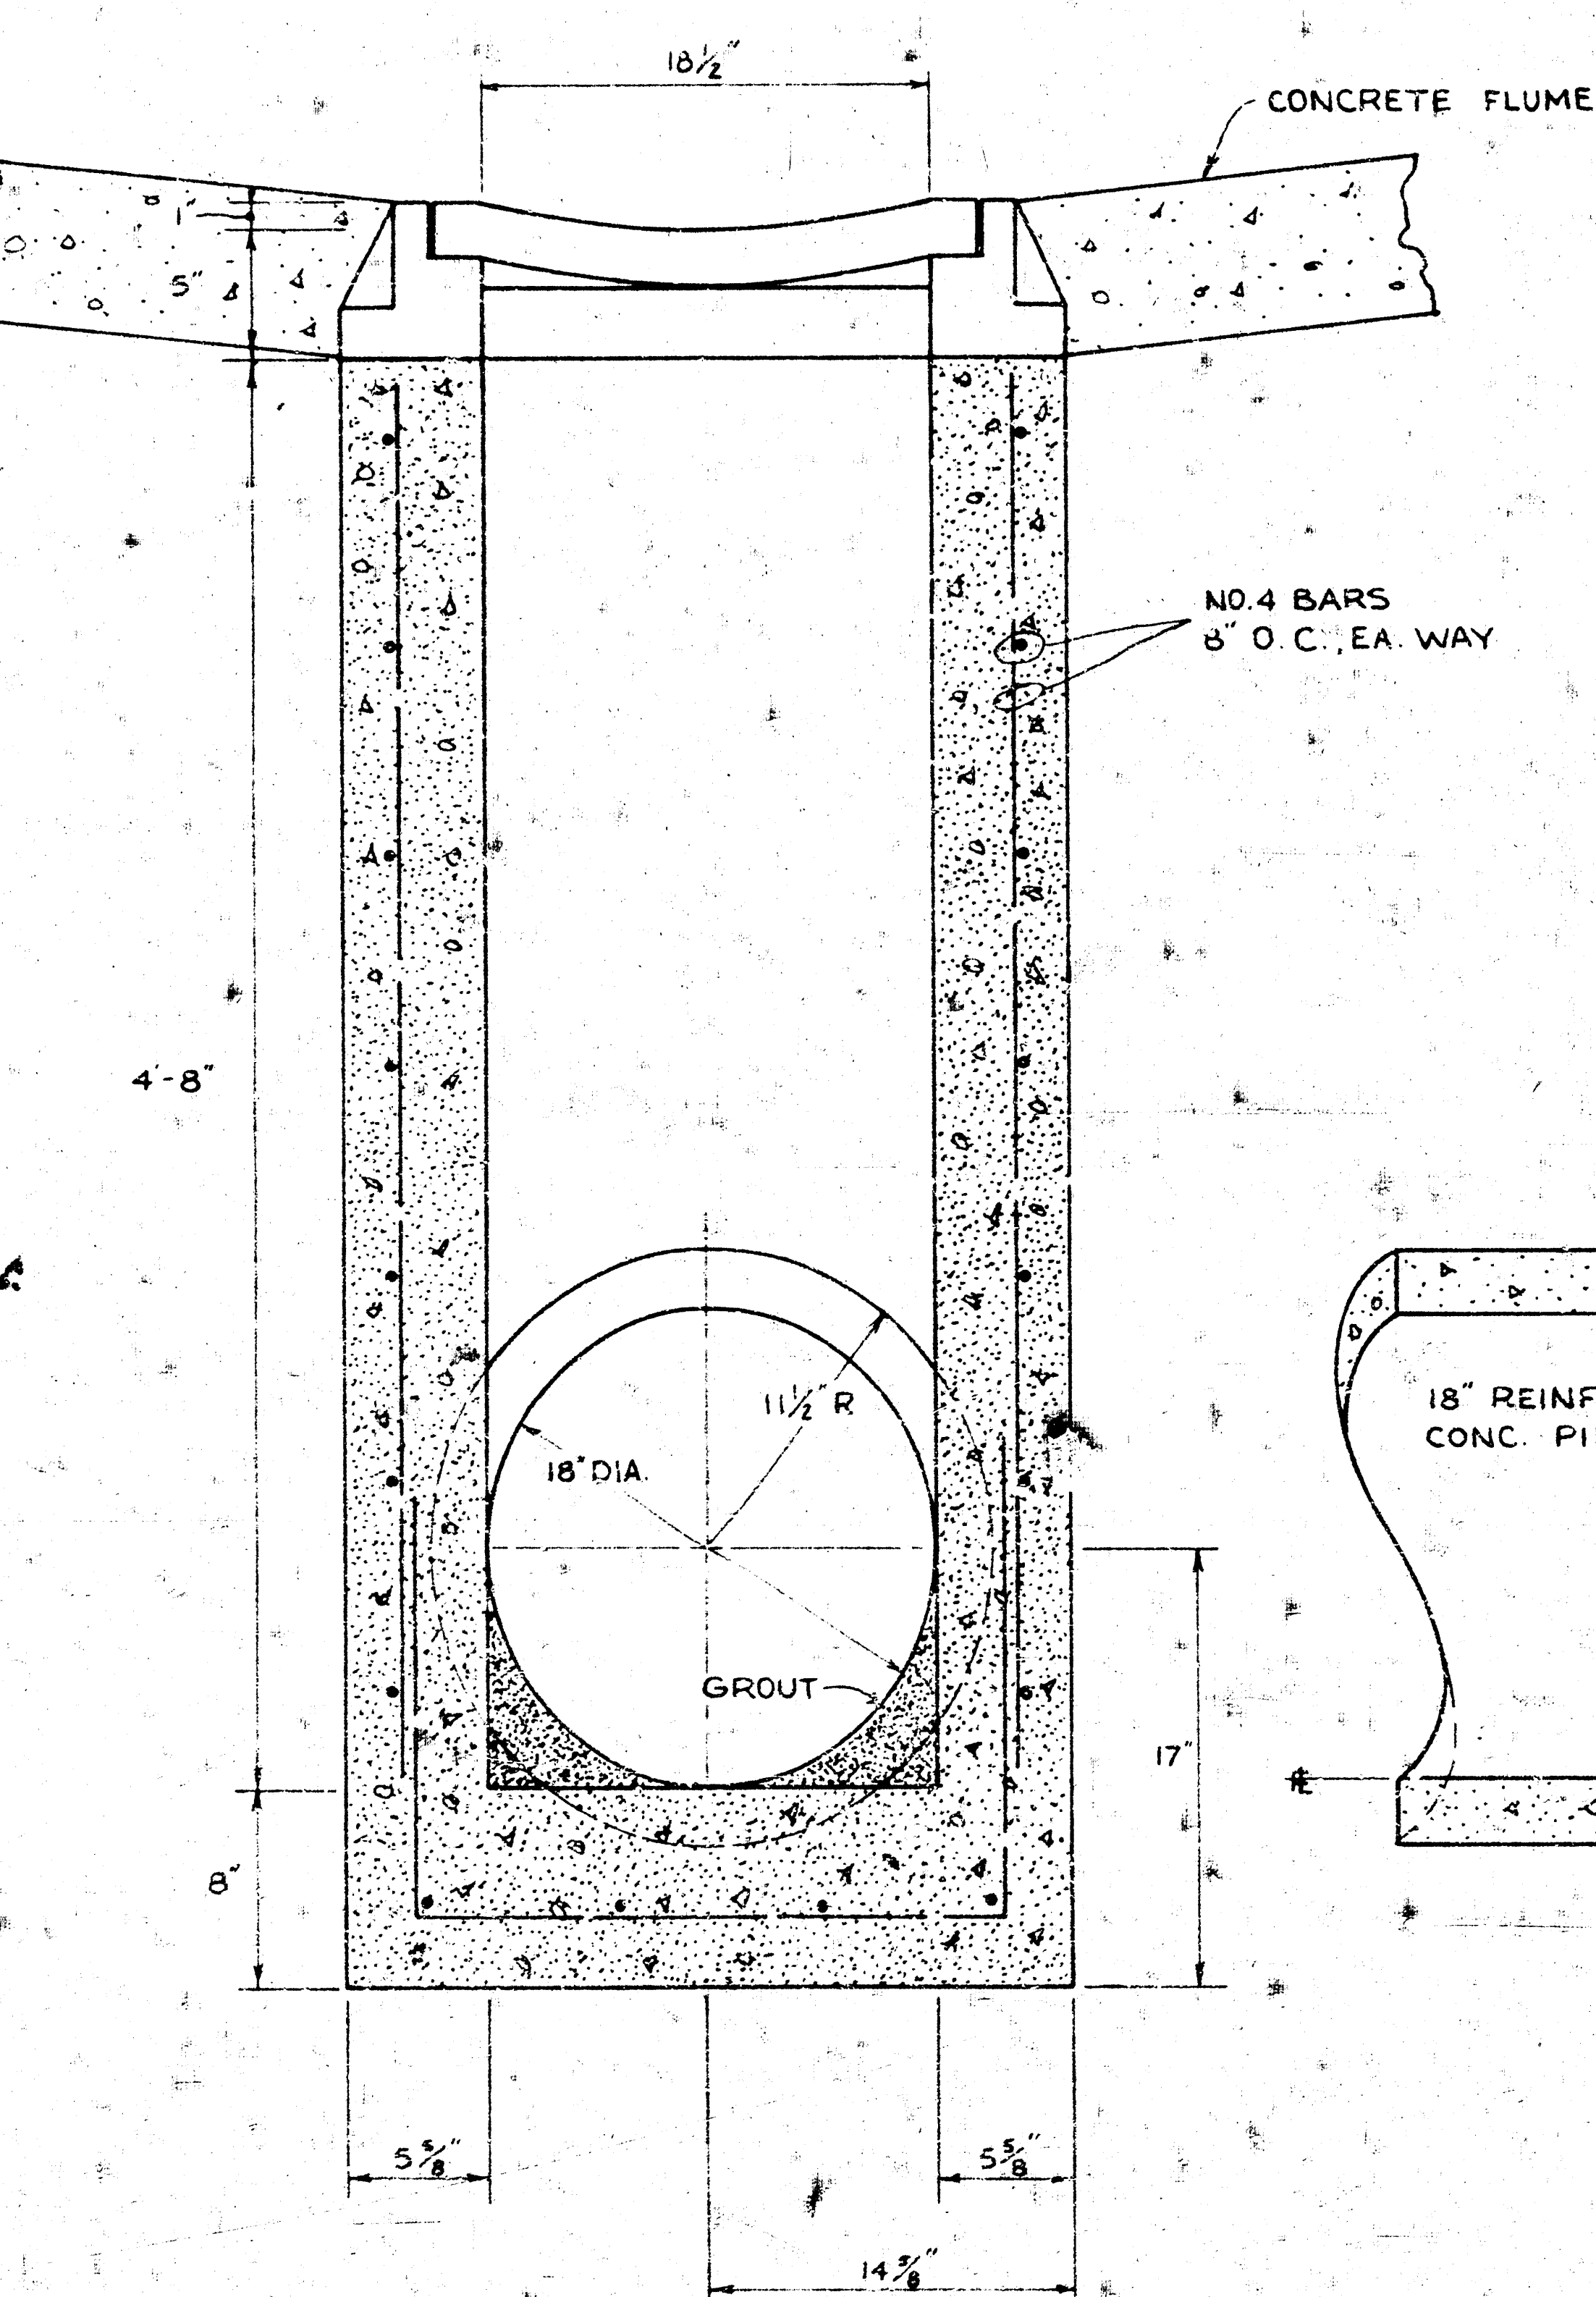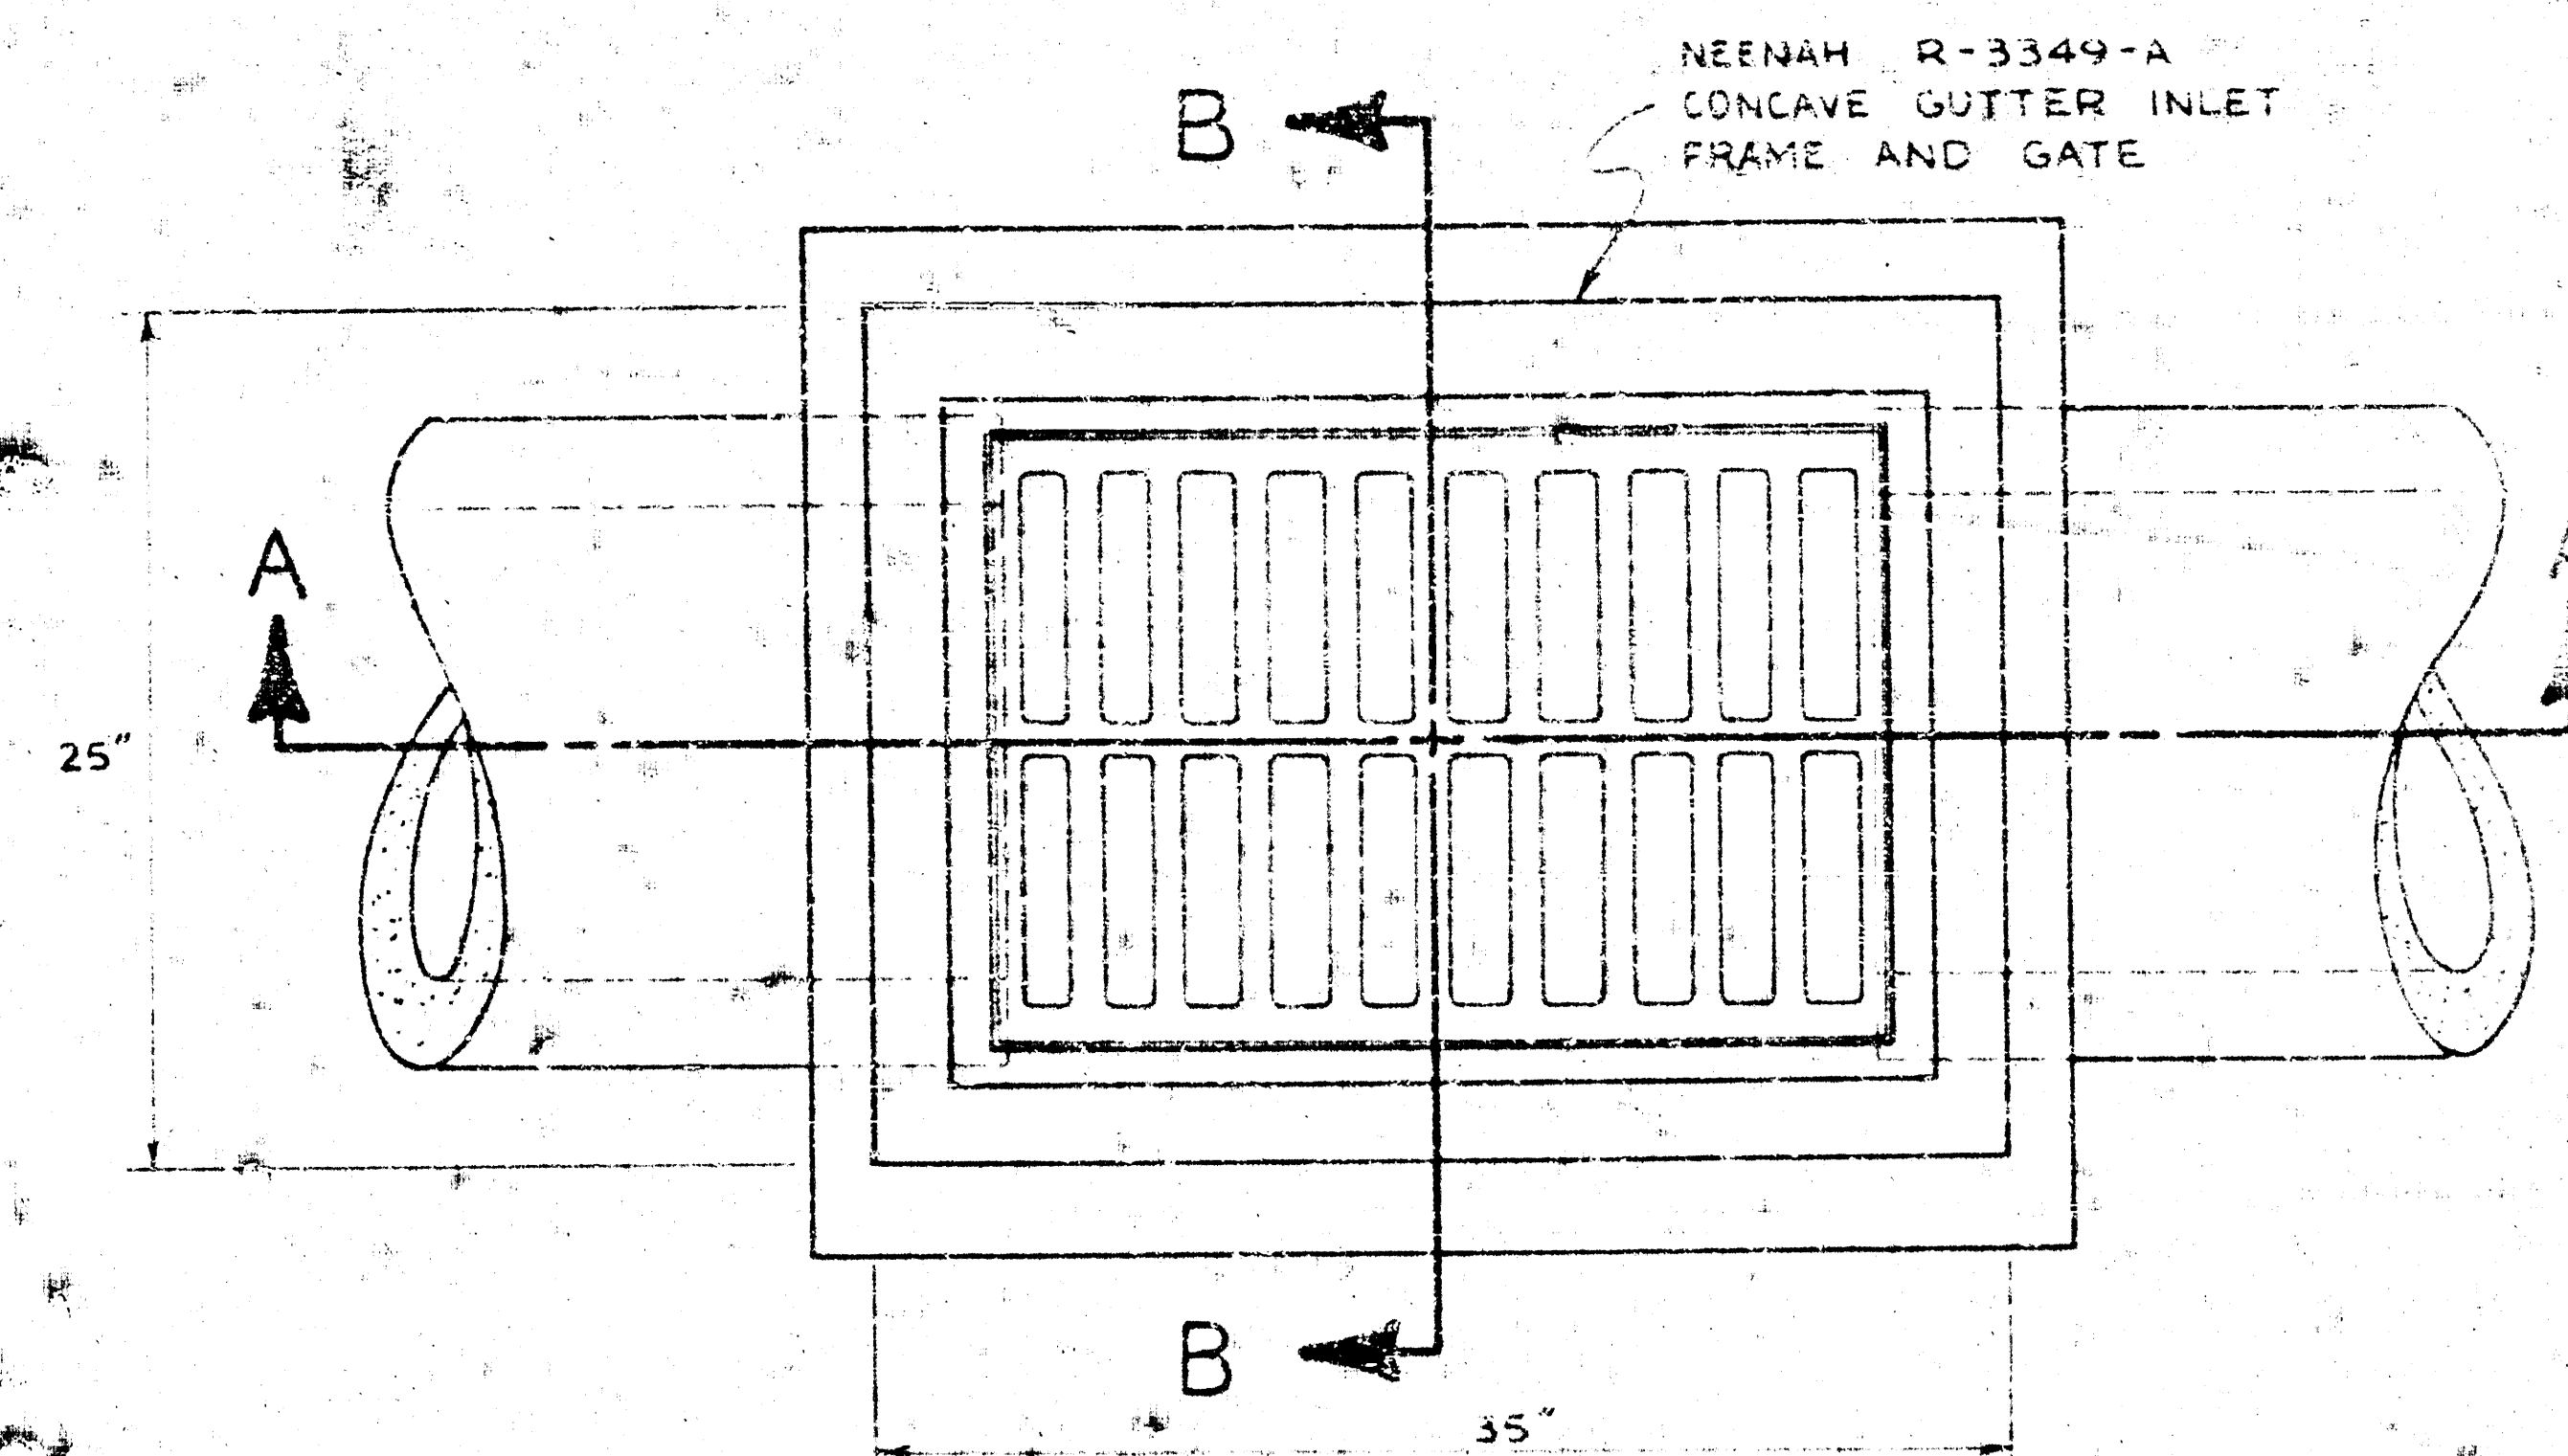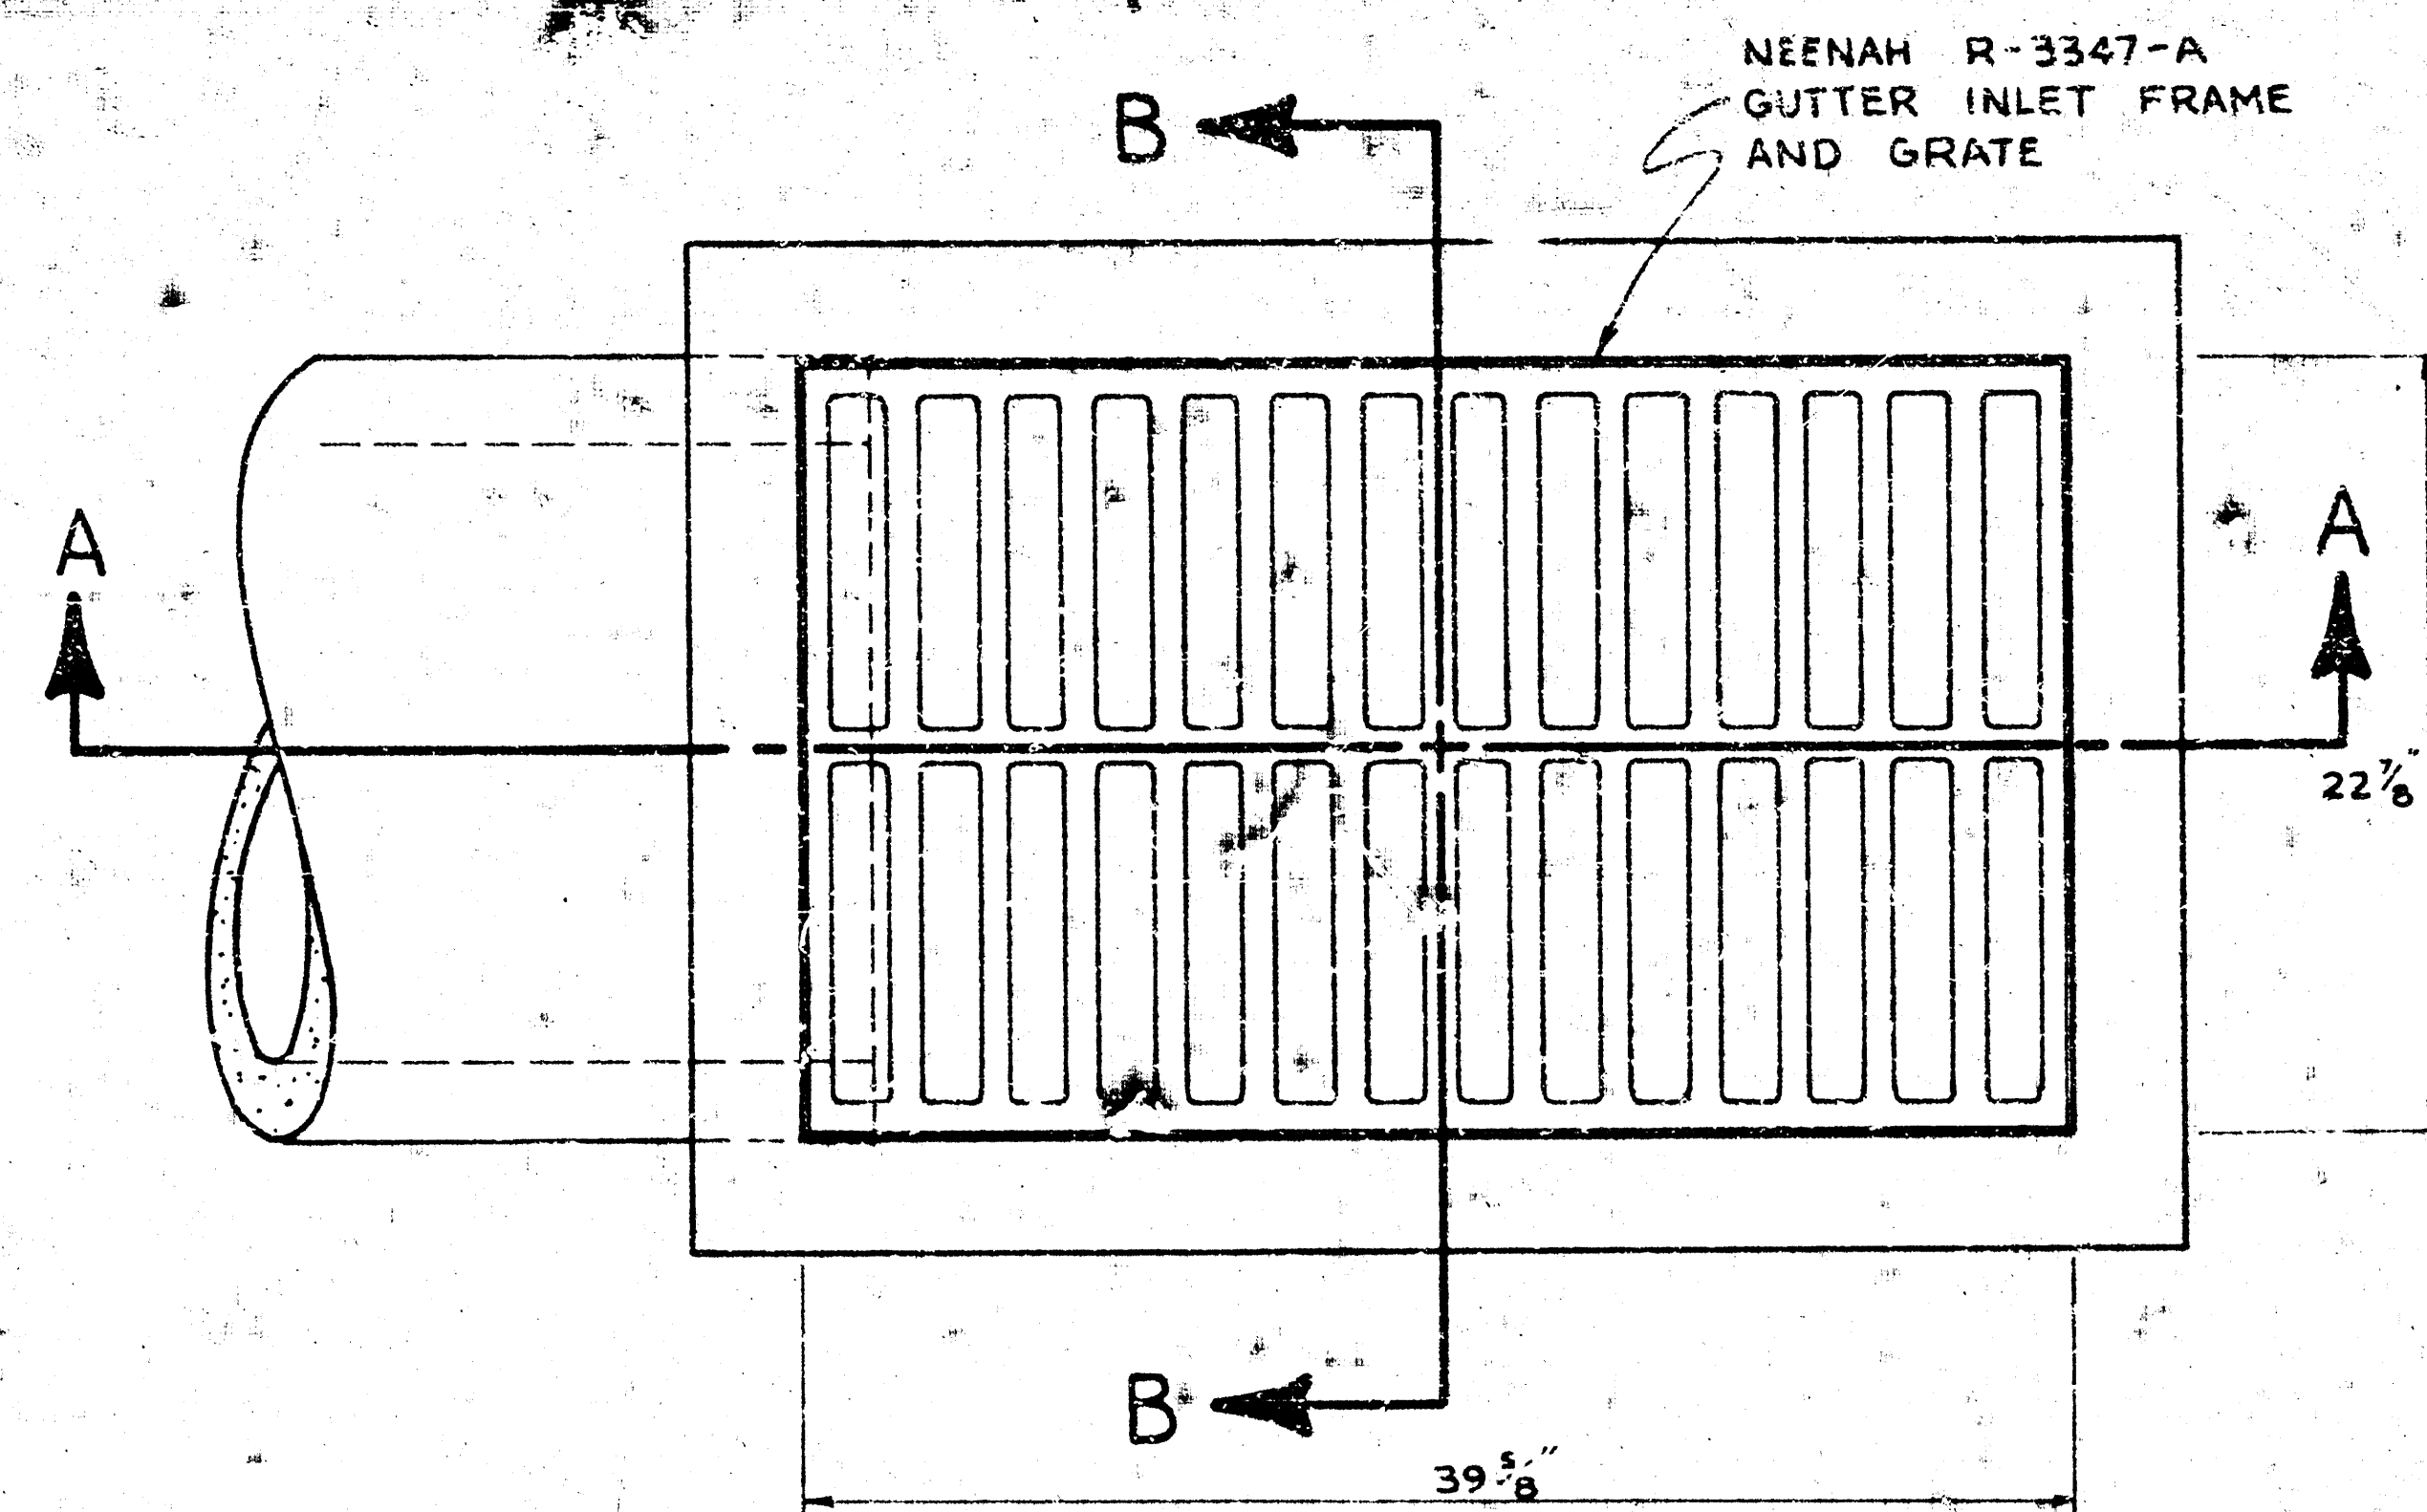

NOTE:
FOR GUTTER ELEVATIONS
AND PIPE INVERTS
SEE PROFILE SHEET.

GUTTER INLET DETAIL
TYPE-A
SCALE 1/2" = 1'-0"

GUTTER INLET DETAIL
TYPE-B
SCALE 1/2" = 1'-0"