

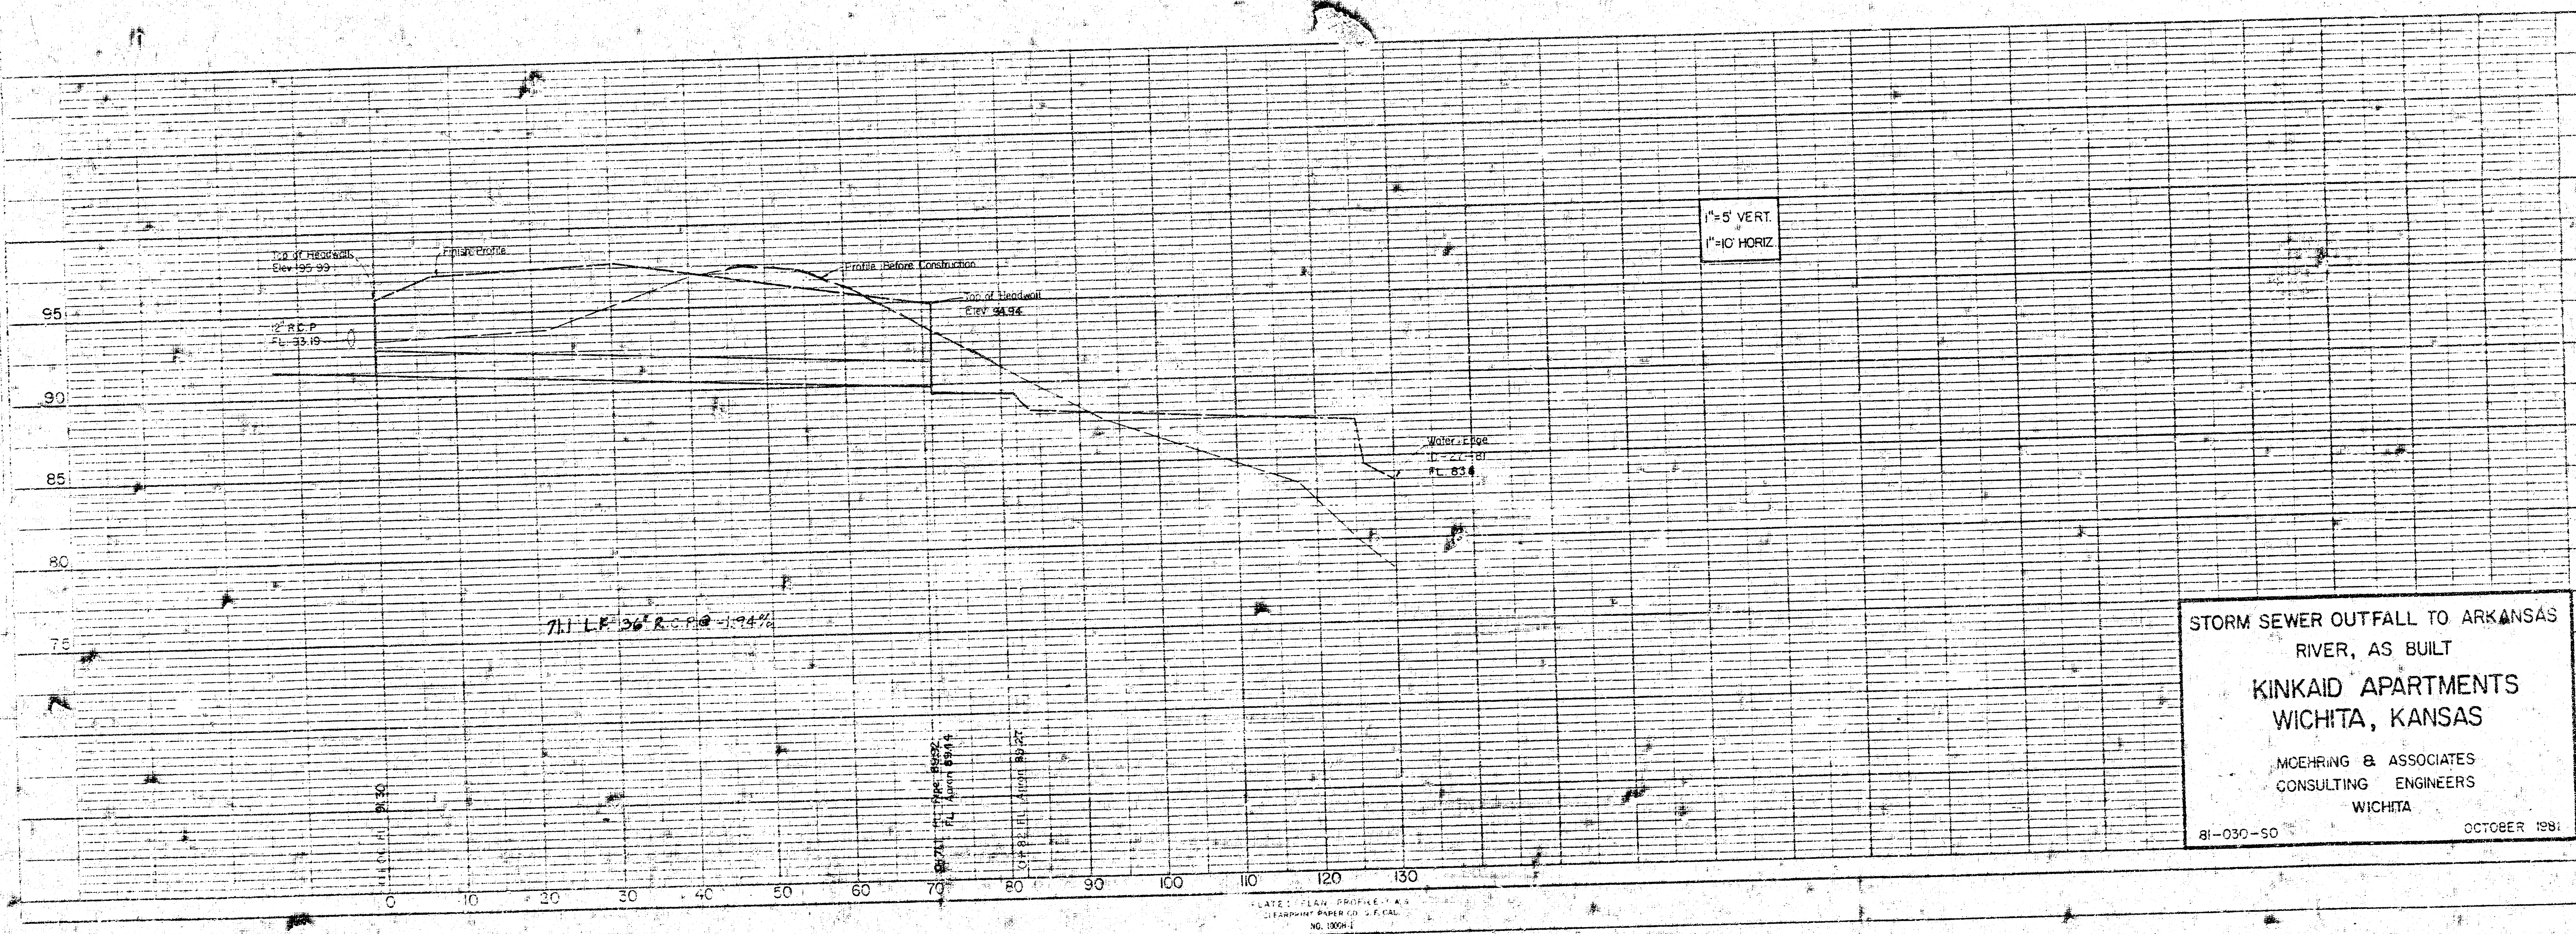


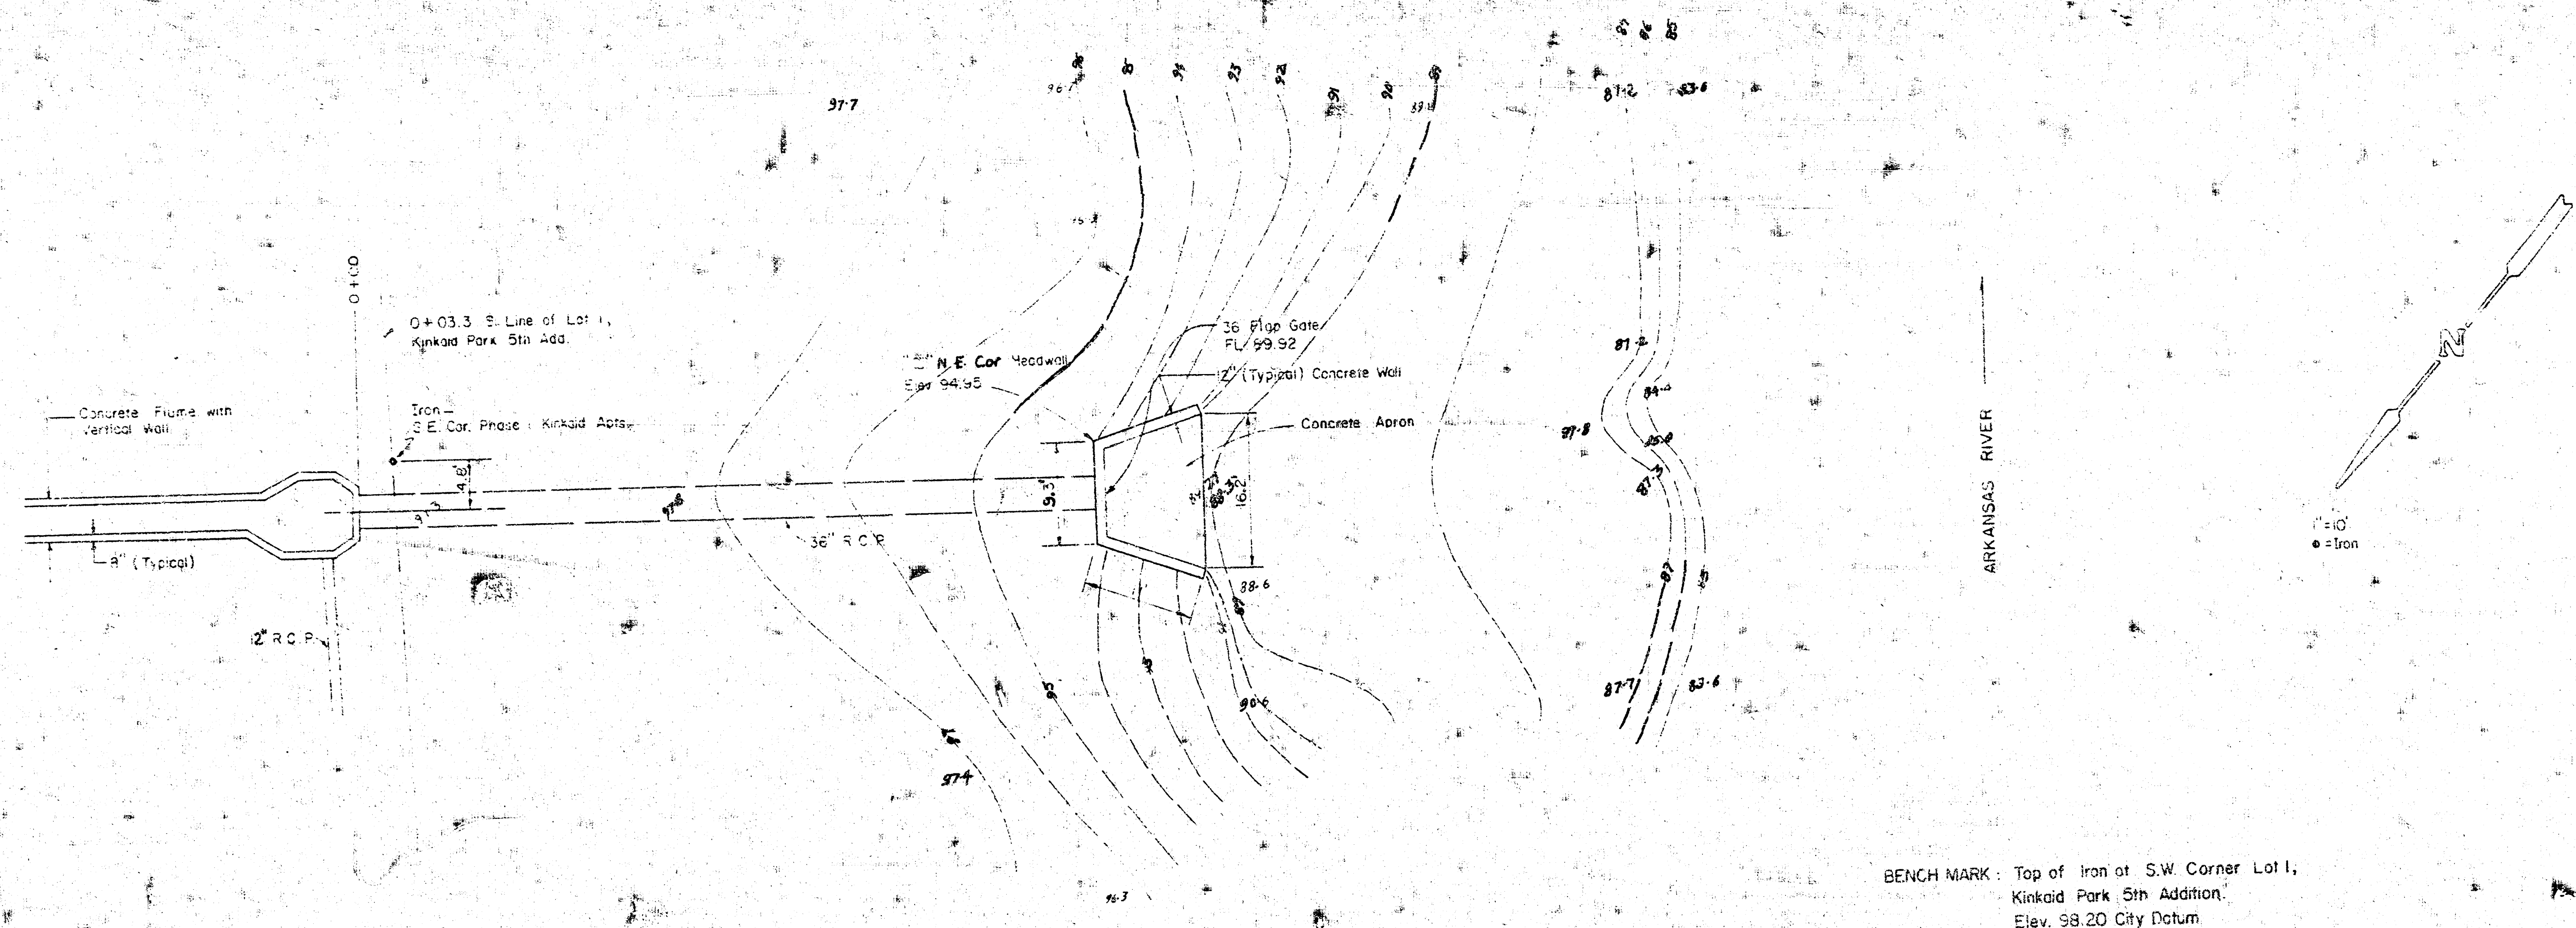

STORM SEWER OUTFALL TO ARKANSAS
RIVER, AS BUILT
KINKAID APARTMENTS
WICHITA, KANSAS
MCEHRING & ASSOCIATES
CONSULTING ENGINEERS
WICHITA
81-030-50 OCTOBER 1981

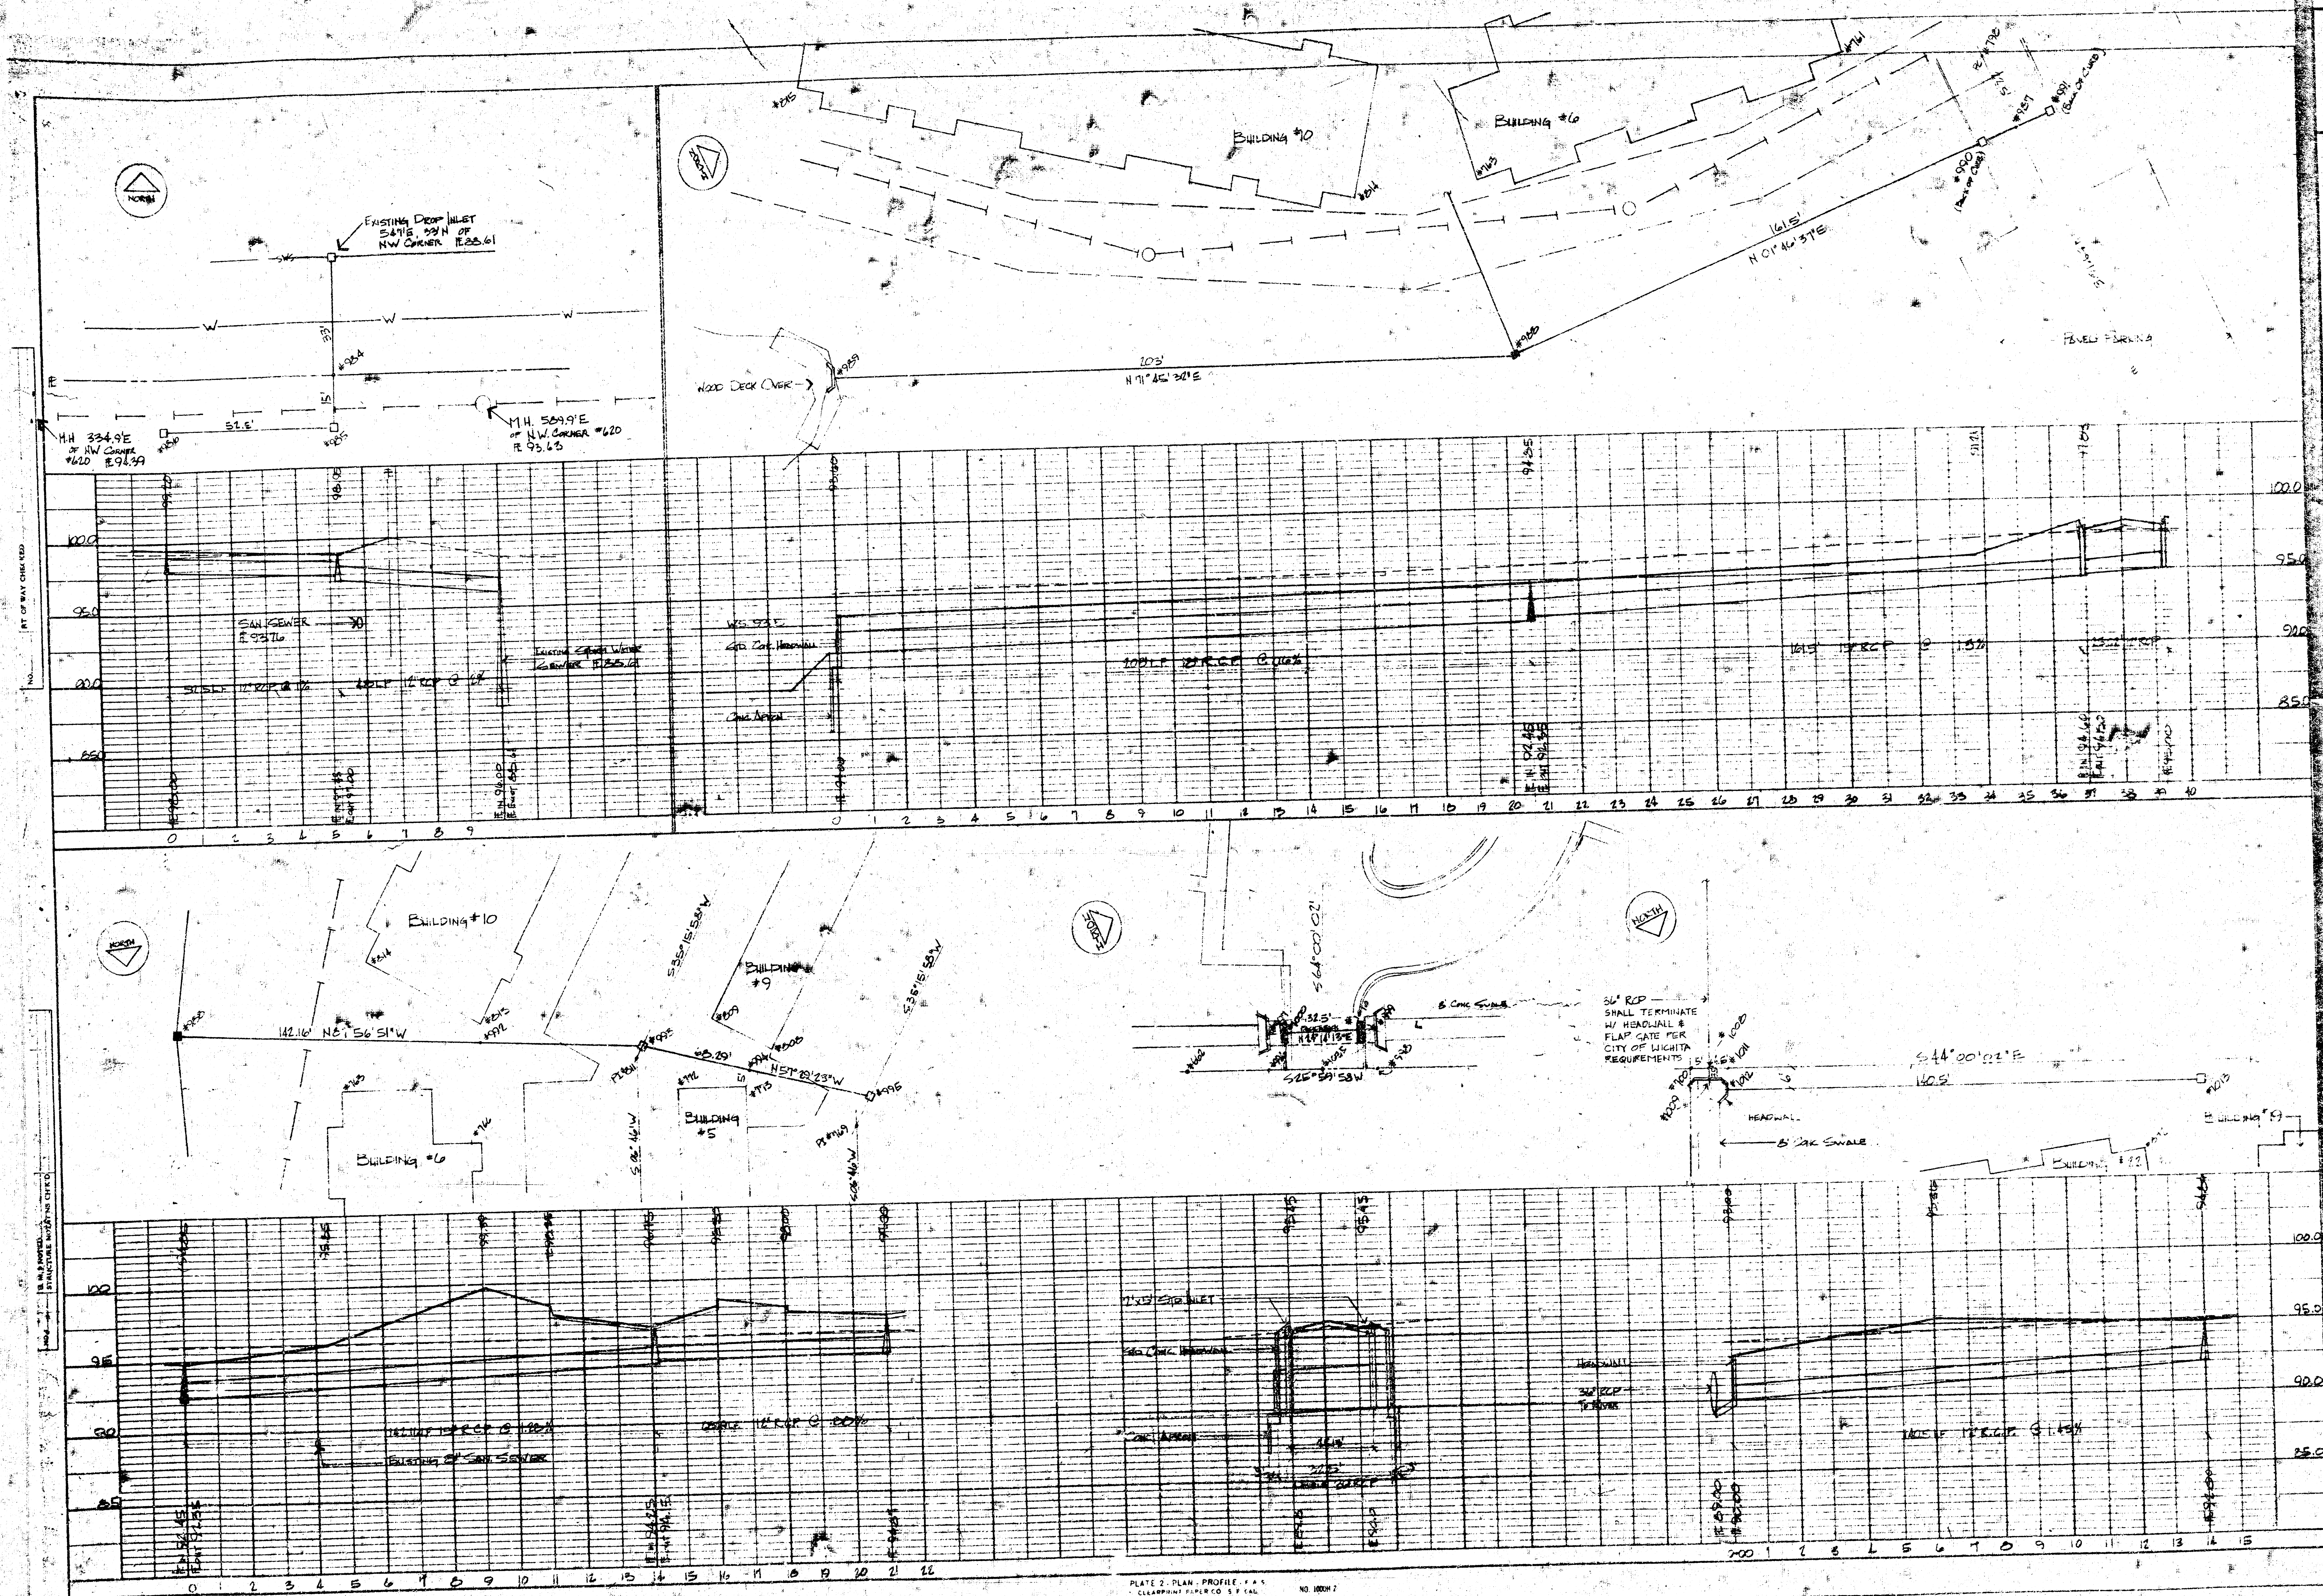

LAWRENCE E. WELLS

ARCHITECT

254 LAURA SUITE 205
WICHITA, KANSAS 67211

KINKAID PARK APTS.

FOR KINKAID INC.


MARION and SOUTH TOPEKA

WICHITA

NATION and SOUTH

WICHITA

NATION and SOUTH

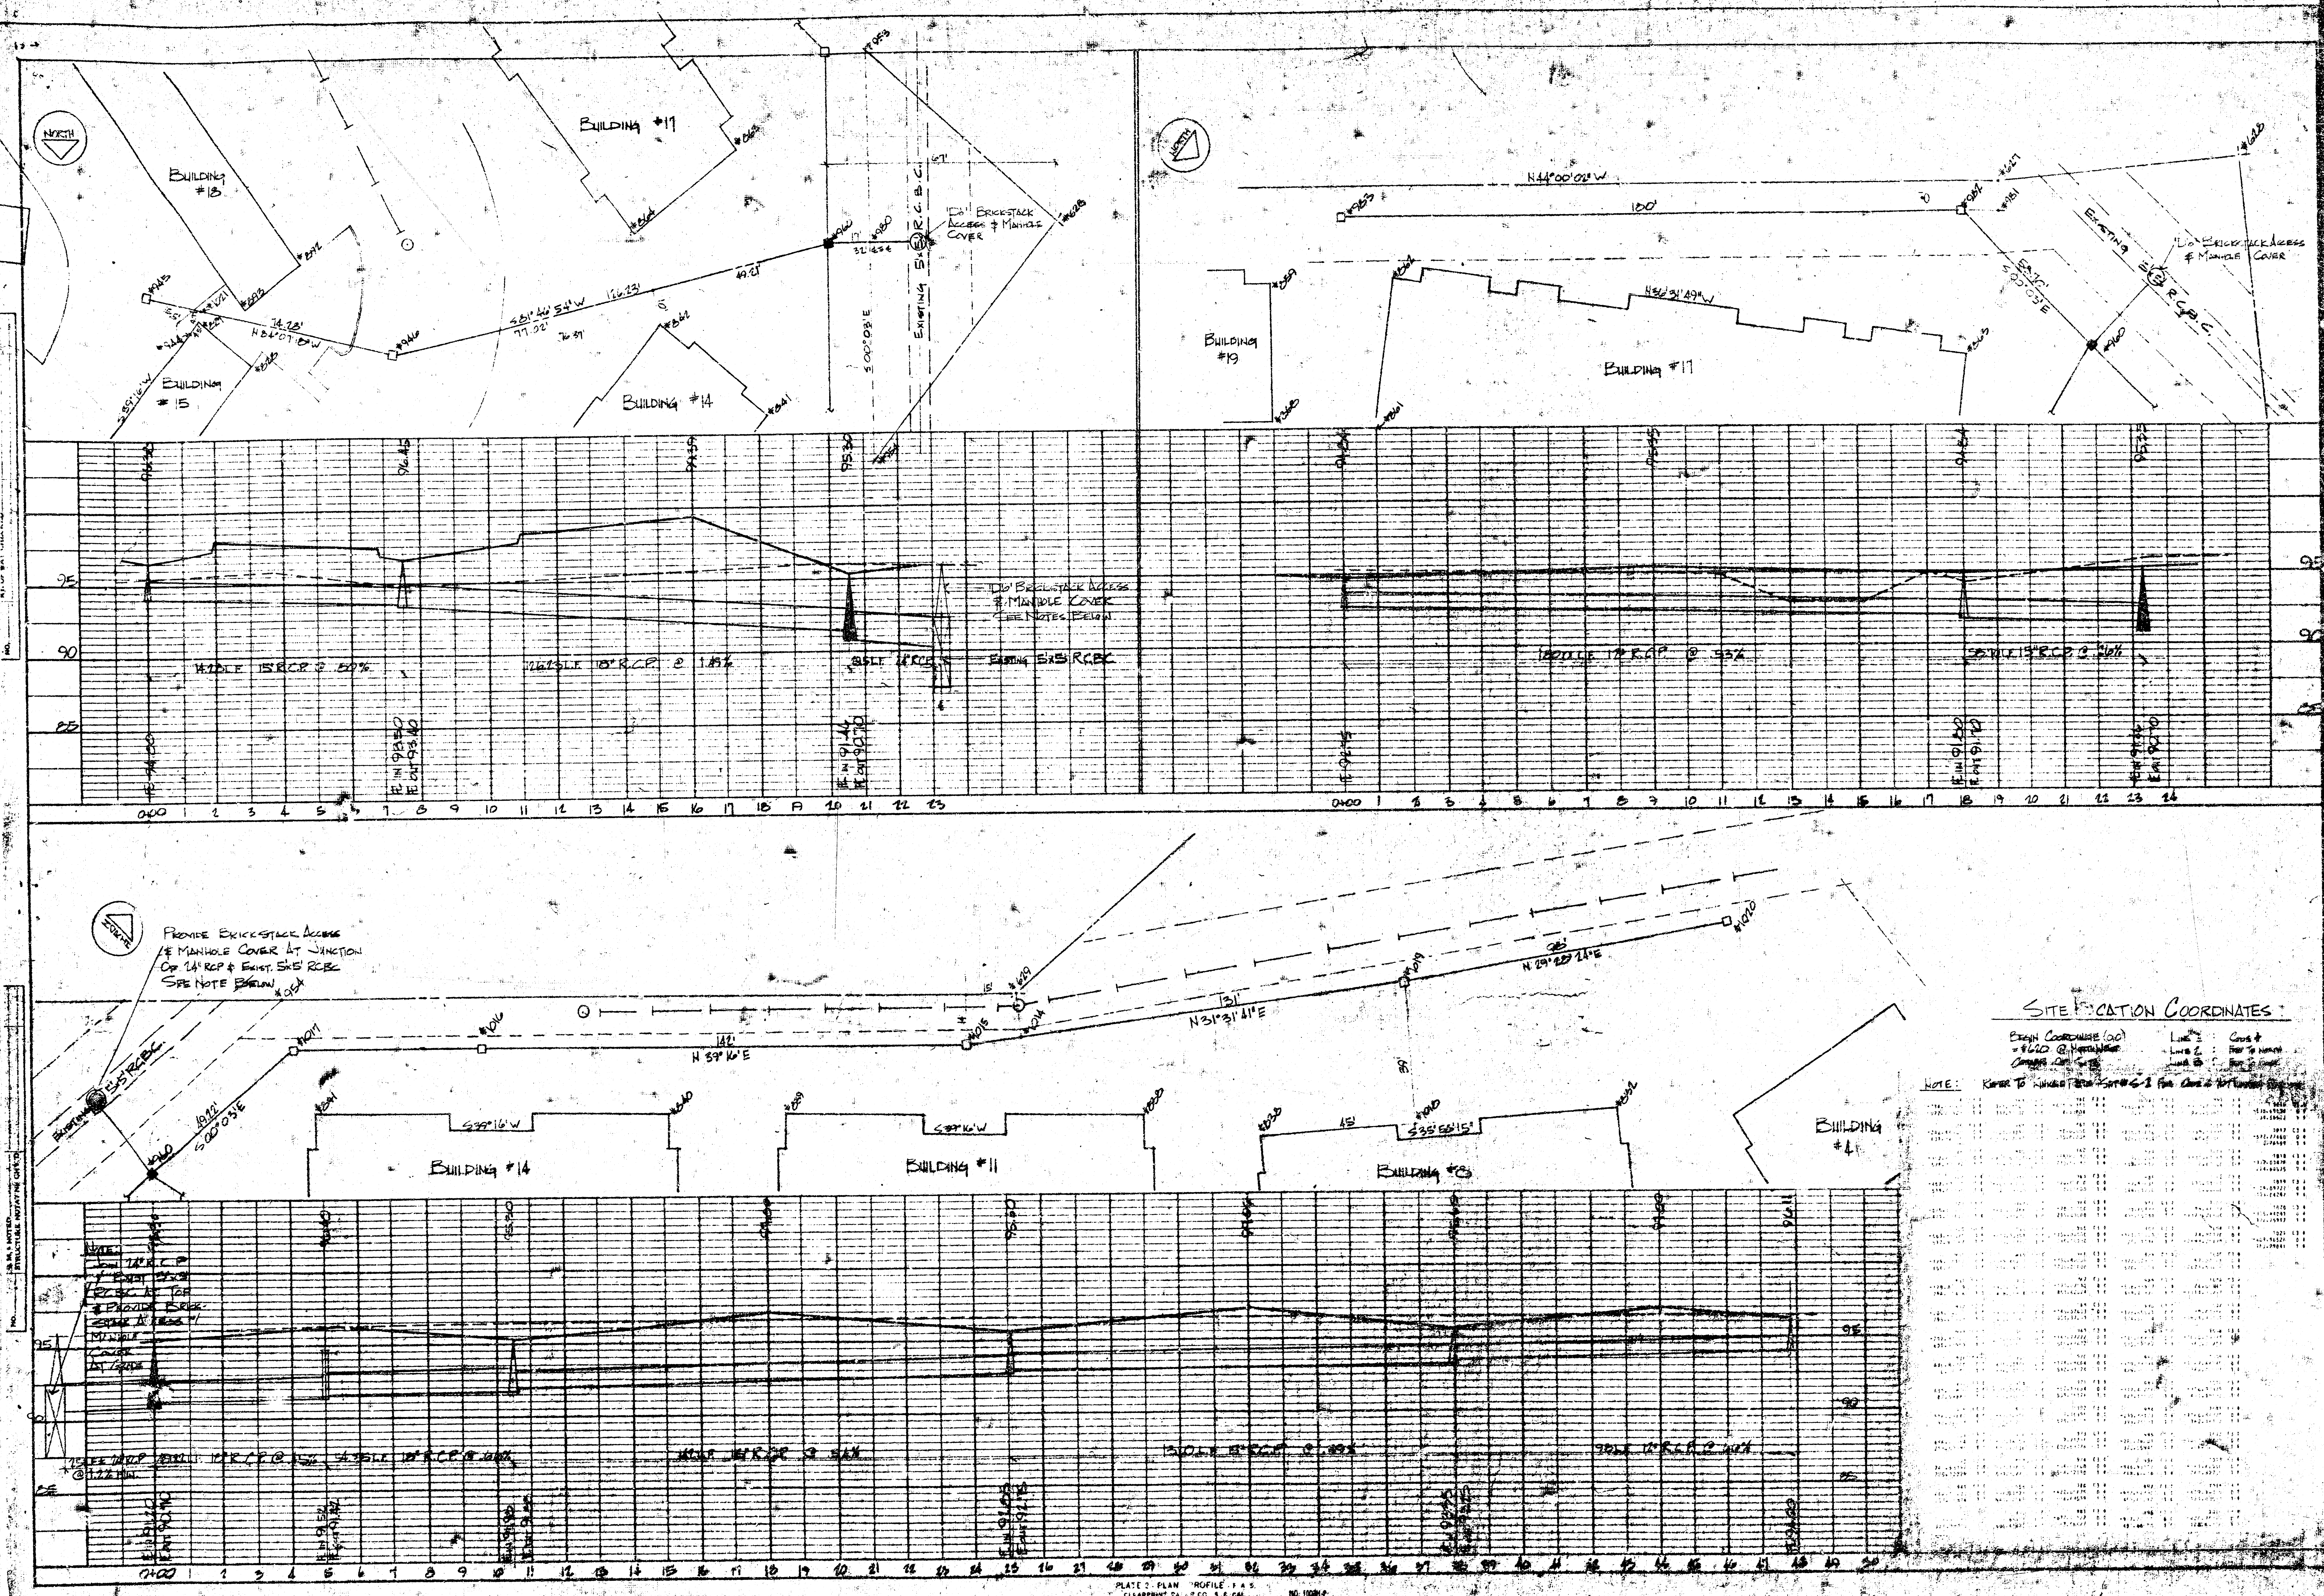

LAWRENCE E. WELLS
A R C H I T E C T

254 LAURA, SUITE 205
WICHITA, KANSAS 67211

KINKAID PARK APTS.
FOR KINKAID, INC., WICHITA, KANSAS

SECTION AND SOUTH TOPEKA
PLAN NO. C-352 PROJECT 545

SHEET 7 OF 2
3/3