


NOTE: All Work to be Done Shall Have Not Less Than 3" of Cover. For Details See Standard Detail Sheets No. 37 & 38.

ALTERNATE NOTES  
 No. 10 is not included in the Contract.  
 Provide a Capped Outlet With Valve At Point A if Building No. 10 is not included in the Contract.  
 Without

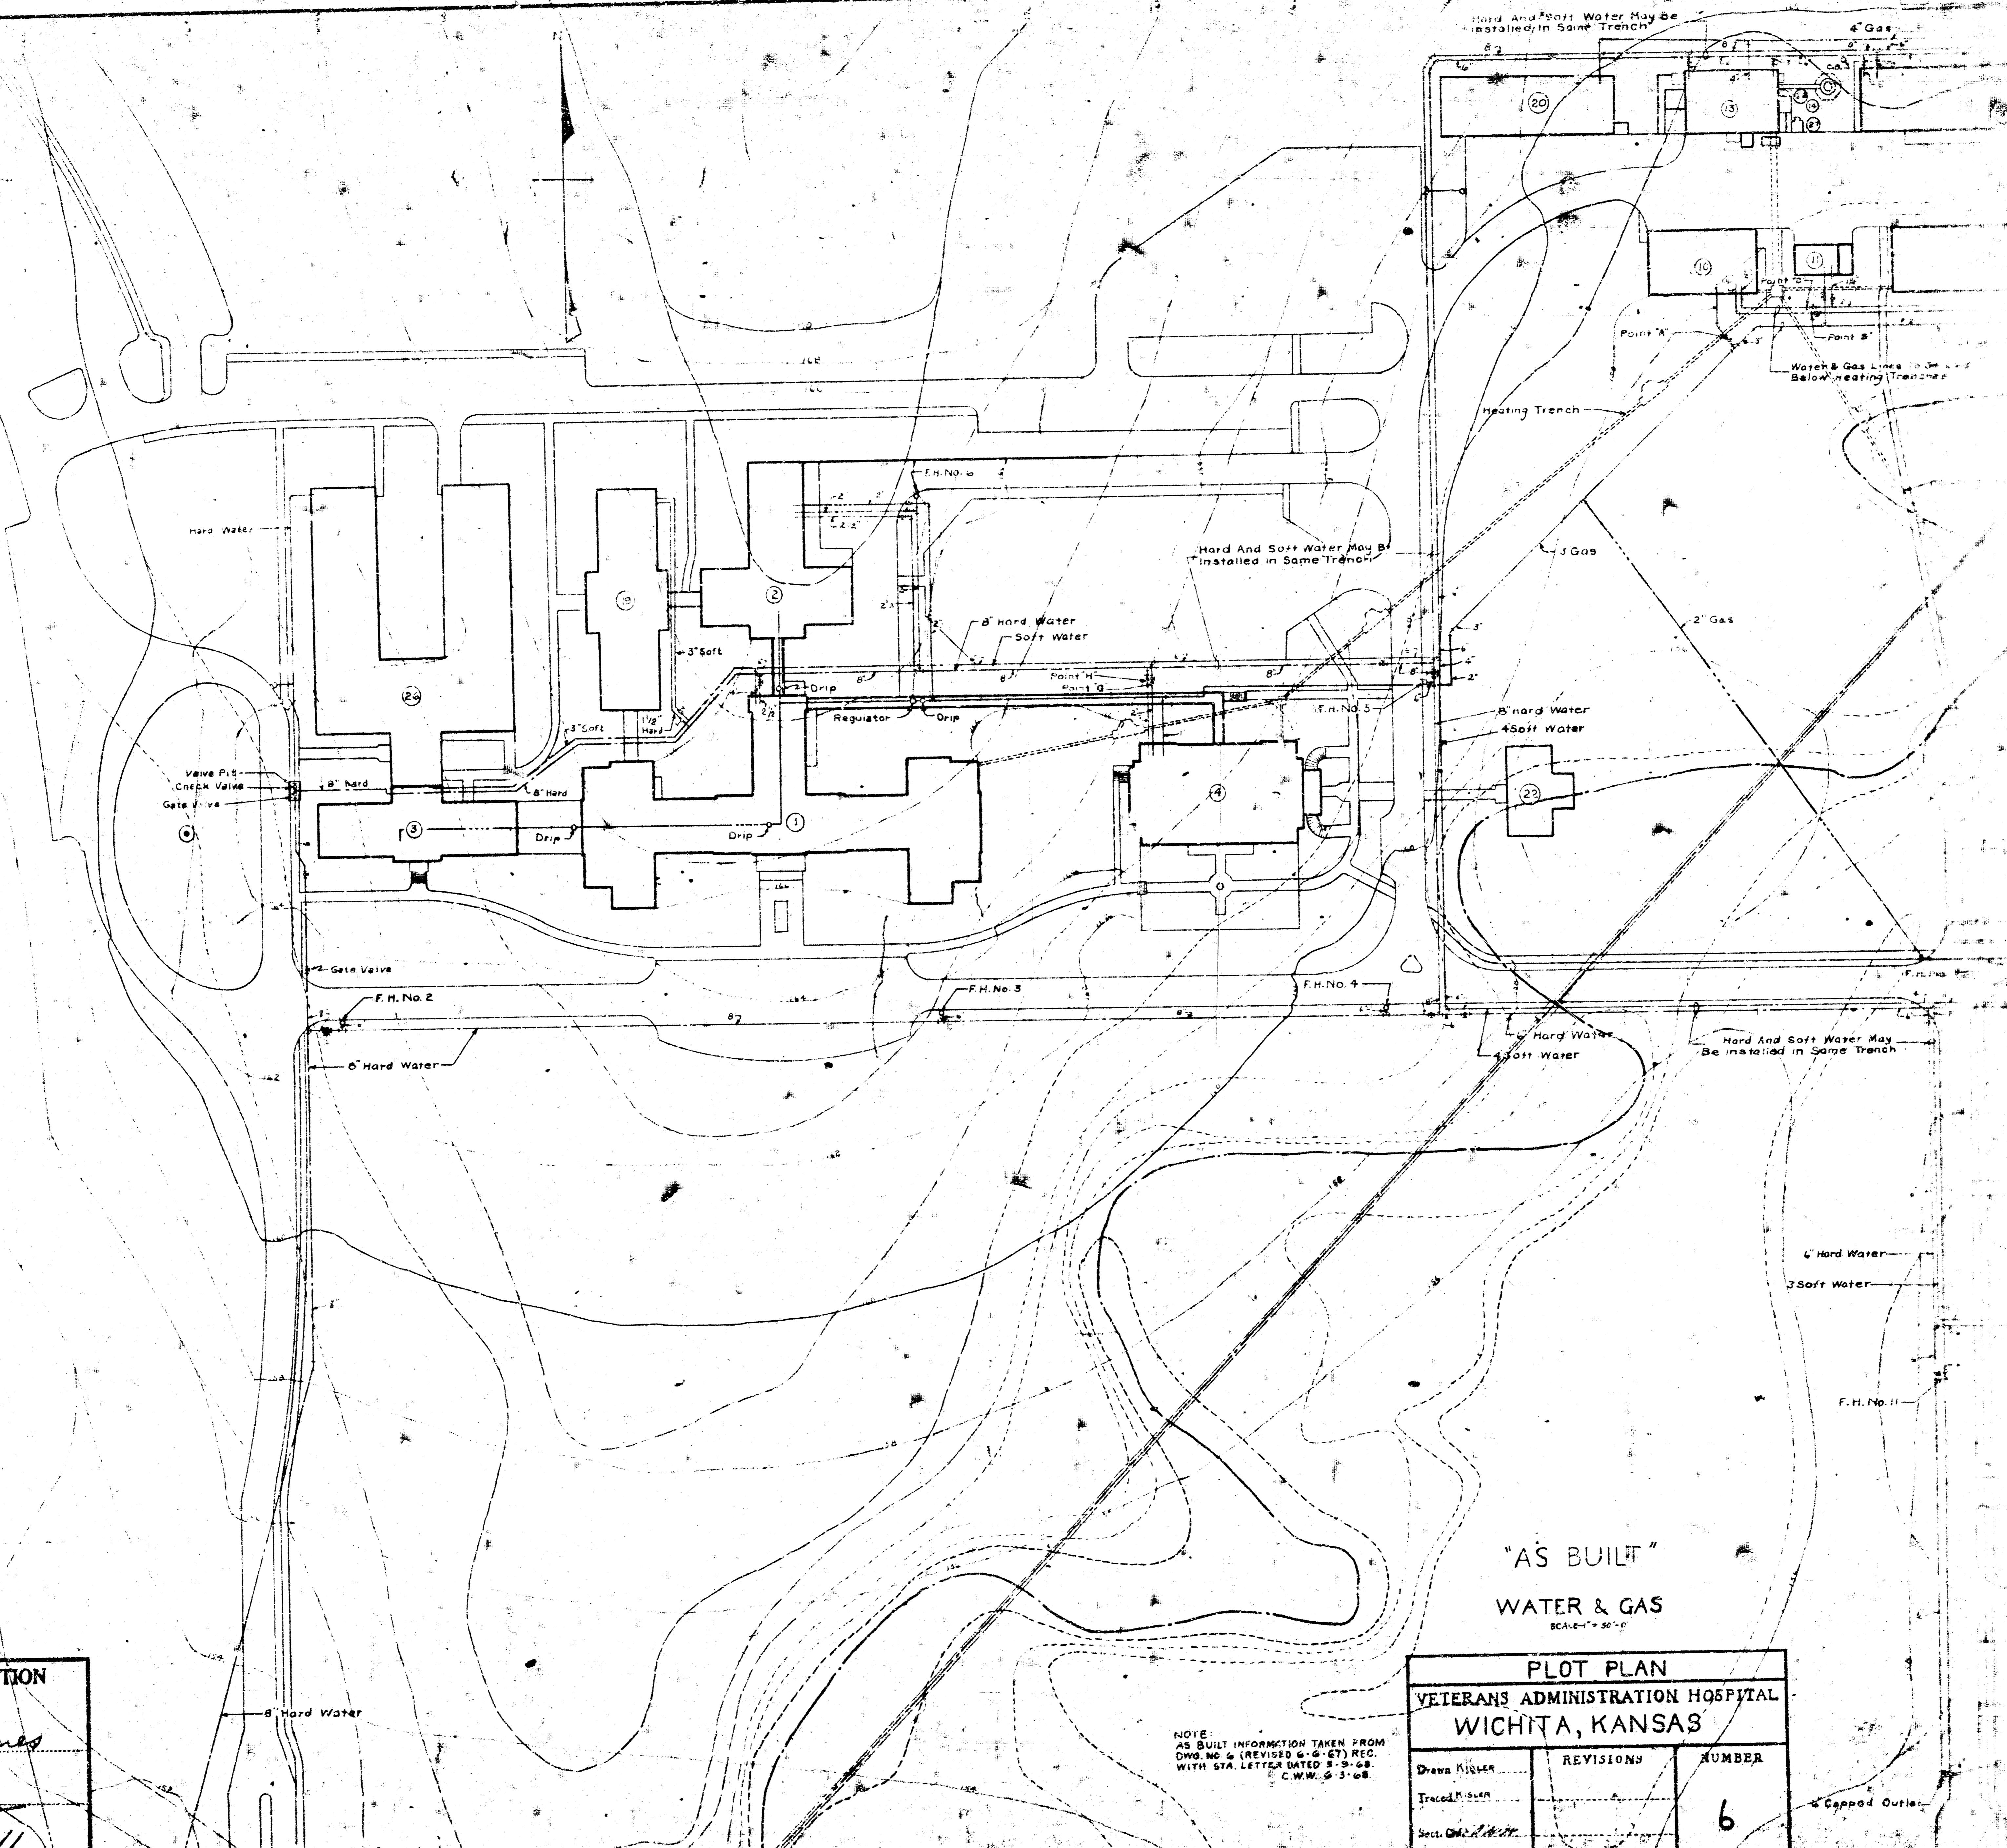

"AS BUILT"  
 WATER & GAS  
 SCALE: 1" = 30'-0"


VETERANS ADMINISTRATION  
 WASHINGTON, D. C.  
 APPROVED: *Frank J. Dines*  
 ADMINISTRATOR  
*George J. King*  
 ASSISTANT ADMINISTRATOR  
 DIRECTOR OF CONSTRUCTION

NOTE: AS BUILT INFORMATION TAKEN FROM DWG. NO. 6 (REVISED 6-6-67) REC. WITH STA. LETTER DATED 8-3-68. C.W.M. 6-3-68.

PLOT PLAN		
VETERANS ADMINISTRATION HOSPITAL WICHITA, KANSAS		
Drawn By	REVISIONS	NUMBER
Traced by: <i>SMH</i>		
Check: <i>SMH</i>		
Date: APR 2, 1952		6
		Sheet 4 of 15

Water and Meter PIP furnished and installed by Water Co.

ALTERNATE NOTE  
 Provide Proposed Inlet For 6" Pipe At Point A If Building No. 4 is Not Included In The Contract

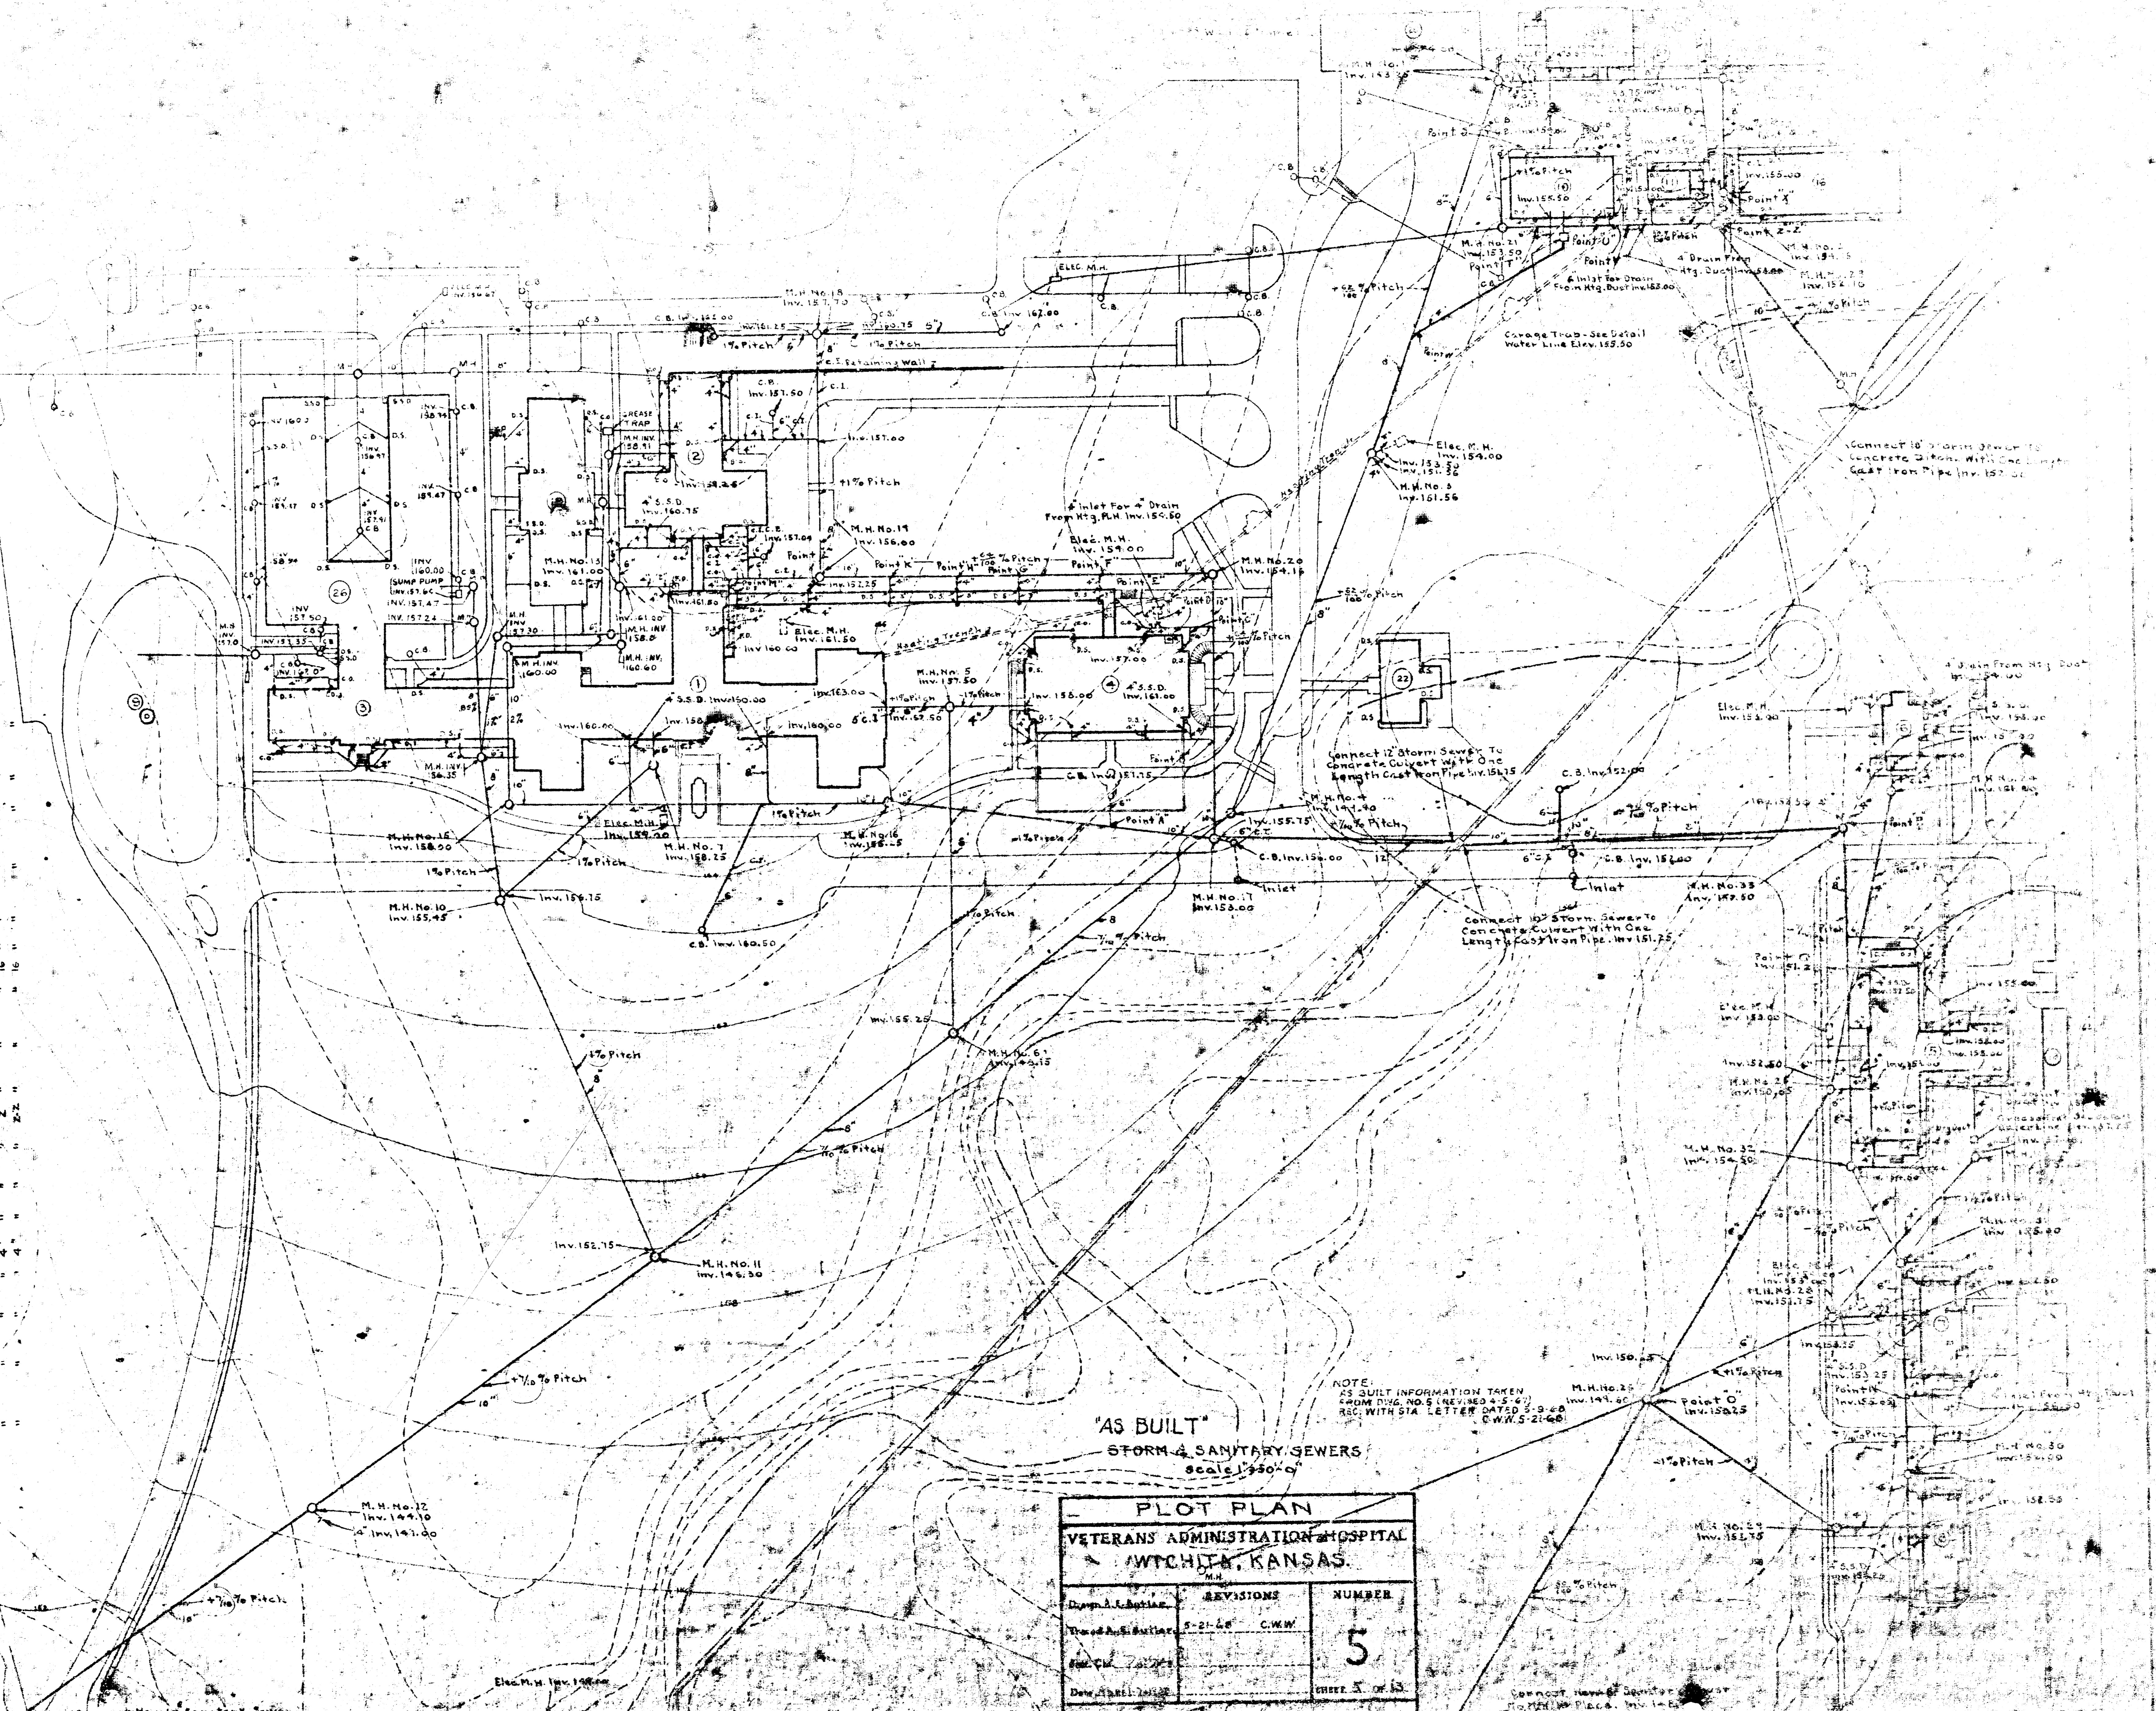

NOTE:  
 ALL S.W. INFORMATION TAKEN  
 FROM DWG. NO. 5 (REVISED 4-5-67)  
 REC. WITH STA. LETTER DATED 5-9-68  
 C.W.W. 5-21-68

'AS BUILT'  
 STORM & SANITARY SEWERS  
 Scale 1/320' = 1"

VETERANS ADMINISTRATION  
 WASHINGTON, D. C.

APPROVED *Frank J. Dines*  
 ADMINISTRATOR

*George E. Jones*  
 ASSISTANT ADMINISTRATOR

*[Signature]*  
 DIRECTOR OF CONSTRUCTION

*[Signature]*  
 CHIEF, TECHNICAL DIVISION

REVISIONS			NUMBER
DATE	BY	DESCRIPTION	
5-21-68	C.W.W.	REVISED	5
THREE OF 13			