
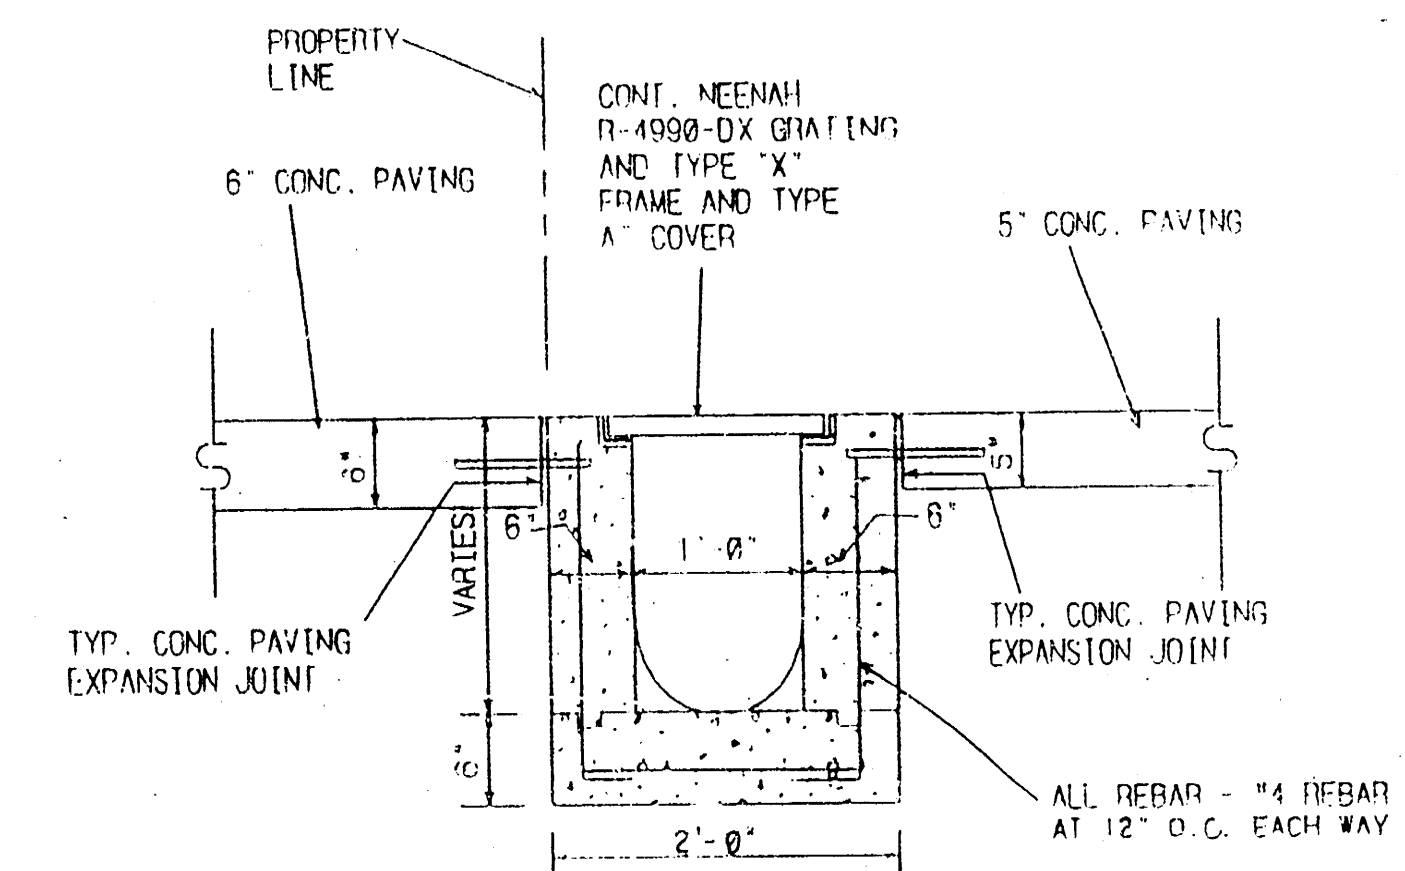


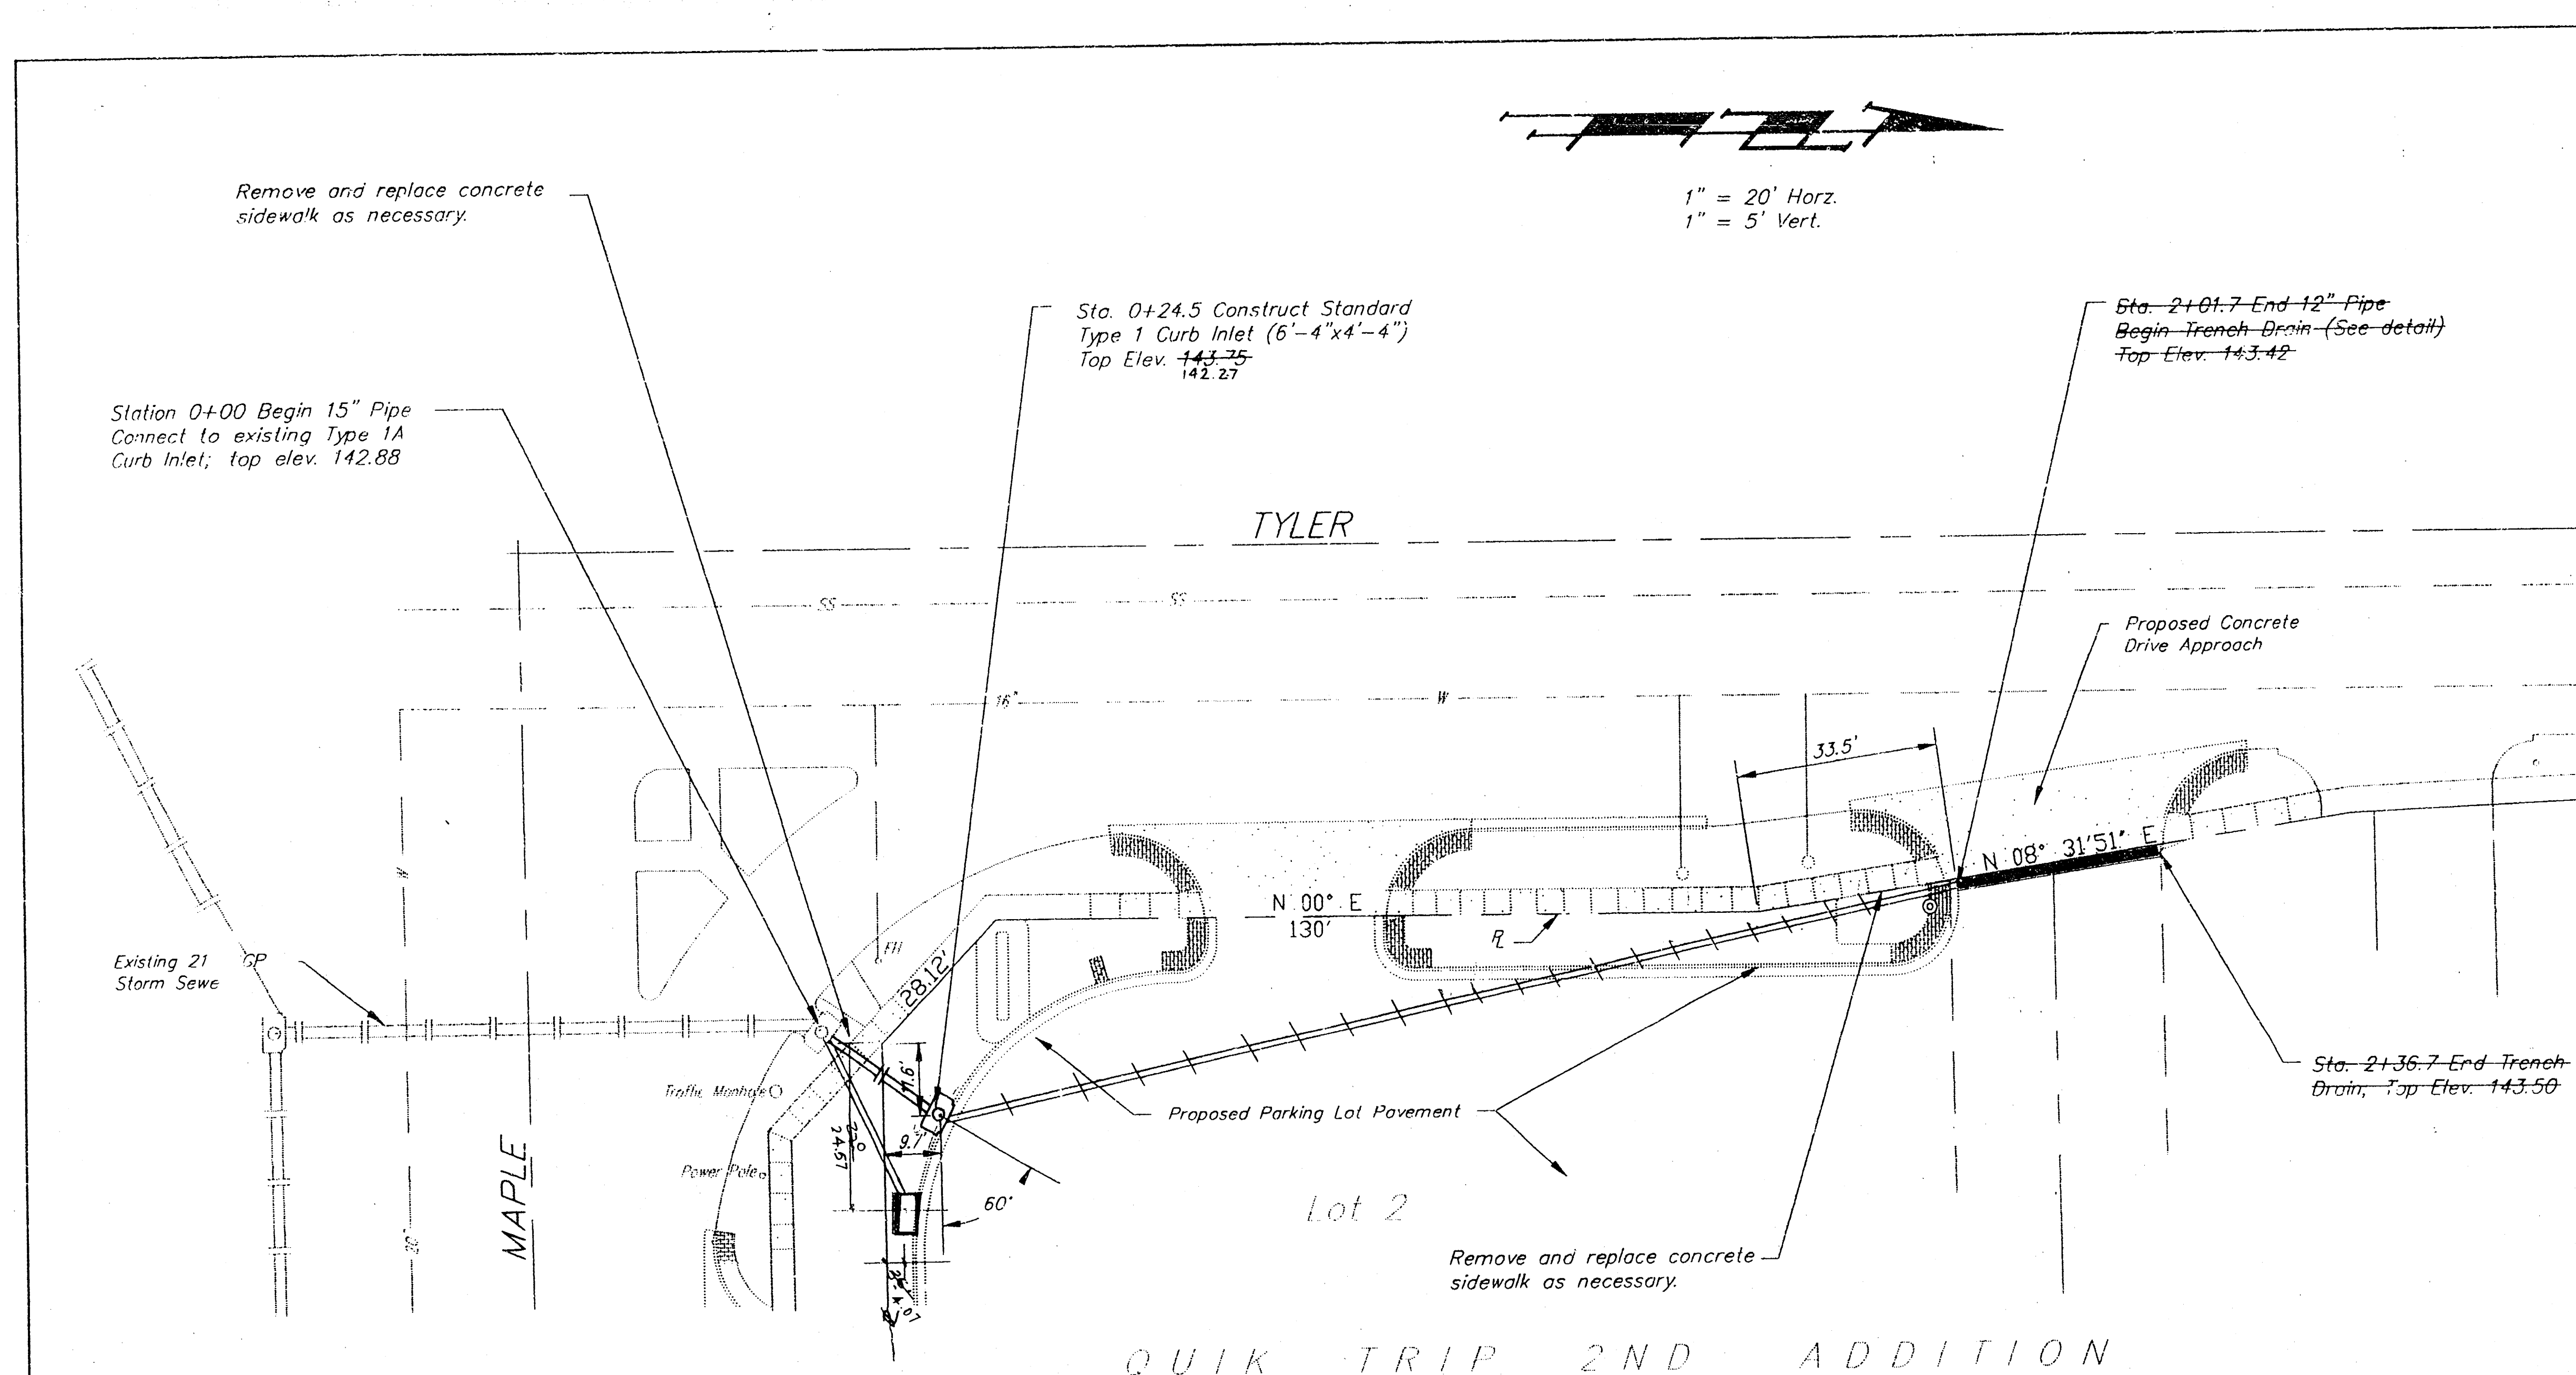

BENCH MARK:


City Standard Disc, located 50.7 feet north and 39.0 feet east of the center lines of Tyler Road and Maple Street, on concrete island at northeast corner of intersection; Elev. 144.12, City Datum

NOTE TO CONTRACTOR:

INSPECTION AND TEST FOR THIS PROJECT, FROM STATION 0+00 TO STATION 0+24.5, IS TO BE PROVIDED BY A LICENSED CONSULTING ENGINEERING FIRM UNDER CONTRACT WITH THE OWNER/DEVELOPER. SAID INSPECTION TO BE IN ACCORDANCE WITH THE CITY OF WICHITA STANDARD CONSTRUCTION ENGINEERING PRACTICES AND CERTIFIED BY A LICENSED PROFESSIONAL ENGINEER. NO WORK SHALL BE PERFORMED IN DEDICATED EASEMENTS OR PUBLIC RIGHT-OF-WAY BY THE CONTRACTOR WITHOUT SUCH INSPECTION, NOR SHALL ANY WORK BE COMMENCED WITHOUT WRITTEN AUTHORIZATION BY THE CITY ENGINEER.

APPROVED AS NOTED
By CITY ENGINEER OF WICHITA

Sanitary Sewers _____
Storm Sewers VRH 9/13/90
Driveway Approaches _____
Water Mains _____
Paving _____

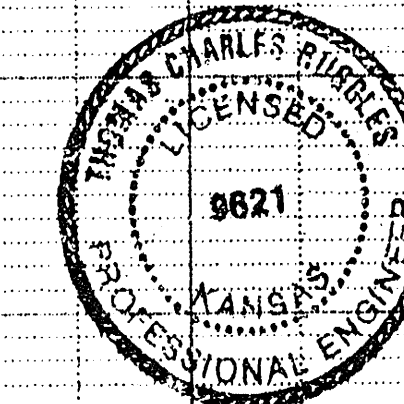

As Built 6-8-93 A.Z.

QUIK TRIP 2ND ADDITION
PRIVATE STORM SEWER
QUIK TRIP 343R

BAUGHMAN COMPANY P.A. SURVEYING & ENGINEERING 316/262-7271 • 315 ELLIS • WICHITA, KANSAS 67211		REV	1
PROJECT NUMBER 266 PPS 607861		SHEET	1
DESIGN TCR	DRAWN TCR	APPROVED DATE 9-11-90	SCALE 1" = 20'

