


APPROVED AS NOTED
By CITY ENGINEER OF ICHITA

Storm Sewers

Storm Sewers *Yes* 4/28/77

Driveway Approaches

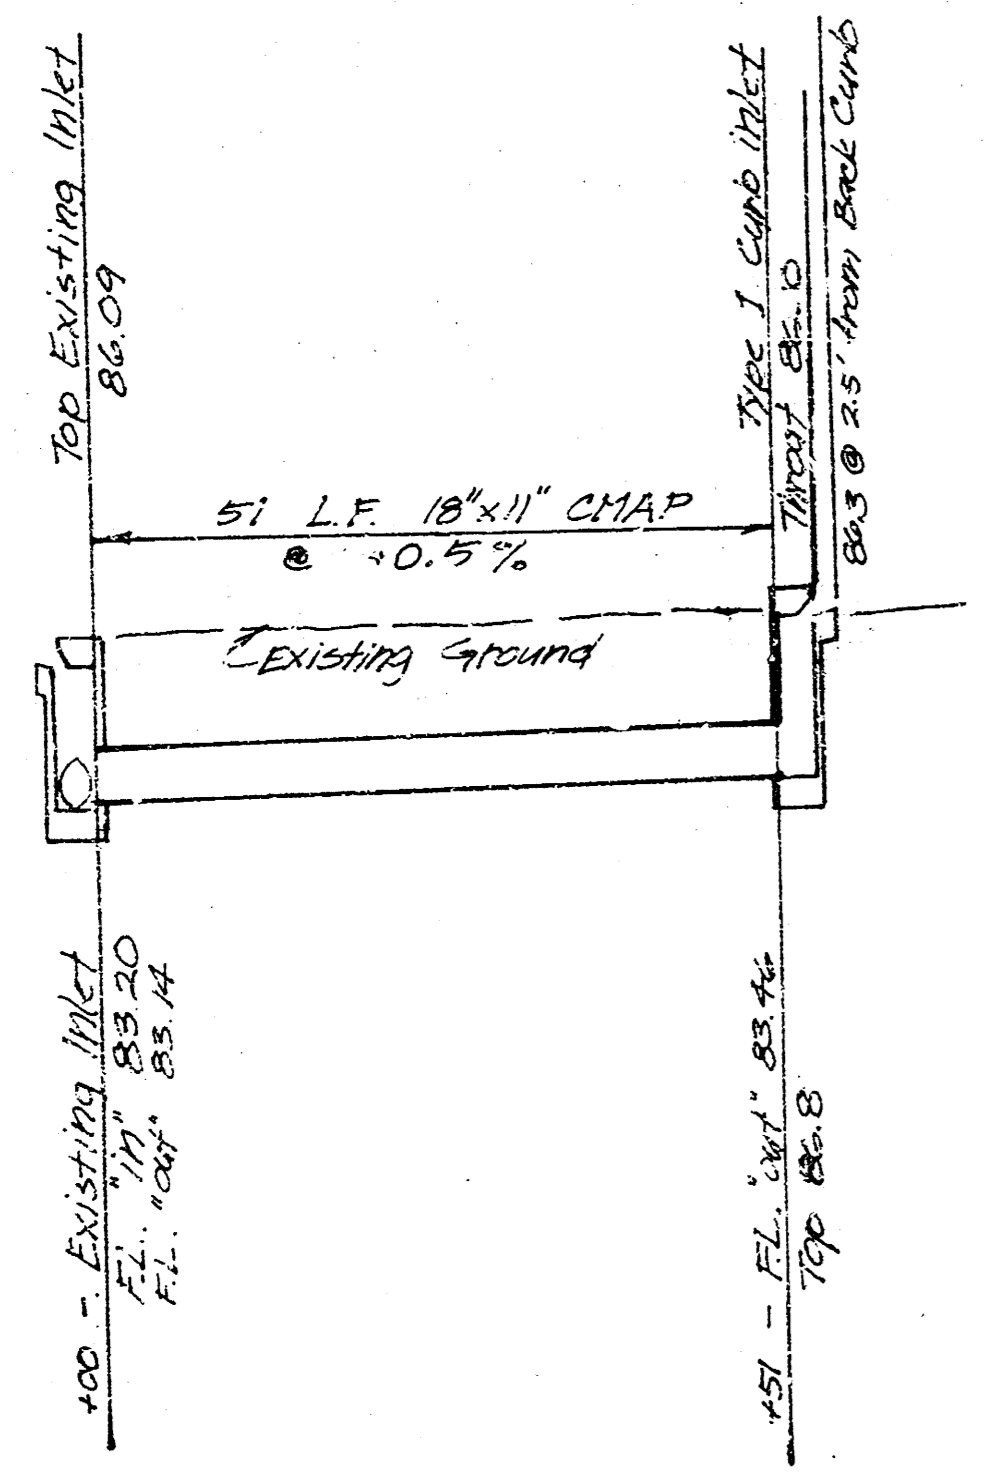

See attached plan for Type I Inlet

Storm Sewer
McDonald's Lease in Nolan's
Gardens, Sedgewick County, Kansas.

K.O. Taylor, P.E.
May 27, 1977
Revised June 21, 1977

