


PROFILE SCALE - HORIZ. 1"=10'  
VERT. 1"=4'

2' BENCH MARK, 121.42 ±  
2' IN GLOBE 1" SOUTH OF SOUTH END RADIUS, 146.00 ±

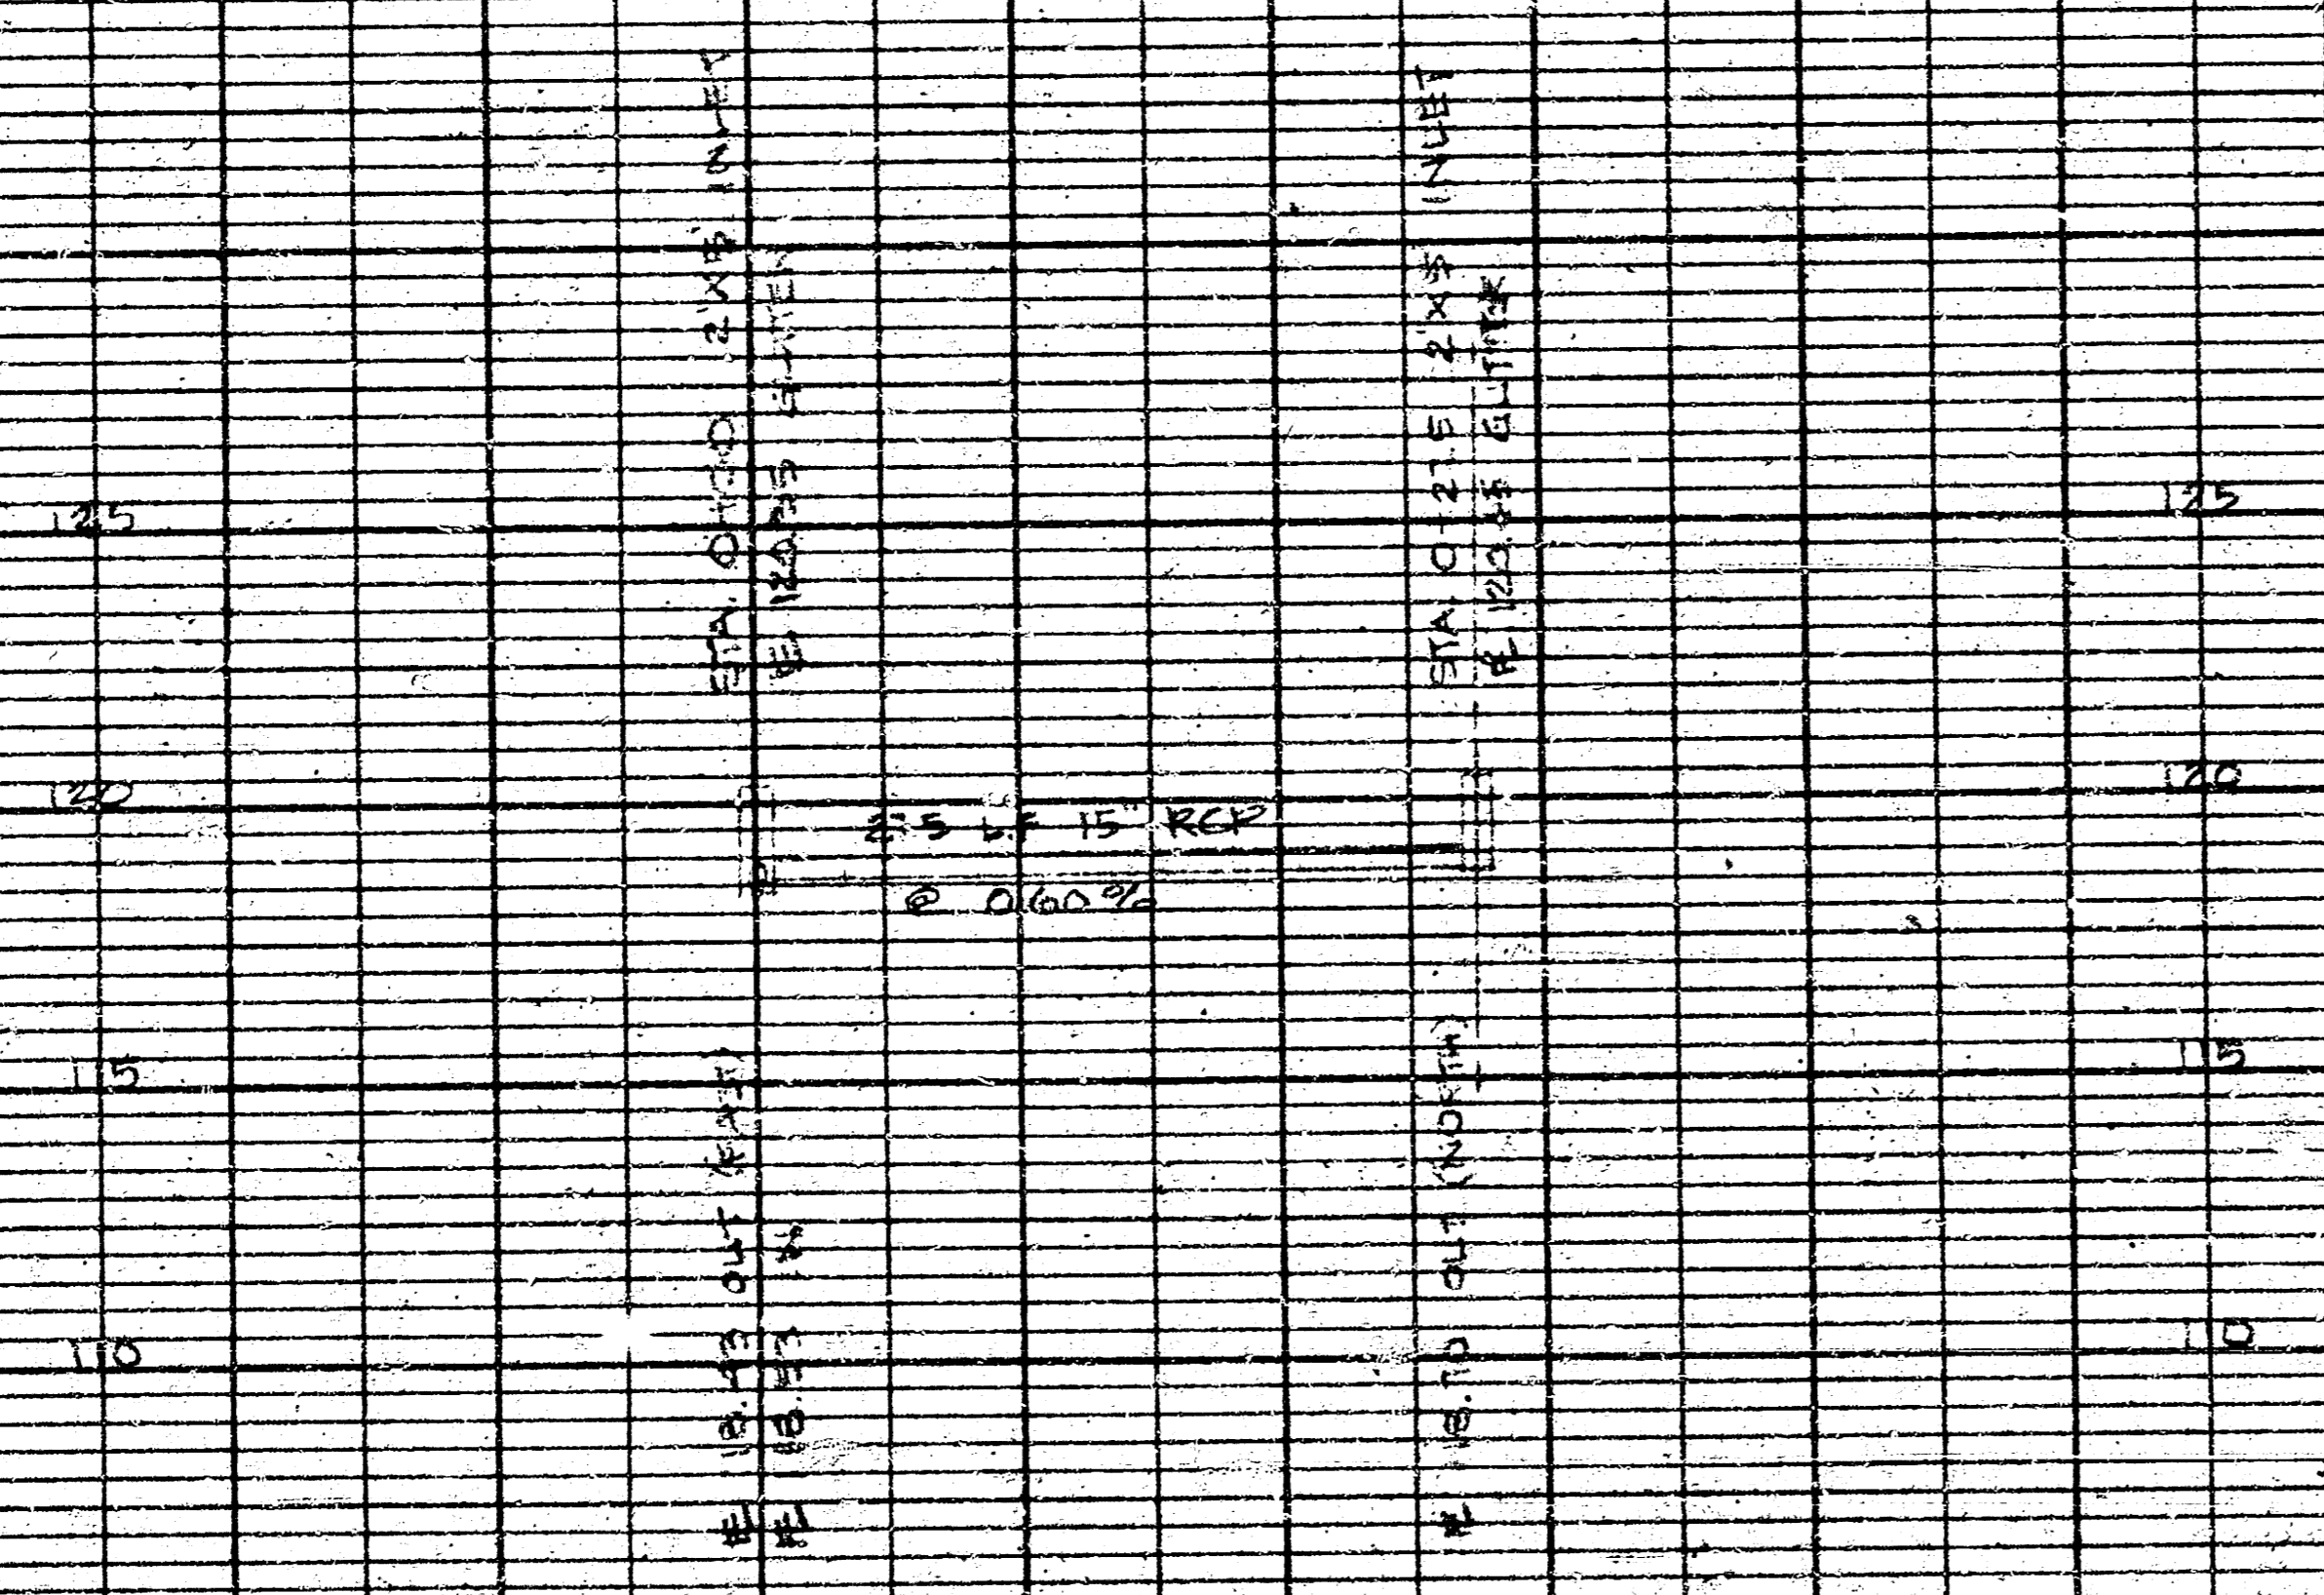

UTILITY CONTRACTORS  
AS BUILT STORM SEWER PLAN  
SIT N WEST ST  
DATE: 11/11/21