

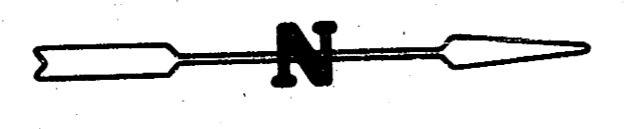
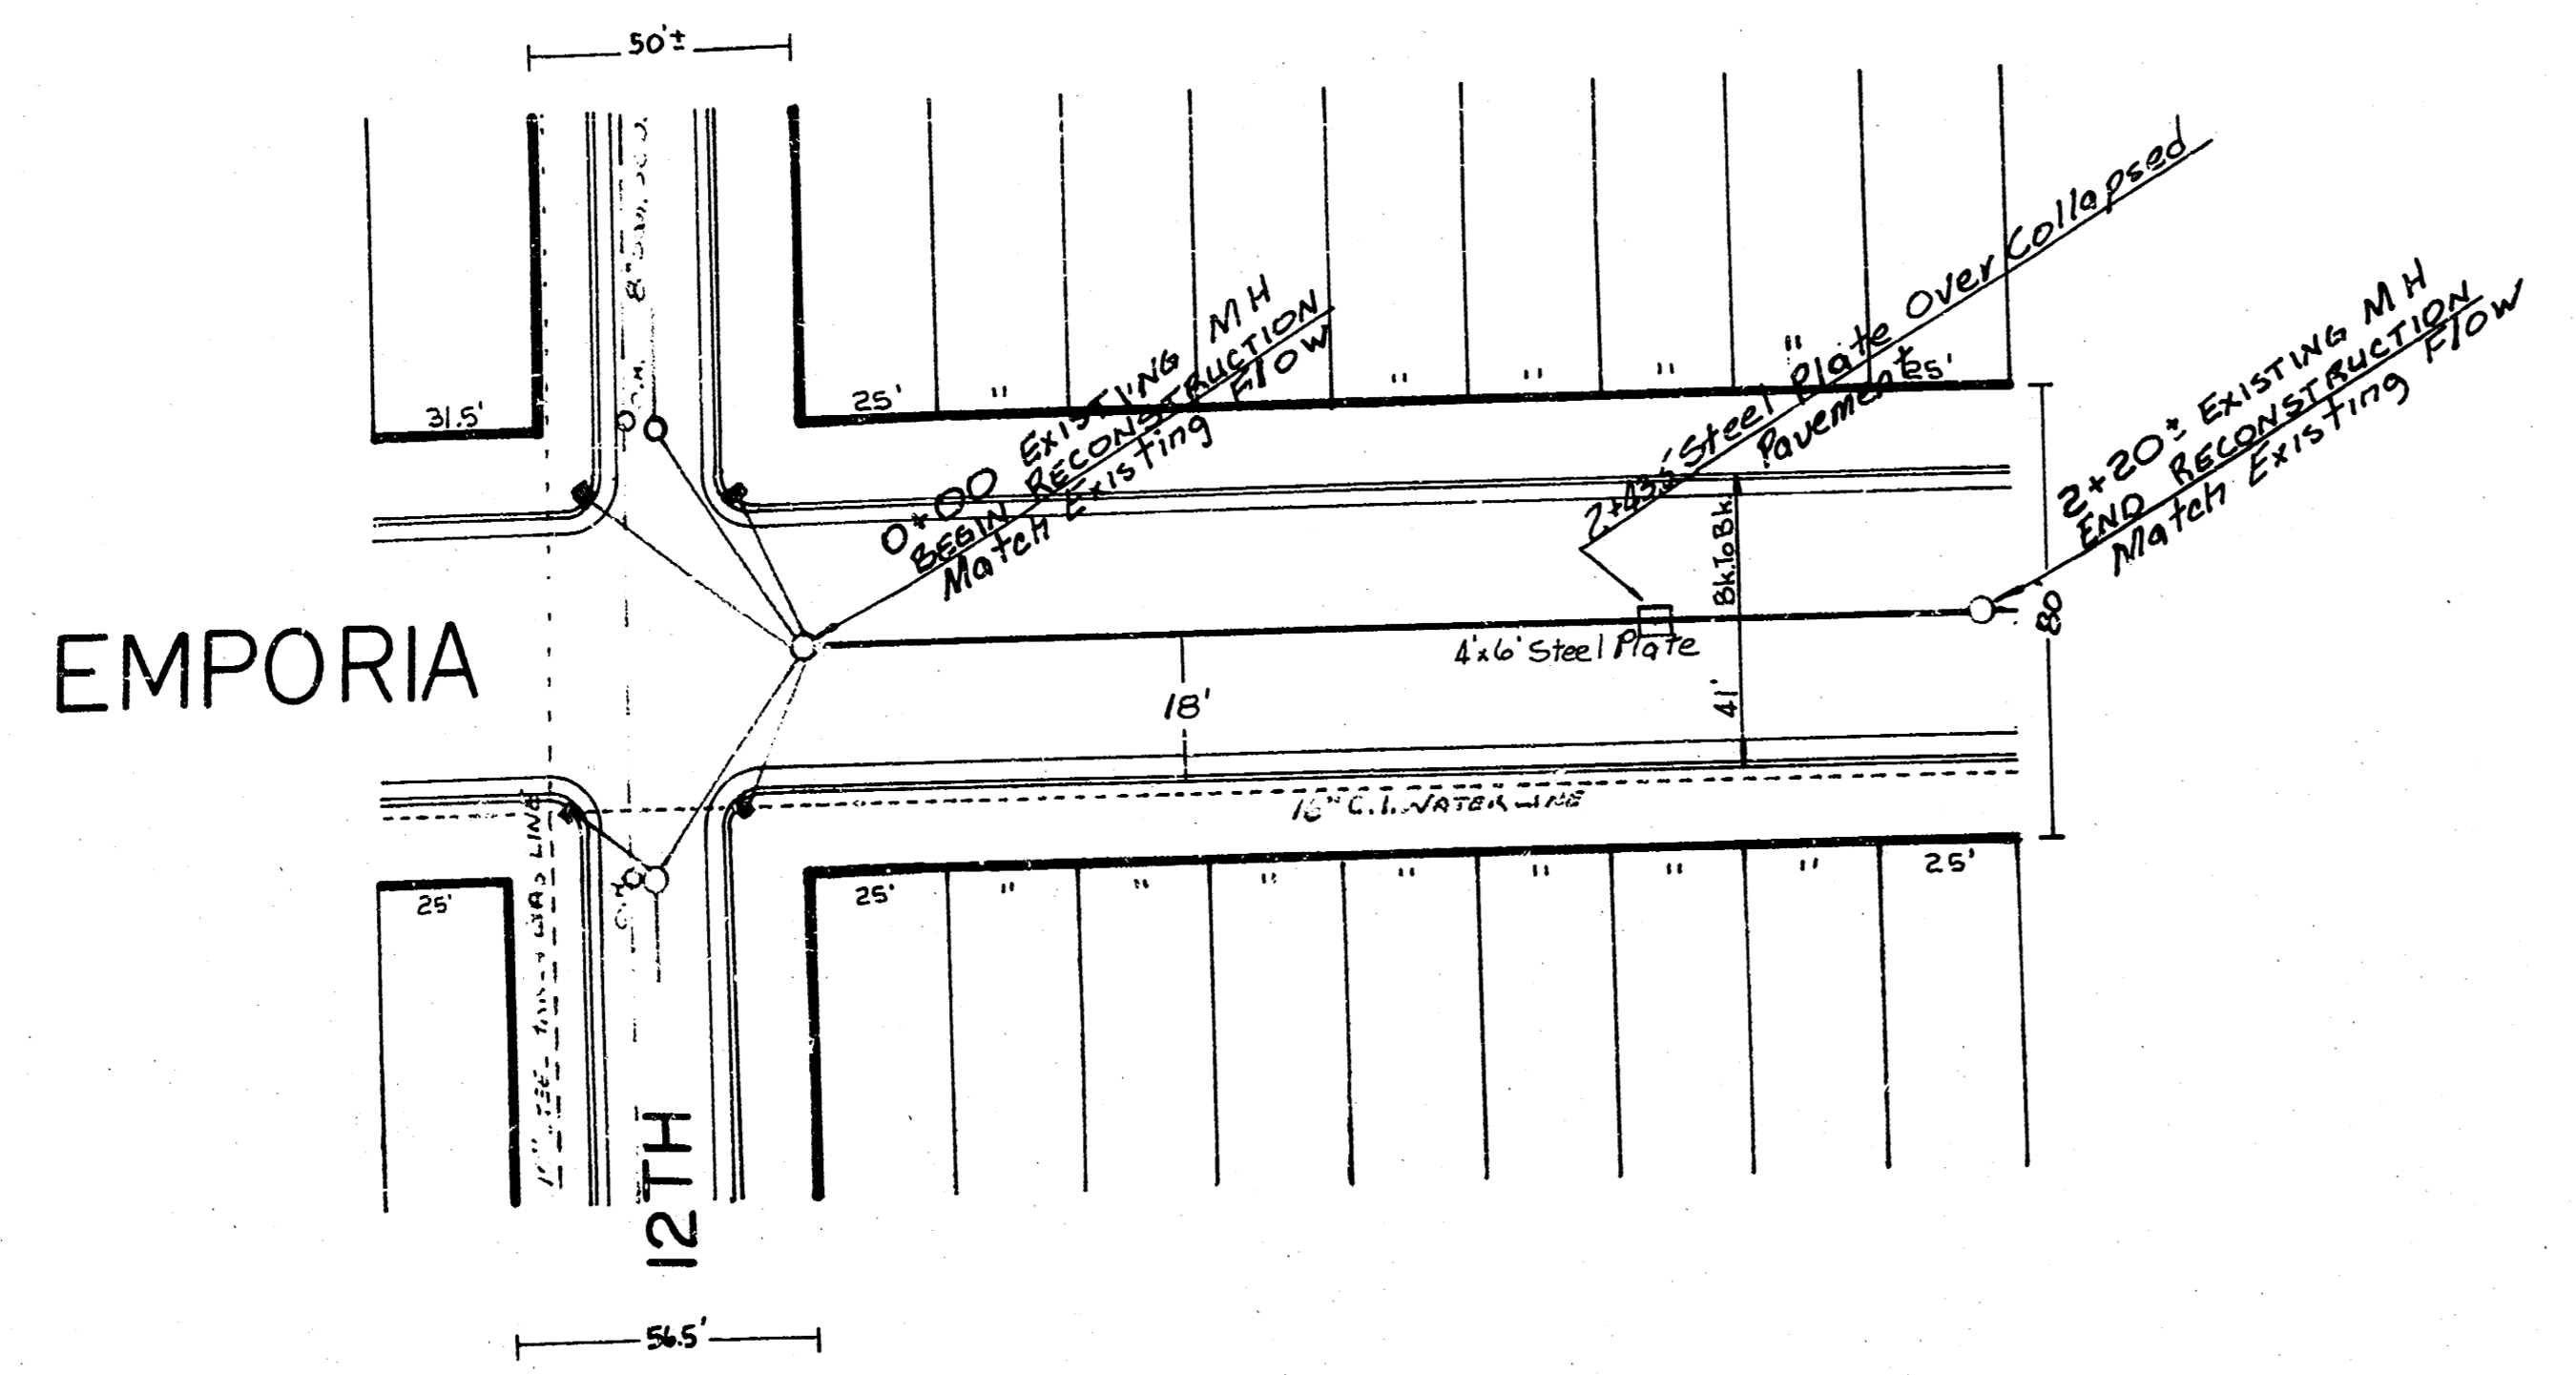


B.M. 114.23' Broadway @ 9th, Brass Rod In Concrete Post 20' West,
And 22' South Of Centerline Of Both.

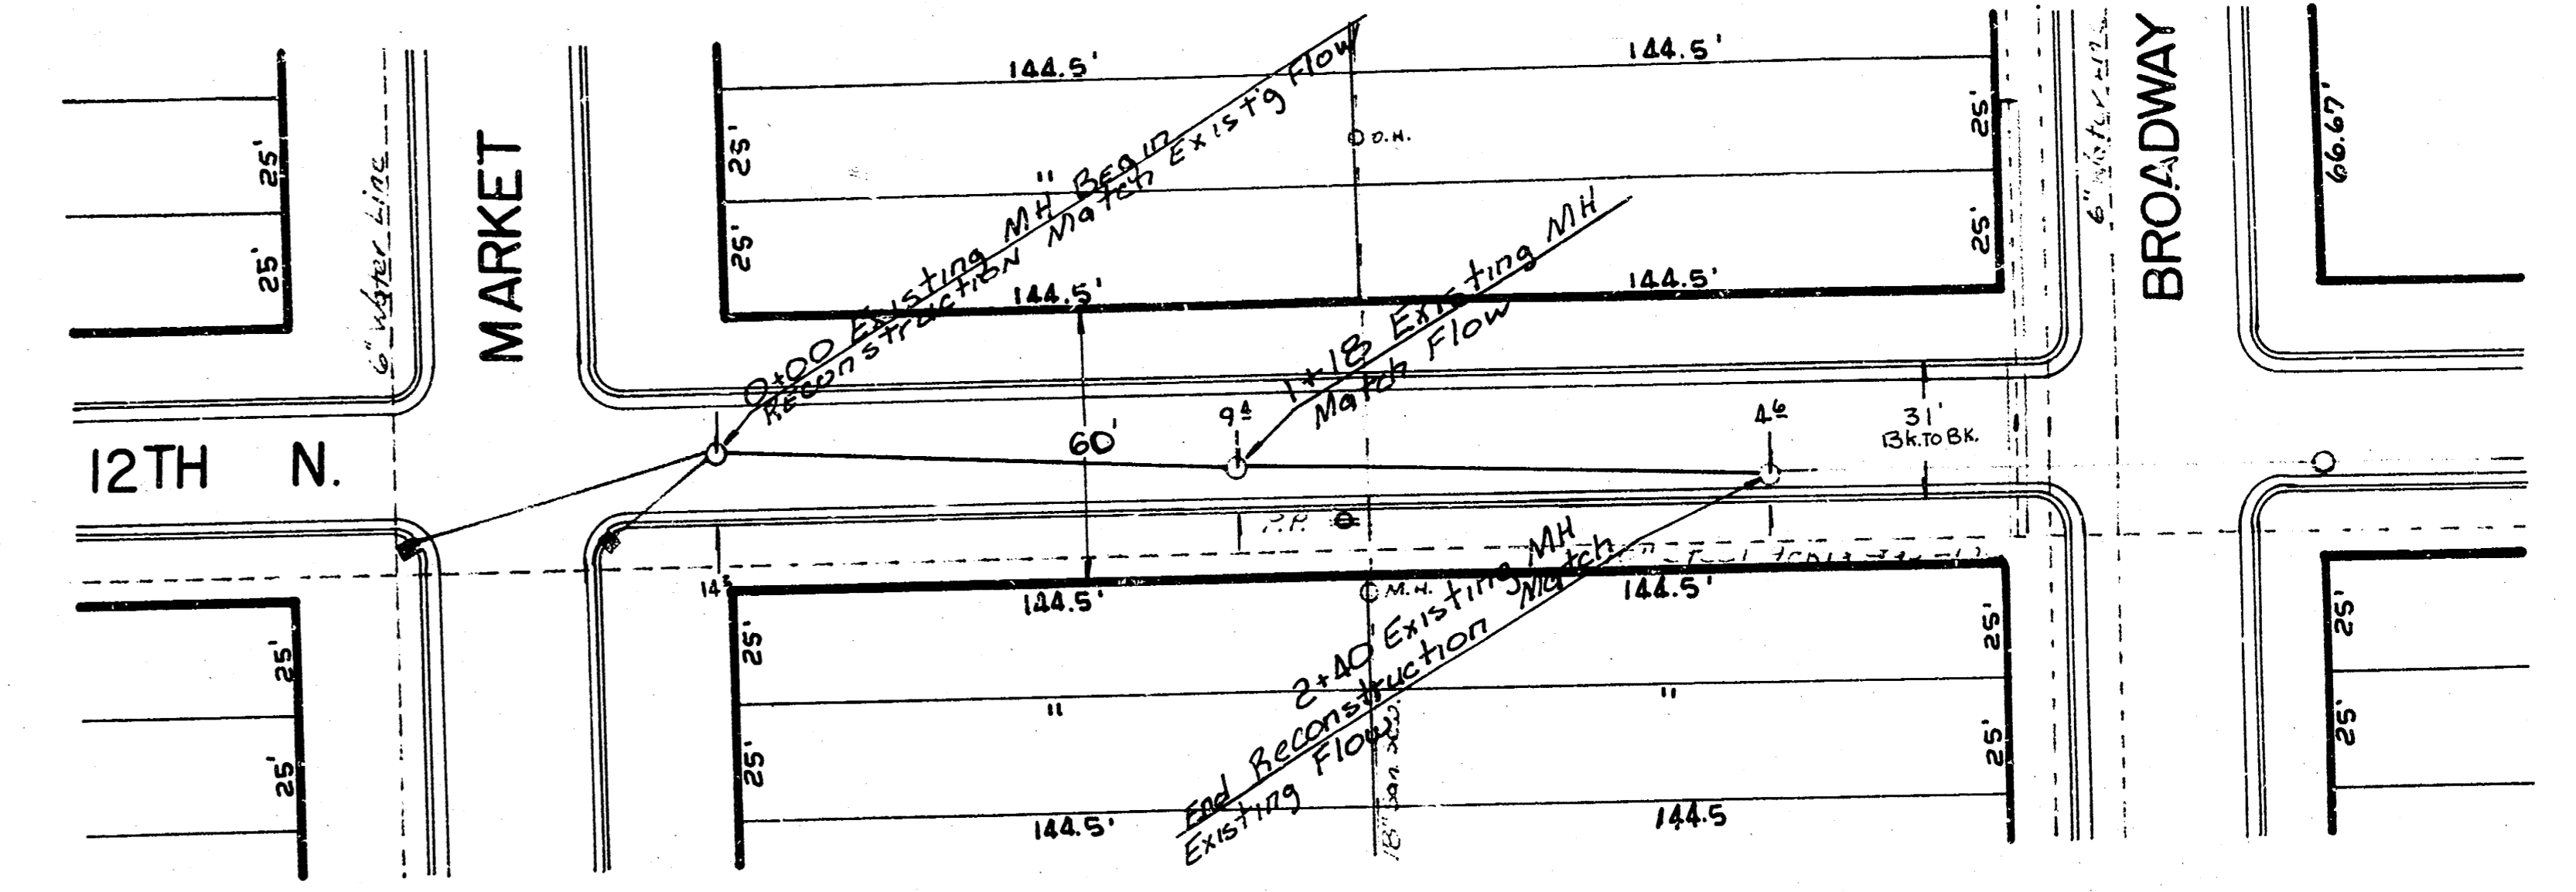


SCALE: PLAN 1" = 40'
PROFILE 1" = 40' HORIZ.
1" = 5' VERT.

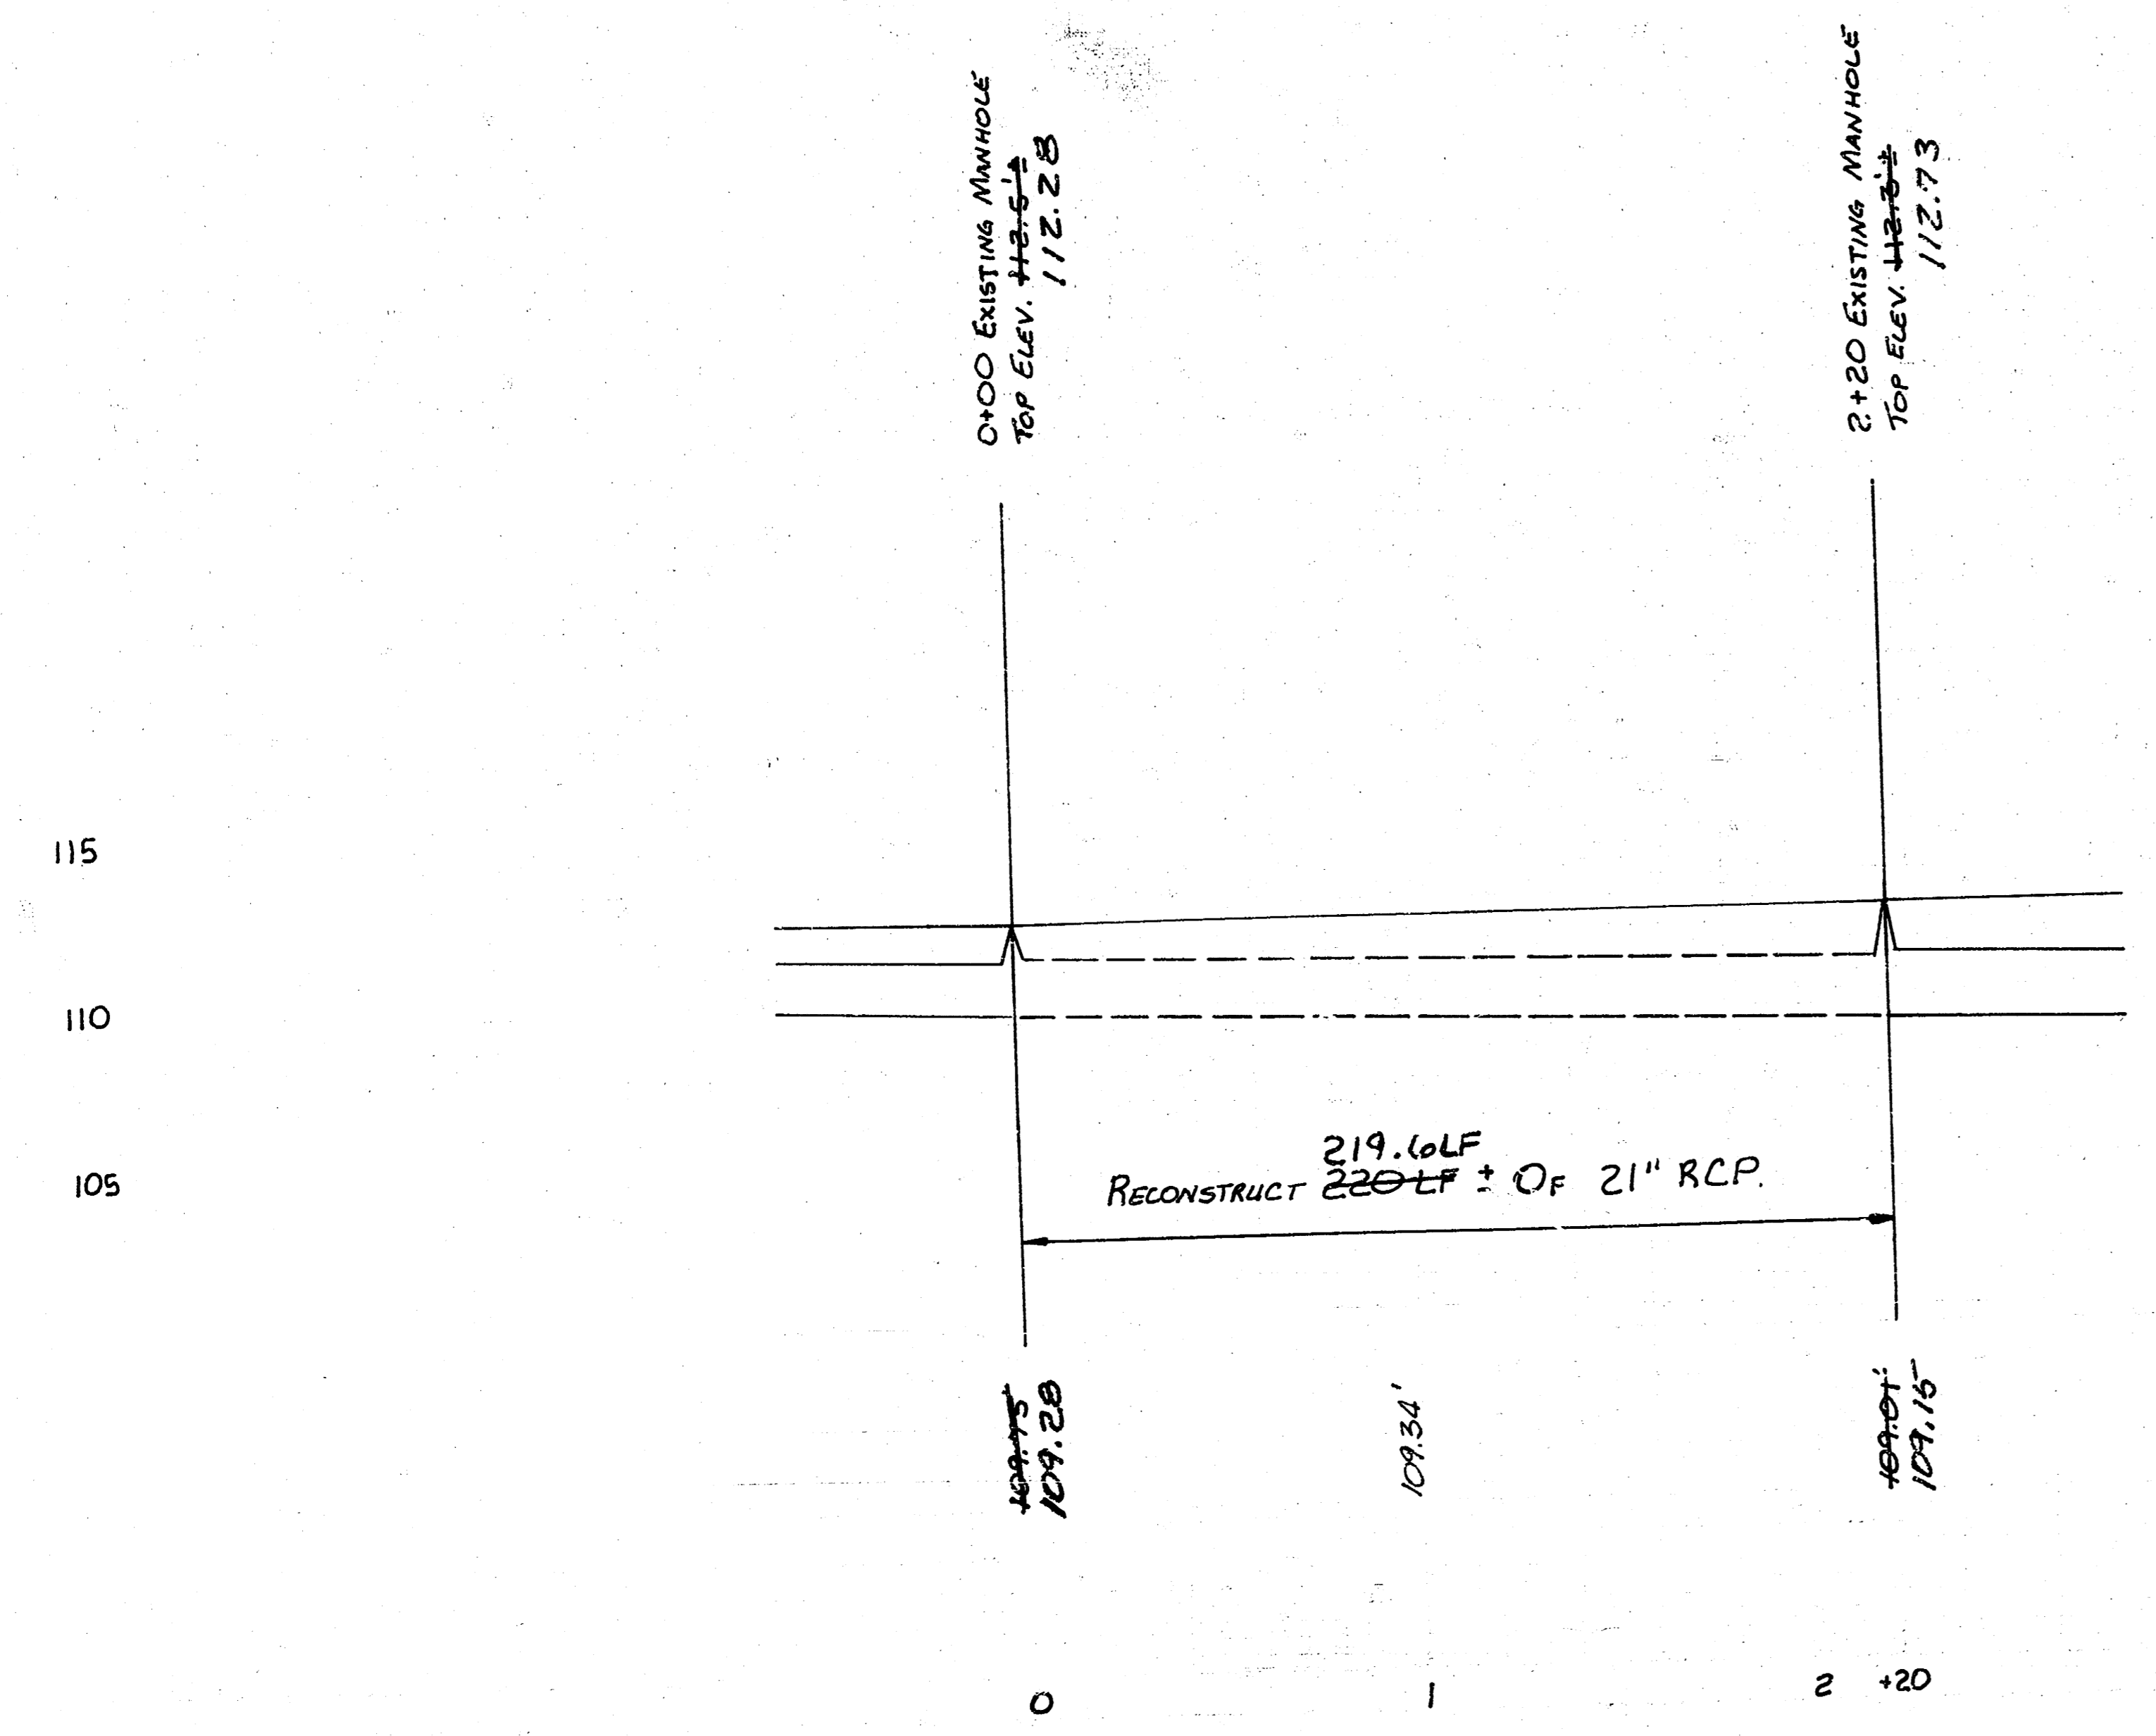


Scale: Plan 1" = 40'
Profile 1" = 40' Horiz.
1" = 5' Vert.

B.M. 114.23' Broadway @ 9th, Brass Rod In Concrete
Post 20' West, And 22' South Of Centerline Of Both.

115
110

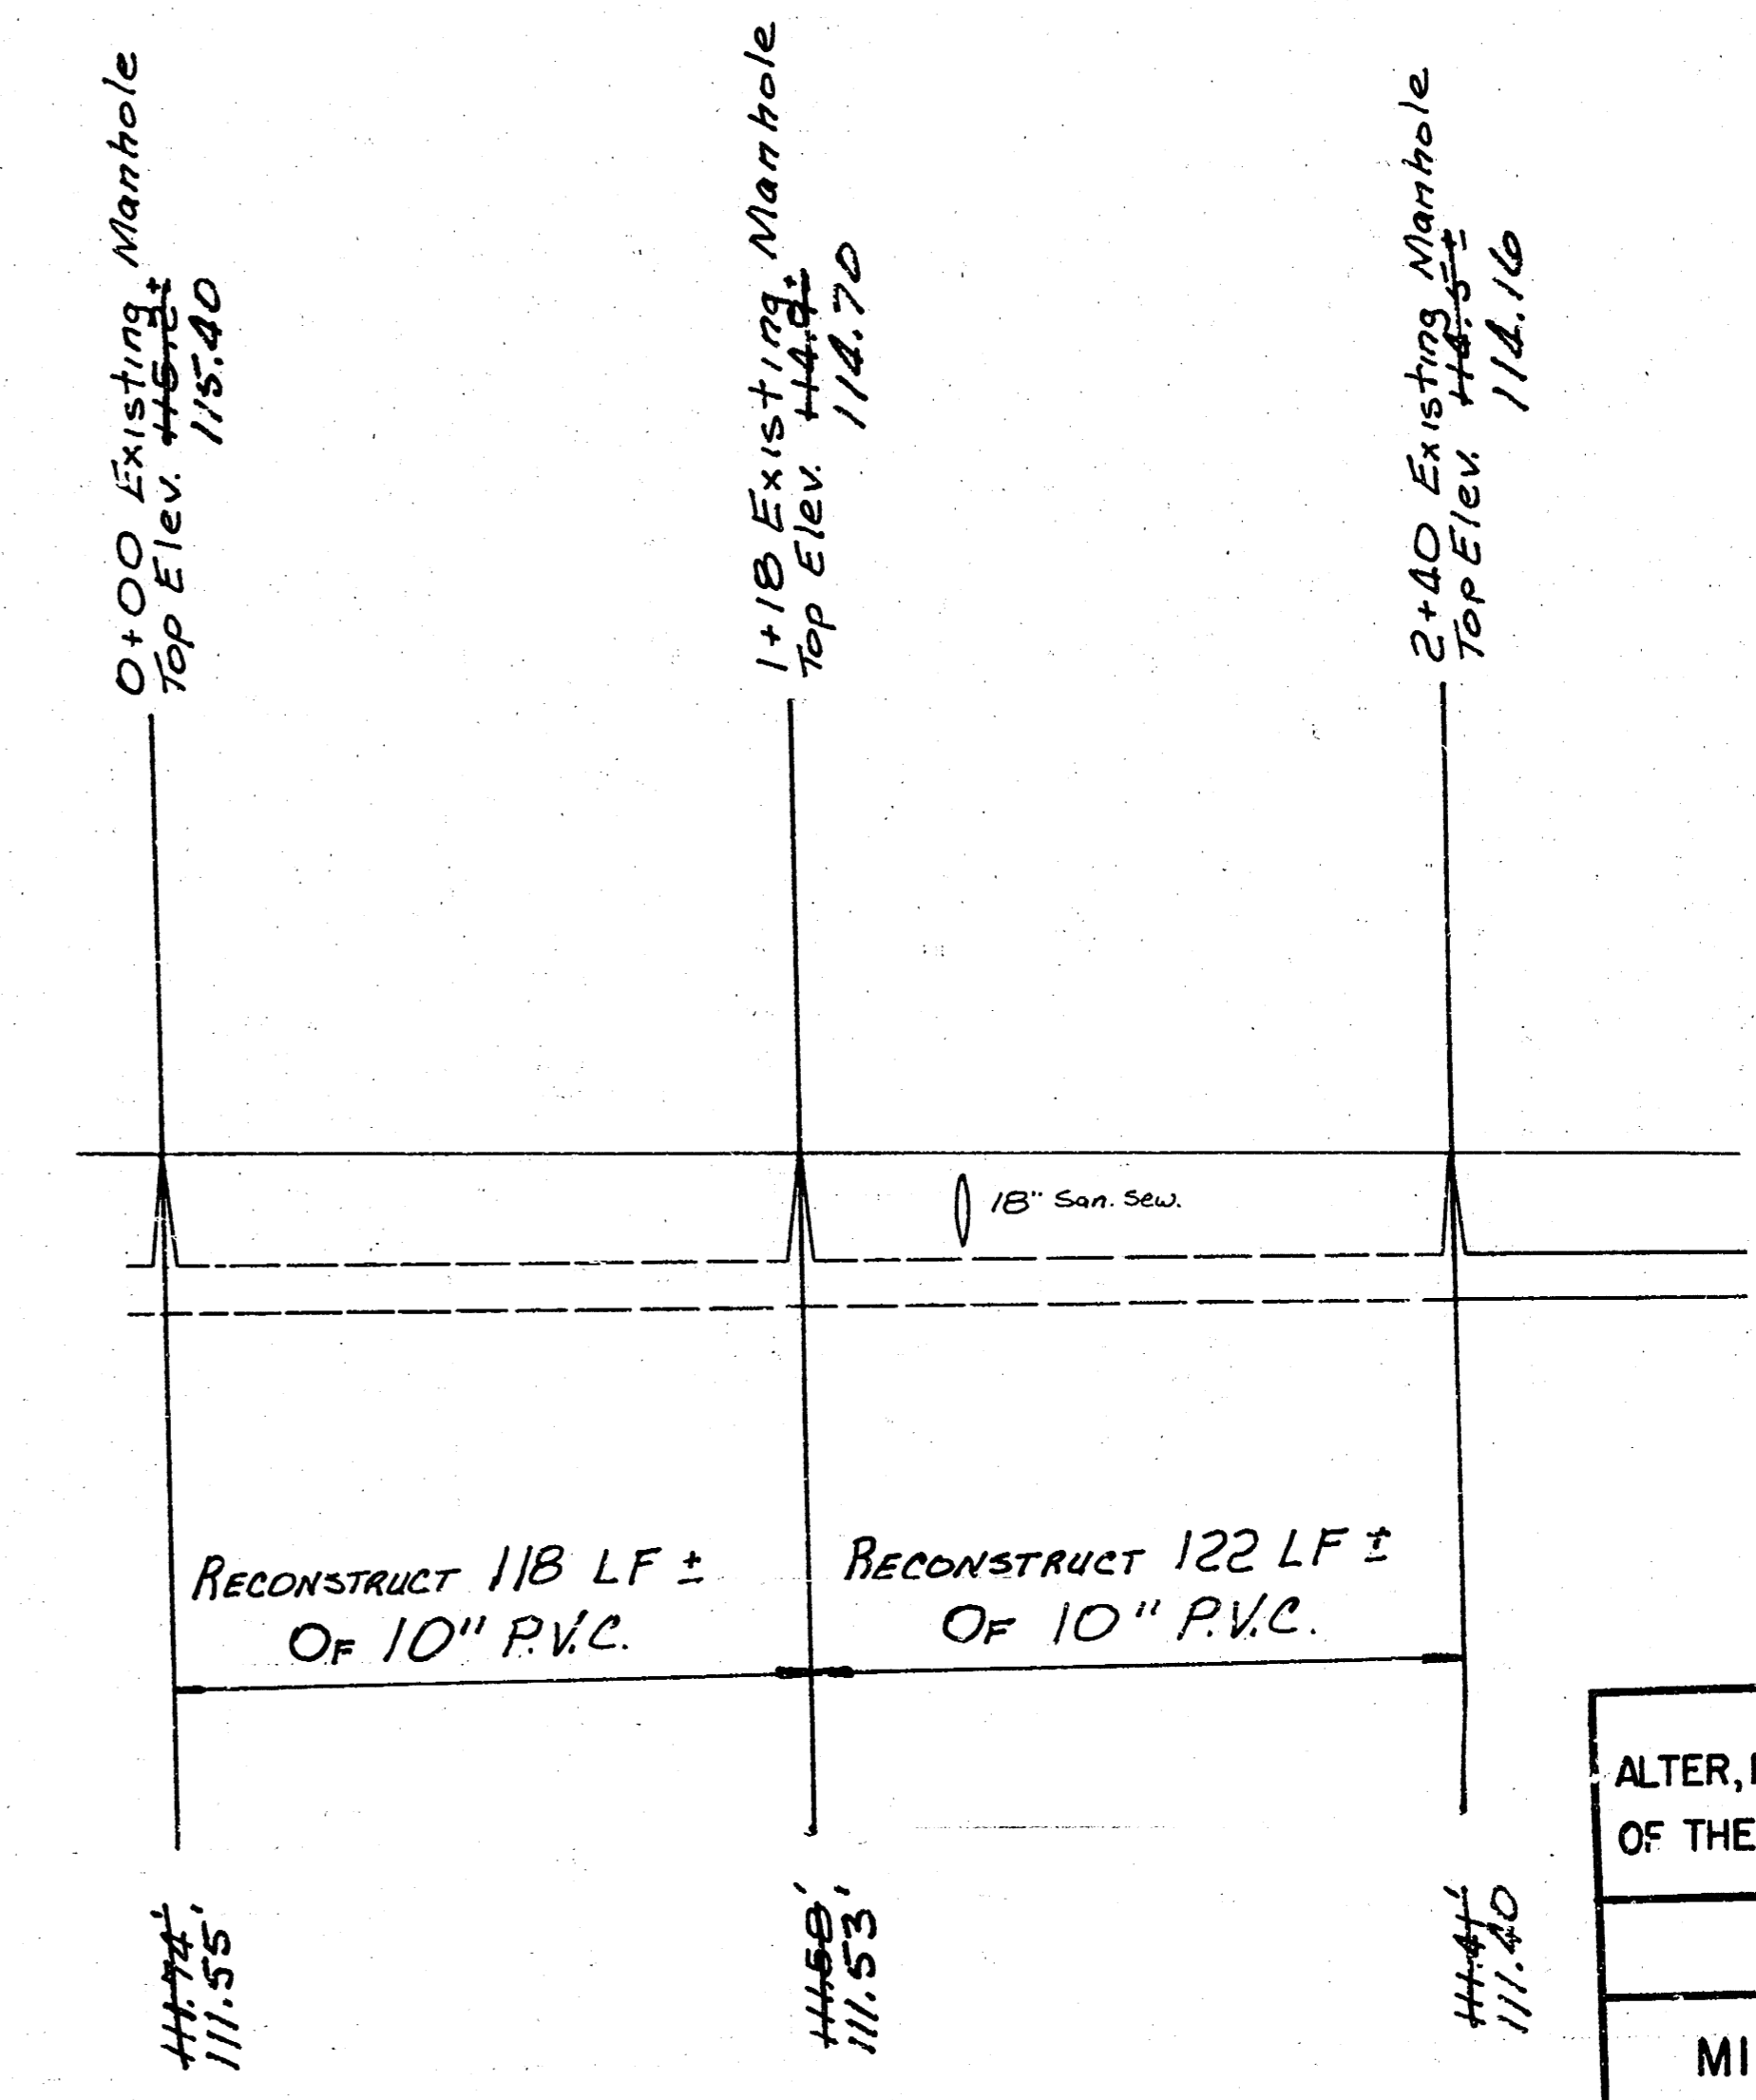

As Built
11-2-86
GREENE

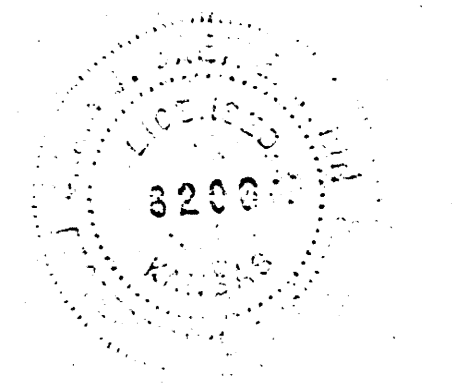

PROJECT DESCRIPTION
ALTER, REPAIR, RECONSTRUCT, OR CONSTRUCT A PORTION OF THE 12TH STREET LATERAL STORM SEWER
468-76-245-81601-000-000-001
MICHAEL E. LINDEBAK - CITY ENGINEER WICHITA, KANSAS 1986

SIC 587

0 1 2 3 4 5 6 7 8 9