


PLAN
 SURVEYED BY
 DATE
 NOTED BY
 CHECKED BY
 NO.

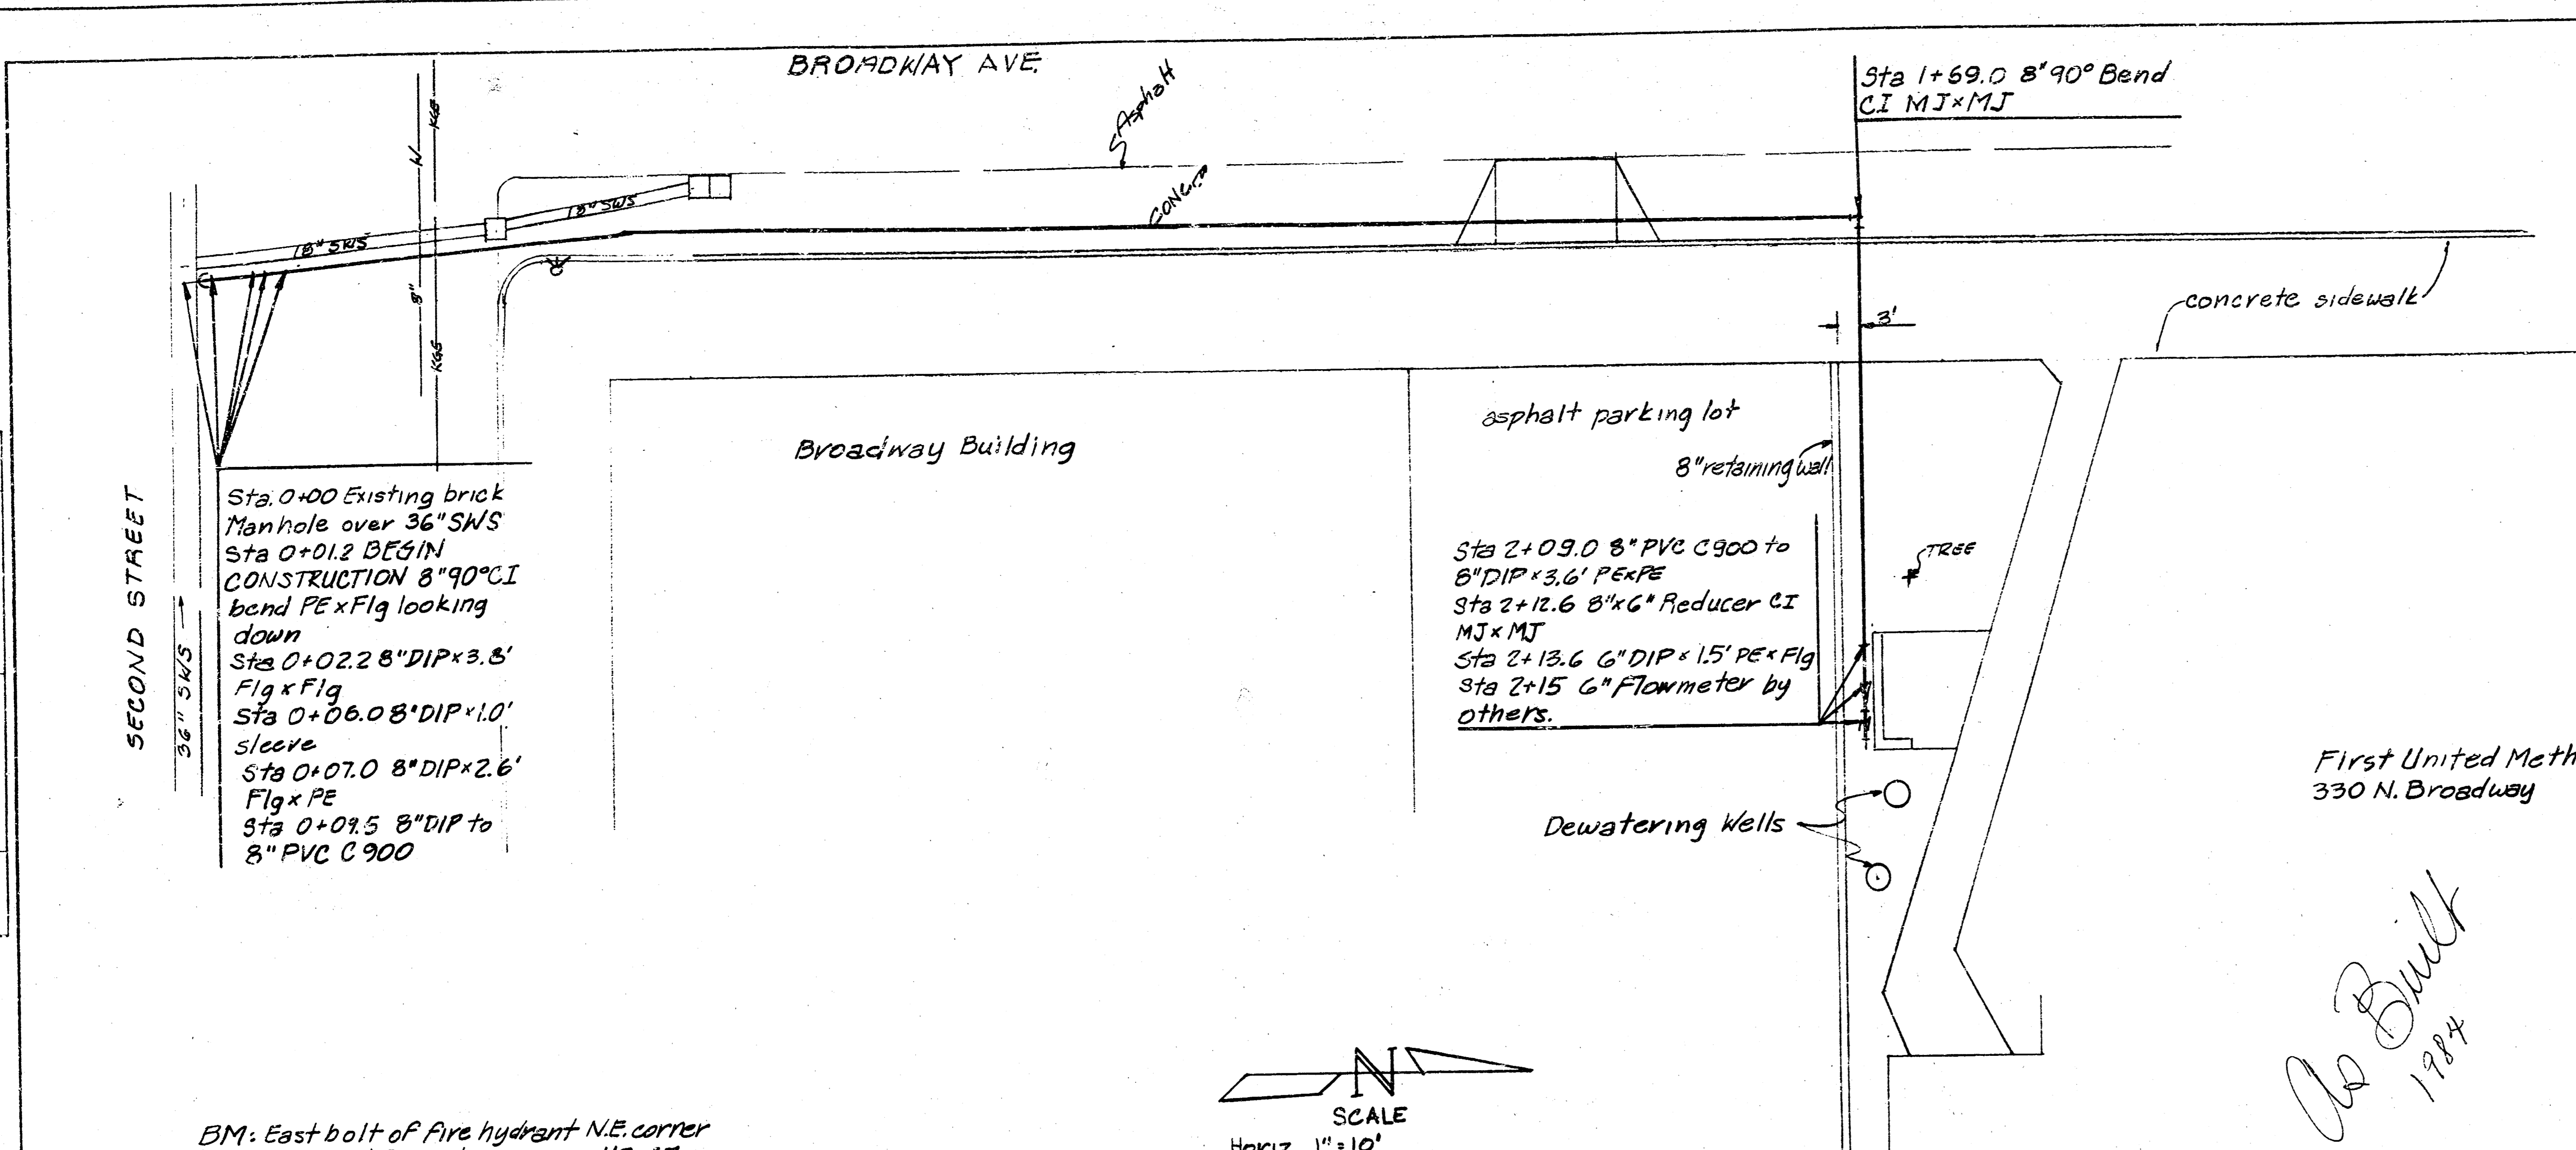

Sta 0+00 Existing brick Manhole over 36\"/>

Sta 2+09.0 8\"/>

First United Methodist Church
 330 N. Broadway

FIELD NOTES COMPILED BY L.G. DUNCAN

CITY OF WICHITA PROJECT NO.
 468-76-245-80000-000-000-008

	UTILITY CONTRACTORS, INC. <small>830 NORTH MARKET - P.O. BOX 2078 WICHITA, KANSAS 67208 - (316) 262-2200</small>
	FIRST UNITED METHODIST CHURCH WICHITA, KANSAS 8\"/>
JOB # 44-3282	BY S. Ramsey
DATE: OCT. 1983	SHEET 1 of 1

As Built
 1984

BM: East bolt of Fire hydrant N.E. corner
 of 2nd and Broadway 112.67

SCALE
 Horiz. 1"=10'
 Vert. 1"=5'

PROFILE
 SURVEYED BY
 DATE
 NOTED BY
 CHECKED BY
 NO.

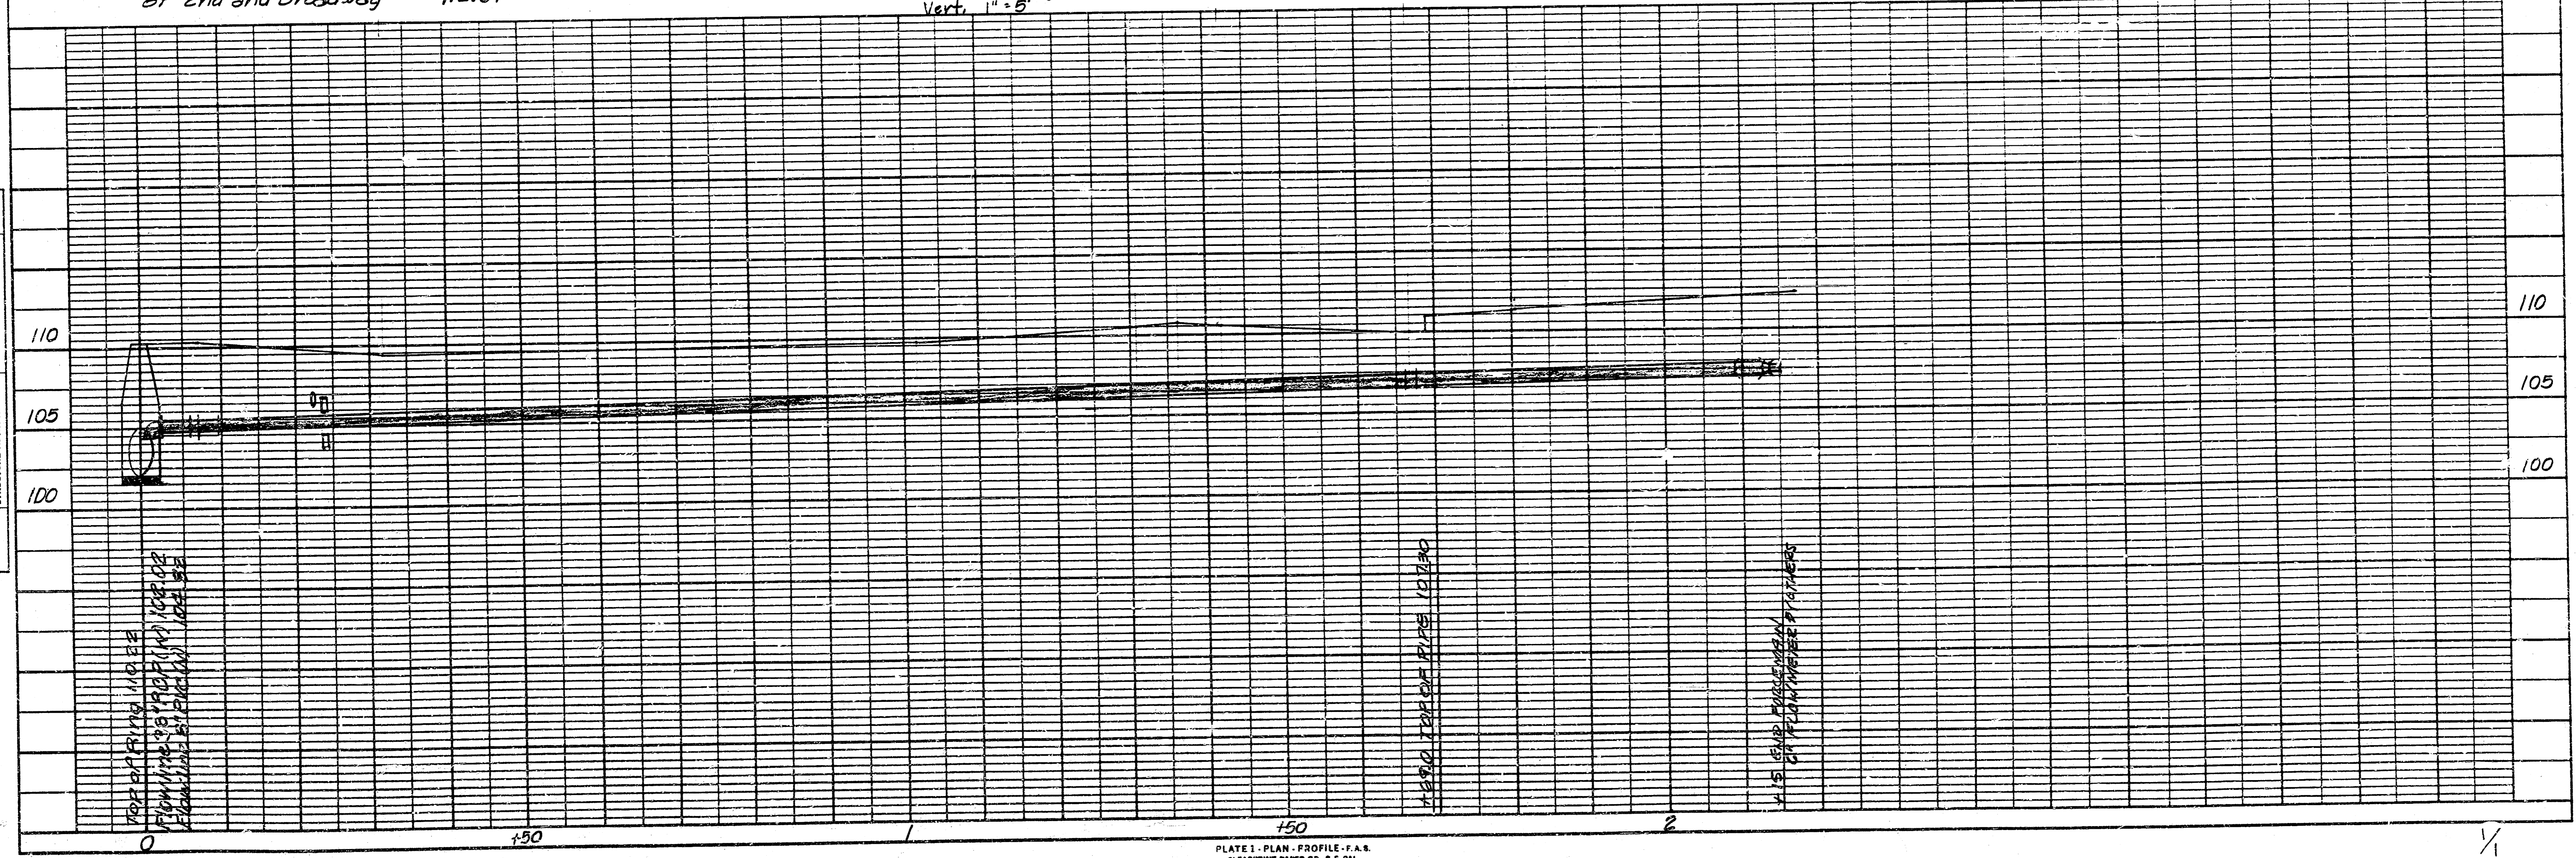


PLATE 1 - PLAN - PROFILE - F.A.S.
 CLEARPRINT PAPER CO., S.F. CAL.
 NO. 1028-1

21 4 1 21

FILMED FROM THE BEST