

LEGEND	
	EXISTING SPOT ELEVATION
	NEW CONTOUR
	NEW SPOT ELEVATION
	TOP OF CURB ELEVATION
	GUTTER ELEVATION


prints issued
FOR BIDDING 11-15-89

revisions
Revised to build
(Baughman Co.)
TCR 1-25-90

date drawn




1300 east lava wichita, kansas 67211
(316) 267-8233

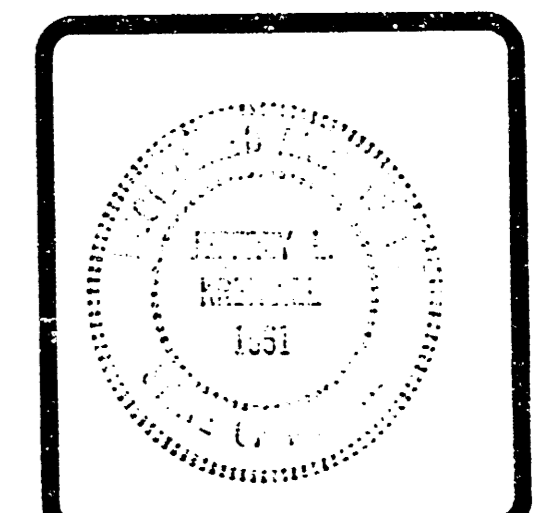

CARLOS O'KELLY'S
527 S. RIDGE RD. CIRCLE
WICHITA, KS.

sheet title
SITE GRADING

sheet
SG-1
of ONE sheets

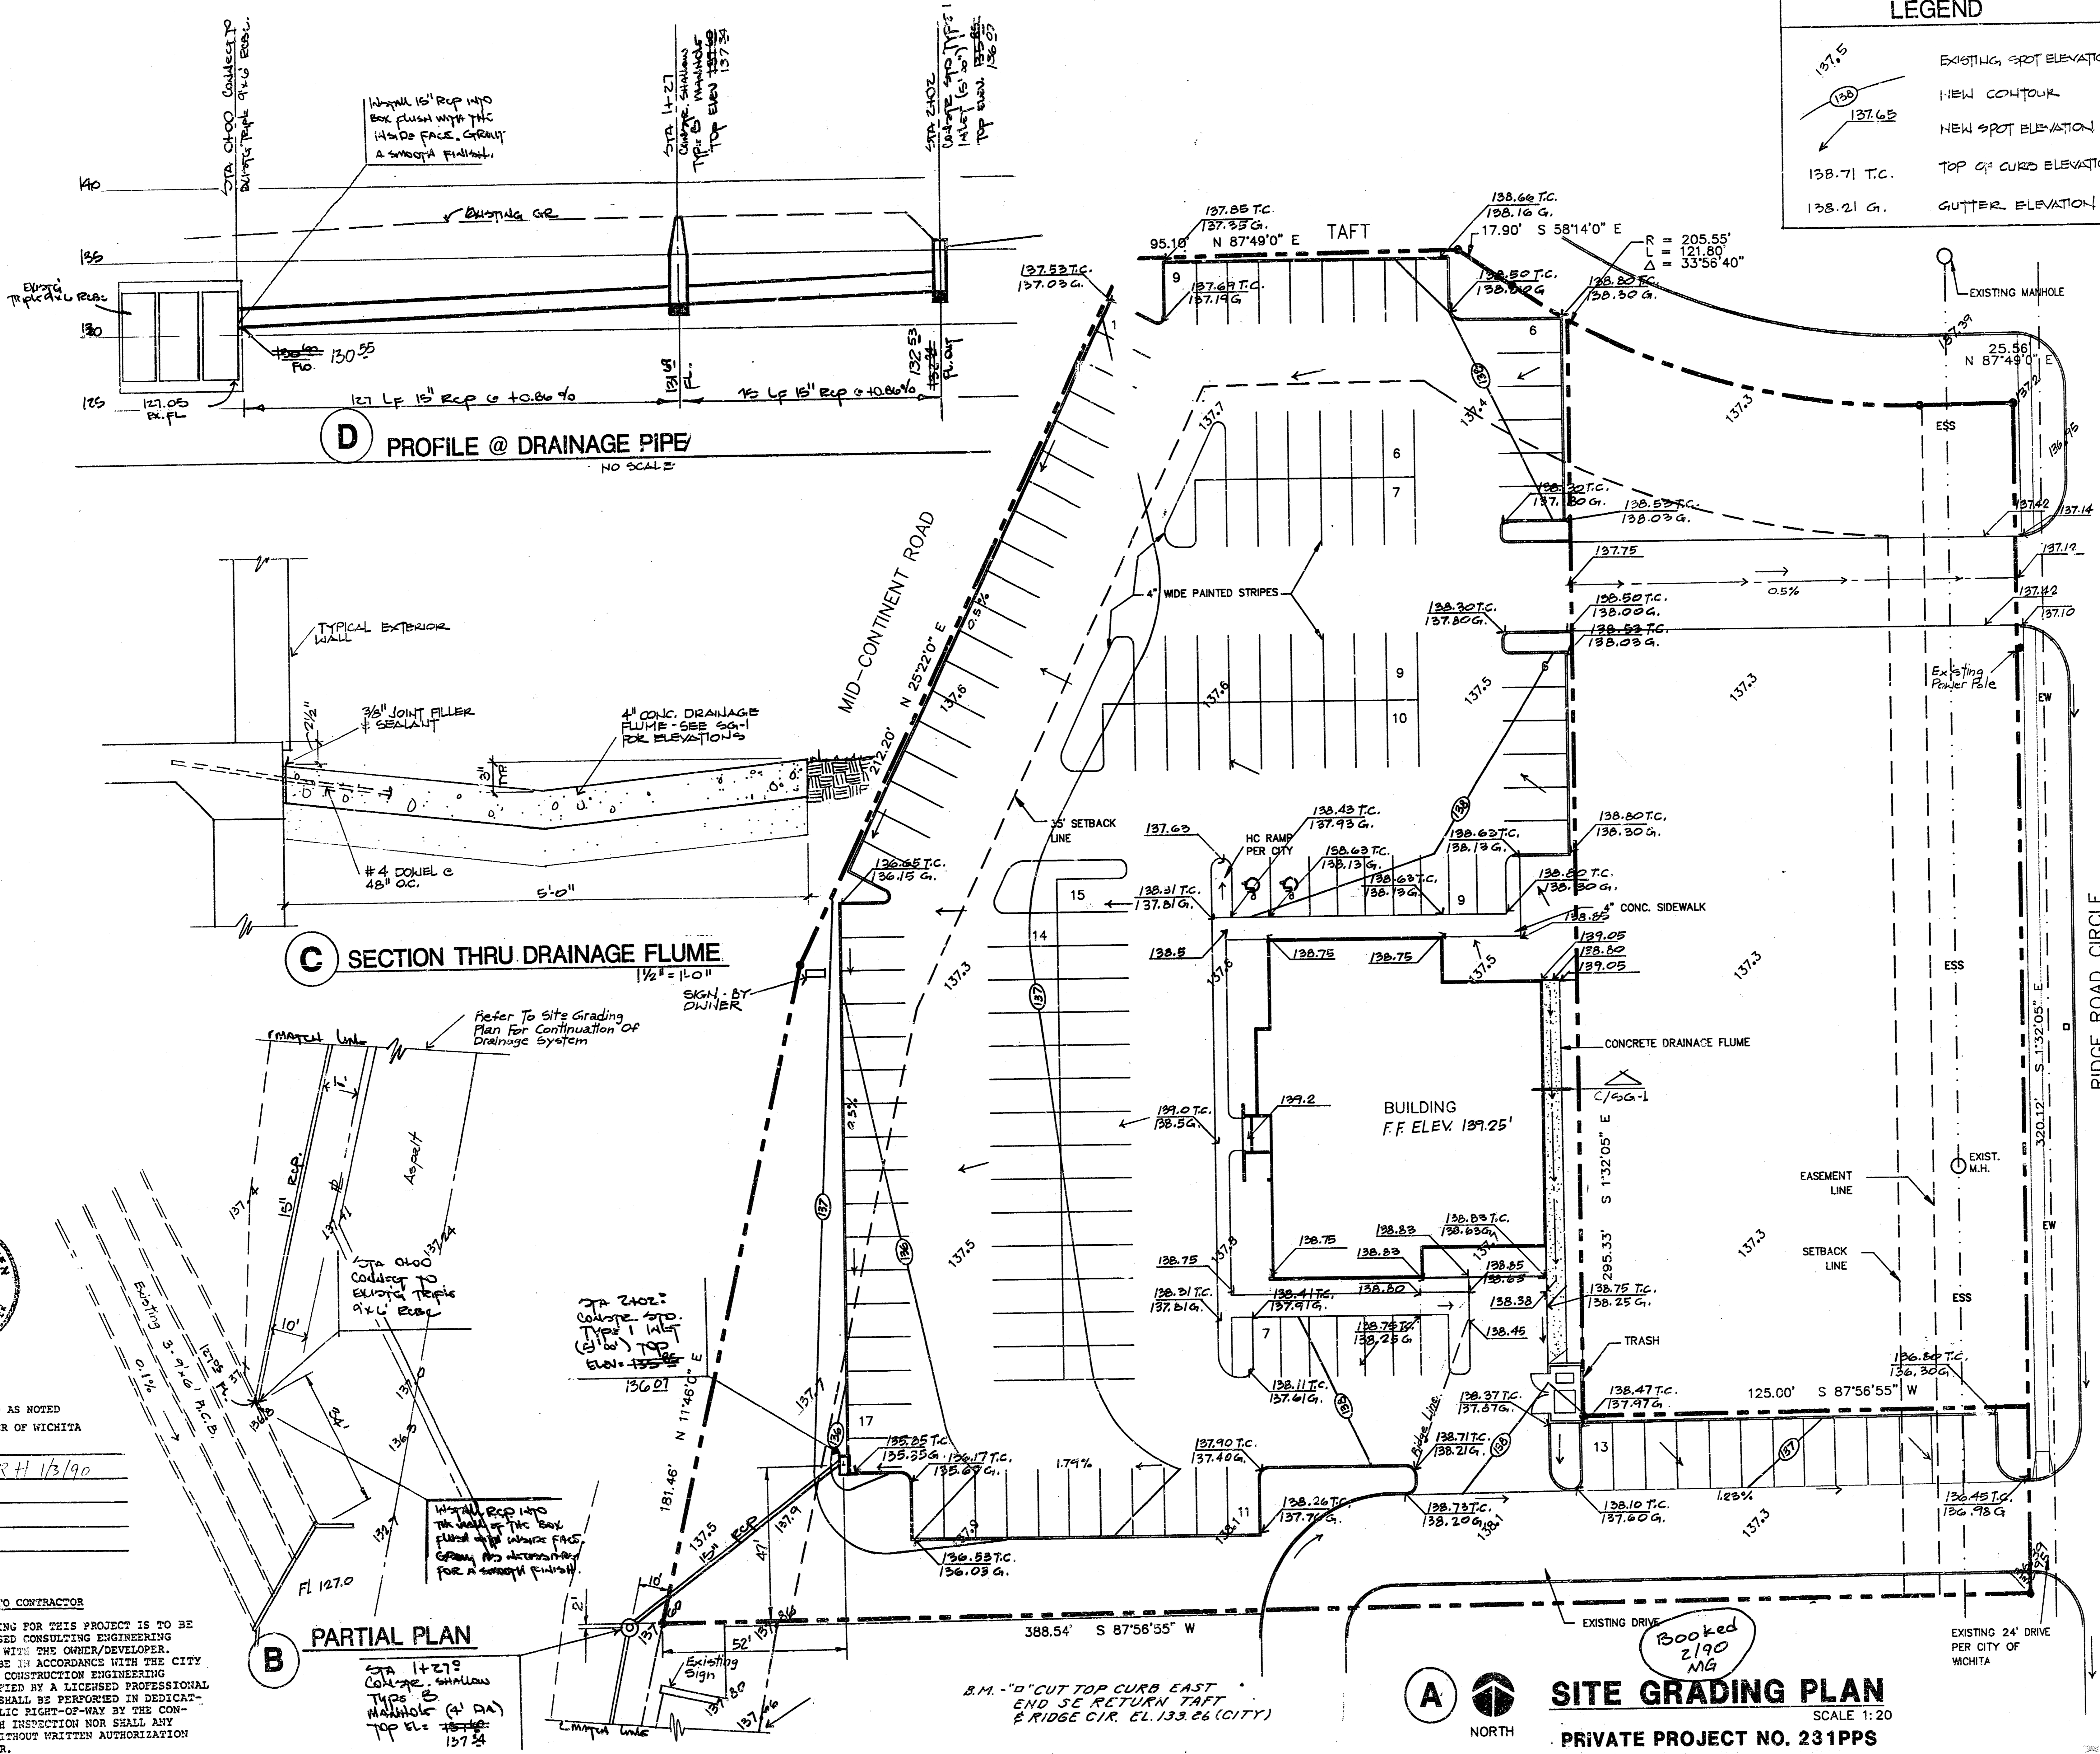


D PROFILE @ DRAINAGE PIPE
NO SCALE

C SECTION THRU DRAINAGE FLUME
1/2" = 1'-0"

B PARTIAL PLAN

A NORTH
SITE GRADING PLAN
SCALE 1:20
PRIVATE PROJECT NO. 231PPS

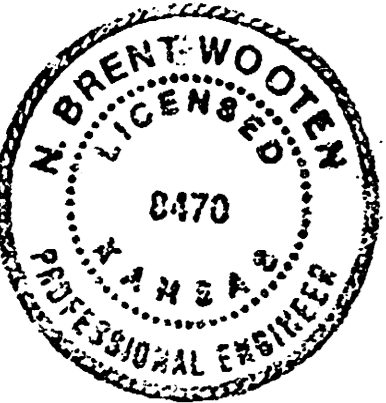

APPROVED AS NOTED
By CITY ENGINEER OF WICHITA

Sanitary Sewers _____
Storm Sewers VRH 1/3/90
Driveway Approaches _____
Water Mains _____
Paving _____

NOTE TO CONTRACTOR

INSPECTION AND TESTING FOR THIS PROJECT IS TO BE PROVIDED BY A LICENSED CONSULTING ENGINEERING FIRM UNDER CONTRACT WITH THE OWNER/DEVELOPER. SAID INSPECTION TO BE IN ACCORDANCE WITH THE CITY OF WICHITA STANDARD CONSTRUCTION ENGINEERING PRACTICES AND CERTIFIED BY A LICENSED PROFESSIONAL ENGINEER. NO WORK SHALL BE PERFORMED IN DEDICATED EASEMENTS OR PUBLIC RIGHT-OF-WAY BY THE CONTRACTOR WITHOUT SUCH INSPECTION NOR SHALL ANY WORK BE COMMENCED WITHOUT WRITTEN AUTHORIZATION BY THE CITY ENGINEER.

W/1/16" REP INTO BOX FLUSH WITH THE 1/4" DE FACE. GRABBY A SMOOTH FINISH.

CONCRETE MANHOLE TYPE 'B' MANHOLE TOP ELEV. 137.33

CONCRETE MANHOLE TYPE 'B' MANHOLE TOP ELEV. 136.57

CONCRETE MANHOLE TYPE 'B' MANHOLE TOP ELEV. 137.34

B.M. - "D" CUT TOP CURB EAST END SE RETURN TAFT & RIDGE CIR. EL. 133.26 (CITY)

Booked 2190 MG