

GENERAL NOTES

- CONTRACTOR WILL BE REQUIRED TO PROVIDE A MINIMUM ADVANCE NOTICE OF TWENTY-FOUR (24) HOURS TO UTILITY COMPANIES PRIOR TO STARTING ANY EXCAVATION.
- ALL WORK SHALL BE COMPLETED IN ACCORDANCE WITH CITY OF WICHITA, KANSAS STANDARD SPECIFICATIONS.
- EXISTING UTILITIES AND THEIR LOCATIONS, AS SHOWN ON THE PLANS, REPRESENT THE BEST INFORMATION OBTAINABLE FOR DESIGN. LOCATION INFORMATION HAS BEEN OBTAINED FROM THE VARIOUS UTILITY COMPANIES AND IS EITHER FROM COMPANY RECORD DRAWINGS OR COMPANY PROVIDED FIELD LOCATIONS. THE CONTRACTOR WILL BE REQUIRED TO WORK AROUND EXISTING UTILITIES WITHIN THE RIGHT-OF-WAY WHICH DO NOT CONFLICT WITH PROPOSED CONSTRUCTION.
- RUBBLE FROM THE REMOVAL OF MISCELLANEOUS STRUCTURES AND EXCESS EXCAVATION WHICH IS TO BE WASTED SHALL BE DISPOSED OF ON SITES TO BE PROVIDED BY THE CONTRACTOR. THESE SITES SHALL BE APPROVED BY THE ENGINEER AS TO SUITABILITY, APPEARANCE AND SITE LOCATION. LOCATIONS THAT, IN THE OPINION OF THE ENGINEER, WILL LEAVE UNSIGHTLY APPEARANCE WILL NOT BE APPROVED.
- THE CONTRACTOR SHALL BE RESPONSIBLE FOR PRESERVING PROPERTY IRONS. THE CONTRACTOR WILL BE REQUIRED TO RE-ESTABLISH ANY PROPERTY IRONS WHICH ARE DAMAGED OR DESTROYED BY HIS CONSTRUCTION OPERATIONS. SUCH IRONS SHALL BE RE-ESTABLISHED BY A LICENSED LAND SURVEYOR OR IN ACCORDANCE WITH STATE LAW.
- GRASS AREAS DISTURBED BY CONSTRUCTION OR STORAGE OF MATERIALS SHALL BE REPLANTED EITHER BY SEEDING OR SODDING WITH THE SAME TYPE OF GRASS AS WAS EXISTING PRIOR TO WATER LINE CONSTRUCTION. SEE 'SPECIAL PROVISIONS' IN THE STANDARD SPECIFICATION NO. 14533 FOR SEEDING AND SODDING OF COOL SEASON AND WARM SEASON GRASSES.
- CONTRACTOR SHALL BE RESPONSIBLE FOR PROVIDING CONSTRUCTION STAKING AND CONSTRUCTION INSPECTION FOR THIS PROJECT IN ACCORDANCE WITH CITY OF WICHITA, KANSAS REQUIREMENTS.

ENGINEER OF WORK


City of Wichita

Sewers *V.K.H. 12/1/92*

City Approaches

Notes

*Booked
MCG
D-202*

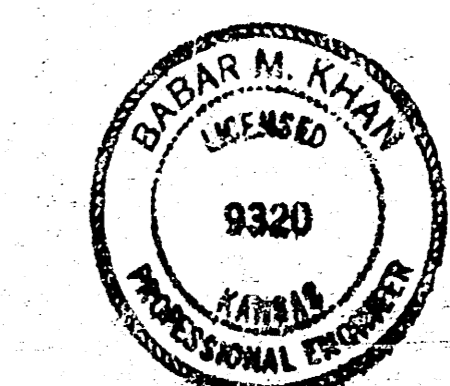

DESIGNED BY	DATE	APPROVED BY	DATE
DRAWN BY	DATE	TITLE	
TRACED	DATE	TITLE	
CHECKED	DATE		

STORM SEWER IMPROVEMENTS

LOT 2, BLOCK 1
FAIRFIELD ESTATES
WICHITA, KANSAS

Private Project No. 368 PPS (607861)

MUNICIPAL ENGINEERS

254-Laura, suite 201
Wichita, Kansas 67211
316-282-3042

CAO FILE NO.

PROJECT NO. 92-45

SHEET NO. 1 OF 1

AS BUILT 5-25-93 B.K.

119 PSE