


B.M. 102.74 - 'M' in Mueller Top of Fire Hydrant
S.W. Cor. Fern & Pawnee.

LOT 3
WESTWAY DEVELOPMENT ADDITION

LOT 11
MEYERS GARDENS ADDN.

MILLWOOD

BLAKE

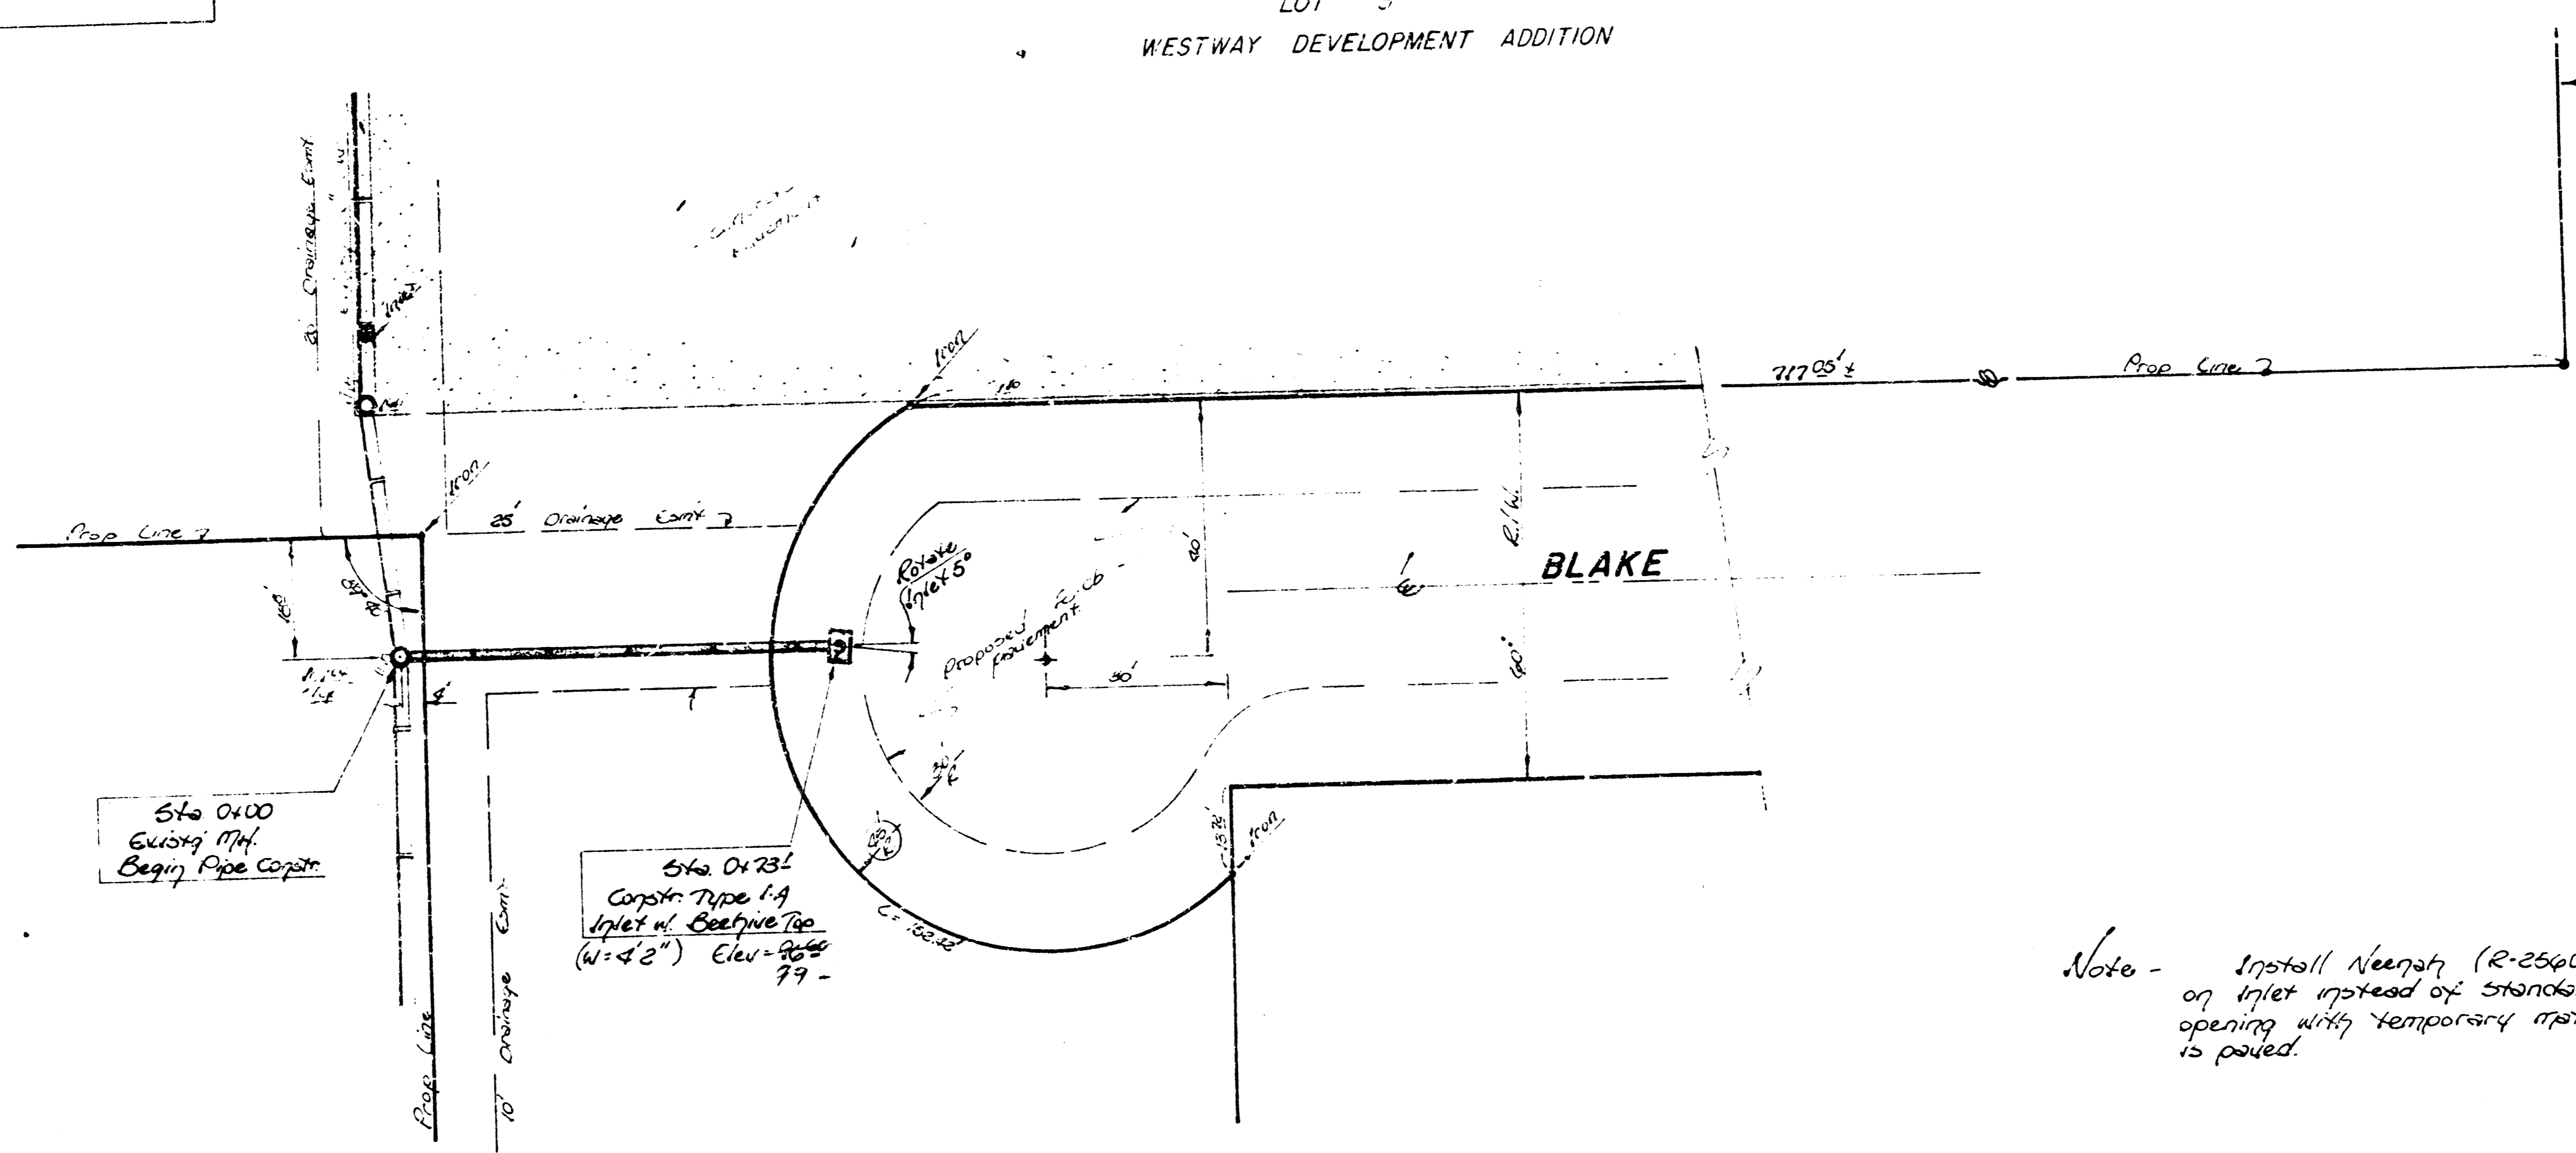

Sta 0+00
Existing MH
Begin Pipe Concr.


Sta 0+31
Concr. Type 1-A
Inlet w/ Beehive Top
(W=4'2") Elev=99'-
79"

Note - Install Neerath (R-2540 E-2) Beehive Inlet Grate
on Inlet instead of standard Inlet cover. Back lateral inlet
opening with temporary material till such time as the street
is paved.

Scale - 1" = 20' Plan
1" = 20' Profile-Ver.
1" = 5' -vert

PLAN
DATE: 1/16/11
BY: [Signature]
SURVEYED: [Signature]
NOTED: [Signature]
CHECKED: [Signature]
NO.:

PROFILE
DATE:
BY:
SURVEYED:
NOTED:
CHECKED:
NO.:

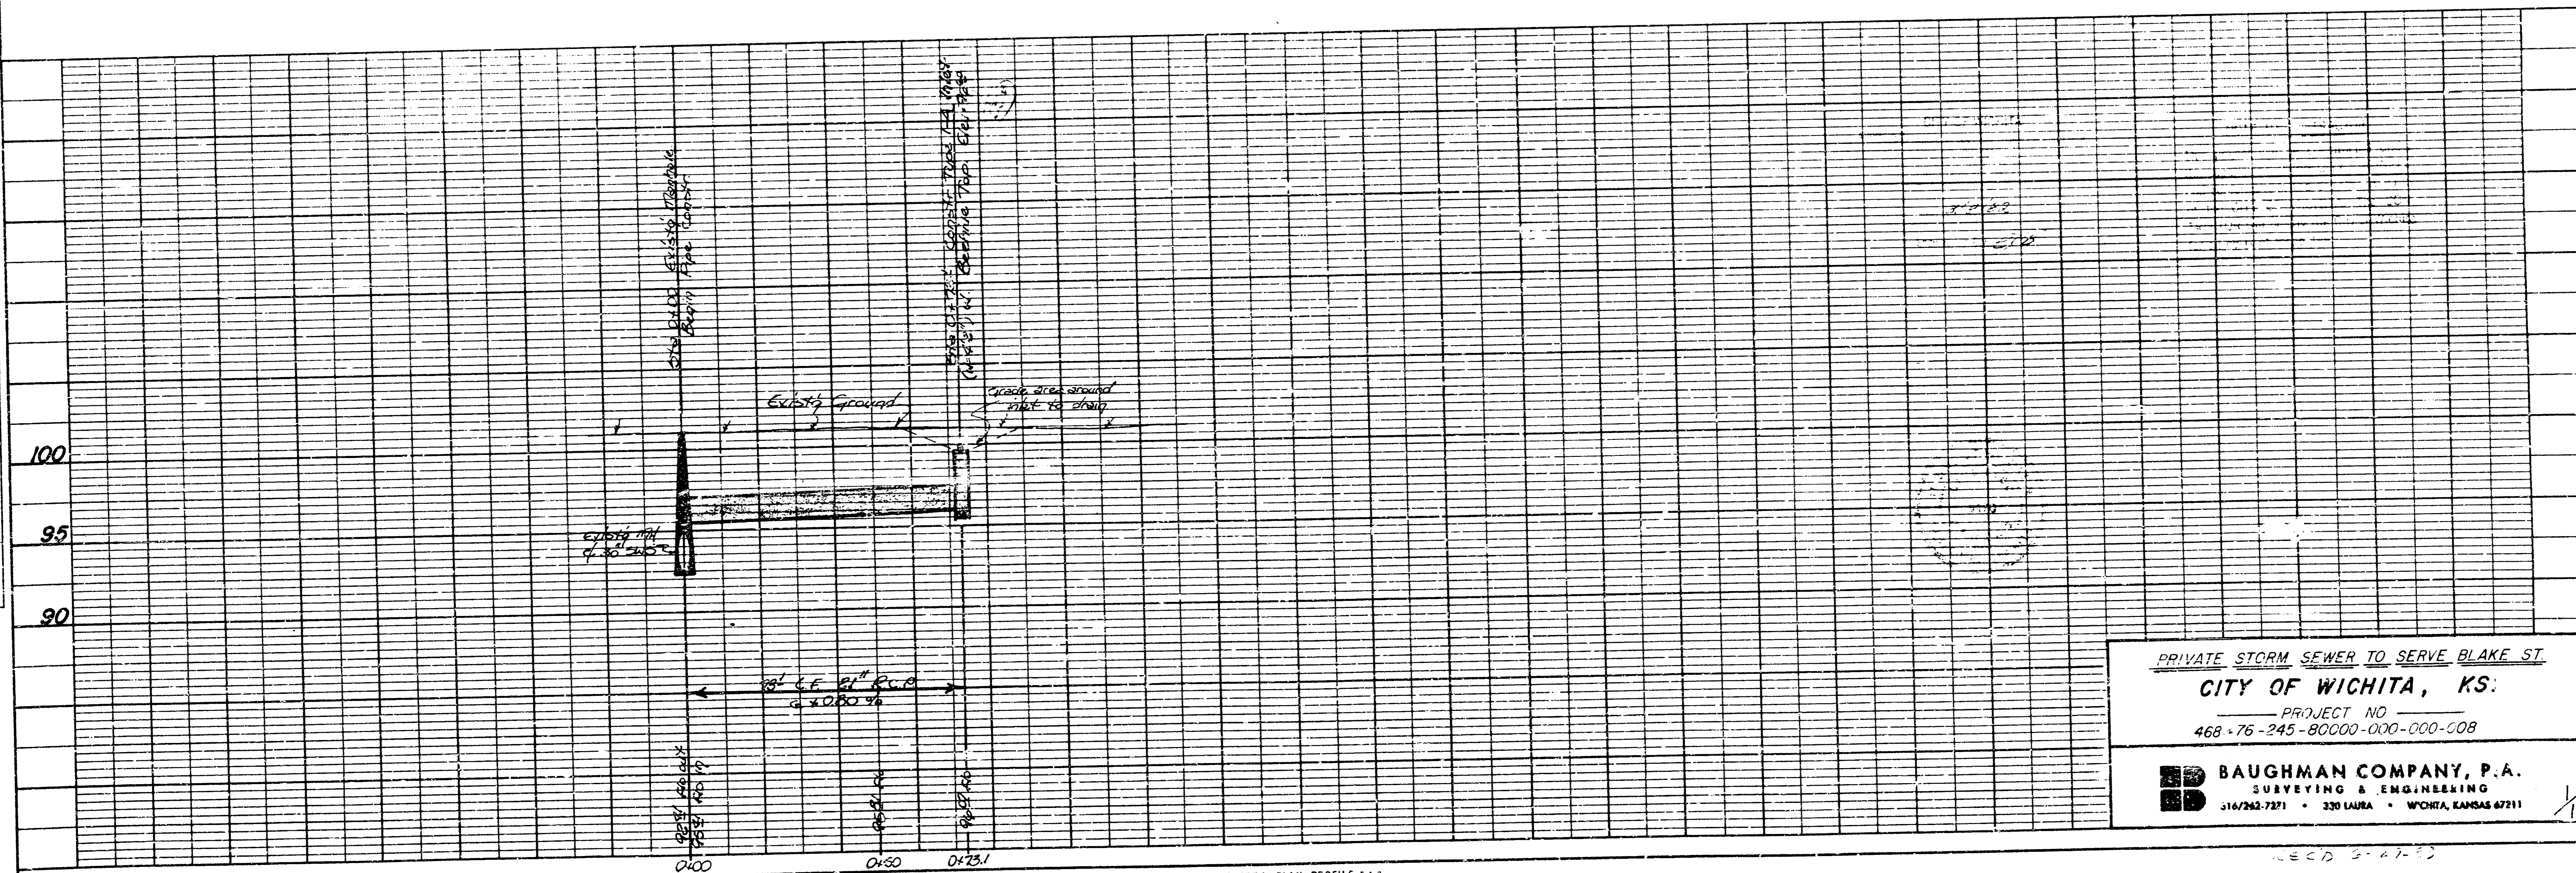

PRIVATE STORM SEWER TO SERVE BLAKE ST.
CITY OF WICHITA, KS.
PROJECT NO. _____
468-76-245-80000-000-000-008

BAUGHMAN COMPANY, P.A.
SURVEYING & ENGINEERING
316/262-7271 • 330 LAURA • WICHITA, KANSAS 67211