


571652

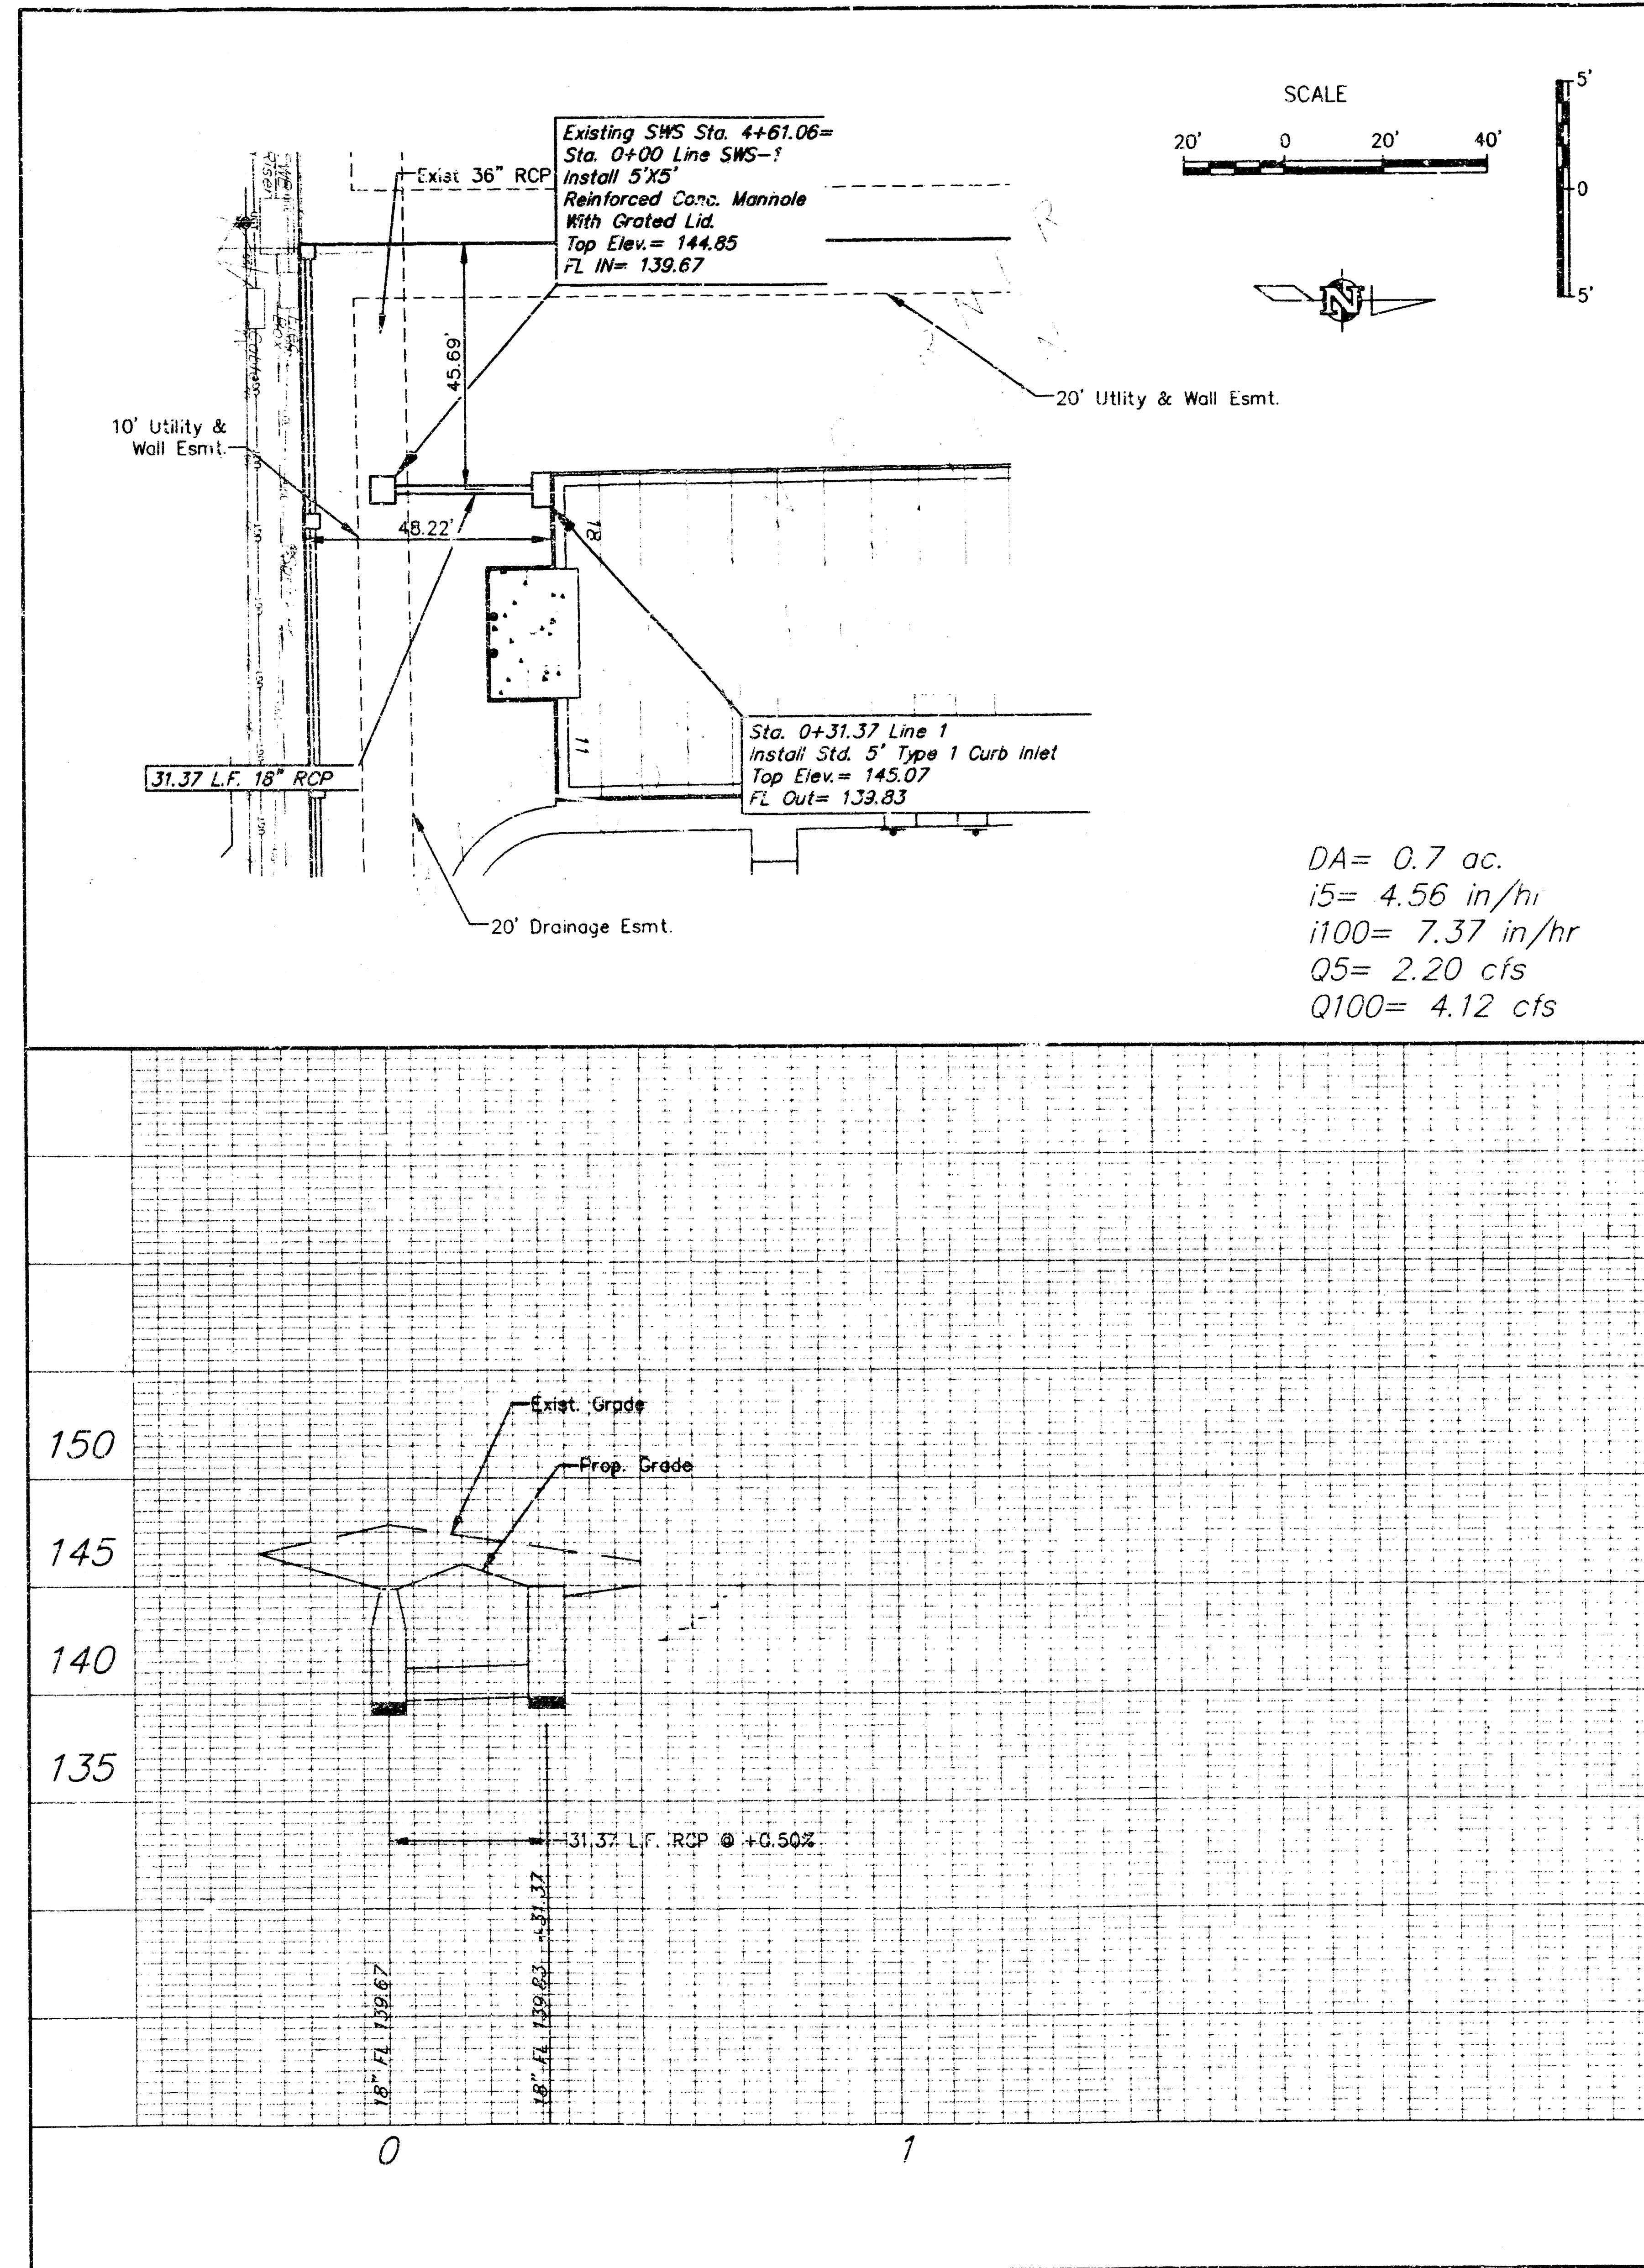

STORMWATER SEWER IMPROVEMENTS TO SERVE PMA CLINIC

Project Number
814 PPS 607381

CITY OF WICHITA, KANSAS
Michael E. Lindebak, P. E., City Engineer


BOOKED
10-19-01
MCG
D-207

BENCHMARK:

#1D= "X" Cut On T/C @ W End
C&G S. Side Parking Lot S. of
Wong's Chinese Restaurant
Elev.= 152.62

GENERAL NOTES

- Contractor will be required to provide notice to utility companies a minimum of twenty-four (24) hours prior to any excavation, as follows:
Kansas One-Call 687-2470
The Contractor must notify the following in case of an emergency:
Cablevision 262-4270
or 263-2061
K.P.L. Gas Service Company 383-8850
Kansas Gas & Electric Company 383-8600
Peoples Gas Company 342-8811
or 1-800-303-0357
Southwestern Bell Telephone Company 1-571-2611
City of Wichita Water Department 268-4908
City of Wichita Sewer Department 268-4071
- Exist. utilities and their locations, as shown on the plans, represent the best information obtainable for design. Location information has been obtained from the various utility companies and is either from company record drawings or company-provided field locations. The Contractor will be required to work around existing utilities which do not conflict with proposed construction.
- The Contractor to verify utility locations prior to construction of this project.
- Utility service and installation shall be coordinated with the respective utility owners. Contacts are:
K&E Gas Steve Orth 261-6857
K.G. & E. Miles Capps 261-6434
Wichita Water Chuck Steven 268-4555
Joe Batimelly 268-4908
Southwestern Bell Jim Tobin 268-2759
- All areas disturbed by construction operations shall be seeded with rye grass at a rate of 300 lbs/acre immediately following construction in that area. Ground shall be prepared per City of Wichita specifications prior to seeding.
- Traffic affected by the construction of this project shall be handled in accordance with the latest edition of the Manual on Uniform Traffic Control Devices.

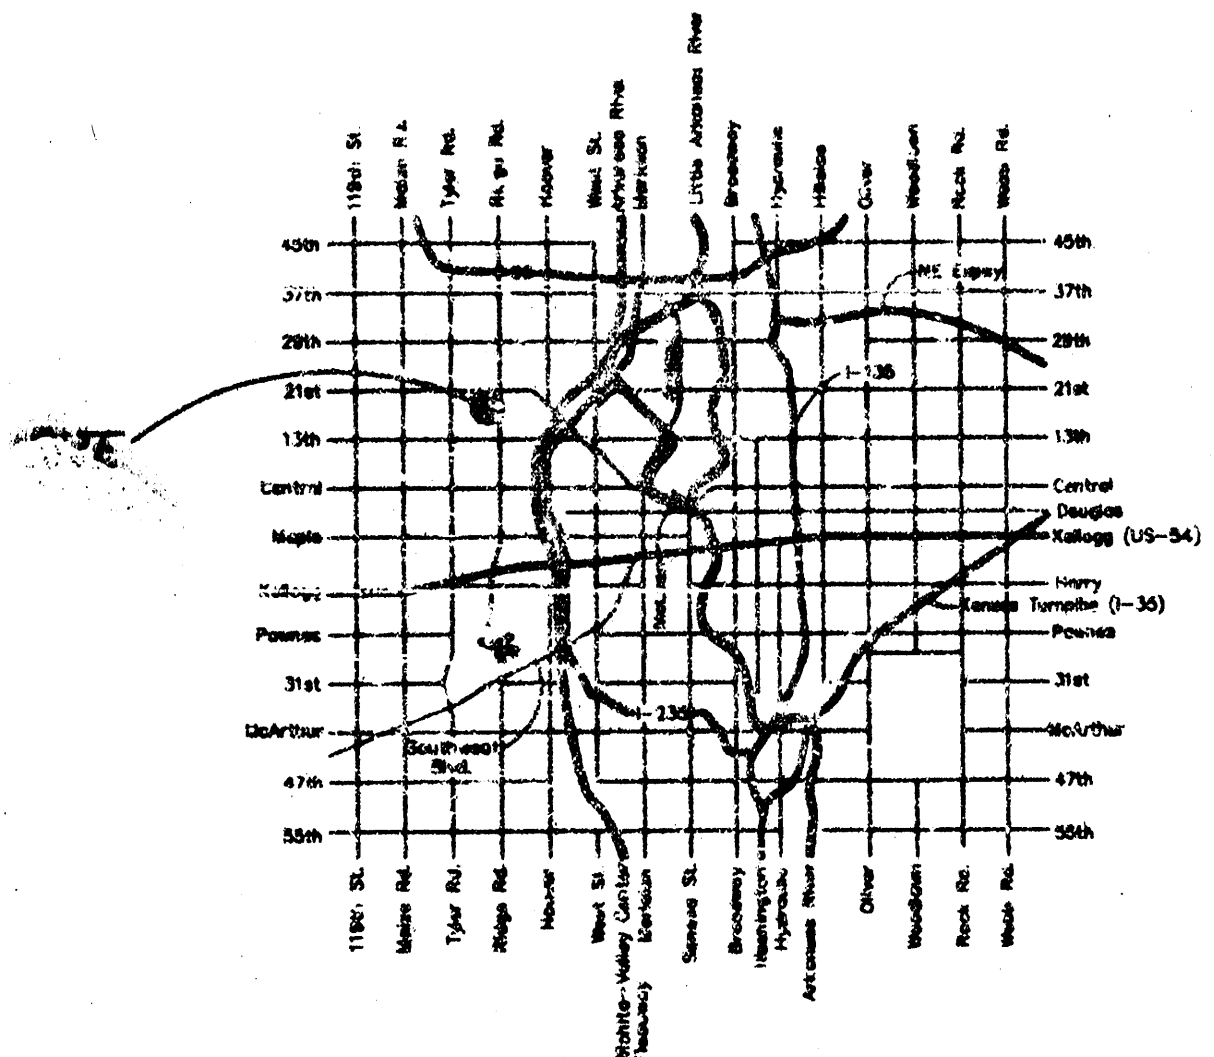

LOCATION MAP

APPROVED AS NOTED BY CITY ENGINEER OF WICHITA
STORM SEWERS VRH 7/14/98

Inspection and testing for this project are to be provided by a Licensed Consulting Engineering Firm under contract with the Owner/Developer. Said inspection is to be in accordance with the City of Wichita standard construction engineering practices and certified by a Licensed Professional Engineer. No work shall be performed in dedicated easements or public right-of-way by the Contractor without such inspection nor shall work be commenced without written authorization by the City Engineer. All construction and materials shall comply with the City of Wichita Specifications and Standards (on file and available in the City Engineer's Office).

[Signature]
7/1/98

AS-BUILT
Date: 7/1/98
Signed: *[Signature]*

DESIGN KM	DRAWN JC	FILE SWS1	DATE 6/12/98	SCALE 1"=20'	PROJECT NUMBER 814 PPS 607381	AM NO. 98045	PMA CLINIC		SHEET 1 OF 1
							LINE SWS-1		
LOT 2, BLK D, BARRINGTON CORNER 2ND ADD.								REVISED	