

PLAN


DATE	
BY	
CHECKED	
APPROVED	
NOTED	
REVISIONS	

PROFILE

DATE	
BY	
CHECKED	
APPROVED	
NOTED	
REVISIONS	

WYE LOCATIONS
Storm Sewer "D" to "K"
(All wyes to south)

- 1.35
- 1.50
- 1.60
- 1.75
- 2.03
- 2.15
- 2.44
- 2.59
- 2.76

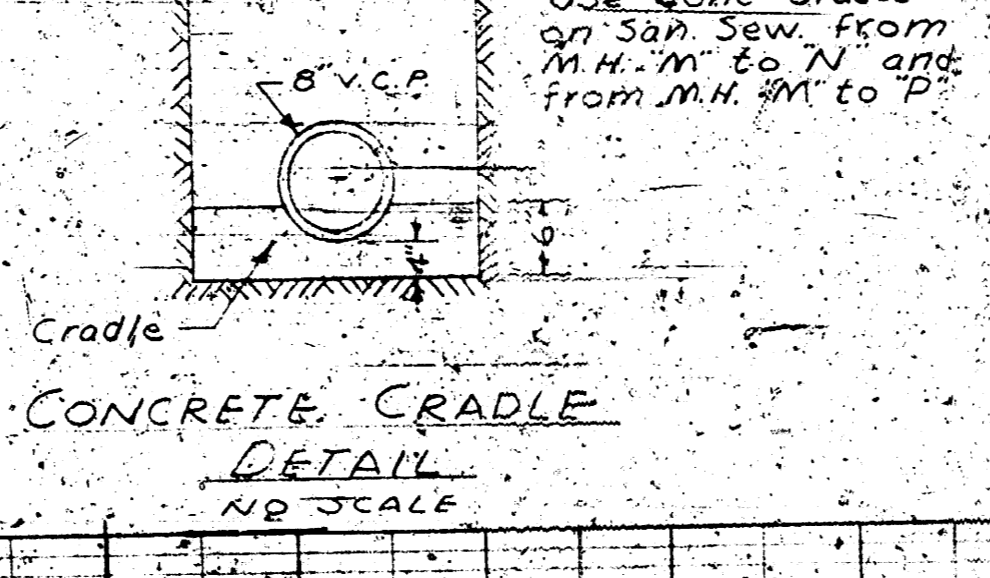

SCALE
Plan - 1" = 50'
Profile 1" = 50' Hor.
1" = 5' Ver.

ST. JOSEPH'S HOSPITAL
SEWER DETAILS
PLAN 101-S
4-3-51
RIPSTRA-TURNER CO.
WICHITA, KANSAS
H.R. HUNTER CONSULTING ENGINEER

Note: Sanitary Sewer Plans
are as built storm
sewer plans are as
built to 500, 1000
between 10' & 20'

H.R. HUNTER
CONSULTING ENGINEER
WICHITA, KANSAS