


LOT 1, BLK 1, VIA CHRISTI
 FAMILY PRACTICE ADDITION
 SANITARY SEWER & SWS
 1364PPS (607861)


APPROVED AS NOTED
 BY CITY ENGINEER OF WICHITA &
 BY WICHITA FIRE DEPARTMENT

GENERAL NOTES

- UNLESS SHOWN OR STATED OTHERWISE ON THESE DRAWINGS, MATERIALS AND CONSTRUCTION SHALL BE IN ACCORDANCE WITH CITY OF WICHITA STANDARD SPECIFICATIONS.
- CONTRACTOR WILL BE REQUIRED TO PROVIDE A MINIMUM ADVANCE NOTICE OF SEVENTY-TWO (72) HOURS TO UTILITY COMPANIES PRIOR TO STARTING ANY EXCAVATION AS FOLLOWS:
 KANSAS ONE-CALL 1-800-344-7233
 or 687-2470 (LOCAL WICHITA)
 THE CONTRACTOR MUST NOTIFY THE FOLLOWING IN CASE OF AN EMERGENCY:
 SBC (TELEPHONE) 800-870-8390
 COX COMMUNICATIONS (CABLE) 262-0661
 KANSAS GAS SERVICE (GAS) 832-3101
 CITY OF WICHITA WATER & SEWER 262-8000
 WESTAR (ELECTRIC) 261-6512
 AQUILA (GAS) 946-0096
- THE CONTRACTOR SHALL BE RESPONSIBLE FOR PRESERVING PROPERTY IRONS. THE CONTRACTOR WILL BE REQUIRED TO RE-ESTABLISH ANY PROPERTY IRONS WHICH ARE DAMAGED OR DESTROYED BY HIS CONSTRUCTION OPERATIONS. SUCH IRONS SHALL BE RE-ESTABLISHED BY A LICENSED LAND SURVEYOR IN ACCORDANCE WITH STATE LAWS.
- EXISTING UTILITIES AND THEIR LOCATIONS, AS SHOWN ON THE PLANS REPRESENT THE BEST INFORMATION OBTAINABLE FOR DESIGN. LOCATION INFORMATION HAS BEEN OBTAINED FROM THE VARIOUS UTILITY COMPANIES AND IS EITHER FROM COMPANY RECORD DRAWINGS OR COMPANY PROVIDED FIELD LOCATIONS. THE PLAN LOCATIONS SHOWN ARE NOT GUARANTEED. ADDITIONAL EXISTING UTILITIES MAY ALSO BE ENCOUNTERED.
- RUBBLE FROM THE REMOVAL OF MISCELLANEOUS STRUCTURES AND EXCESS EXCAVATION WHICH IS TO BE WASTED SHALL BE DISPOSED OF ON SITES TO BE PROVIDED BY THE CONTRACTOR. THESE SITES SHALL BE APPROVED BY THE ENGINEER AS TO SUITABILITY, APPEARANCE AND SITE LOCATION. LOCATIONS THAT, IN THE OPINION OF THE ENGINEER, WILL LEAVE AN UNSIGHTLY APPEARANCE WILL NOT BE APPROVED. ALL DISPOSAL SITES MUST BE APPROVED BY THE KANSAS DEPARTMENT OF HEALTH AND ENVIRONMENT. MATERIAL EITHER STOCKPILED OR DISPOSED OF IN A FLOOD PLAIN WOULD REQUIRE A KANSAS STATE BOARD OF AGRICULTURE PERMIT. ANY MATERIAL DUMPED IN WATERS OF THE UNITED STATES OR WETLANDS IS SUBJECT TO U.S. CORPS OF ENGINEERS PERMITTING REGULATIONS. ANY MATERIAL BURIED OR STOCKPILED BEYOND APPROVED CONSTRUCTION LIMITS WOULD REQUIRE ADDITIONAL ARCHAEOLOGICAL INVESTIGATIONS UNLESS BURIED IN A PREVIOUSLY APPROVED BORROW LOCATION.
- COST OF EXCAVATION, HAULING, AND DUMPING OF EXCESS EXCAVATION SHALL BE SUBSIDIARY TO THE PROJECT.
- A PORTION OF EXCESS EXCAVATED MATERIAL SHALL BE MOUNDING AROUND MANHOLES WHICH EXTEND MORE THAN ONE (1) FOOT ABOVE THE EXISTING GROUND. SUCH MOUNDS SHALL BE CONSTRUCTED WITH A SIX (6) FOOT DIAMETER FLAT TOP WITH 4 TO 1 SIDE SLOPES DOWN TO THE ORIGINAL GROUND. THE ELEVATION OF THE FLAT TOP OF THE MOUND SHALL BE 0.4 FOOT BELOW THE TOP OF THE MANHOLE.
- ALL STUBS AND PLUGGED PIPES SHALL BE LOCATED WITH GREEN PLASTIC TAPE IN THE SAME MANNER AS RISERS.
- CONNECTING TO EXISTING MANHOLES:
 PRIOR TO LAYING SEWER LINES USING EXISTING STUBS IN EXISTING MANHOLES, THE CONTRACTOR SHALL EXPOSE AND VERIFY THE ELEVATION, GRADE AND ALIGNMENT OF EXISTING STUBS AND NOTIFY THE ENGINEER OF ANY DEVIATION FROM THE PLAN. WHERE CONNECTION TO AN EXISTING MANHOLE THAT DOES NOT HAVE AN EXISTING STUB OR THE STUB IS UNSERVICEABLE DUE TO ELEVATION GRADE OR ALIGNMENT, THE CONTRACTOR SHALL BORE CUT INTO EXISTING MANHOLE WALL TO MAKE CONNECTION USING APPROVED WATER STOP GASKET, AND RESHAPE THE EXISTING MANHOLE INVERT TO PROVIDE SMOOTH FLOW. THE COST OF CONNECTING TO EXISTING MANHOLES IS INCIDENTAL TO THE PROJECT.
- TREES AND SHRUBS IN PUBLIC RIGHT-OF-WAY WHICH ARE IN DIRECT CONFLICT WITH PROPOSED NEW CONSTRUCTION SHALL BE REMOVED BY THE CONTRACTOR WITH THE ENGINEER'S APPROVAL. TREES AND SHRUBS WHICH ARE NOT IN DIRECT CONFLICT WITH PROPOSED NEW CONSTRUCTION SHALL BE SAVED AND PROTECTED FROM DAMAGE.
- ALL DISTURBED AREAS TO BE SEEDED WITH RYE GRASS AT A RATE OF 200 LBS. PER ACRE WITHIN 10 DAYS OF CONSTRUCTION. CONTRACTOR TO PREPARE GROUND PER CITY SPECIFICATIONS. COST IS SUBSIDIARY TO SITE PREPARATION AND RESTORATION.

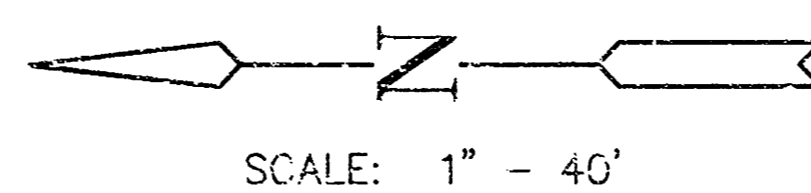


EMPORIA AVE.

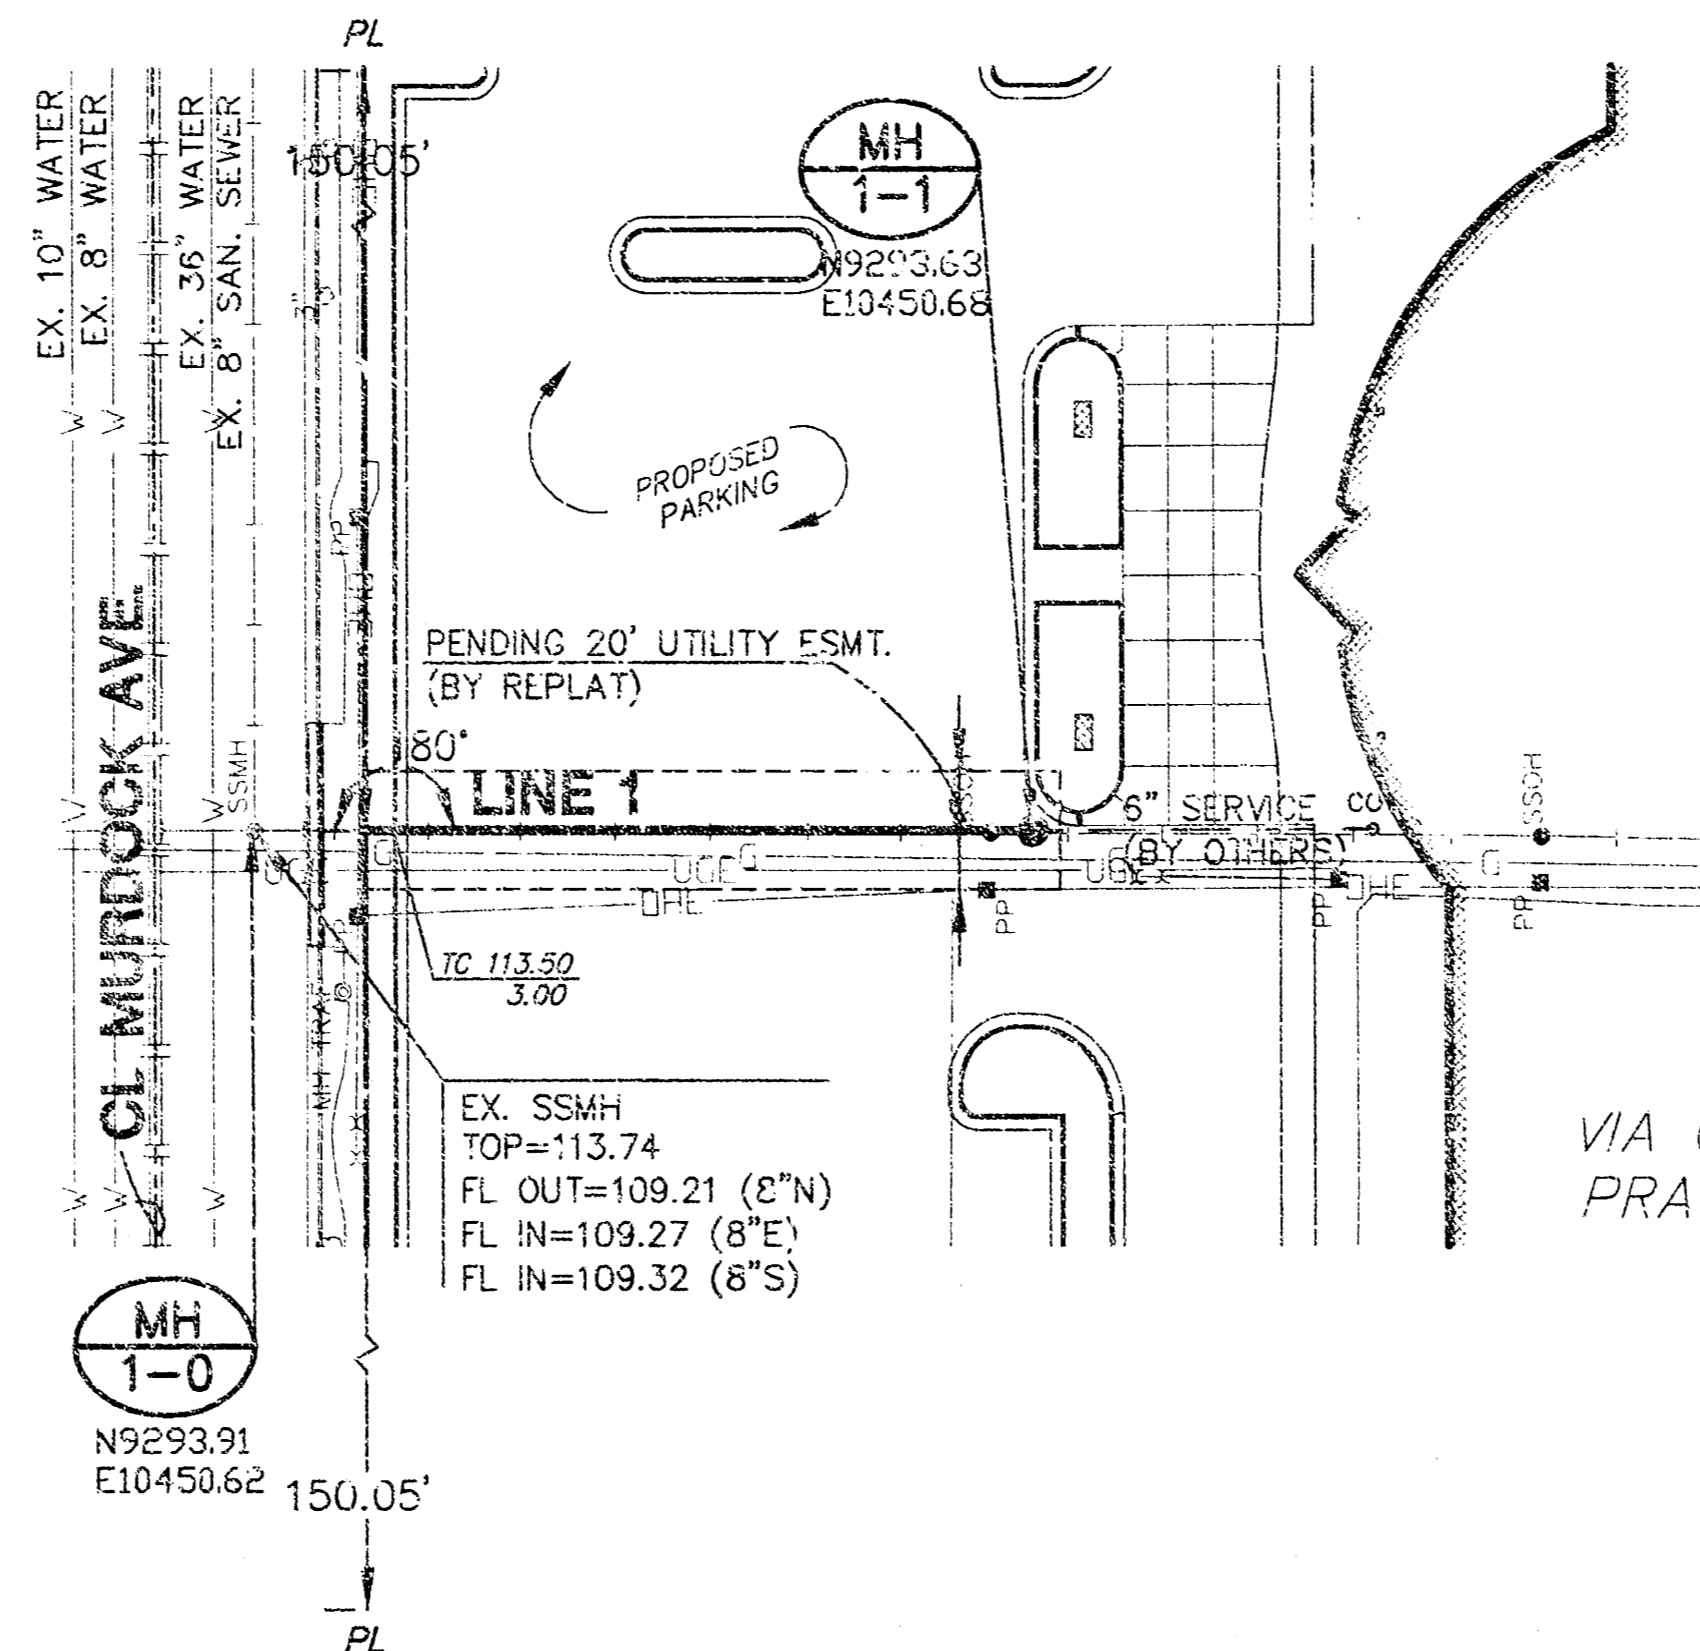

Storm Sewer VRH 11/5/03
 Sanitary Sewer VRH 11/5/03

NOTE TO CONTRACTOR


INSPECTION AND TESTING FOR THIS PROJECT IS TO BE PROVIDED BY A LICENSED CONSULTING ENGINEERING FIRM UNDER CONTRACT WITH THE OWNER/DEVELOPER. SAID INSPECTION TO BE IN ACCORDANCE WITH THE CITY OF WICHITA STANDARD CONSTRUCTION ENGINEERING PRACTICES AND CERTIFIED BY A LICENSED PROFESSIONAL ENGINEER. NO WORK SHALL BE PERFORMED IN DEDICATED EASEMENTS OR THE PUBLIC RIGHT-OF-WAY BY THE CONTRACTOR WITHOUT SUCH INSPECTION NOR SHALL ANY WORK BE COMMENCED IN DEDICATED EASEMENTS OR PUBLIC RIGHT-OF-WAY WITHOUT WRITTEN AUTHORIZATION BY THE CITY ENGINEER.

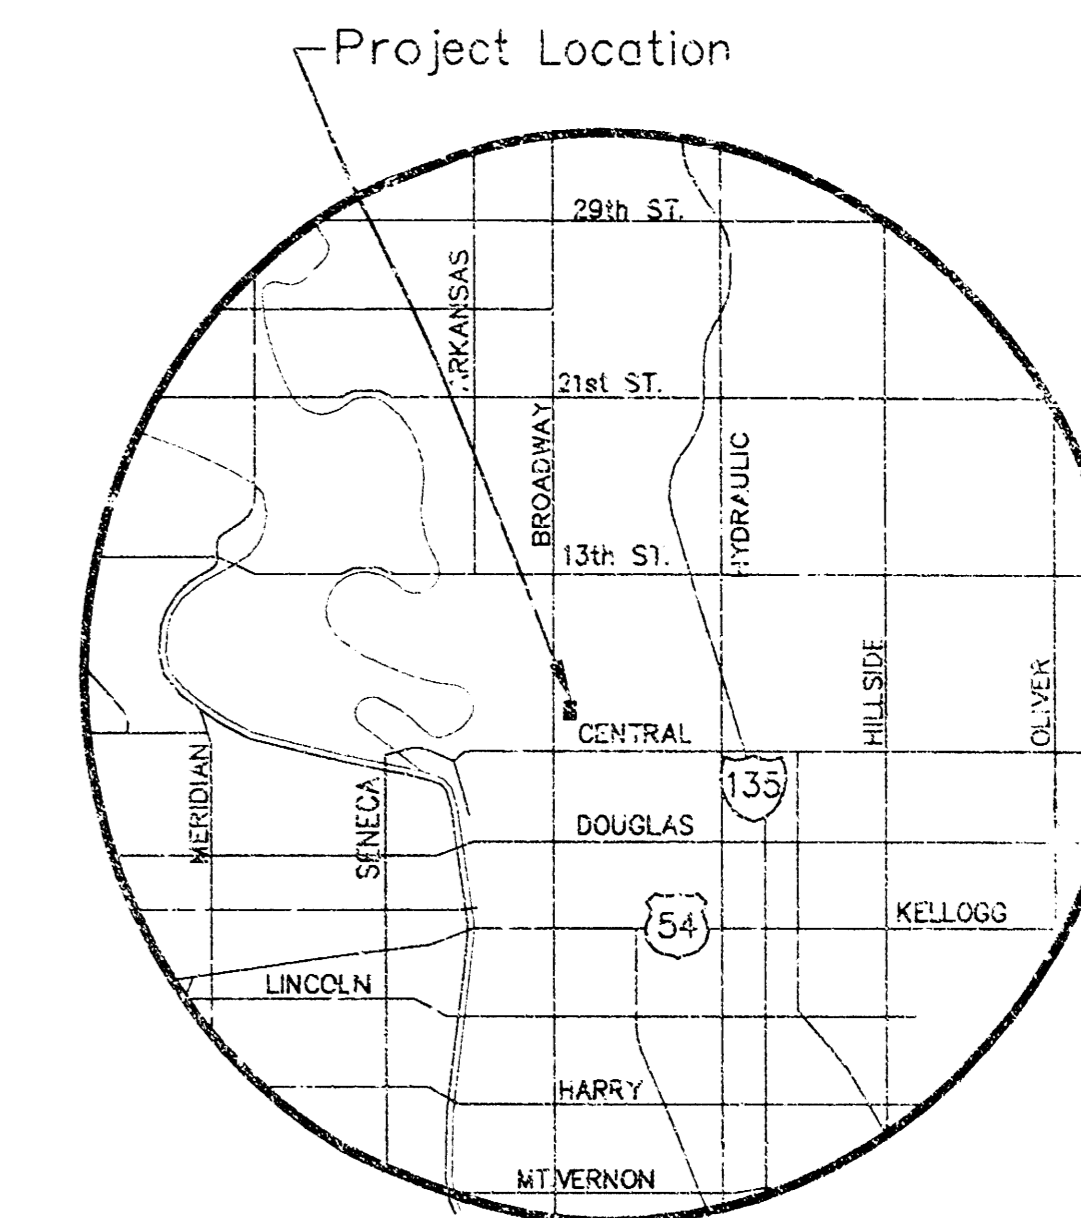

LOCATION MAP

TOPEKA AVE

PLAN - LINE 1
 SCALE: 1" = 40'

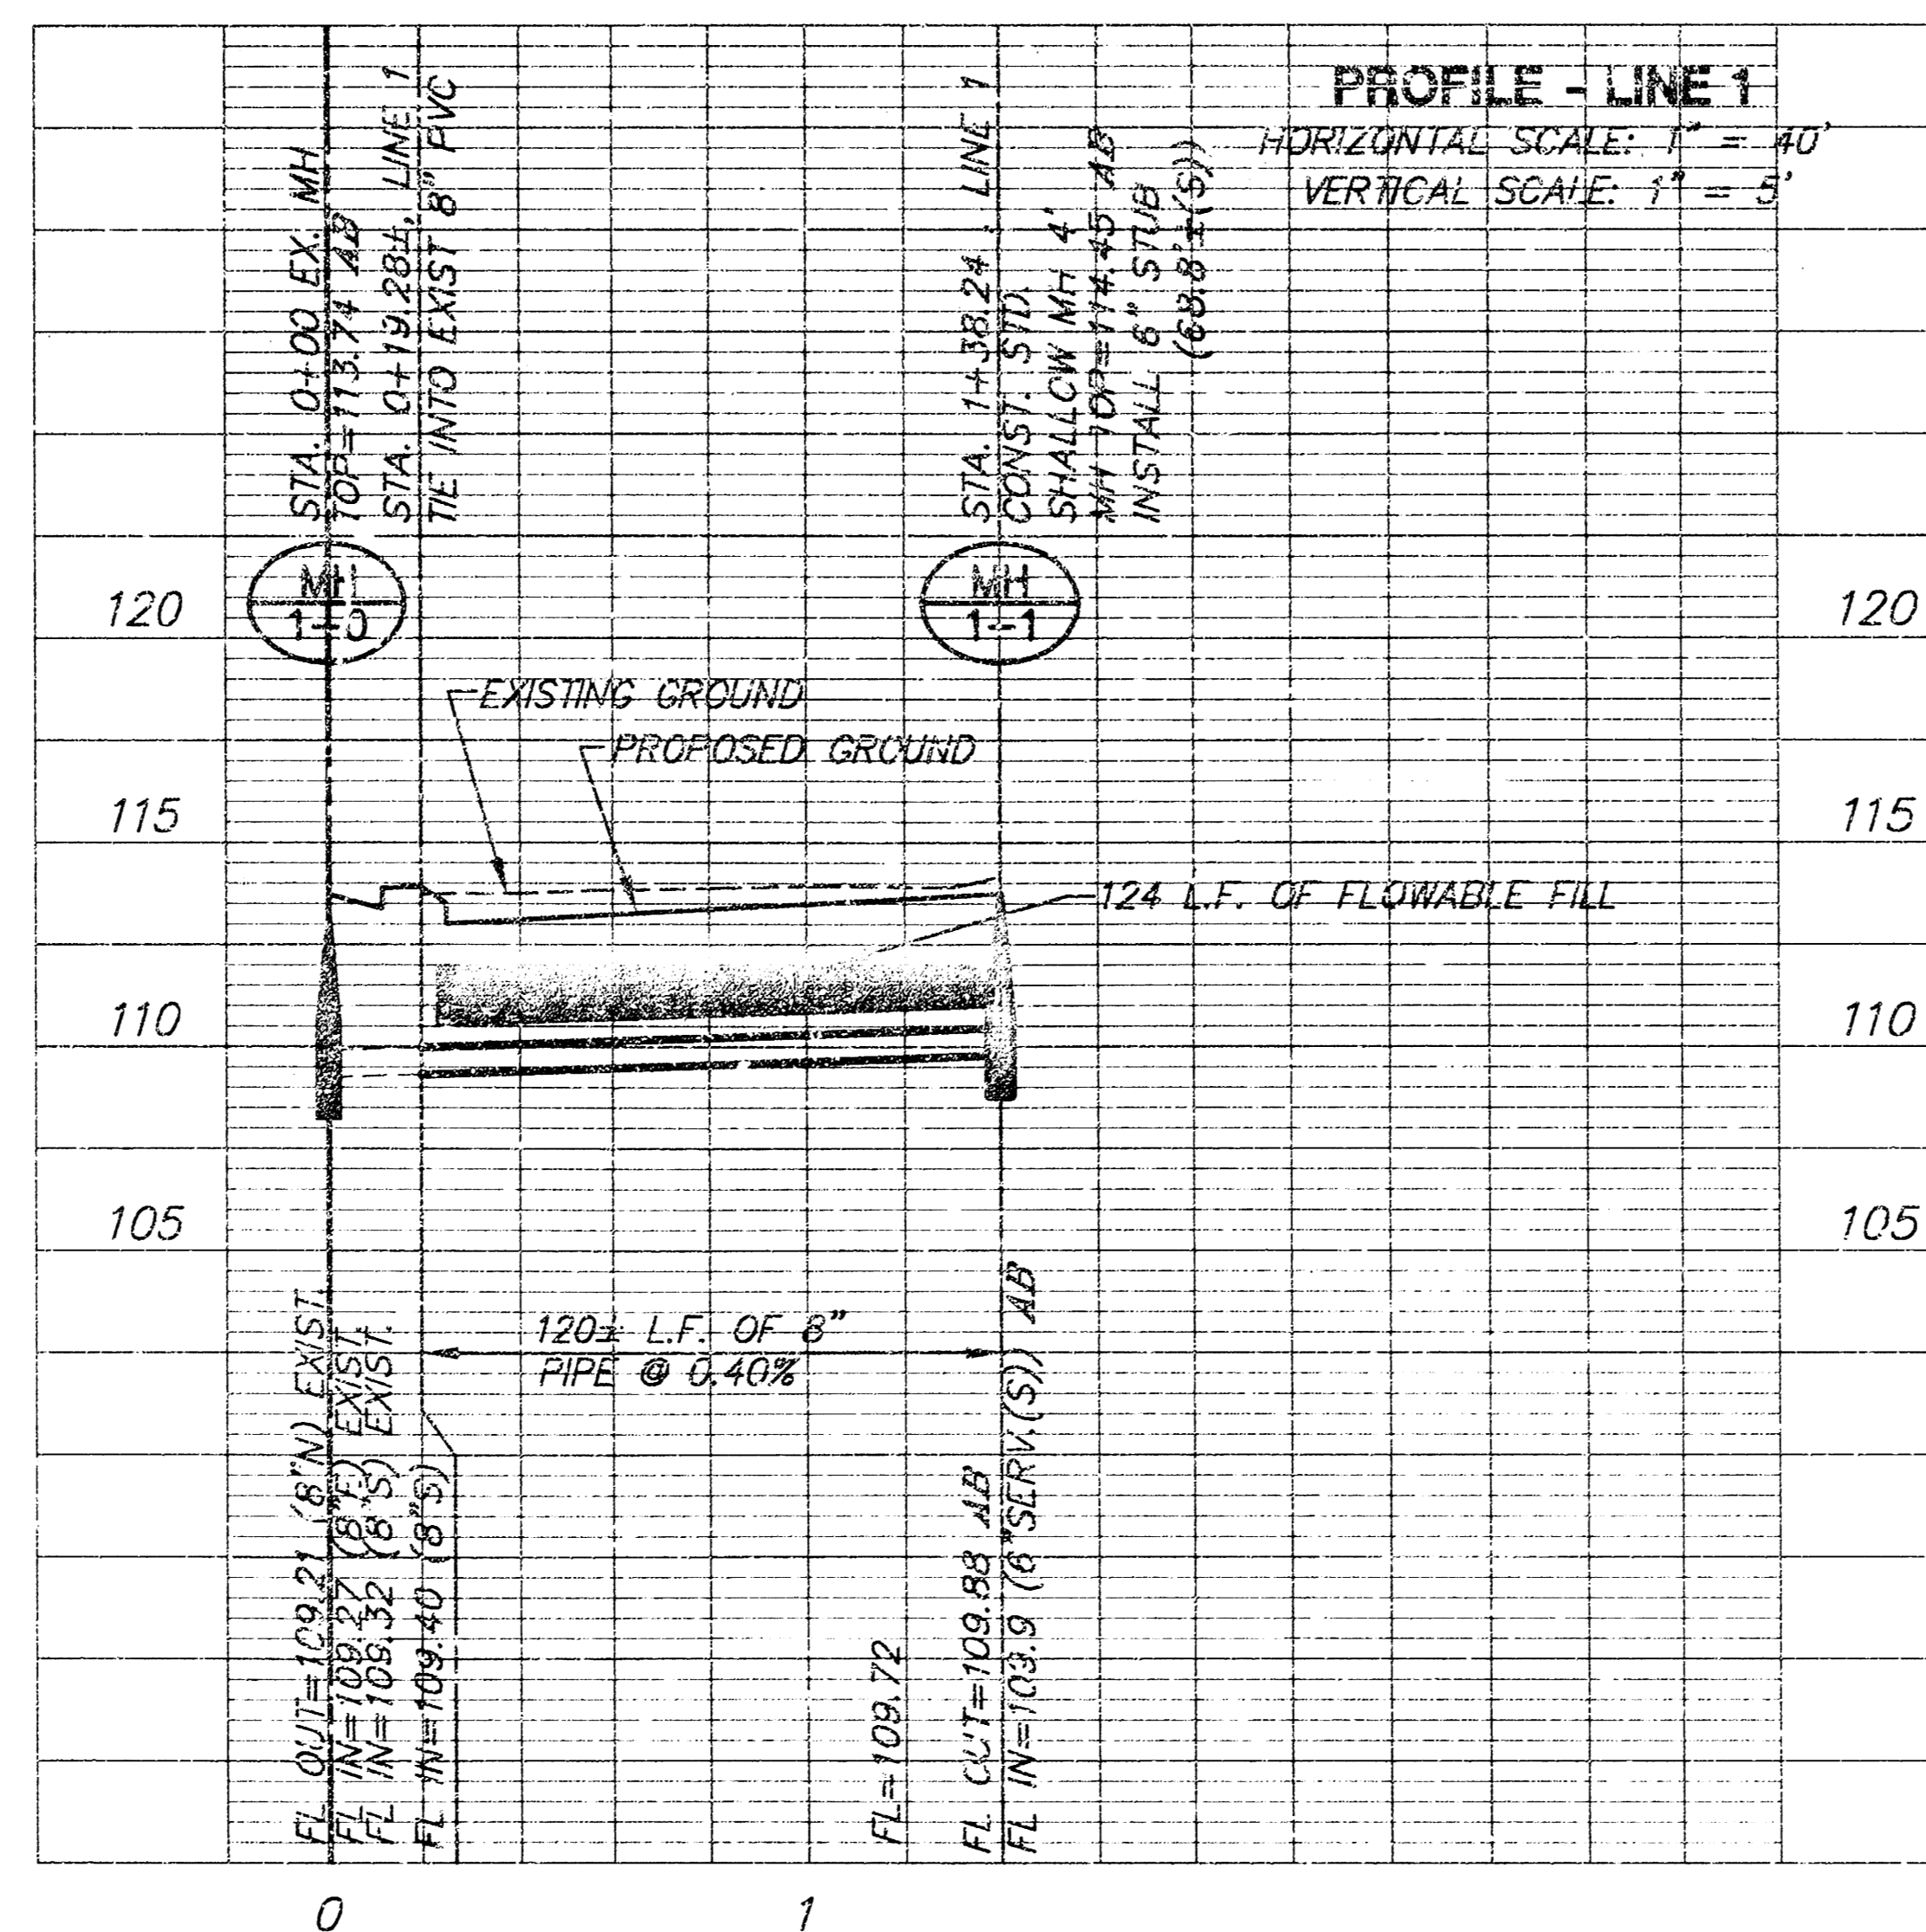


NOTE: SERVICE LINES TO BE INSTALLED BY OTHERS SUBJECT TO O.C.I. REVIEW.

NOTE: CONTRACTOR TO VERIFY DEPTH & LOCATION OF EXISTING UTILITIES PRIOR TO CONSTRUCTION.

NOTE: ABANDON 8" SEWER IN PLACE. REMOVE OBSERVATION HOLES & MANHOLES.


CP1	N8993.39	E10596.06
CP2	N8993.46	E10296.10
CP3	N9413.63	E10300.62
CP4	N9413.63	E10600.73
MH 1-0	N9432.91	E10450.62
MH 1-1	N9293.63	E10450.68

Mies Construction- Contractor
 Brian Lange, MKEC- Inspector
 As-Built: May, 2004
 Released: 11/9/04
 pdf by JCL 11/18/04

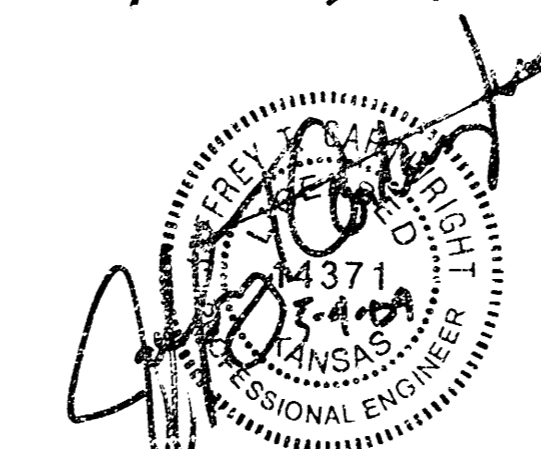

BENCHMARKS

- BM 1 113.86 "4" W SIDE OF POWER POLE ON BASE NE CORNER OF PINE & ST. FRANCIS
- BM 2 112.48 "1" T.C. W OF RETURN @ SW CORNER PINE & EMPORIA.
- BM 3 113.86 "4" E SIDE OF TRAFFIC SIGN BASE @ SE CORNER OF MURDOCK & TOPEKA

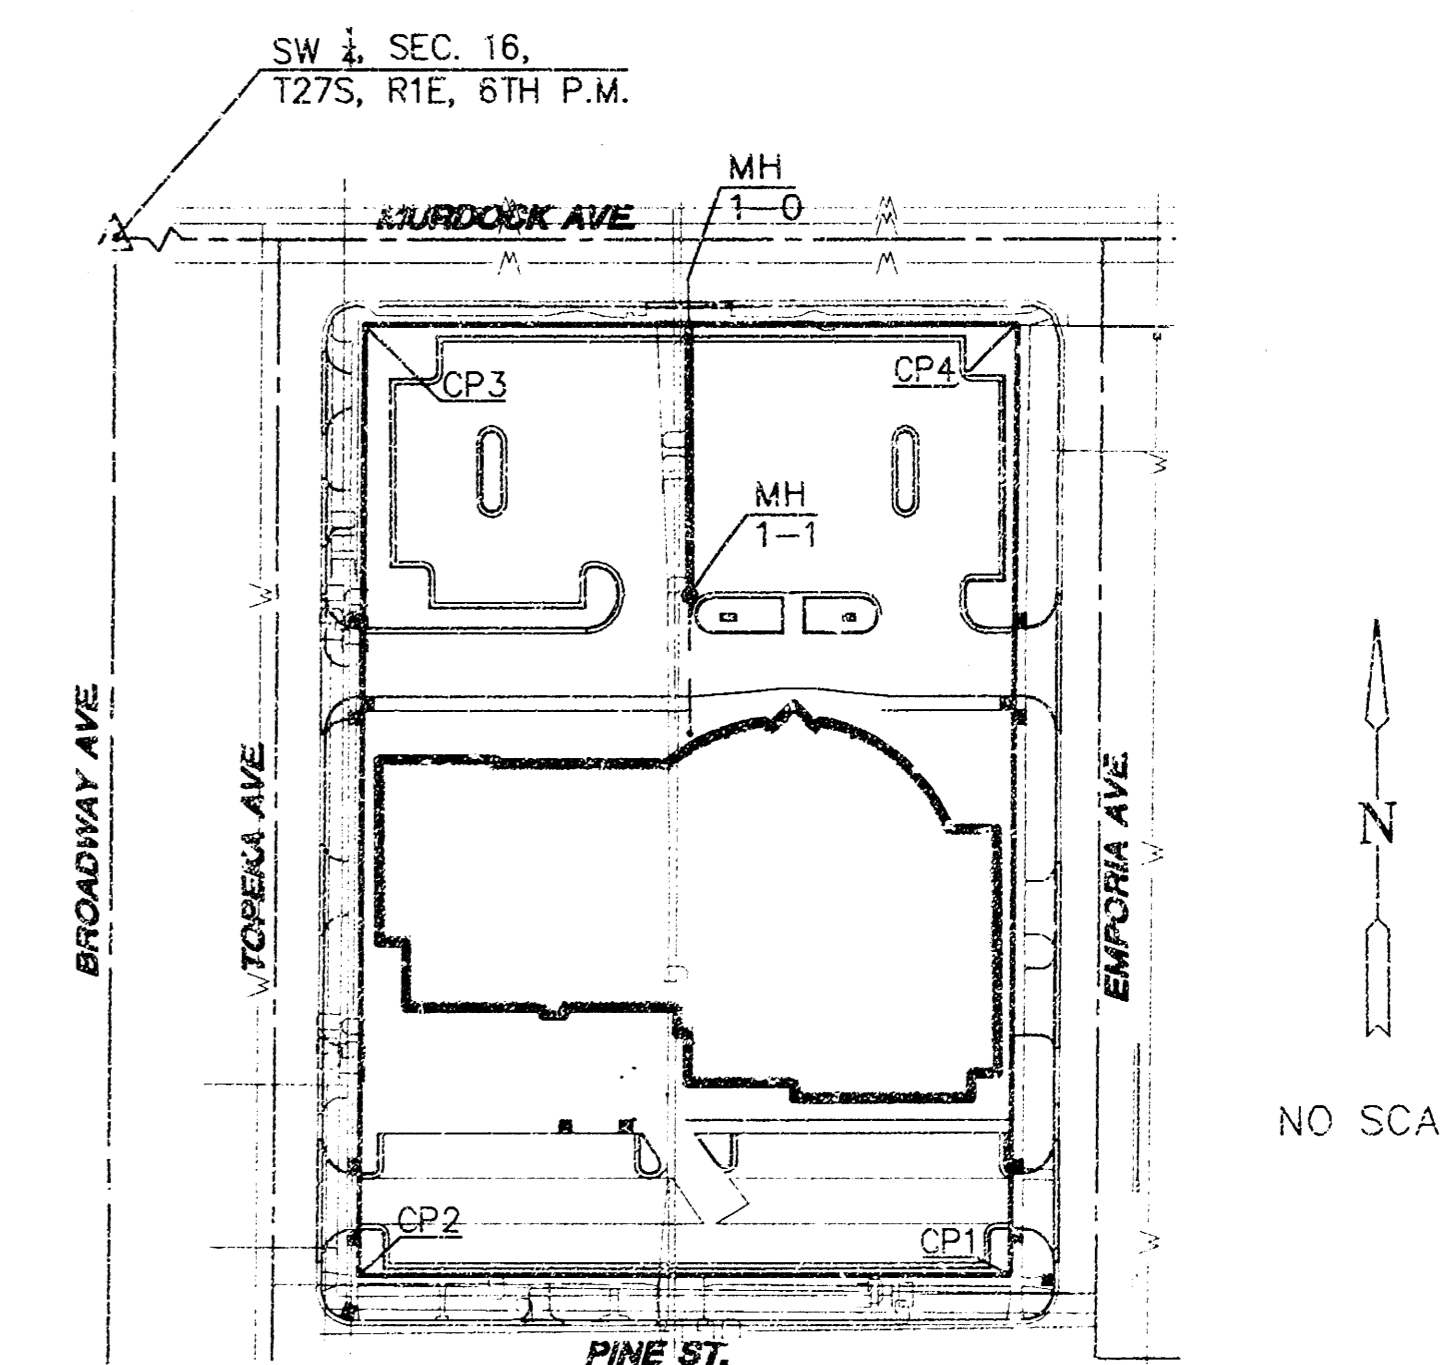

NO SCALE

AS-BUILT MAY 2004

MKEC
 ENGINEERING CONSULTANTS
 411 N. WEBB ROAD
 WICHITA, KS. 67206
 316-684-9600

SANITARY SEWER & STORM WATER SEWER TO SERVE LOT 1, BLK 1 VIA CHRISTI FAMILY PRACTICE ADDITION
 PROJECT NAME
SANITARY SEWER PLANS
 SHEET TITLE

JTC DESIGN BY:	DAC DRAWN BY:	JTC CHECKED BY:
AUGUST 2003 DATE	03186 JOB NO.	1 / 7 SHEET/OF

LOT 1, BLK 1, VIA CHRISTI
FAMILY PRACTICE ADDITION
SANITARY SEWER & SWS
1364PPS (607861)

STA. 0+00, LINE 1
REMOVE & REPLACE EX. INLET
CONST. STD. TYPE 1 CURB INLET
(5' X 3'). TIE INTO EX. 12" PIPE
INLET TOP=113.28 AB
INSTALL PAVEMENT UNDERDRAIN
N8974.59±, E10298.41±

STA. 0+00, LINE 2
REMOVE & REPLACE EX. INLET
CONST. STD. TYPE 1 CURB INLET
(5' X 3'). TIE INTO EX. 8" PIPE
INLET TOP=112.37 AB
INSTALL PAVEMENT UNDERDRAIN
N8979.43±, E10610.52±


STA. 0+33.9, LINE 4
CONST. STD. TYPE 1 CURB INLET
(5' X 3'). INLET TOP=112.60 AB
INSTALL PAVEMENT UNDERDRAIN
N9390.88, E10315.14
N9390.88, E10315.23 AB

STA. 0+26.0, LINE 1
CONST. STD. TYPE 1 CURB INLET
(5' X 3'). INLET TOP=113.30 AB
INSTALL PAVEMENT UNDERDRAIN
N8999.13±, E10306.23±
N8999.00, E10305.77 AB

STA. 0+30.1, LINE 2
CONST. STD. TYPE 1 CURB INLET
(5' X 3'). INLET TOP=113.00 AB
INSTALL PAVEMENT UNDERDRAIN
N8999.06±, E10588.23±
N8999.05, E10588.58 AB

STA. 0+00, LINE 3
CONNECT INTO EXIST.
INLET. RESHAPE INVERT
AS REQ'D.
EX. TOP=113.08
N9422.37, E10599.71

STA. 0+00, LINE 4
CONNECT INTO EXIST.
INLET. RESHAPE INVERT
AS REQ'D.
EX. TOP=113.10
N9422.32, E10303.73

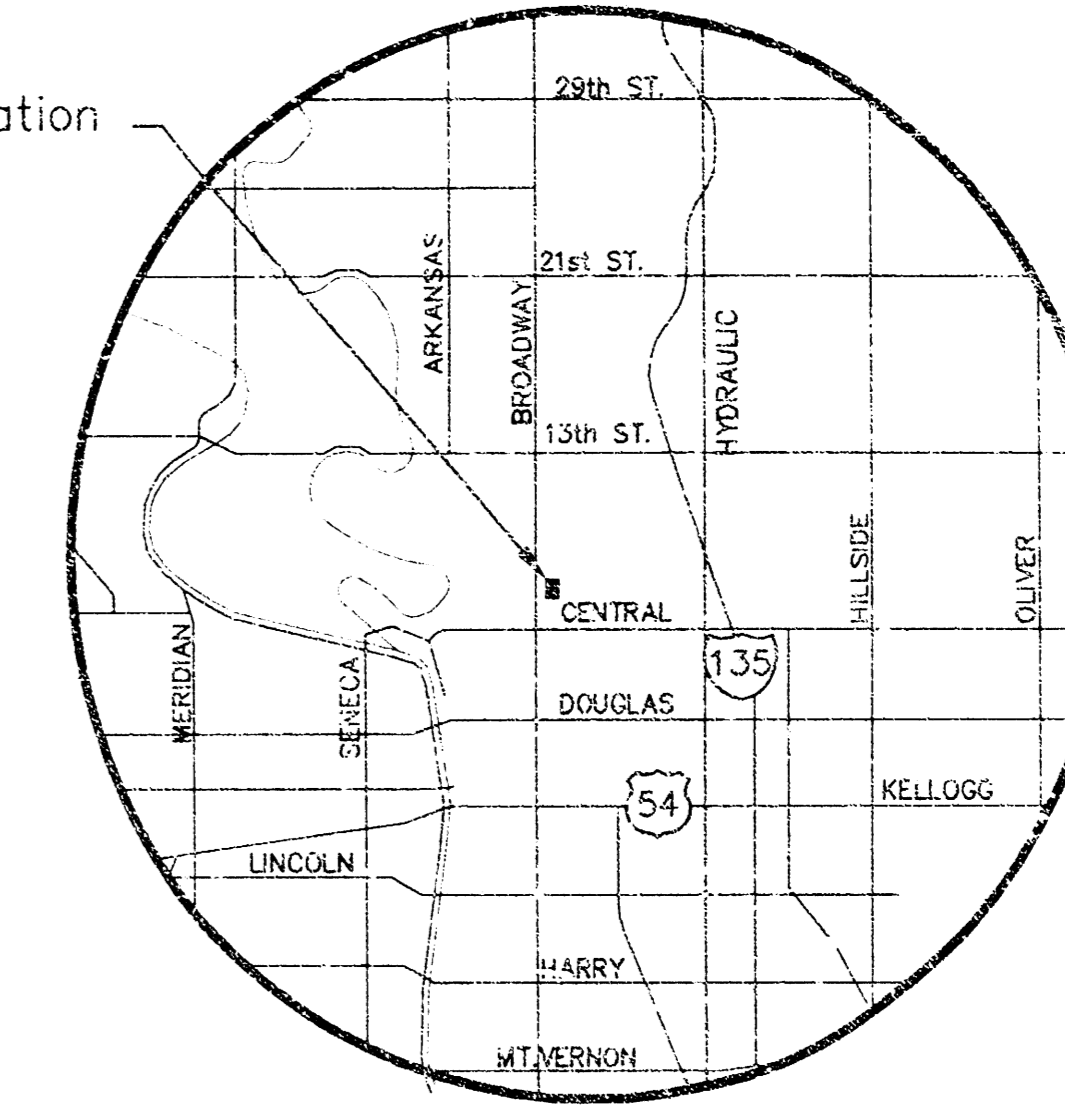

LOCATION MAP

PLAN LINE 1

SCALE: 1"=20'

PLAN LINE 2

SCALE: 1"=20'

PLAN LINE 3

SCALE: 1"=20'

PLAN LINE 4

SCALE: 1"=20'


NOTE: SERVICE LINES
TO BE INSTALLED BY
OTHERS SUBJECT TO
O.C.I. REVIEW.

NOTE: CONTRACTOR
TO VERIFY DEPTH &
LOCATION OF EXISTING
UTILITIES PRIOR TO
CONSTRUCTION.


NOTE: CONTRACTOR
TO COORDINATE
REPLACEMENT OF
PAVEMENT/SIDEWALK
IN STREET R.O.W.
W/CITY OF WICHITA

BENCHMARKS

- BM 1 113.86 "+ " W SIDE OF POWER POLE ON
BASE NE CORNER OF PINE & ST. FRANCIS
- BM 2 112.48 "T" I.C. W OF RETURN @ SW
CORNER PINE & EMPORIA.
- BM 3 113.86 "+ " E SIDE OF TRAFFIC SIGN BASE
@ SE CORNER OF MURDOCK & TOPEKA

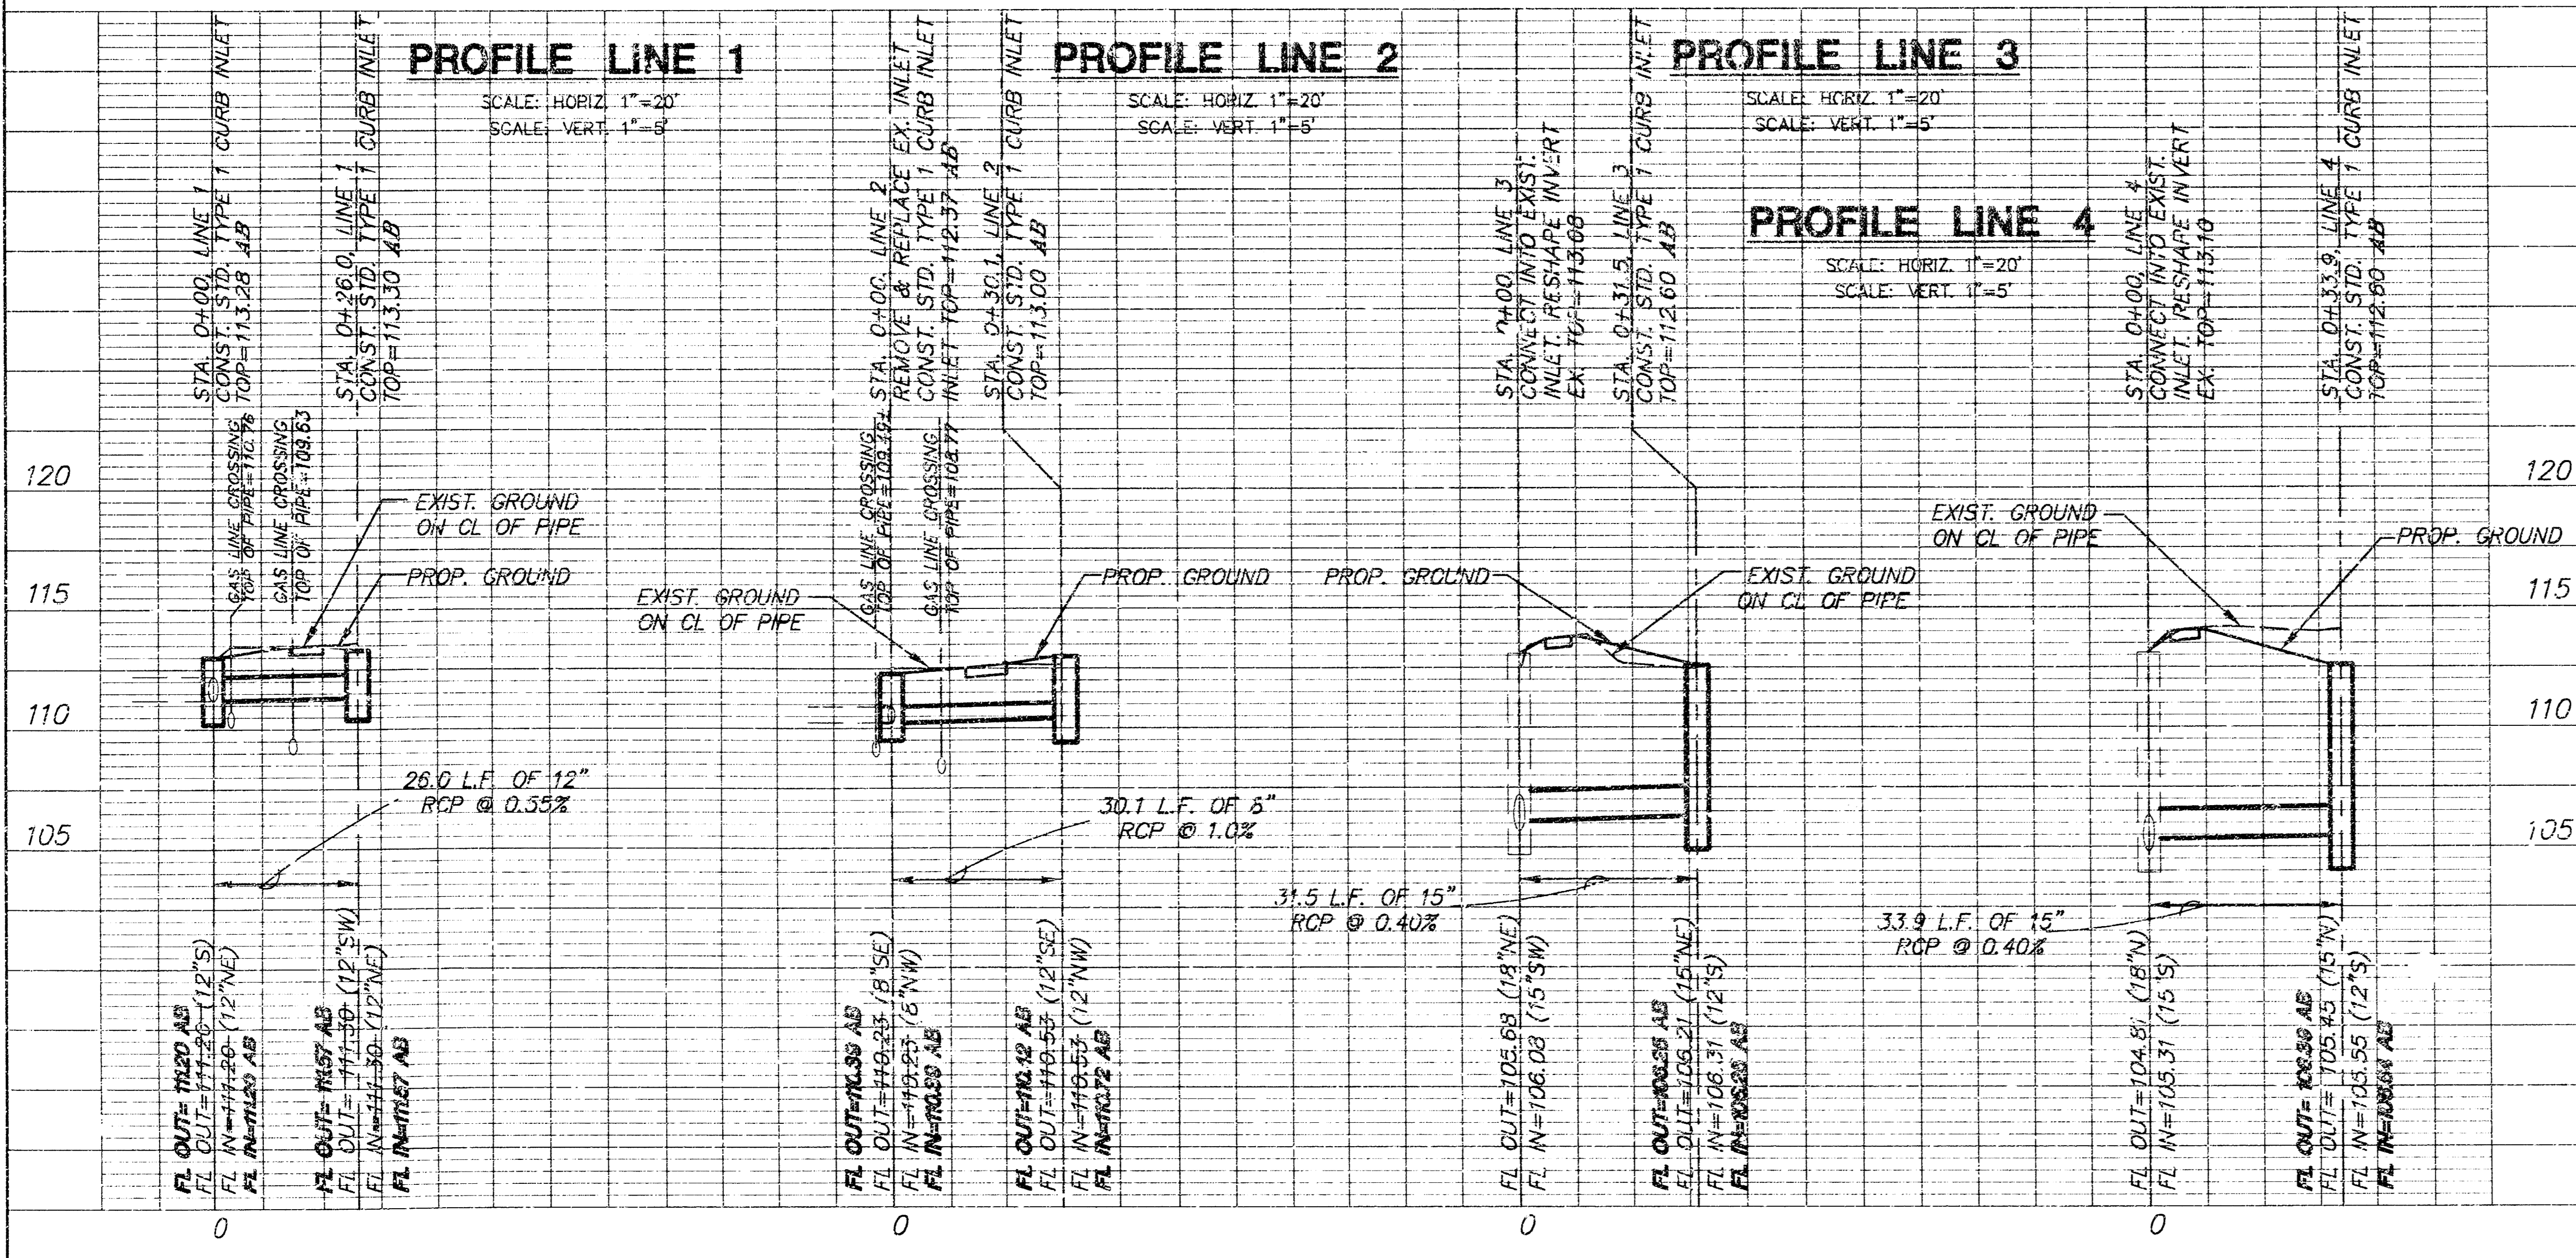

CP1	N8993.39	E10596.06
CP2	N8993.46	E10296.10
CP3	N9413.63	E10300.62
CP4	N9413.63	E10600.73
INL#1	N8974.59±	E10298.41±
INL#2	N8999.13	E10306.23±
INL#3	N8979.43±	E10610.52±
INL#4	N8999.06	E10588.23±
INL#5	N9392.09	E10591.51±
INL#6	N9390.88	E10315.14

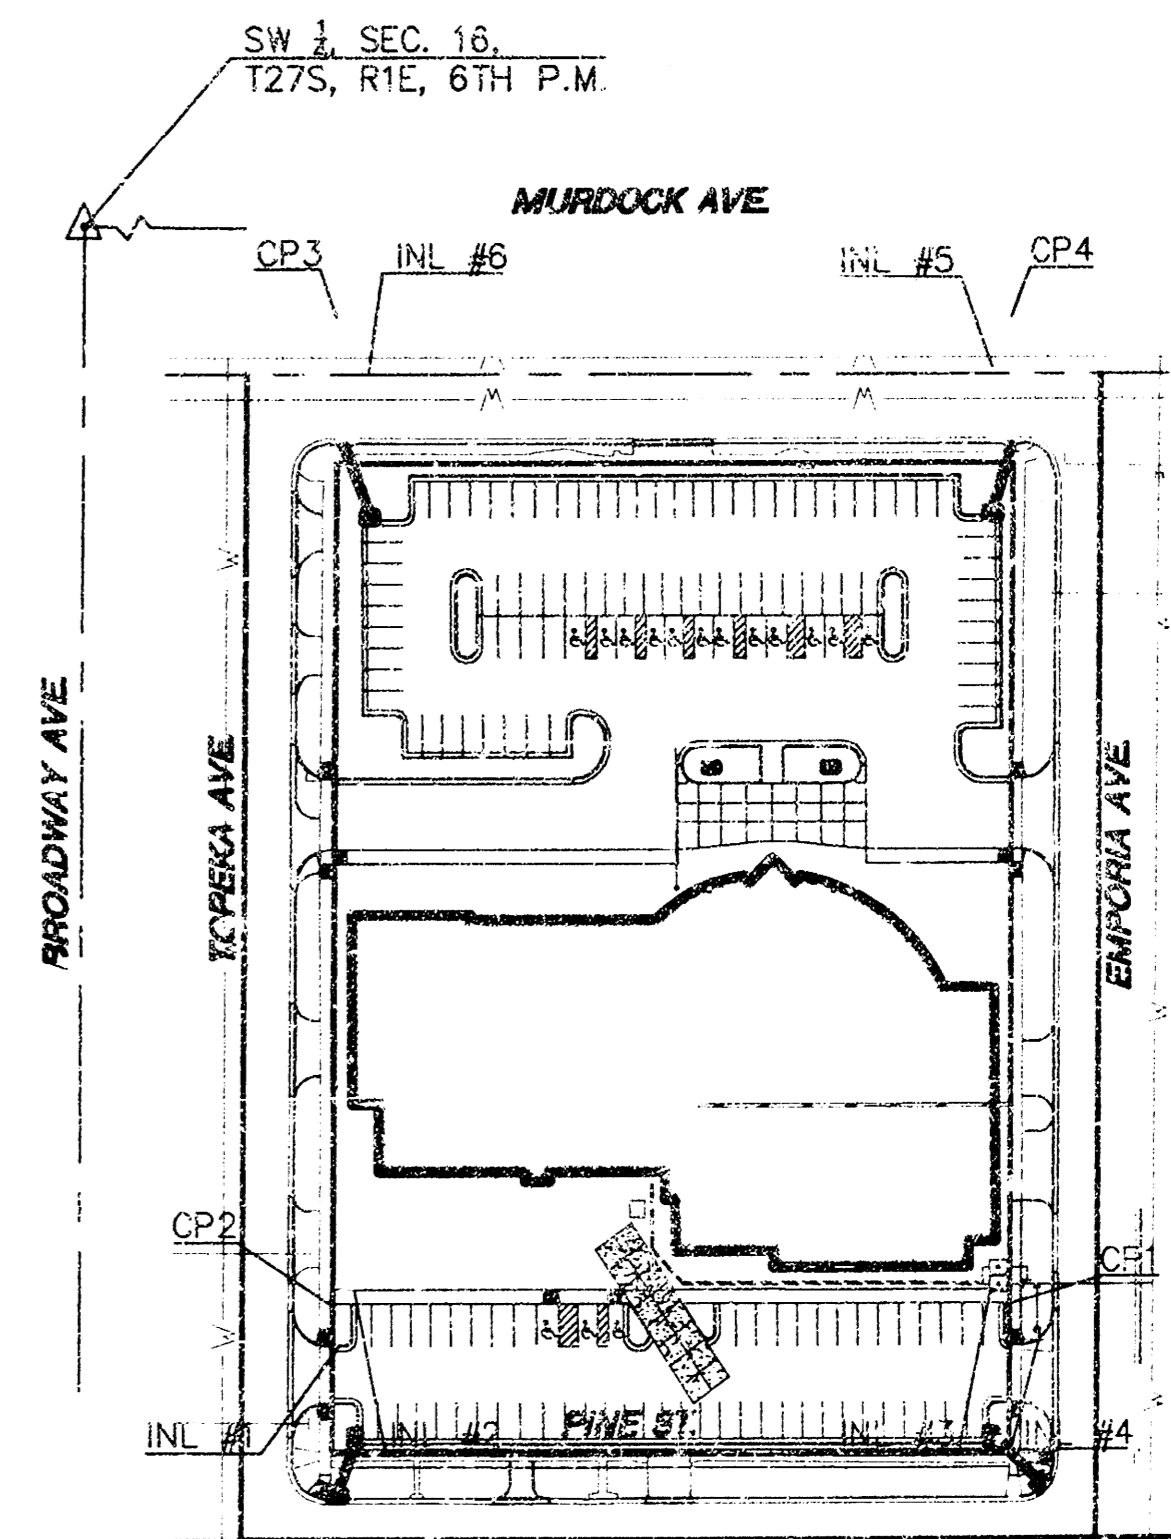

NO SCALE




AS-BUILT MAY 2004


MKEC ENGINEERING CONSULTANTS
411 N. WEBB ROAD
WICHITA, KS. 67206
316-684-9600

SANITARY SEWER & STORM WATER SEWER TO SERVE LOT 1, BLK 1, VIA CHRISTI FAMILY PRACTICE ADDITION
PROJECT NAME
STORM SEWER PLANS
SHEET TITLE


JTC DESIGN BY: DAC DRAWN BY: JTC CHECKED BY:
AUGUST 2003 DATE: 03186 JOB NO.: 2 / 7 SHEET/OF

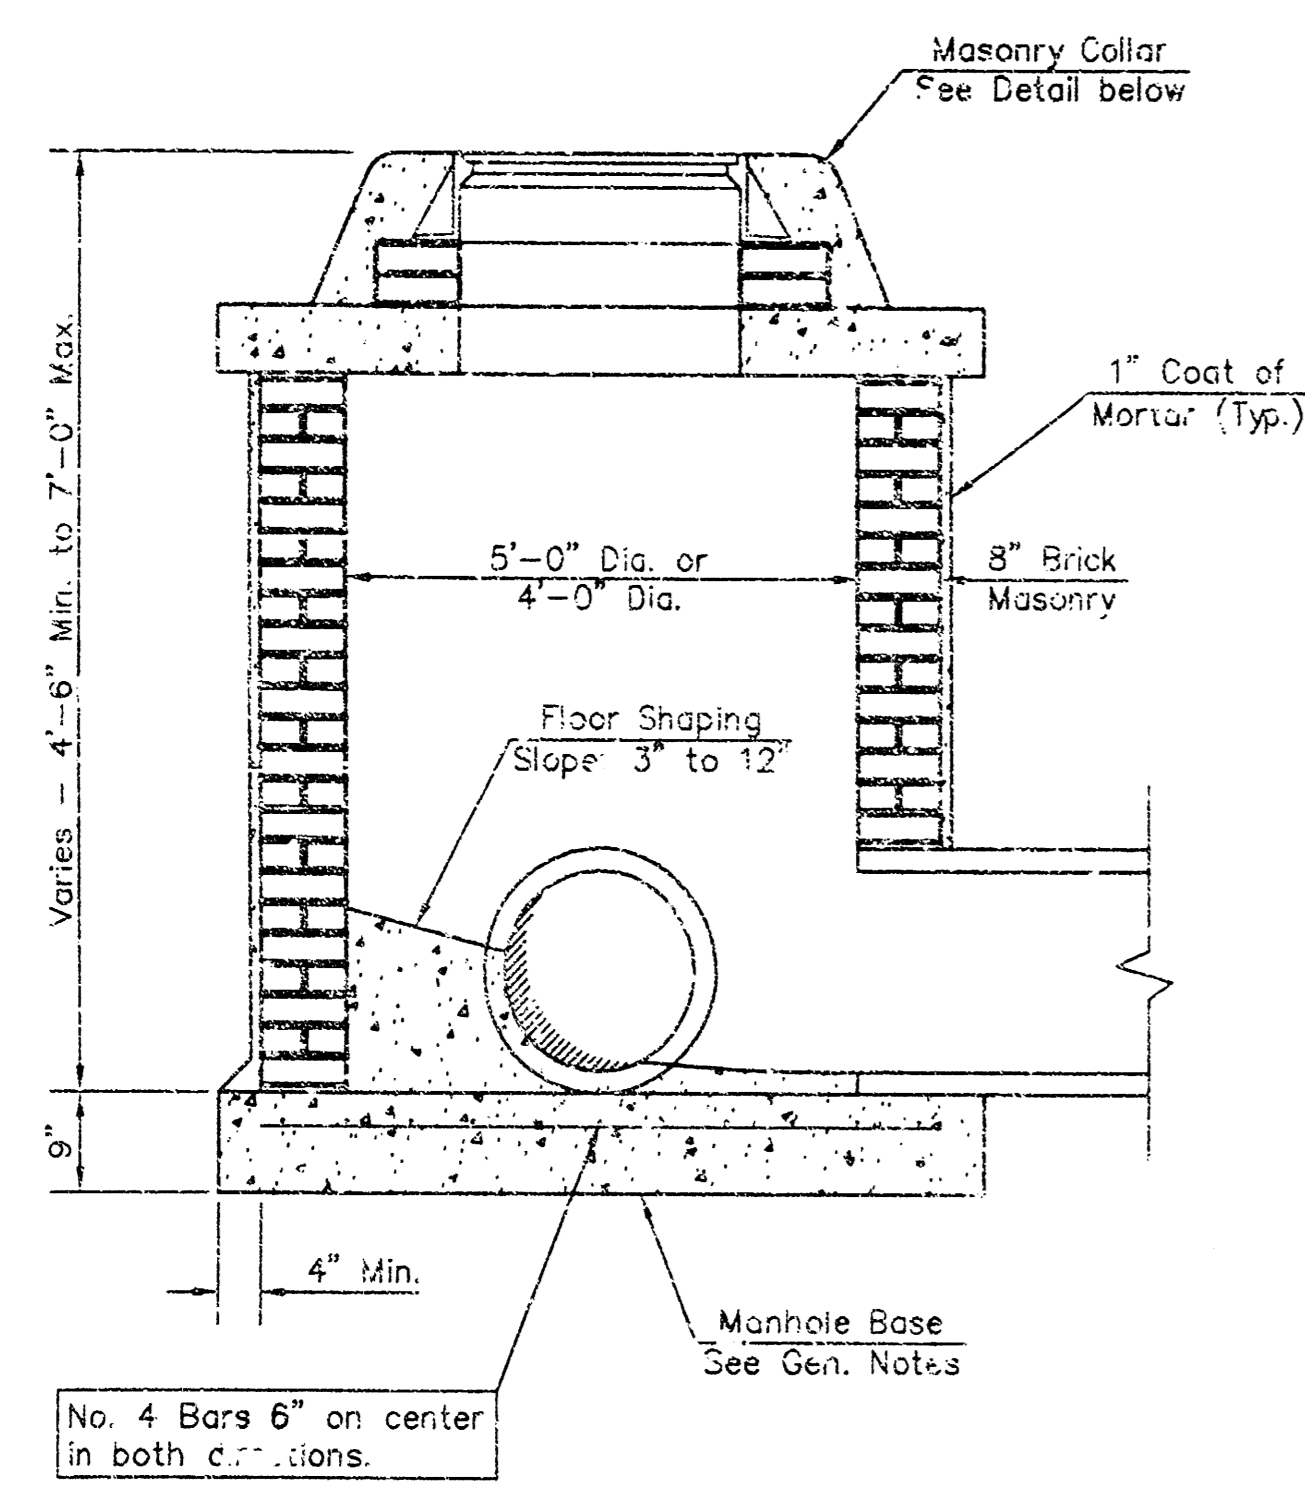


SHALLOW TYPE "A" MANHOLE

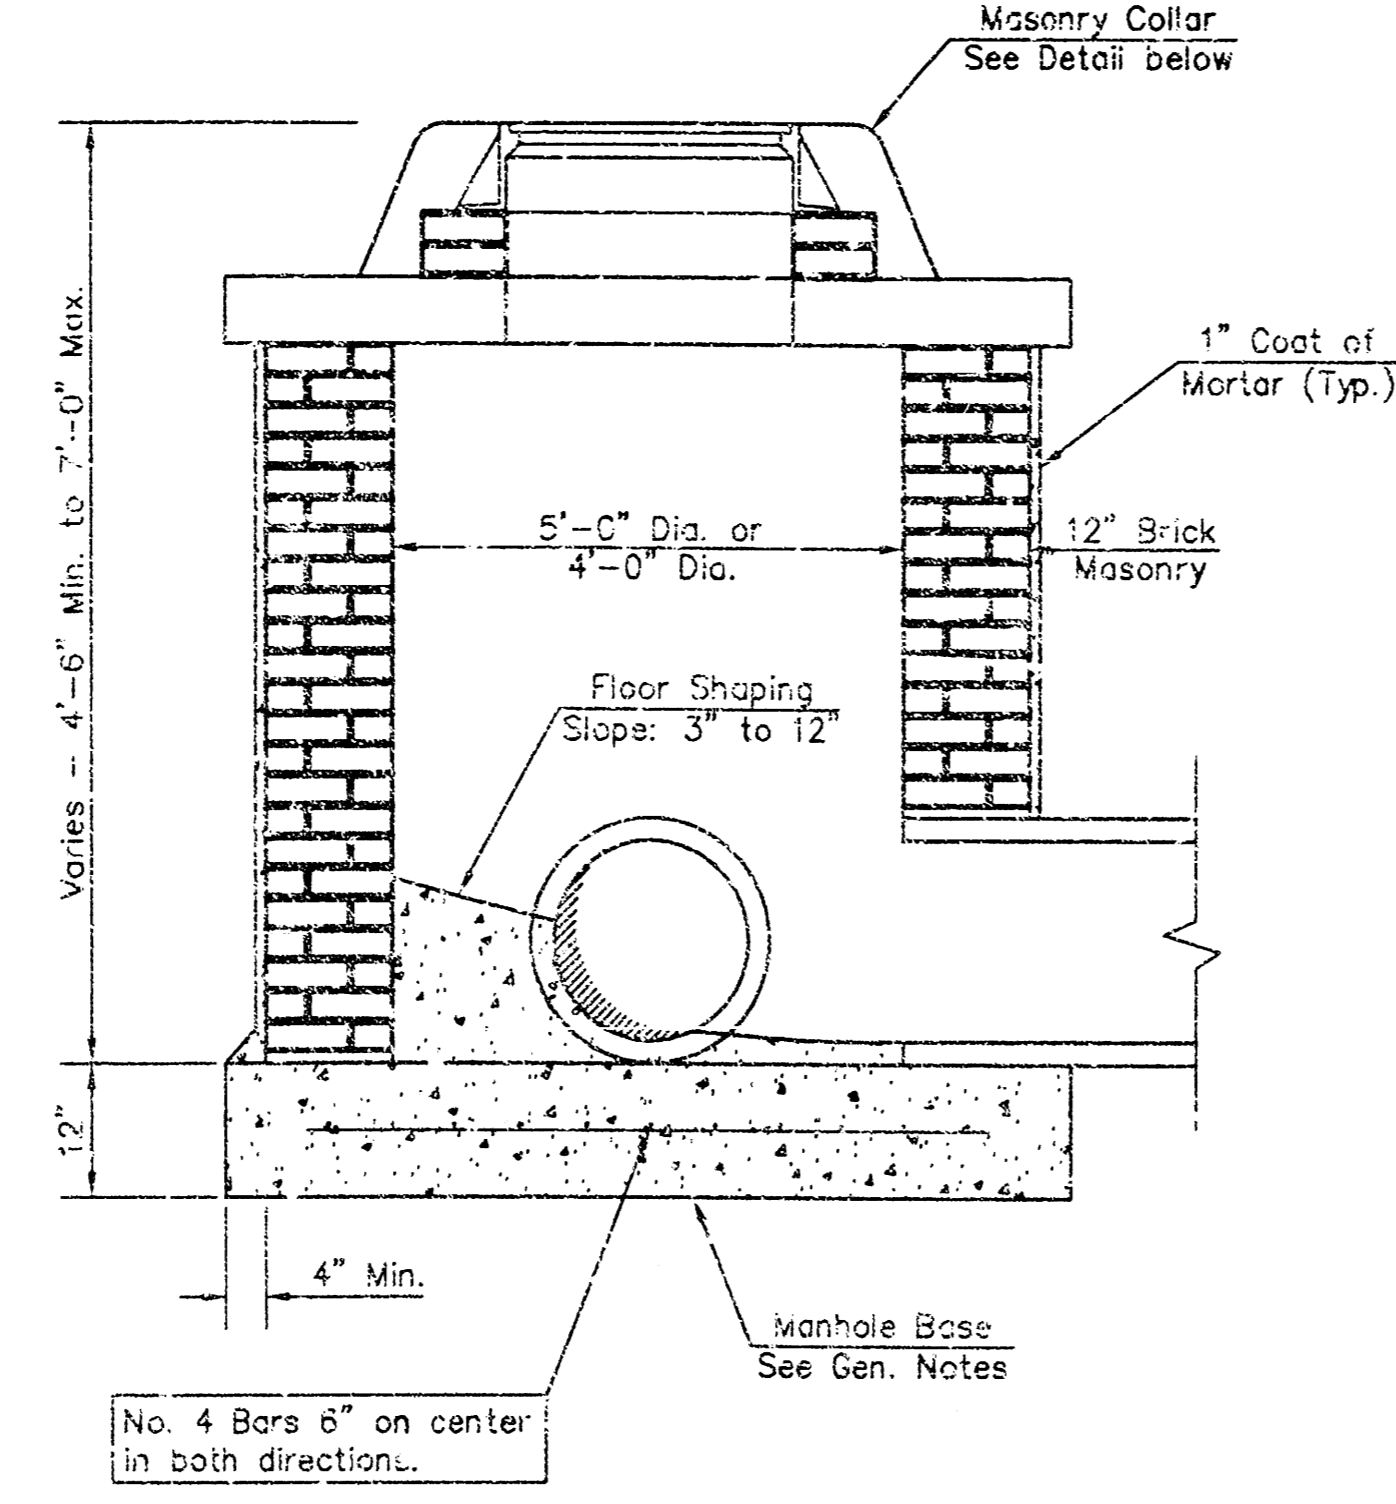


SHALLOW TYPE "B" MANHOLE

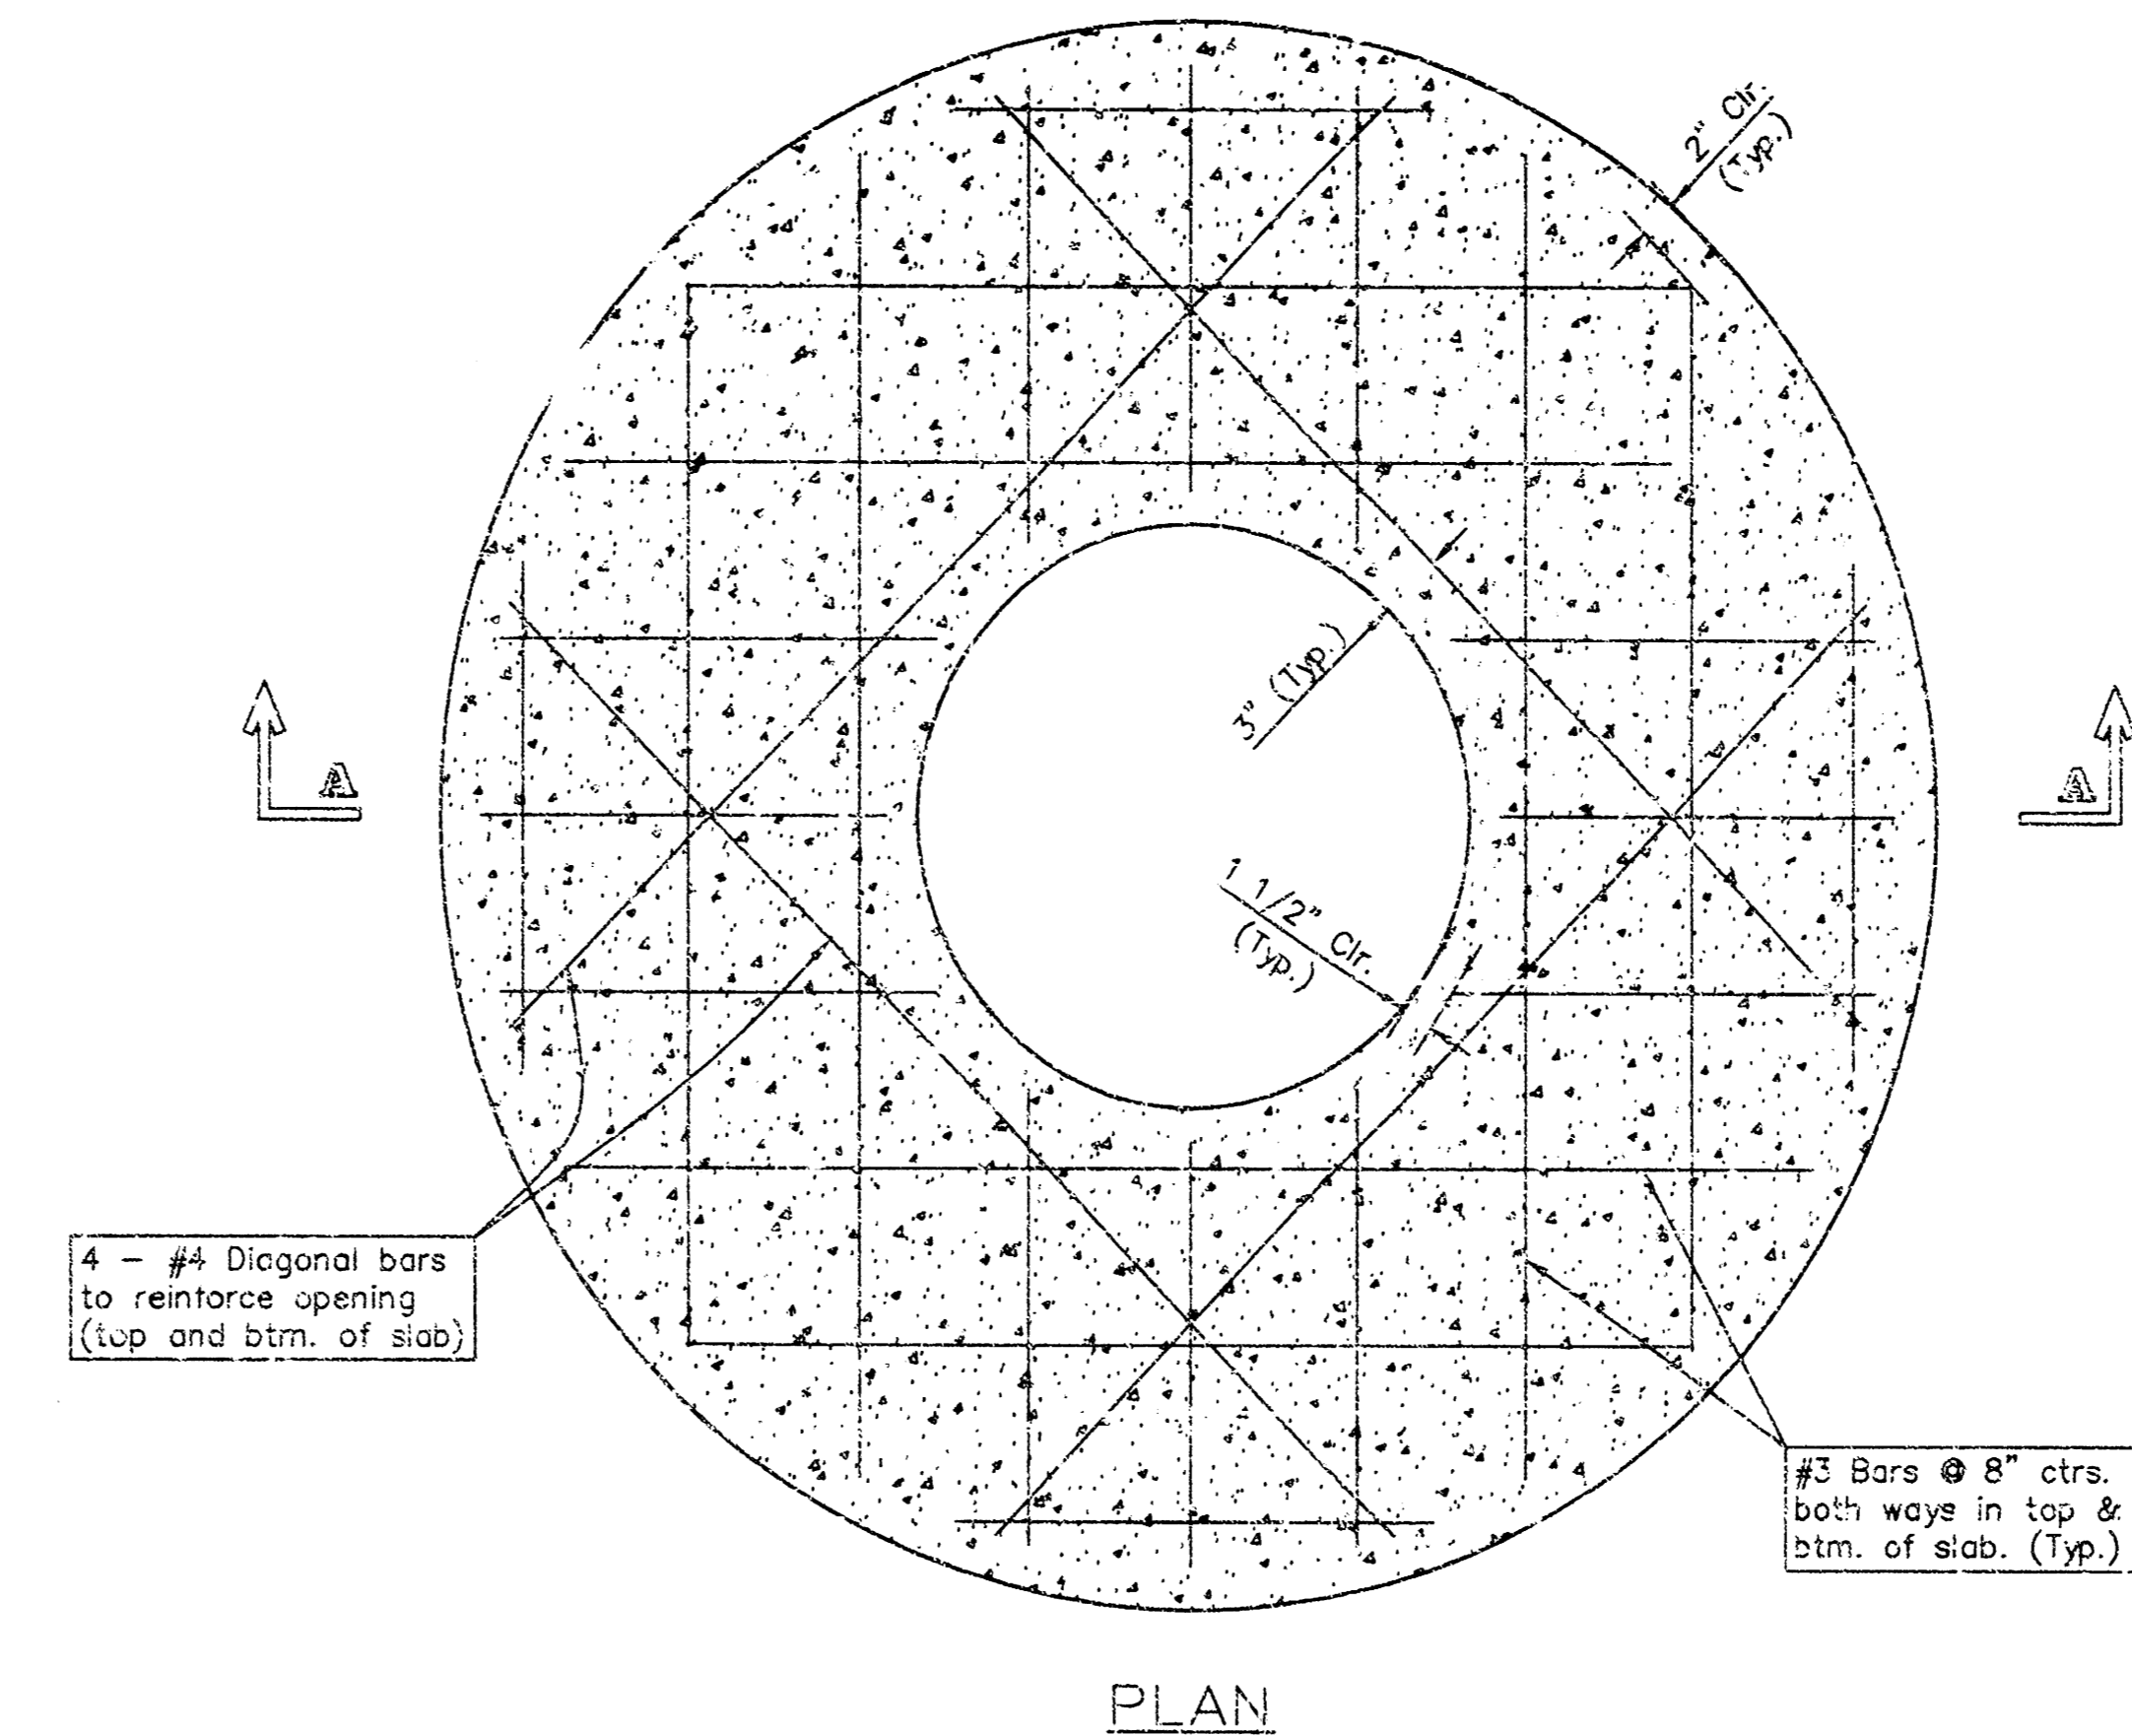


PLAN

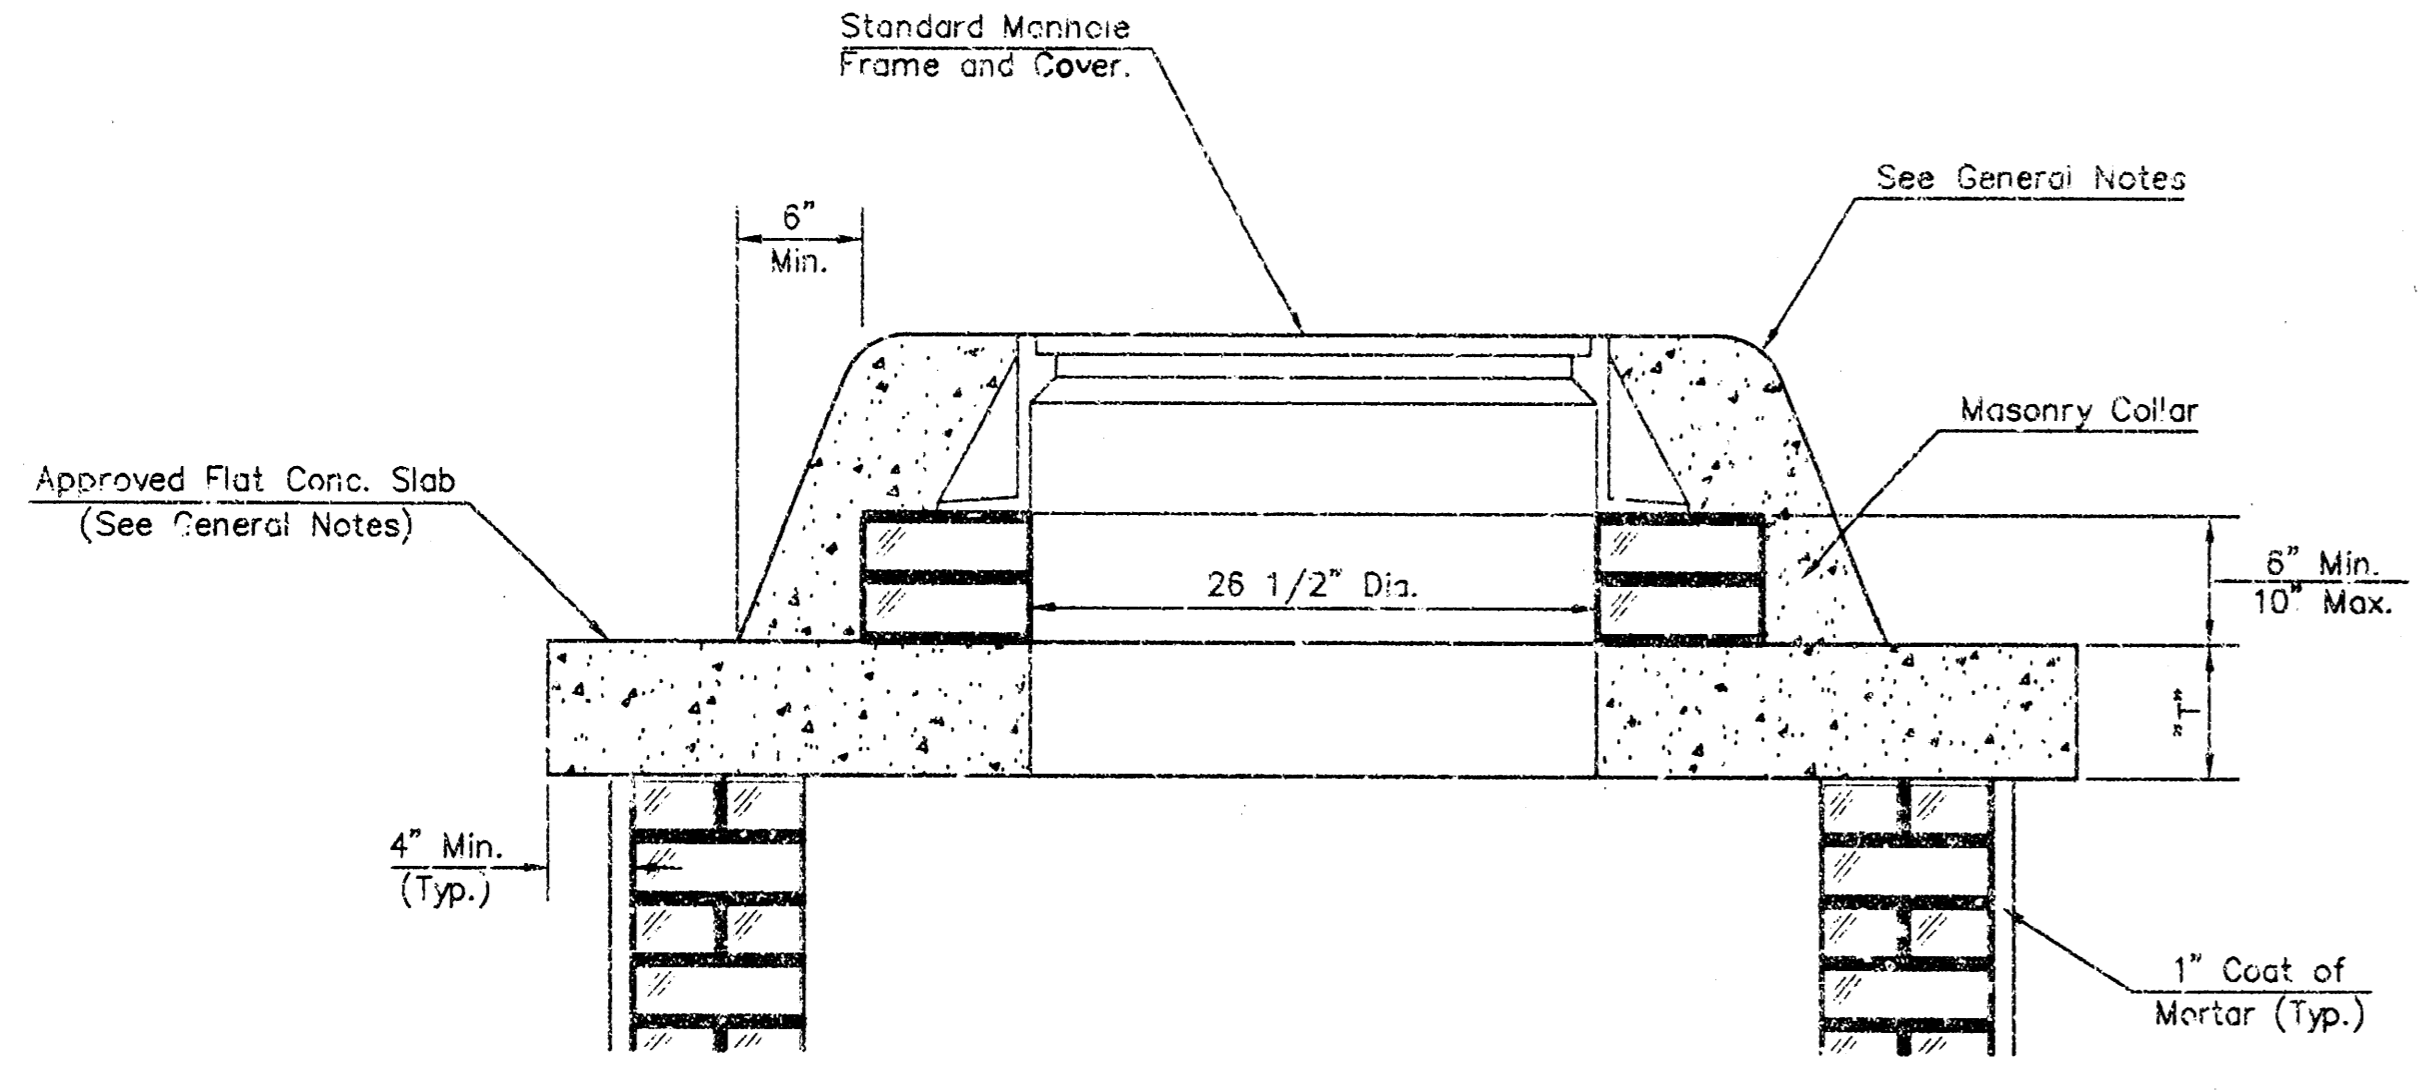


MASONRY COLLAR DETAIL

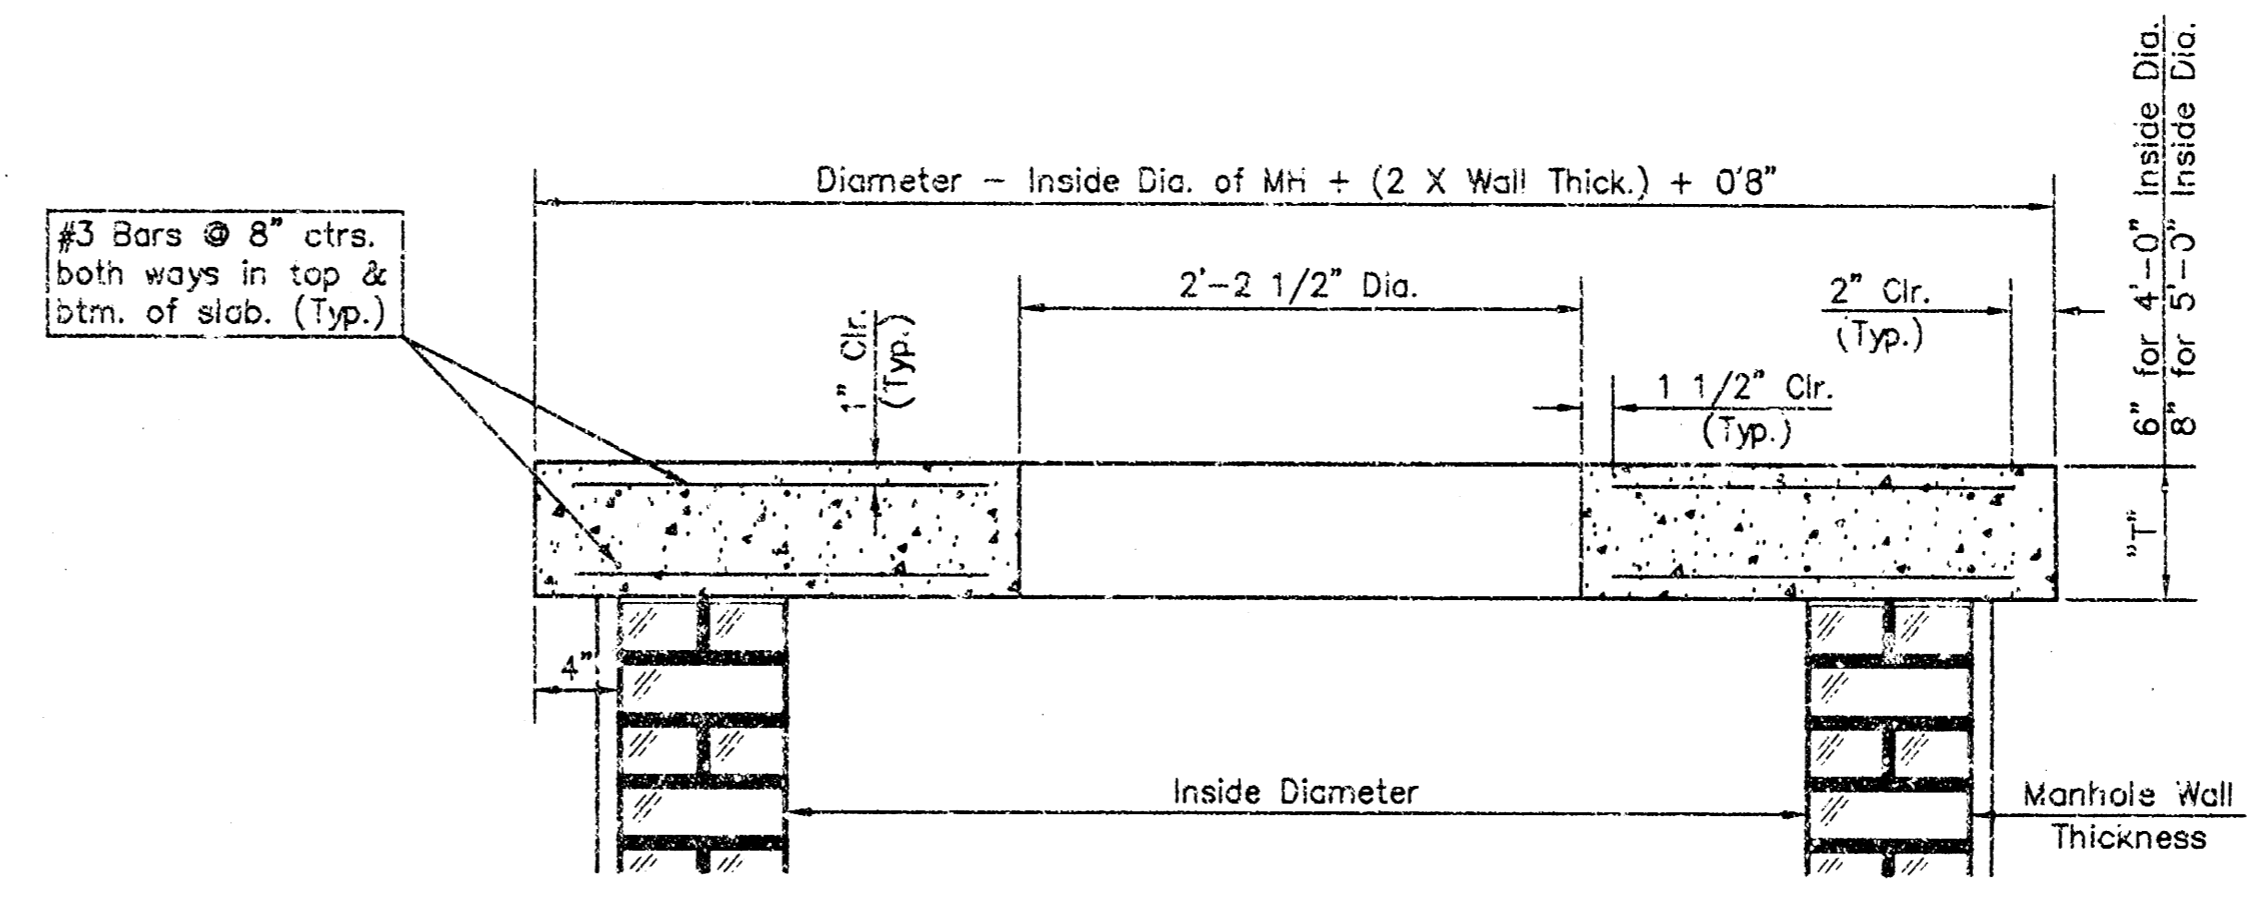

SECTION A-A
FLAT CONCRETE SLAB DETAILS

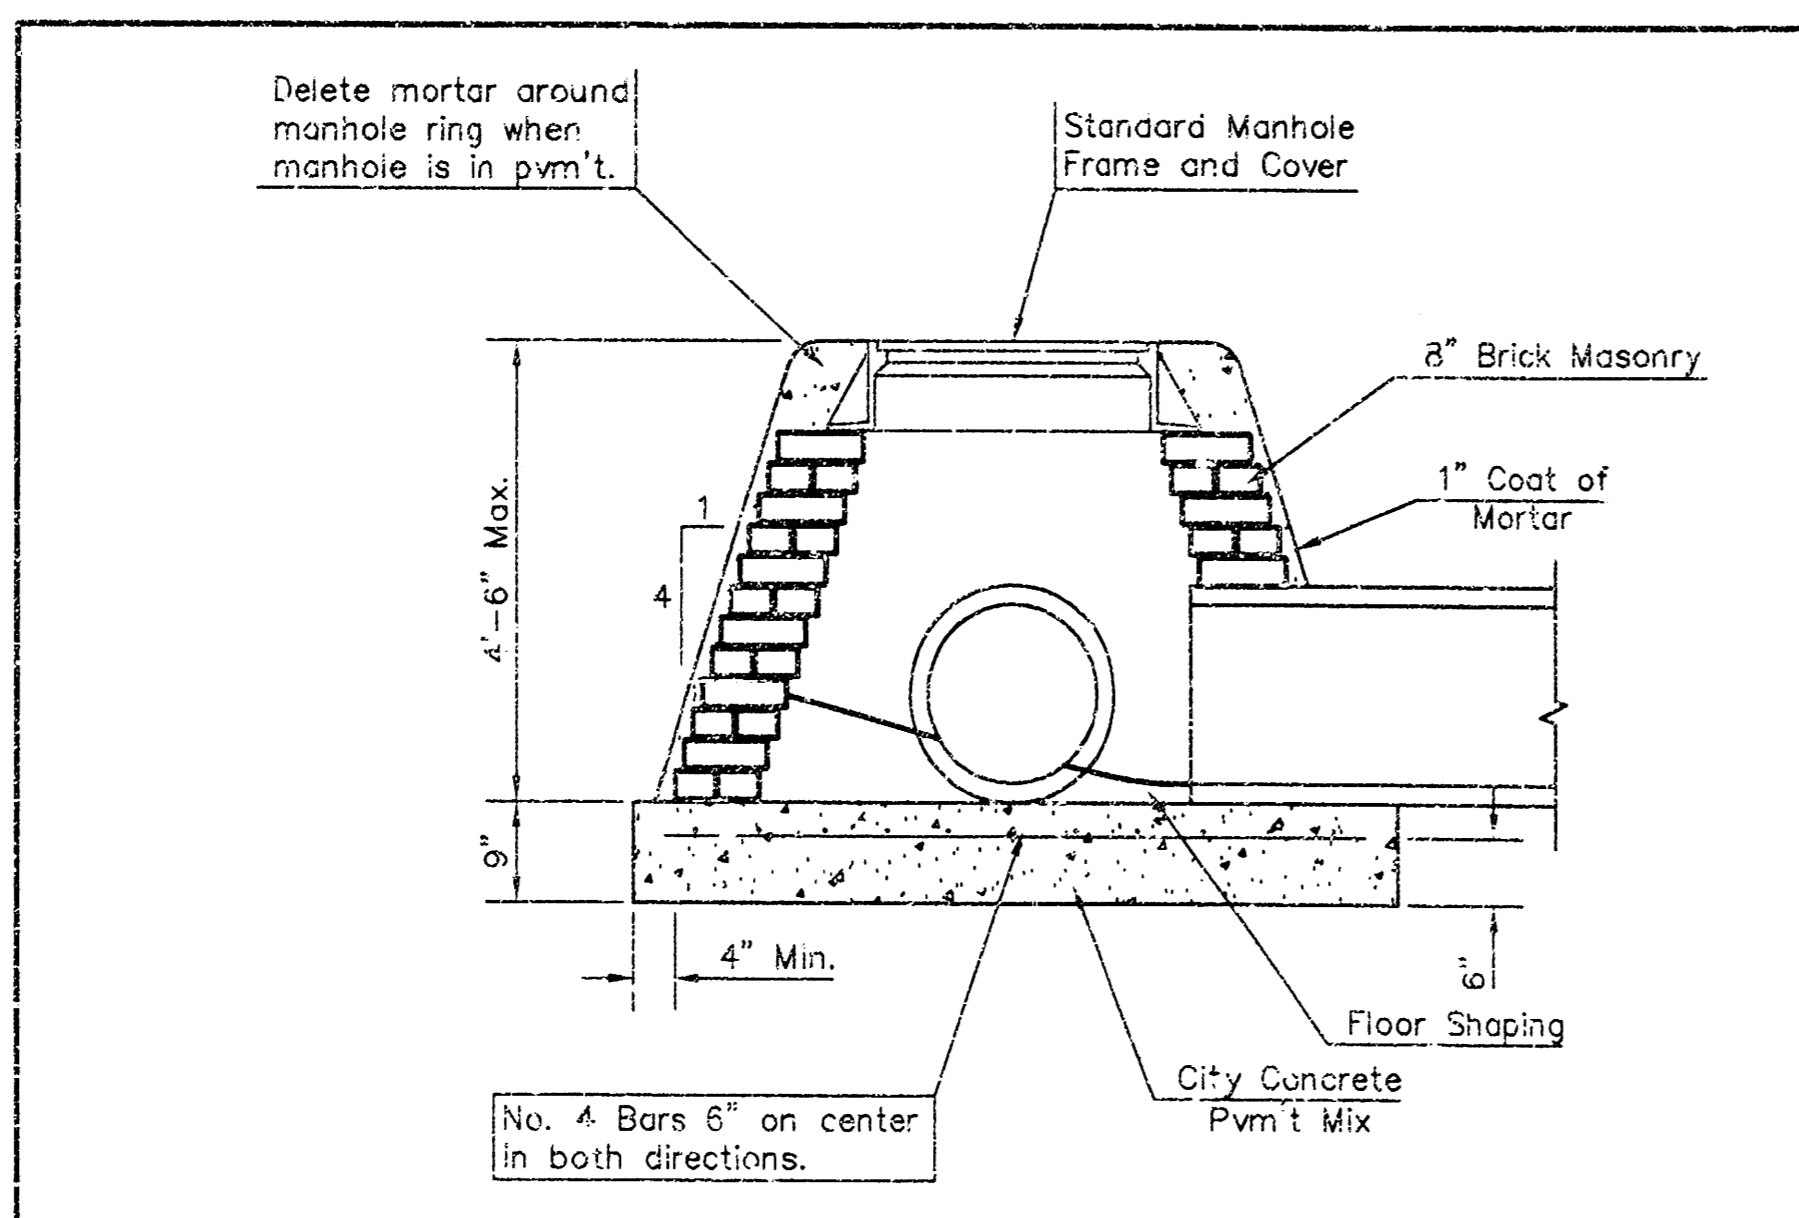

SPECIAL SHALLOW TYPE "A" MANHOLE

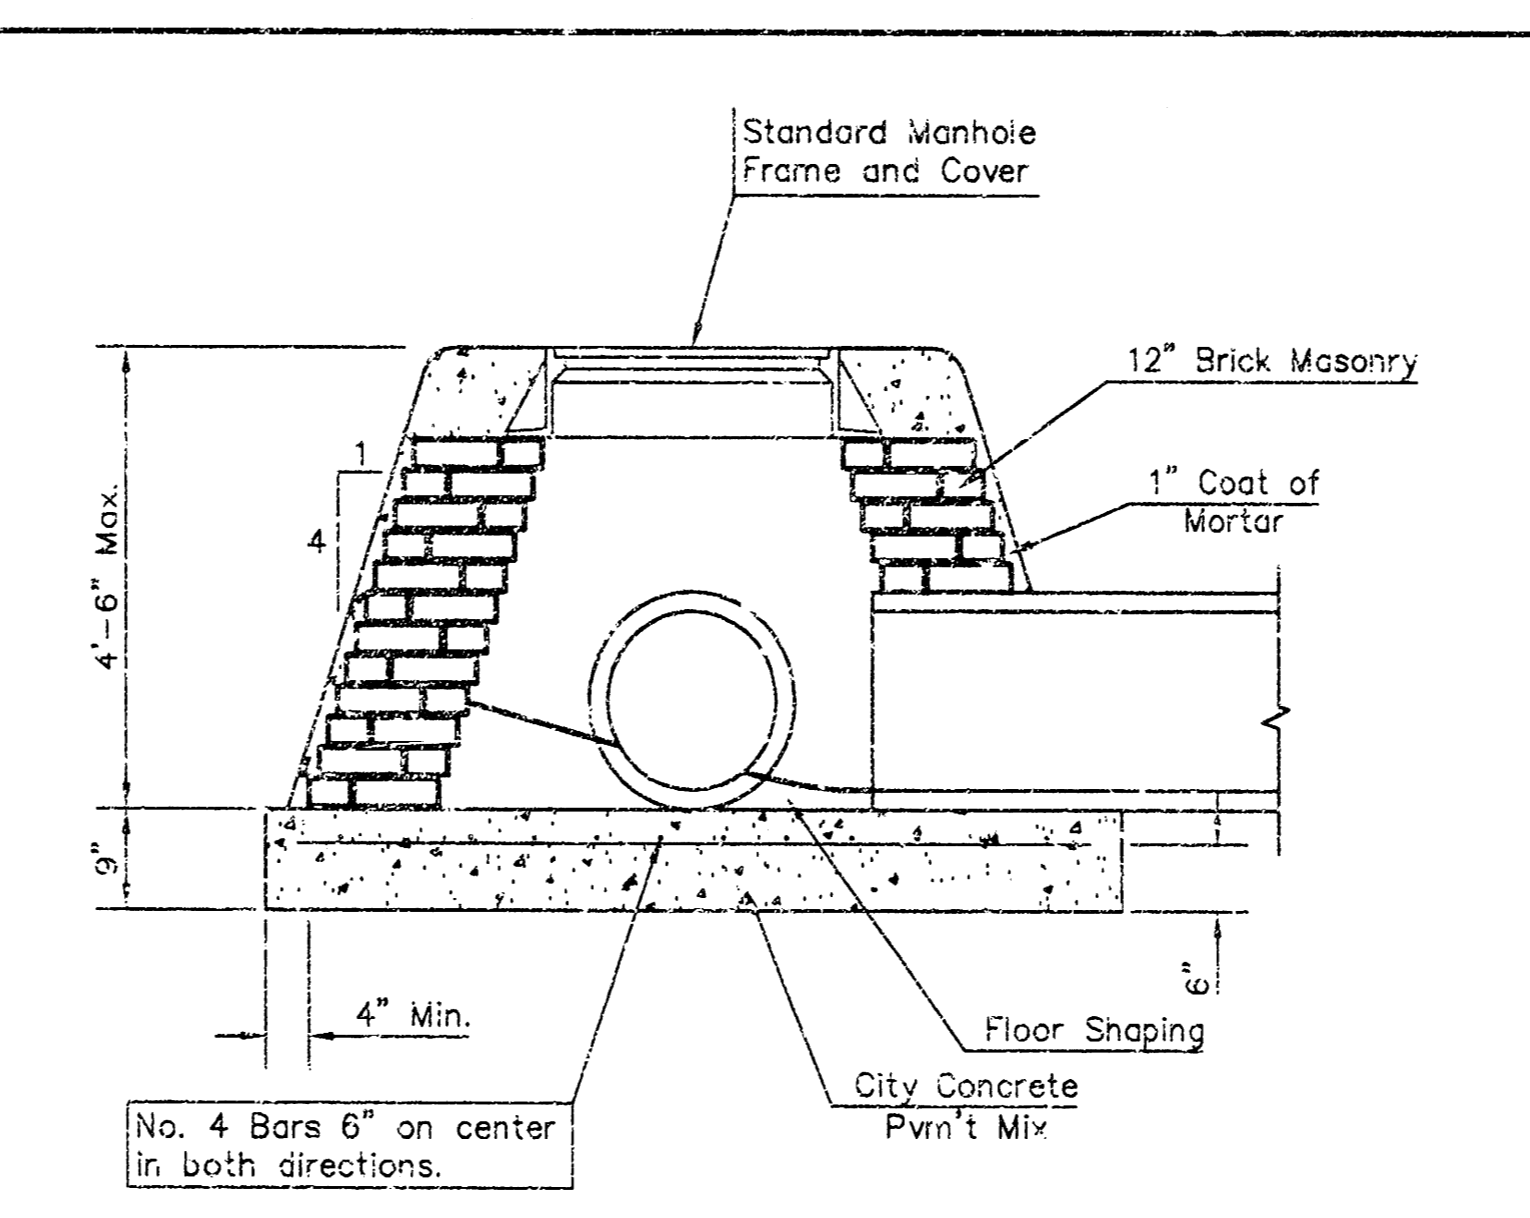

SPECIAL SHALLOW TYPE "B" MANHOLE









REV. 1/05/01, MCG

GENERAL NOTES


- Mortar used in masonry construction shall contain 8 sacks of cement per cubic yard. Concrete used in manhole bases shall conform to the requirements of concrete for concrete pavement construction as specified in the city standard paving specifications using city concrete cement mix without air entraining admixture. Mortar shall be placed around the manhole ring as shown on the drawings when manholes are constructed in unpaved areas. Type "A" shallow manholes can be used on sewers when the manhole is not located within public street pavement. Manholes constructed where pipe sizes are smaller than 24" shall have an inside diameter of 4". Manholes constructed where pipe sizes are 24" or larger shall have an inside diameter of 5". Completed manhole shall be without leaks and water tight.
- Reinforcing steel shall be installed in the manhole bases and shall consist of no. 4 bars placed on 6" centers in both directions. The manhole base reinforcement shall be placed 6" above the bottom of the manhole base. All costs for furnishing and installing reinforcing steel shall be included in the unit price bid for the manhole.
- The floors of all manholes shall be shaped with flow channels such that the manholes will be self clean and free of areas where solids could be deposited as sewage flows through the manhole from all inlet pipes to the outlet pipe. Flow channels shall be formed to match the bottom, naives of the inflowing pipes and the outflowing pipe as shown by the drawings. Manhole floors shall have slopes of 3 inches per foot in the areas outside of the flow channels sloped toward the flow channels. Pipes laid through manholes shall have the top half removed to neat lines for the full inside diameter of the manhole. Manhole floors shall then be shaped around the bottom half of the pipe which forms the flow channel.
- Pipes installed within the excavation made for the manhole shall be cradled with concrete to the limits of the manhole excavation. When clay pipe is used, the cradle shall extend to the first joint outside the manhole. The cradle shall be terminated at the clay pipe joint in a manner which will maintain the flexibility of the joint. Cost of cradle within manhole excavation or to clay pipe joints adjacent to manhole shall be included in the unit price bid for the manhole.
- Manhole cover castings and manhole frame castings shall conform to the requirements as indicated in the standard specifications and as shown in the standard detail drawings.
- The crowns of inflowing pipes shall never be set lower than the crown of the outflowing pipe.
- Standard shallow manholes type "A" and "B" shall be paid for at the unit price bid per each for the type and diameter indicated. Standard special shallow manholes type "A" and "B" shall be paid for at the unit price bid per each for the type indicated. All standard shallow manhole diameters will be 4' unless indicated otherwise.
- All brick used in manhole construction shall meet Grade SW of ASTM C652 or C62-87.

<p>THE CITY OF WICHITA</p> <p>CITY ENGINEER'S OFFICE CITY HALL - SEVENTH FLOOR 400 NORTH MAIN STREET WICHITA, KANSAS 67202 (316) 268-4114 FAX</p>	<p>STANDARD/SPECIAL SHALLOW MANHOLES TYPE 'A' & 'B'</p>	
	<p>NEIL D. CABLE, P.E. - CITY ENGINEER</p>	
<p>PROJECT NUMBER 979PPW</p>	<p>INDEX CODE 607853</p>	
<p>DATE MAR 96</p>	<p>SHEET 4 OF 7</p>	

Special Shallow MH Type A & B.DWG

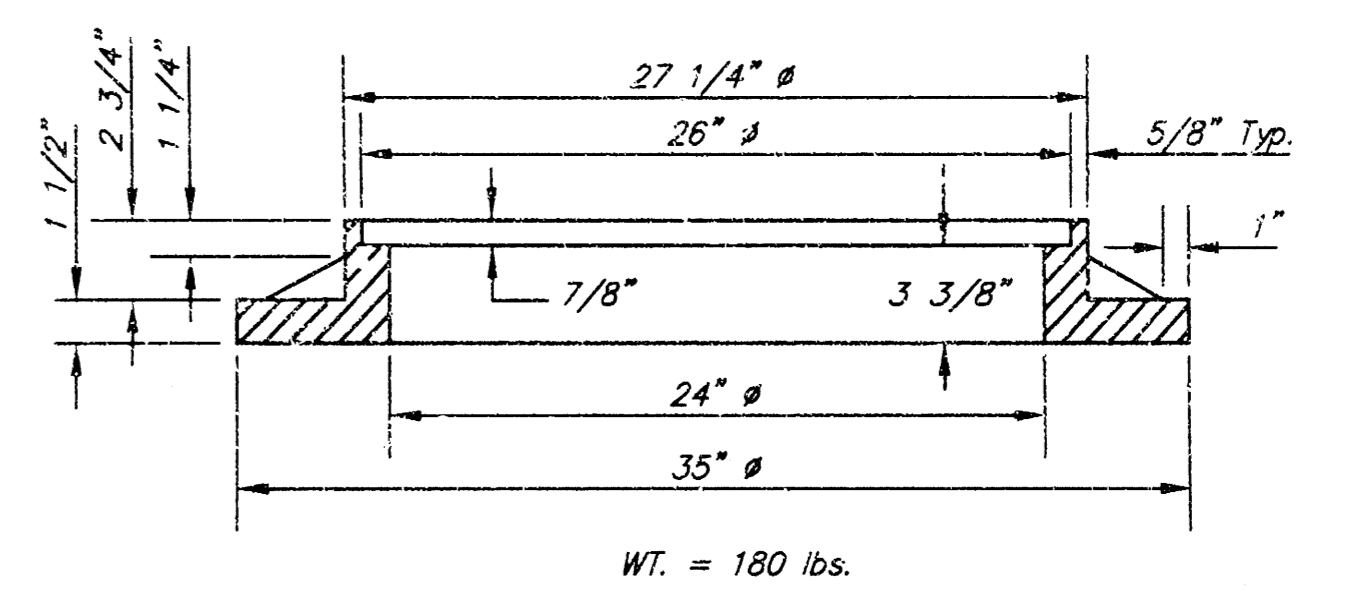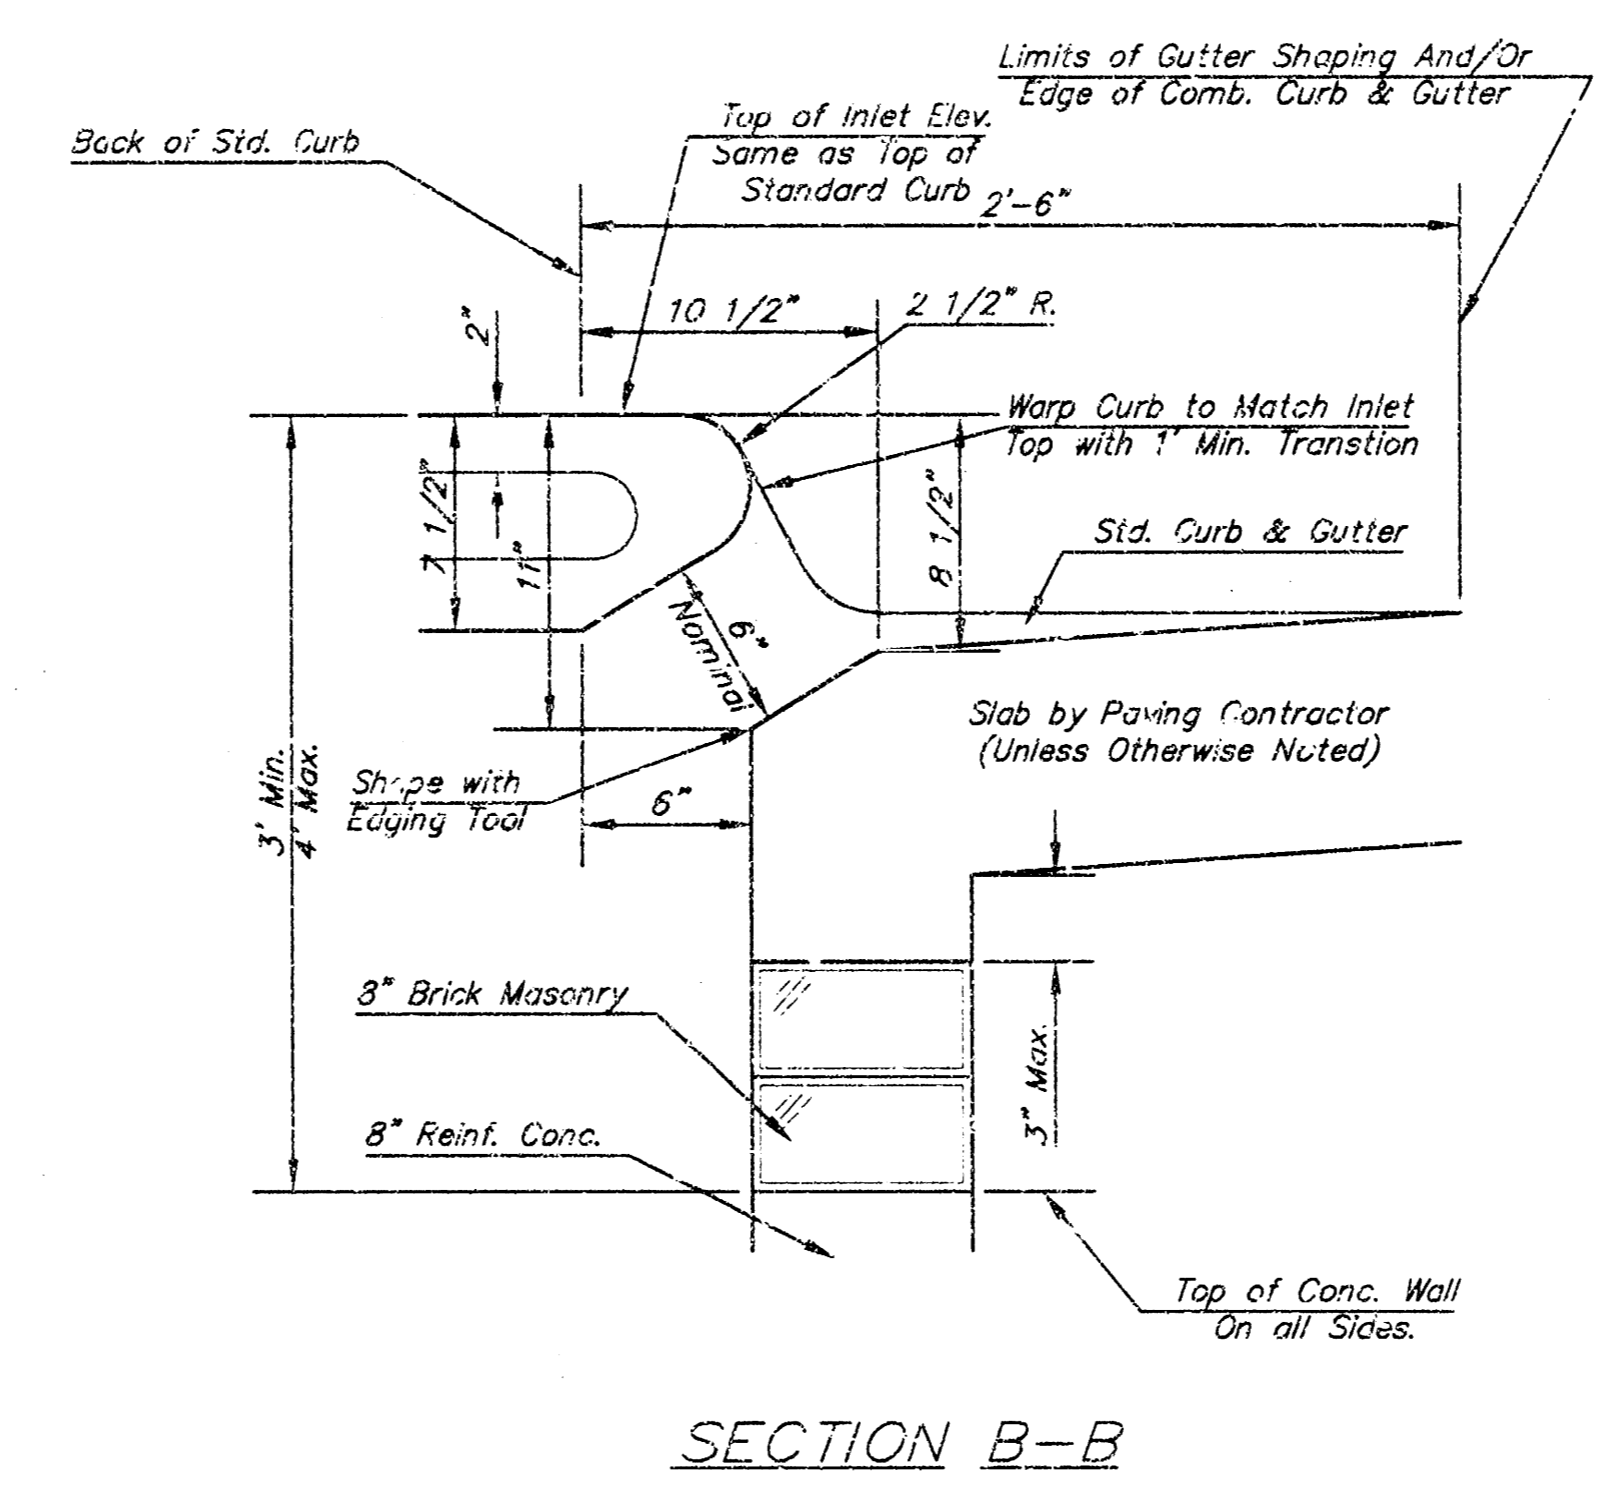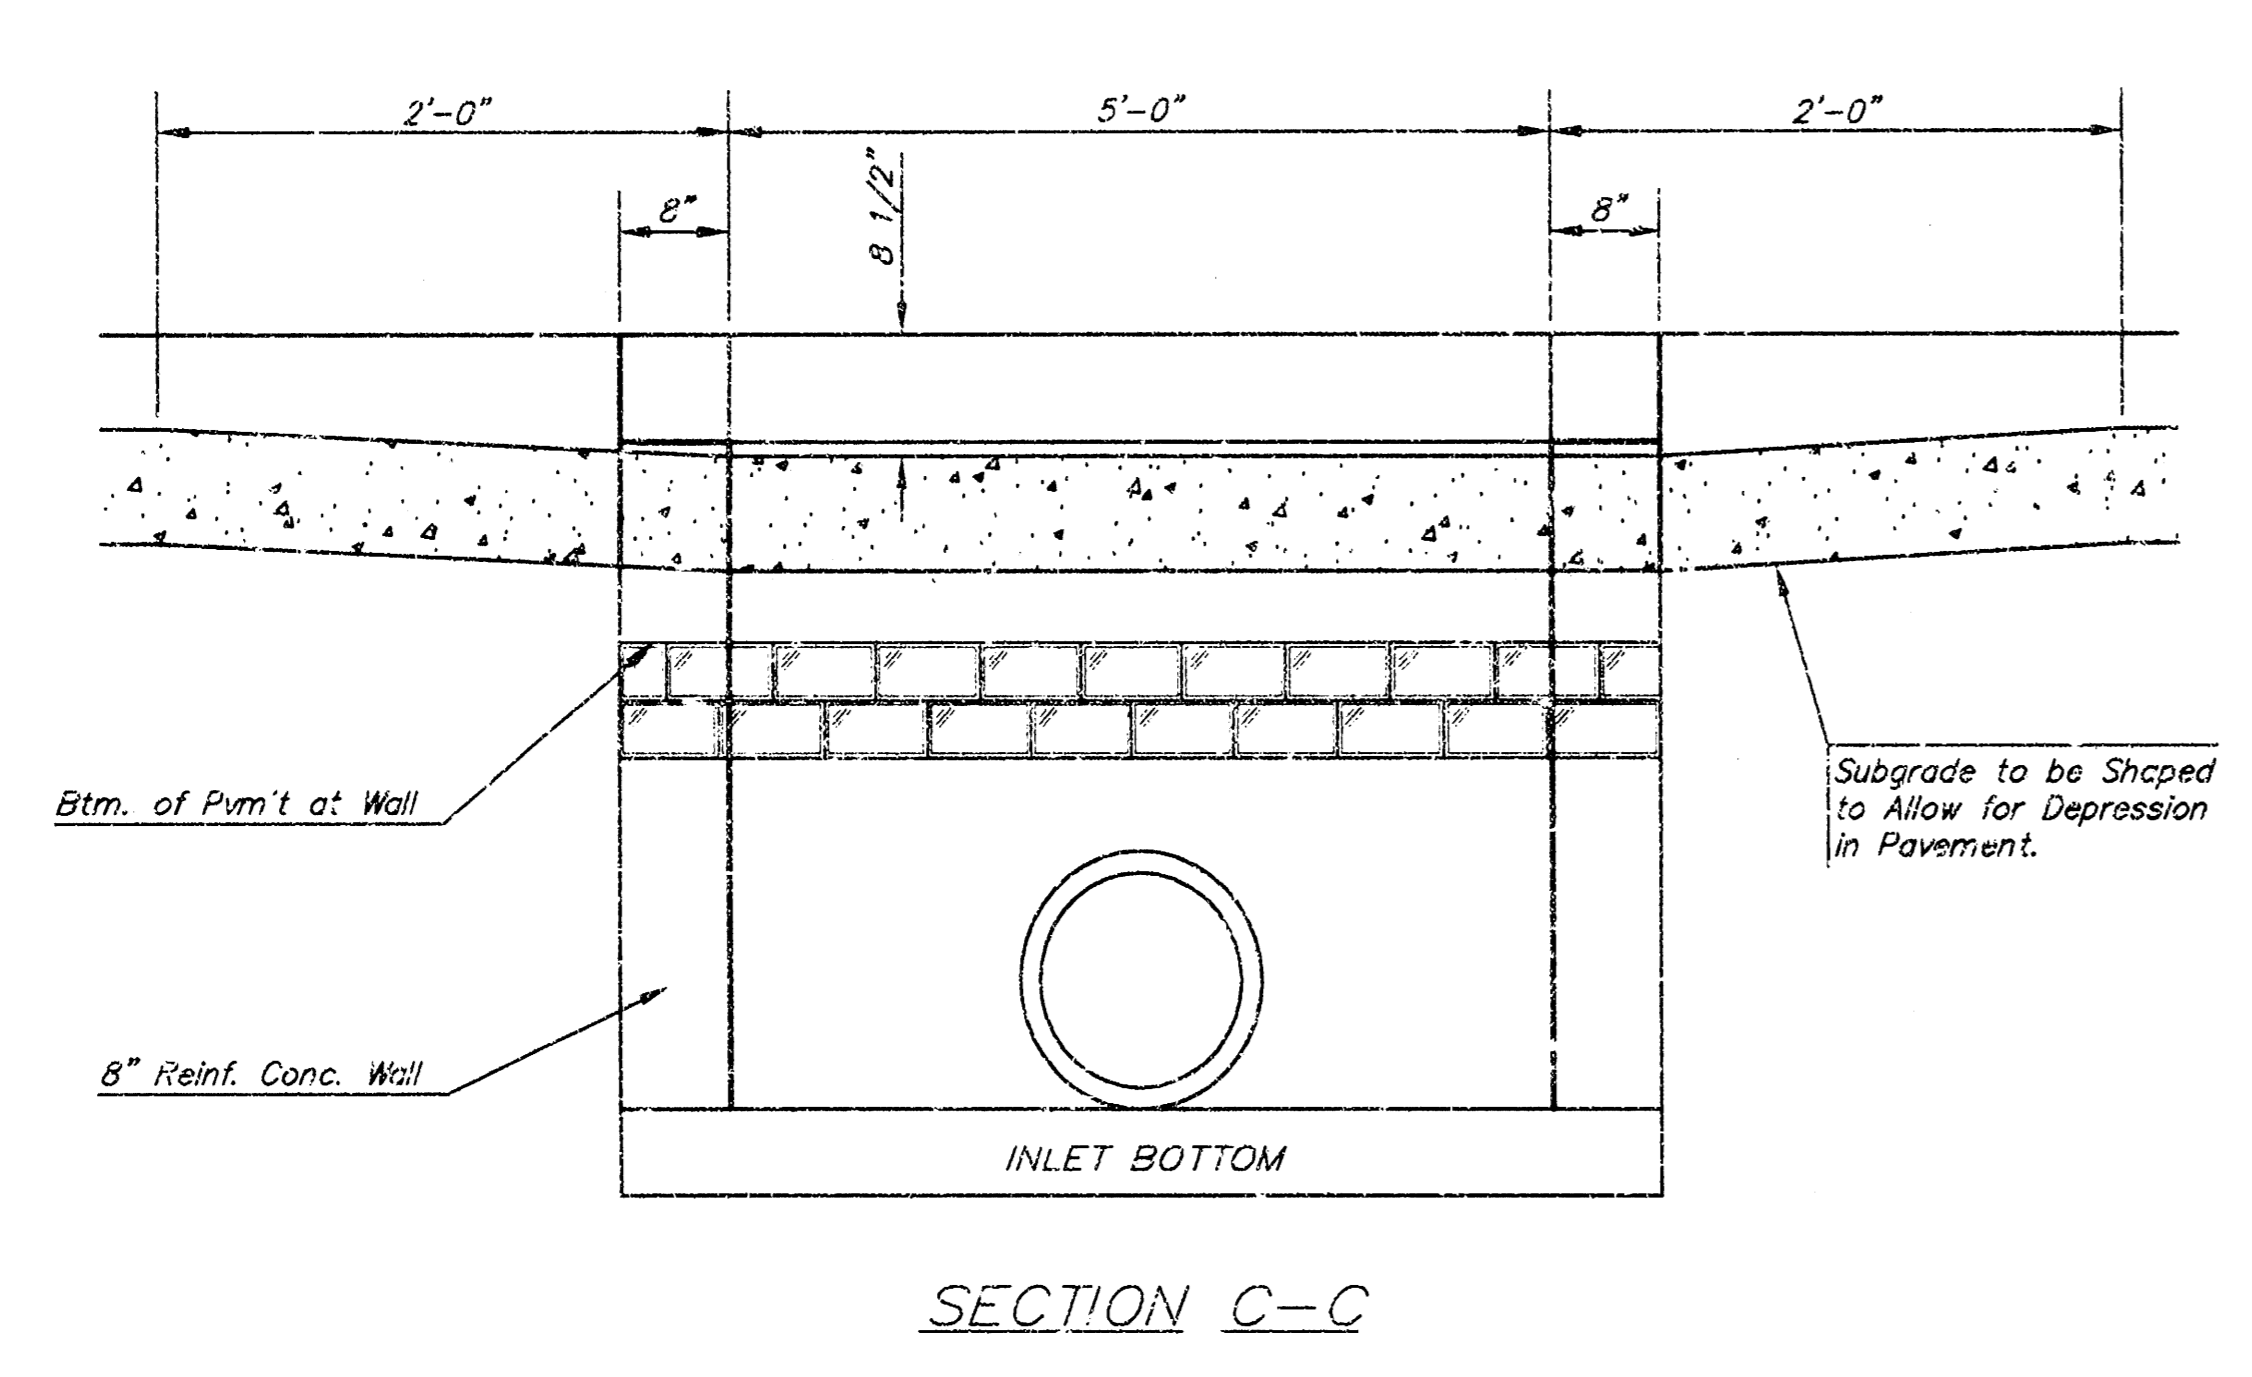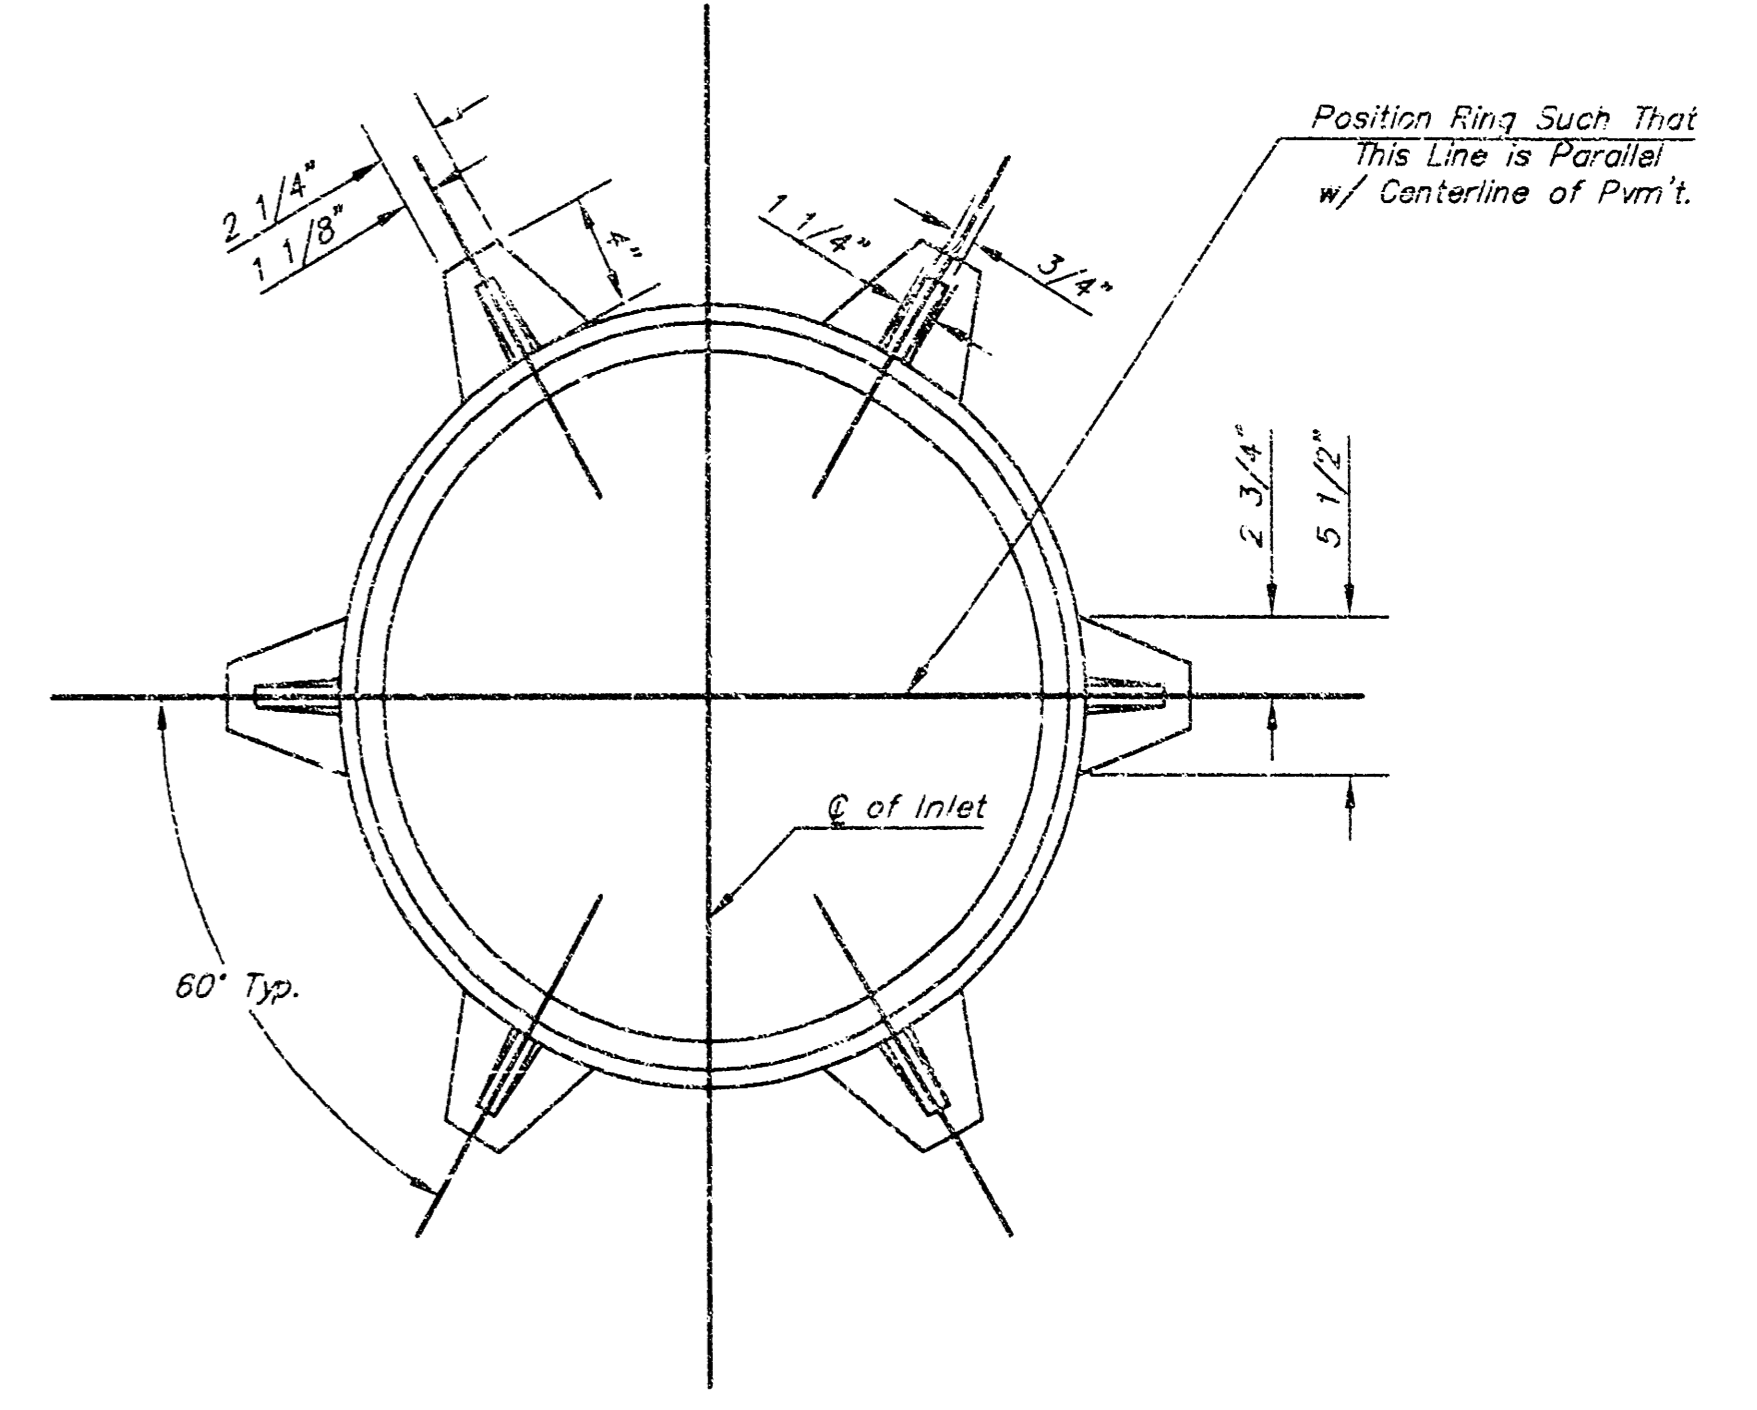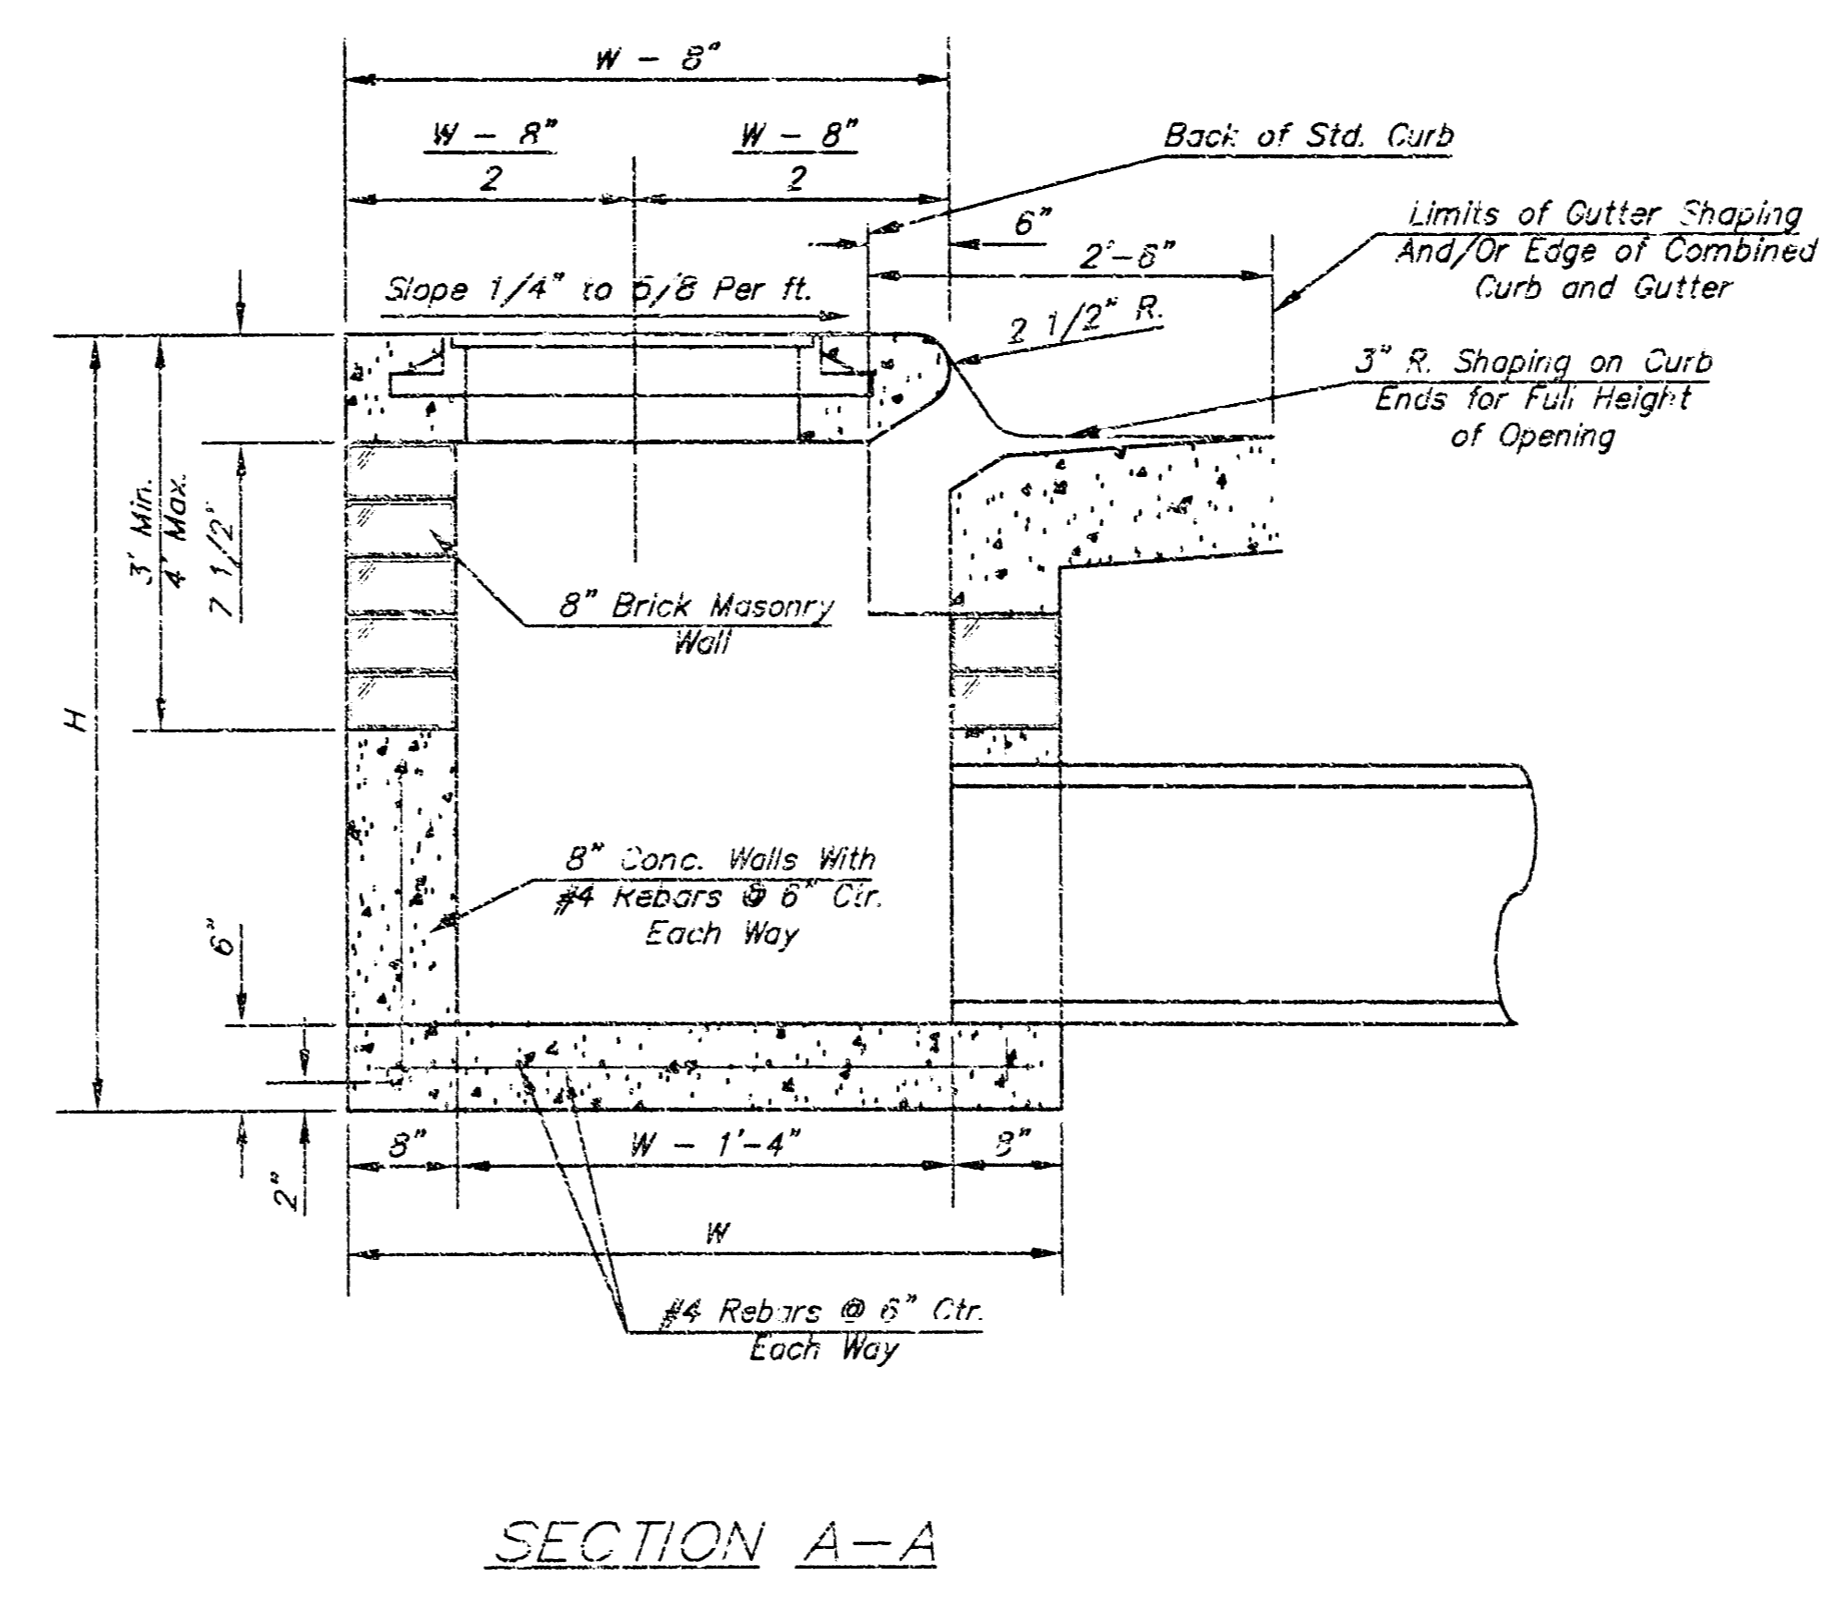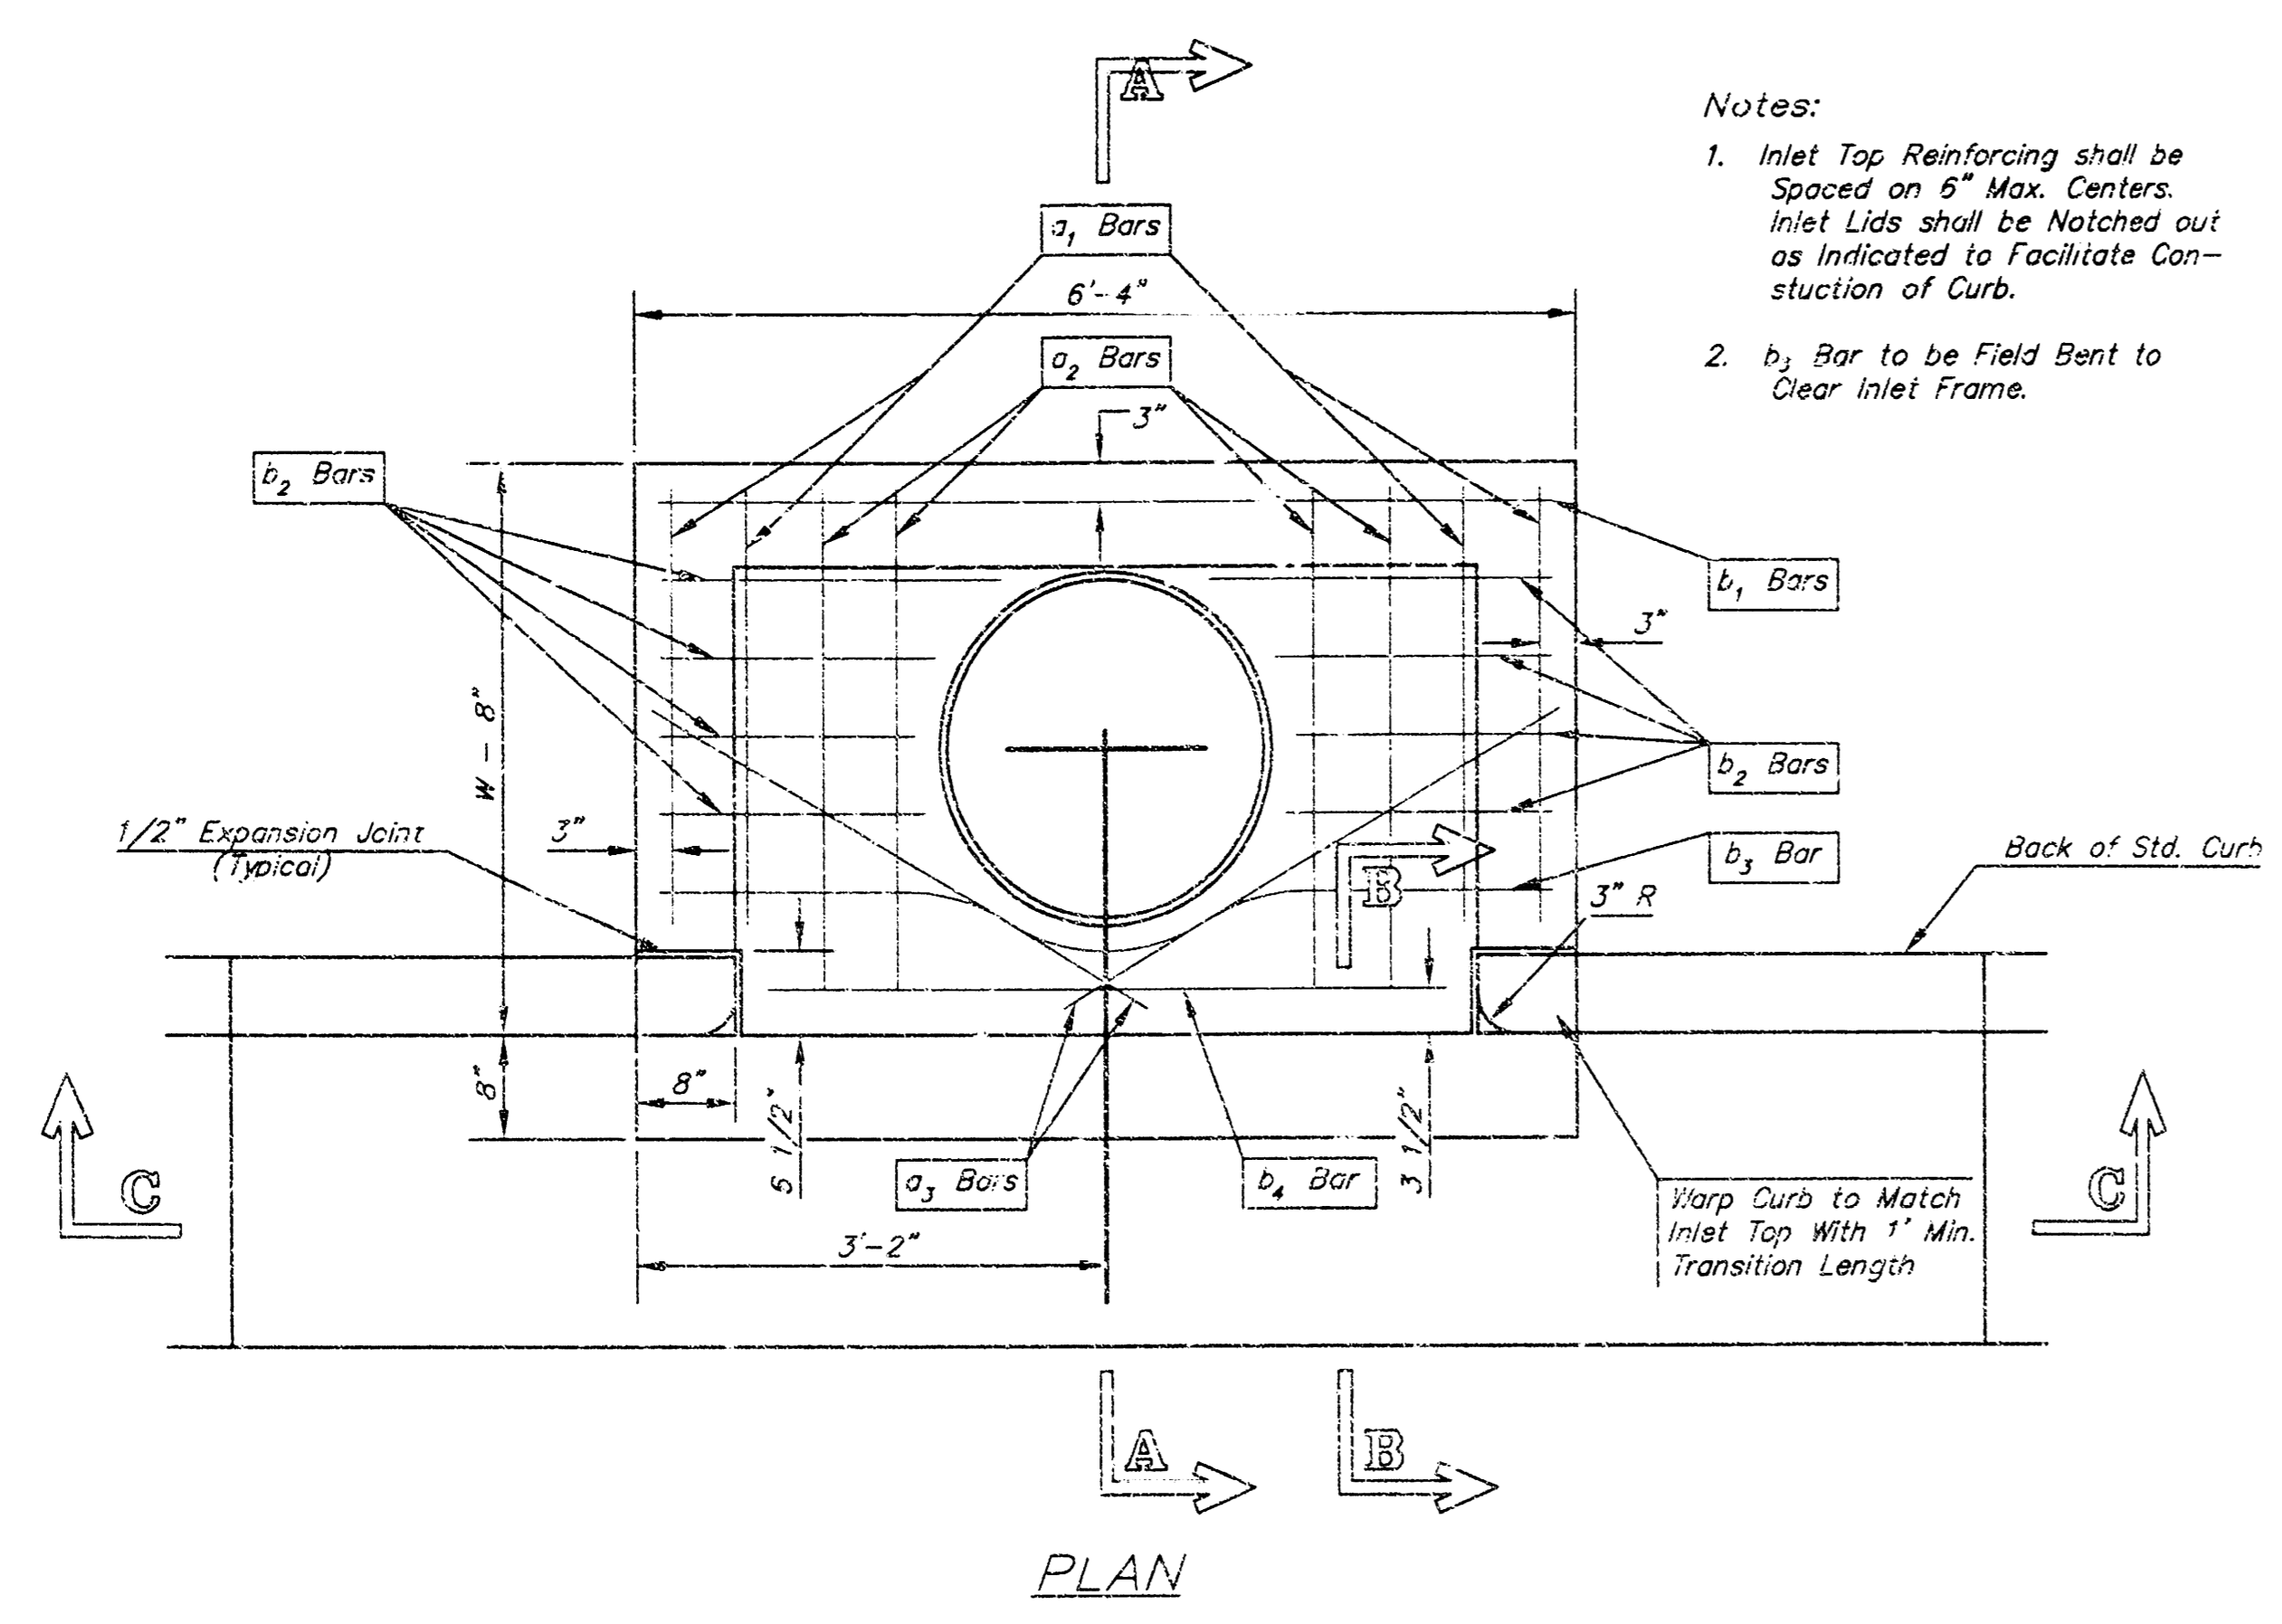

MANHOLE RING AND COVER
*See City of Wichita Standard Manhole Ring and Cover Detail Sheet for Cover Details to Be Used With Inlet Frame.

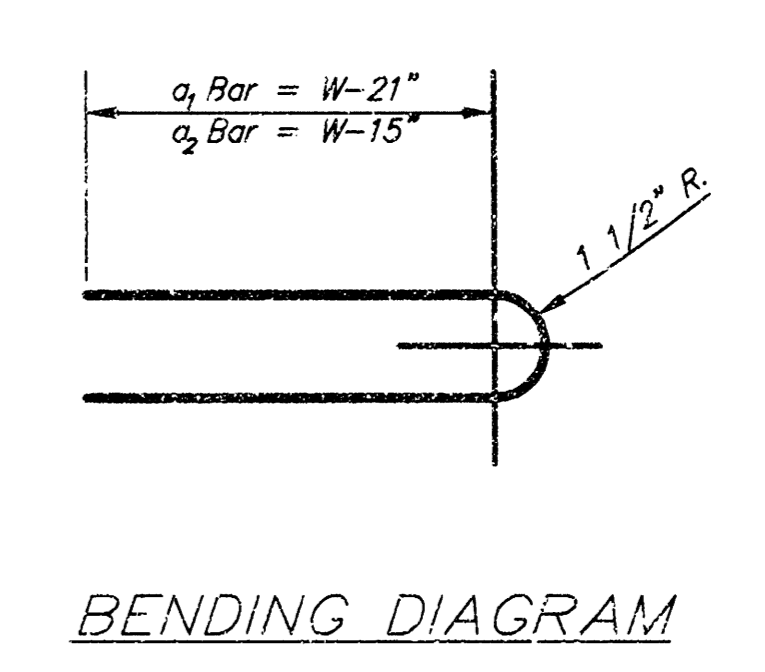


STEEL SCHEDULE

BAR NUMBER	a ₁	a ₂	a ₃	a ₄	a ₅	a ₆	a ₇	a ₈	a ₉	a ₁₀	a ₁₁	a ₁₂	WT. Lbs.
4	4	2	1	3	5	7	9	6	1	1			
SIZE	#4	#4	#4	#4	#4	#4	#4	#4	#4	#6			
W=4'-4"	5'-7"	6'-7"	4'-0"	6'-1"	-	-	-	1'-9"	6'-2"	4'-8"			60±
W=5'-4"	7'-7"	8'-7"	5'-0"	6'-1"	-	-	-	1'-9"	6'-2"	4'-8"			81±
W=6'-4"	9'-7"	10'-7"	6'-0"	6'-1"	-	-	-	1'-9"	6'-2"	4'-8"			101±
W=7'-4"	11'-7"	12'-7"	7'-0"	6'-1"	-	-	-	1'-9"	6'-2"	4'-8"			121±
W=8'-4"	13'-7"	14'-7"	8'-0"	6'-1"	-	-	-	1'-9"	6'-2"	4'-8"			141±

STANDARD CURB INLET PRECAST TOPS

W	PRE-CAST TOP SIZE	PIPE SIZE	CU. YD. CONC.
4'-4"	3'-8" 6'-4" 7 1/2"	21" & SMALLER	0.38±
5'-4"	4'-8" 6'-4" 7 1/2"	24" & 30"	0.51±
6'-4"	5'-8" 6'-4" 7 1/2"	36" & 42"	0.64±
7'-4"	6'-8" 6'-4" 7 1/2"	48" & 54"	0.77±
8'-4"	7'-8" 6'-4" 7 1/2"	60" & 66"	0.90±

- GENERAL NOTES
- Concrete tops to be installed on thin mortar cushion to insure full support along brick walls. Concrete tops may be cast in place or precast. Concrete used for inlet construction shall be concrete pavement mix.
 - Contractor shall have the option of constructing 8" brick masonry walls between the concrete inlet base and top on this inlet when W=6'-4" and H=7'-0" or less.
 - Inlet invert shall be shaped with 8 sack sand mix concrete to create flow channels and to increase hydraulic efficiency such that the inlet will be self-cleaning between all inlet and/or outlet pipes.
 - The ends of all pipes installed in inlets shall be cut off flush with the inside face of the inlet wall.

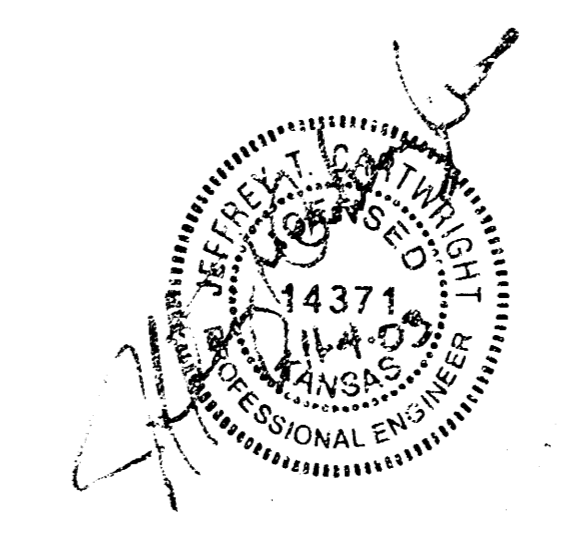

THE CITY OF WICHITA

STANDARD TYPE 1 CURB INLET

OPENING = 6" x 5'-0"

NEIL D. CABLE, P.E. - CITY ENGINEER

CITY ENGINEER'S OFFICE
CITY HALL - SEVENTH FLOOR
452 NORTH MAIN STREET
WICHITA, KANSAS 67202
(316) 223-2251
(316) 268-8116 FAX

PROJECT NUMBER: 1364 FPS
INDEX CODE: 607861

DATE: MAR 98
SHEET 5 OF 7