

# STORM WATER SEWER TO SERVE HAN DIEC ADDITION

Lot 1, Blk. A

Private Project Number: 1457 PPS (607861)

CITY OF WICHITA, KANSAS

James L. Armour, P.E. Acting City Engineer

June 2004

### Bench Marks:

BM #1 CITY OF WICHITA BENCHMARK DISC - SE CORNER OF GREENWICH ROAD AND KELLOGG, NW CORNER OF LIGHTPOLE BASE.  
48.60' NNW OF CENTER OF SANITARY SEWER MANHOLE.  
48.70' S. OF CENTERLINE OF TRAFFIC SIGNAL MANHOLE IN KELLOGG MEDIAN.  
48.70' S. OF CENTERLINE OF TRAFFIC SIGNAL MANHOLE IN KELLOGG MEDIAN.  
70.50' E. OF BACK OF EAST CURB ON EAST SIDE OF MEDIAN IN GREENWICH RD.  
ELEV. = 164.78 CITY DATUM (1352.18 NGVD)

BM #2 "□" On Catch Basin Located 128.95 L.F. North of the SE Corner of Han Diec Addition.  
ELEV. = 171.46 City Datum

### Index

Cover Sheet	1
Line 1 & 2	2
Line 3	3
Curb Inlet Detail	4
Drop Inlet Detail	5
Erosion Control Detail	6
Copy Of Plot	7


APPROVED AS NOTED  
BY CITY ENGINEER OF WICHITA

Storm Sewers VRH 6/15/04



### NOTE TO CONTRACTORS

Installation, inspection and testing for this project is to be provided by a Licensed Consulting Engineering Firm under contract with the Owner/Developer. Said inspection is to be in accordance with the City of Wichita standard construction engineering practices and certified by a Licensed Professional Engineer. No work shall be performed in dedicated easements or public right-of-way by the Contractor without such inspection and that any work be commenced without written authorization by the City Engineer. All Construction and Materials shall comply with the City of Wichita Specifications and Standards (as its and available in the City Engineer's Office).

### Location Map

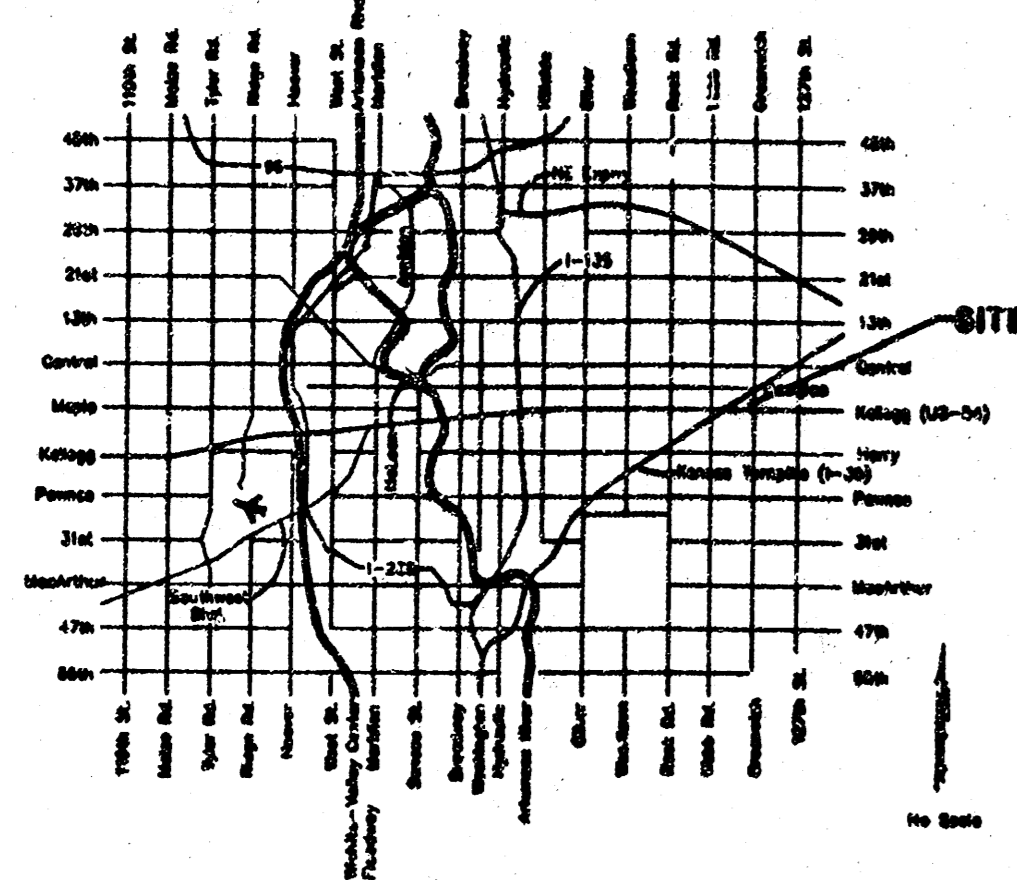


RAYTHEON AIRCRAFT COMPANY  
P.O. BOX 85  
WICHITA, KS 67201-0085

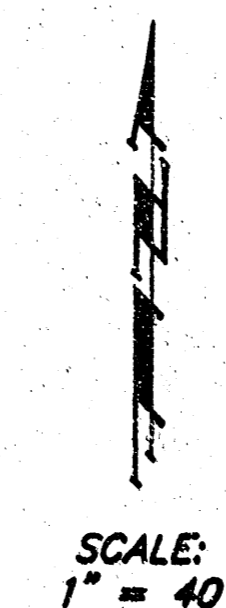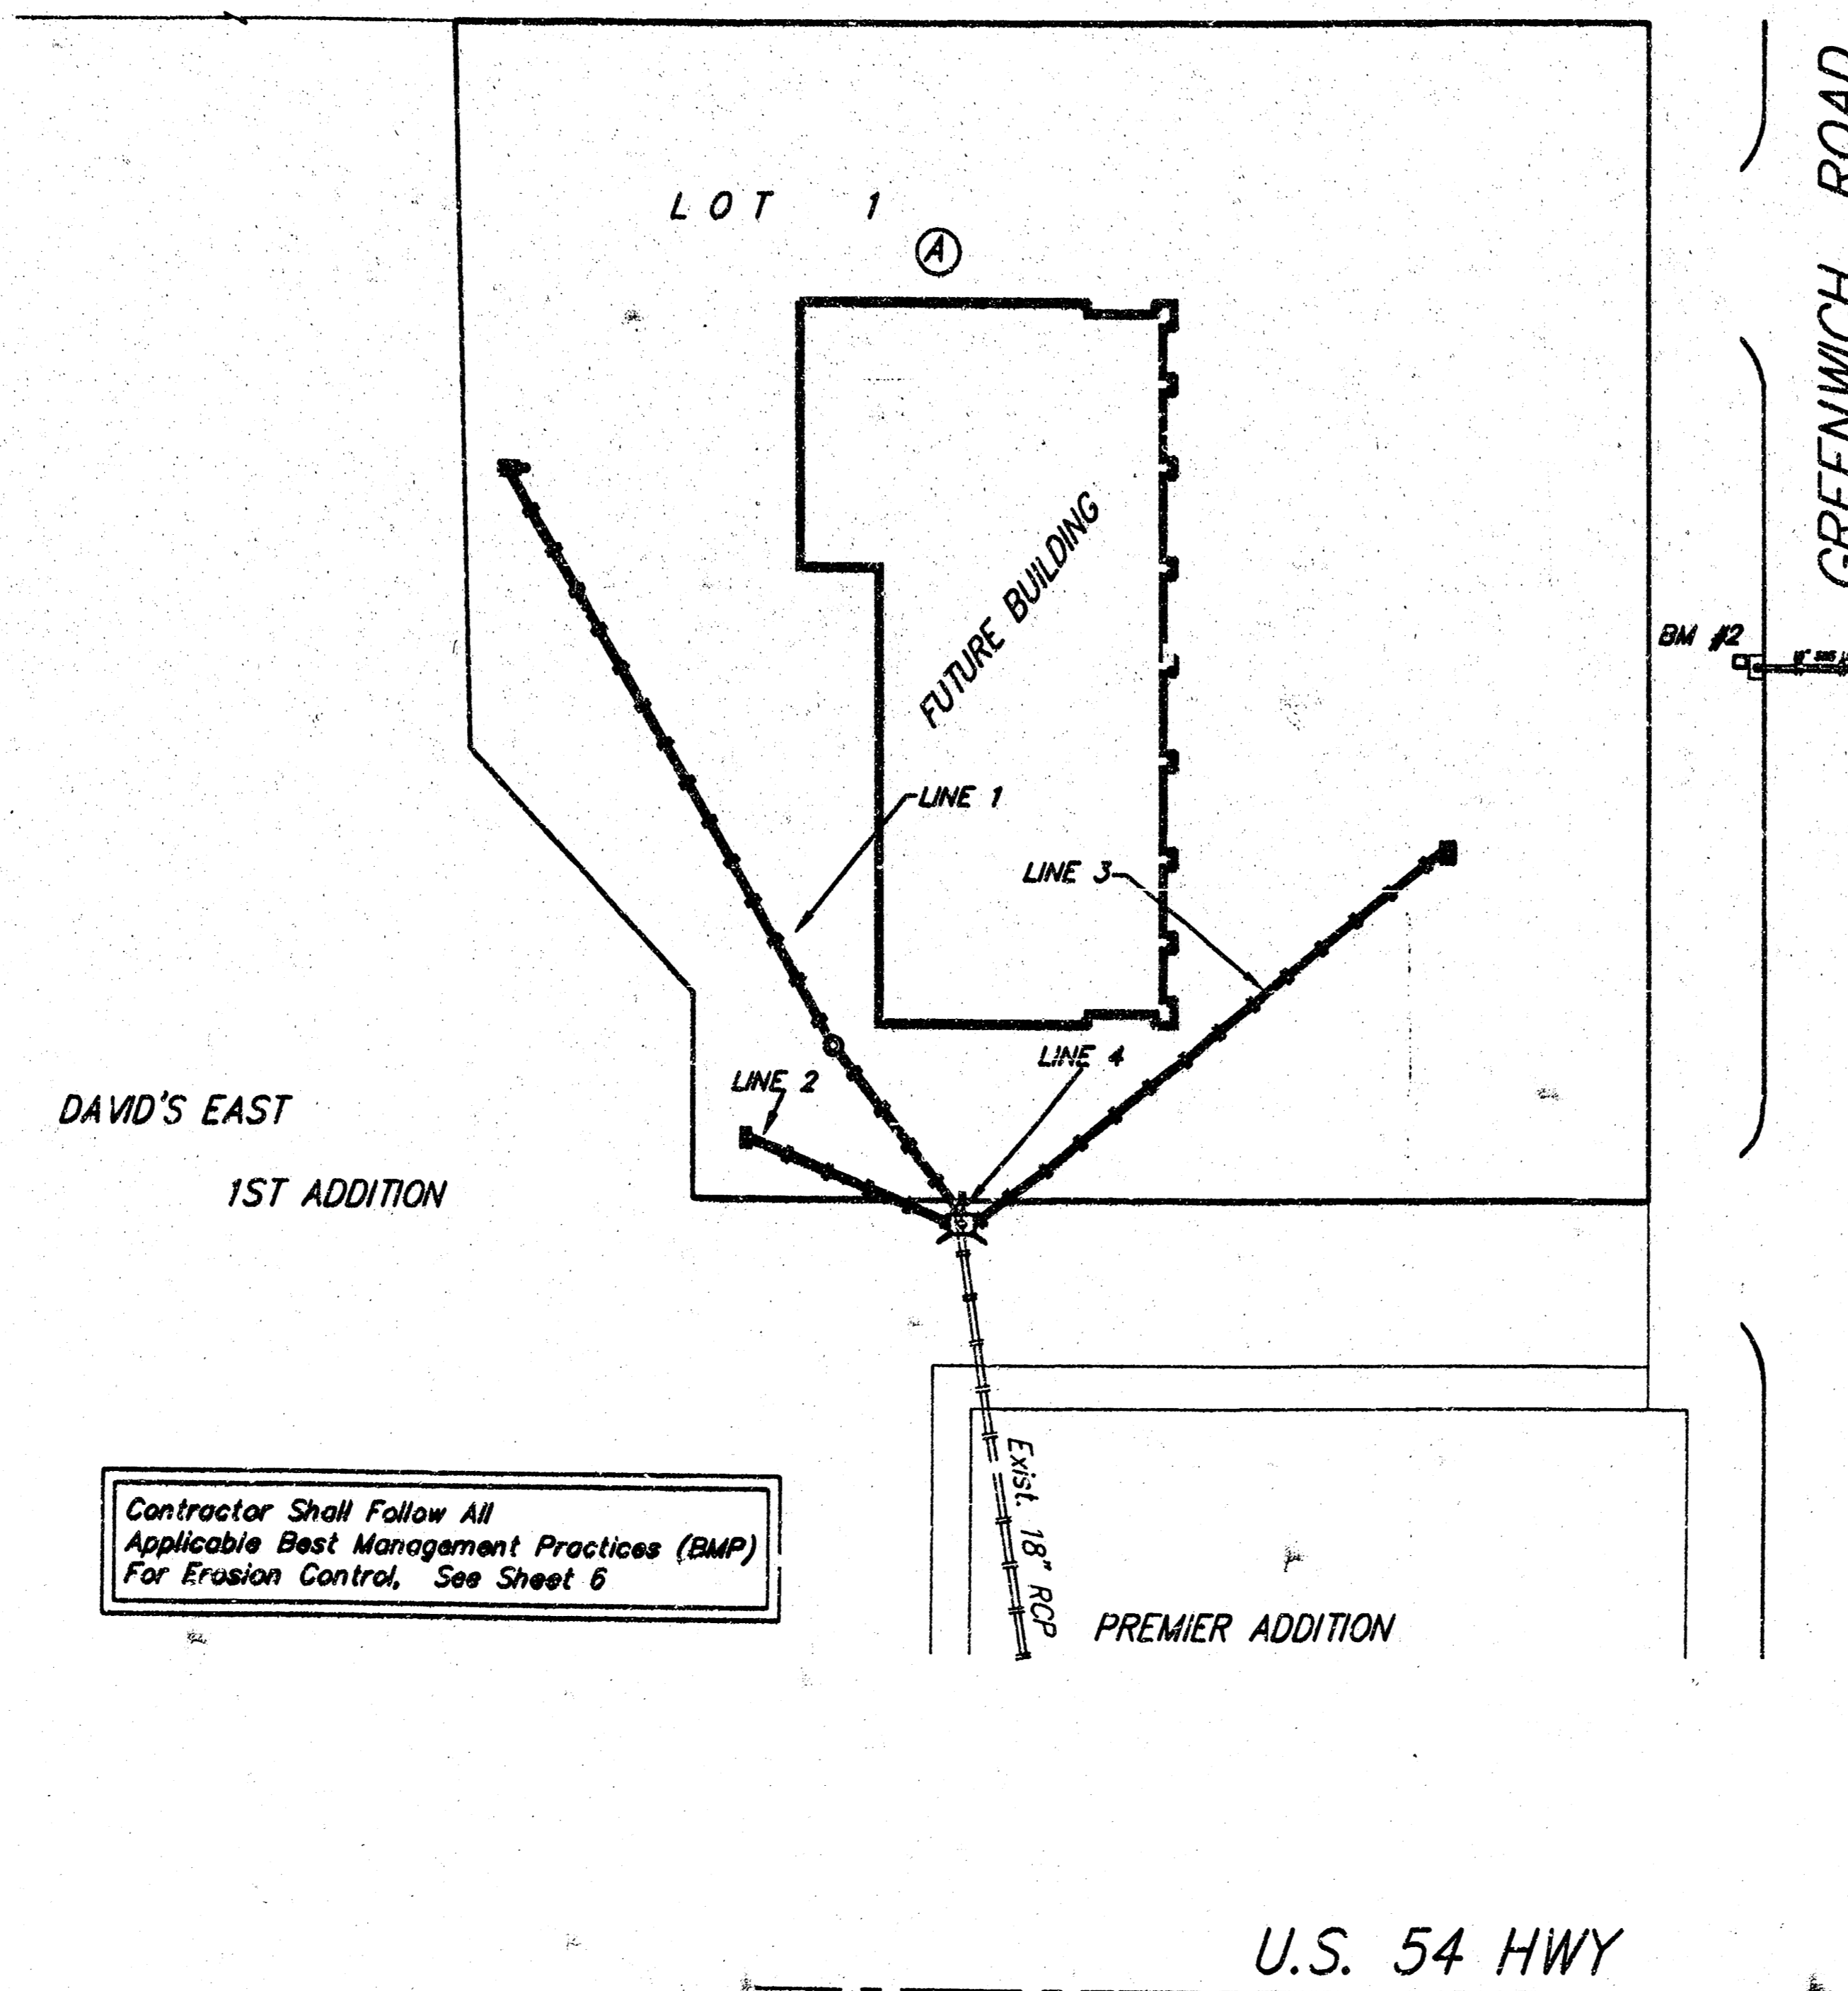

### General Notes

- Contractor will be required to provide notice to utility companies a minimum of forty-eight (48) hours prior to any excavation, as follows:  
Kansas One-Call 687-2470  
The Contractor must notify the following in case of an emergency:  
Cox Communications 262-4270  
Kansas Gas Service Company 1-888-482-4800  
Wester Energy (Electric) 383-8650  
Aquila Energy (Gas) 1-800-303-0307  
Southwestern Bell Telephone Co. 1-800-286-8313  
City of Wichita Water Dept. (Water) 268-4903  
City of Wichita Sewer Maint. (SS) 268-4024  
City of Wichita Storm Sewer Maint. 268-4090  
City of Wichita Traffic Maint. 268-4034
- Utility service lines, poles, valve boxes, meters, et cetera are to be adjusted as necessary by others prior to construction unless the plans specifically call for their adjustment by the Contractor or unless the plans specifically identify a utility to be adjusted by its owner during construction. Existing utilities and their location, as shown on the plans, represent the best information obtainable for design and shall be field verified. The contractor will be required to work around existing utilities within the right-of-way which do not conflict with proposed construction.
- Contractor shall not start work on the project until the project inspector is assigned to the project and is present on the site. Contractor shall not start on the project until all necessary bonds and permits have been obtained. Bonds may include but are not limited to Statutory, Performance & Maintenance for areas in public right-of-way and easement. For projects within the City of Wichita contact Tom Mason (268-4574). Any work done without inspection will be required to be uncovered for inspection.
- Rubble from the removal of miscellaneous structures and excess excavation which is to be wasted shall be disposed of on sites to be provided by the Contractor. These sites shall be approved by the Engineer as to suitability, appearance and site location. Locations that, in the opinion of the Engineer, will leave an unsightly appearance will not be approved. All disposal sites must be approved by the Kansas Department of Health and Environment. Material stockpiled or disposed of in a flood plain would require a Kansas State Board of Agriculture permit. Any material dumped in waters of the United States or wetlands is subject to U.S. Corps. of Engineers permitting regulations. Any material buried or stockpiled beyond approved construction limits would require additional archaeological investigations unless buried in a previously approved borrow location.
- All storm sewers shall be installed in accordance with the most recent edition of City of Wichita, Kansas Standard Specifications for the Construction of City Projects.
- All R/W areas disturbed by construction operations shall be seeded with K-31 Fescue at a rate of 8 lbs. per 1000 sq. feet or as per city specs. Contractor to prepare ground to city specifications.
- The Contractor shall give all property owners and/or tenants of developed property abutting the construction of this project a minimum of ten (10) days advance notice prior to start of construction.

Contractor Shall Follow All  
Applicable Best Management Practices (BMP)  
For Erosion Control, See Sheet 6

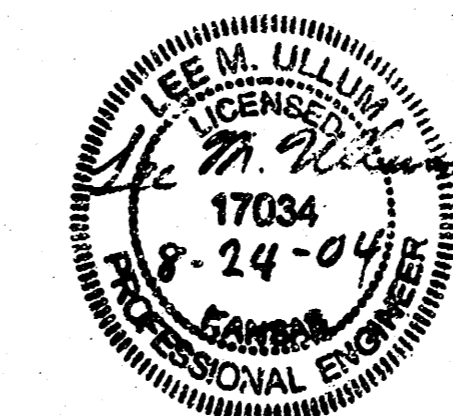

As Built 11/23/04

Baughman Company, P.A. 315 Ella St. Wichita, KS 67211 316-262-0149  
ENGINEERING | SURVEYING | PLANNING | LANDSCAPE ARCHITECTURE


06/14/2004  
Revised 08/20/2004



**BENCHMARK:**

BM #1 CITY OF WICHITA BENCHMARK DISC - SE CORNER OF GREENWICH ROAD AND KELLOGG, NW CORNER OF LIGHTPOLE BASE.  
 48.60' NNW OF CENTER OF SANITARY SEWER MANHOLE.  
 48.70' S. OF CENTERLINE OF TRAFFIC SIGNAL MANHOLE IN KELLOGG MEDIAN.  
 48.70' S. OF CENTERLINE OF TRAFFIC SIGNAL MANHOLE IN KELLOGG MEDIAN.  
 70.50' E. OF BACK OF EAST CURB ON EAST SIDE OF MEDIAN IN GREENWICH RD.  
 ELEV. = 164.78 CITY DATUM (1352.18 NGVD)


BM #2 "□" On Catch Basin Located 128.95 L.F. North of the SE Corner of Han Diec Addition.  
 ELEV. = 171.46 City Datum

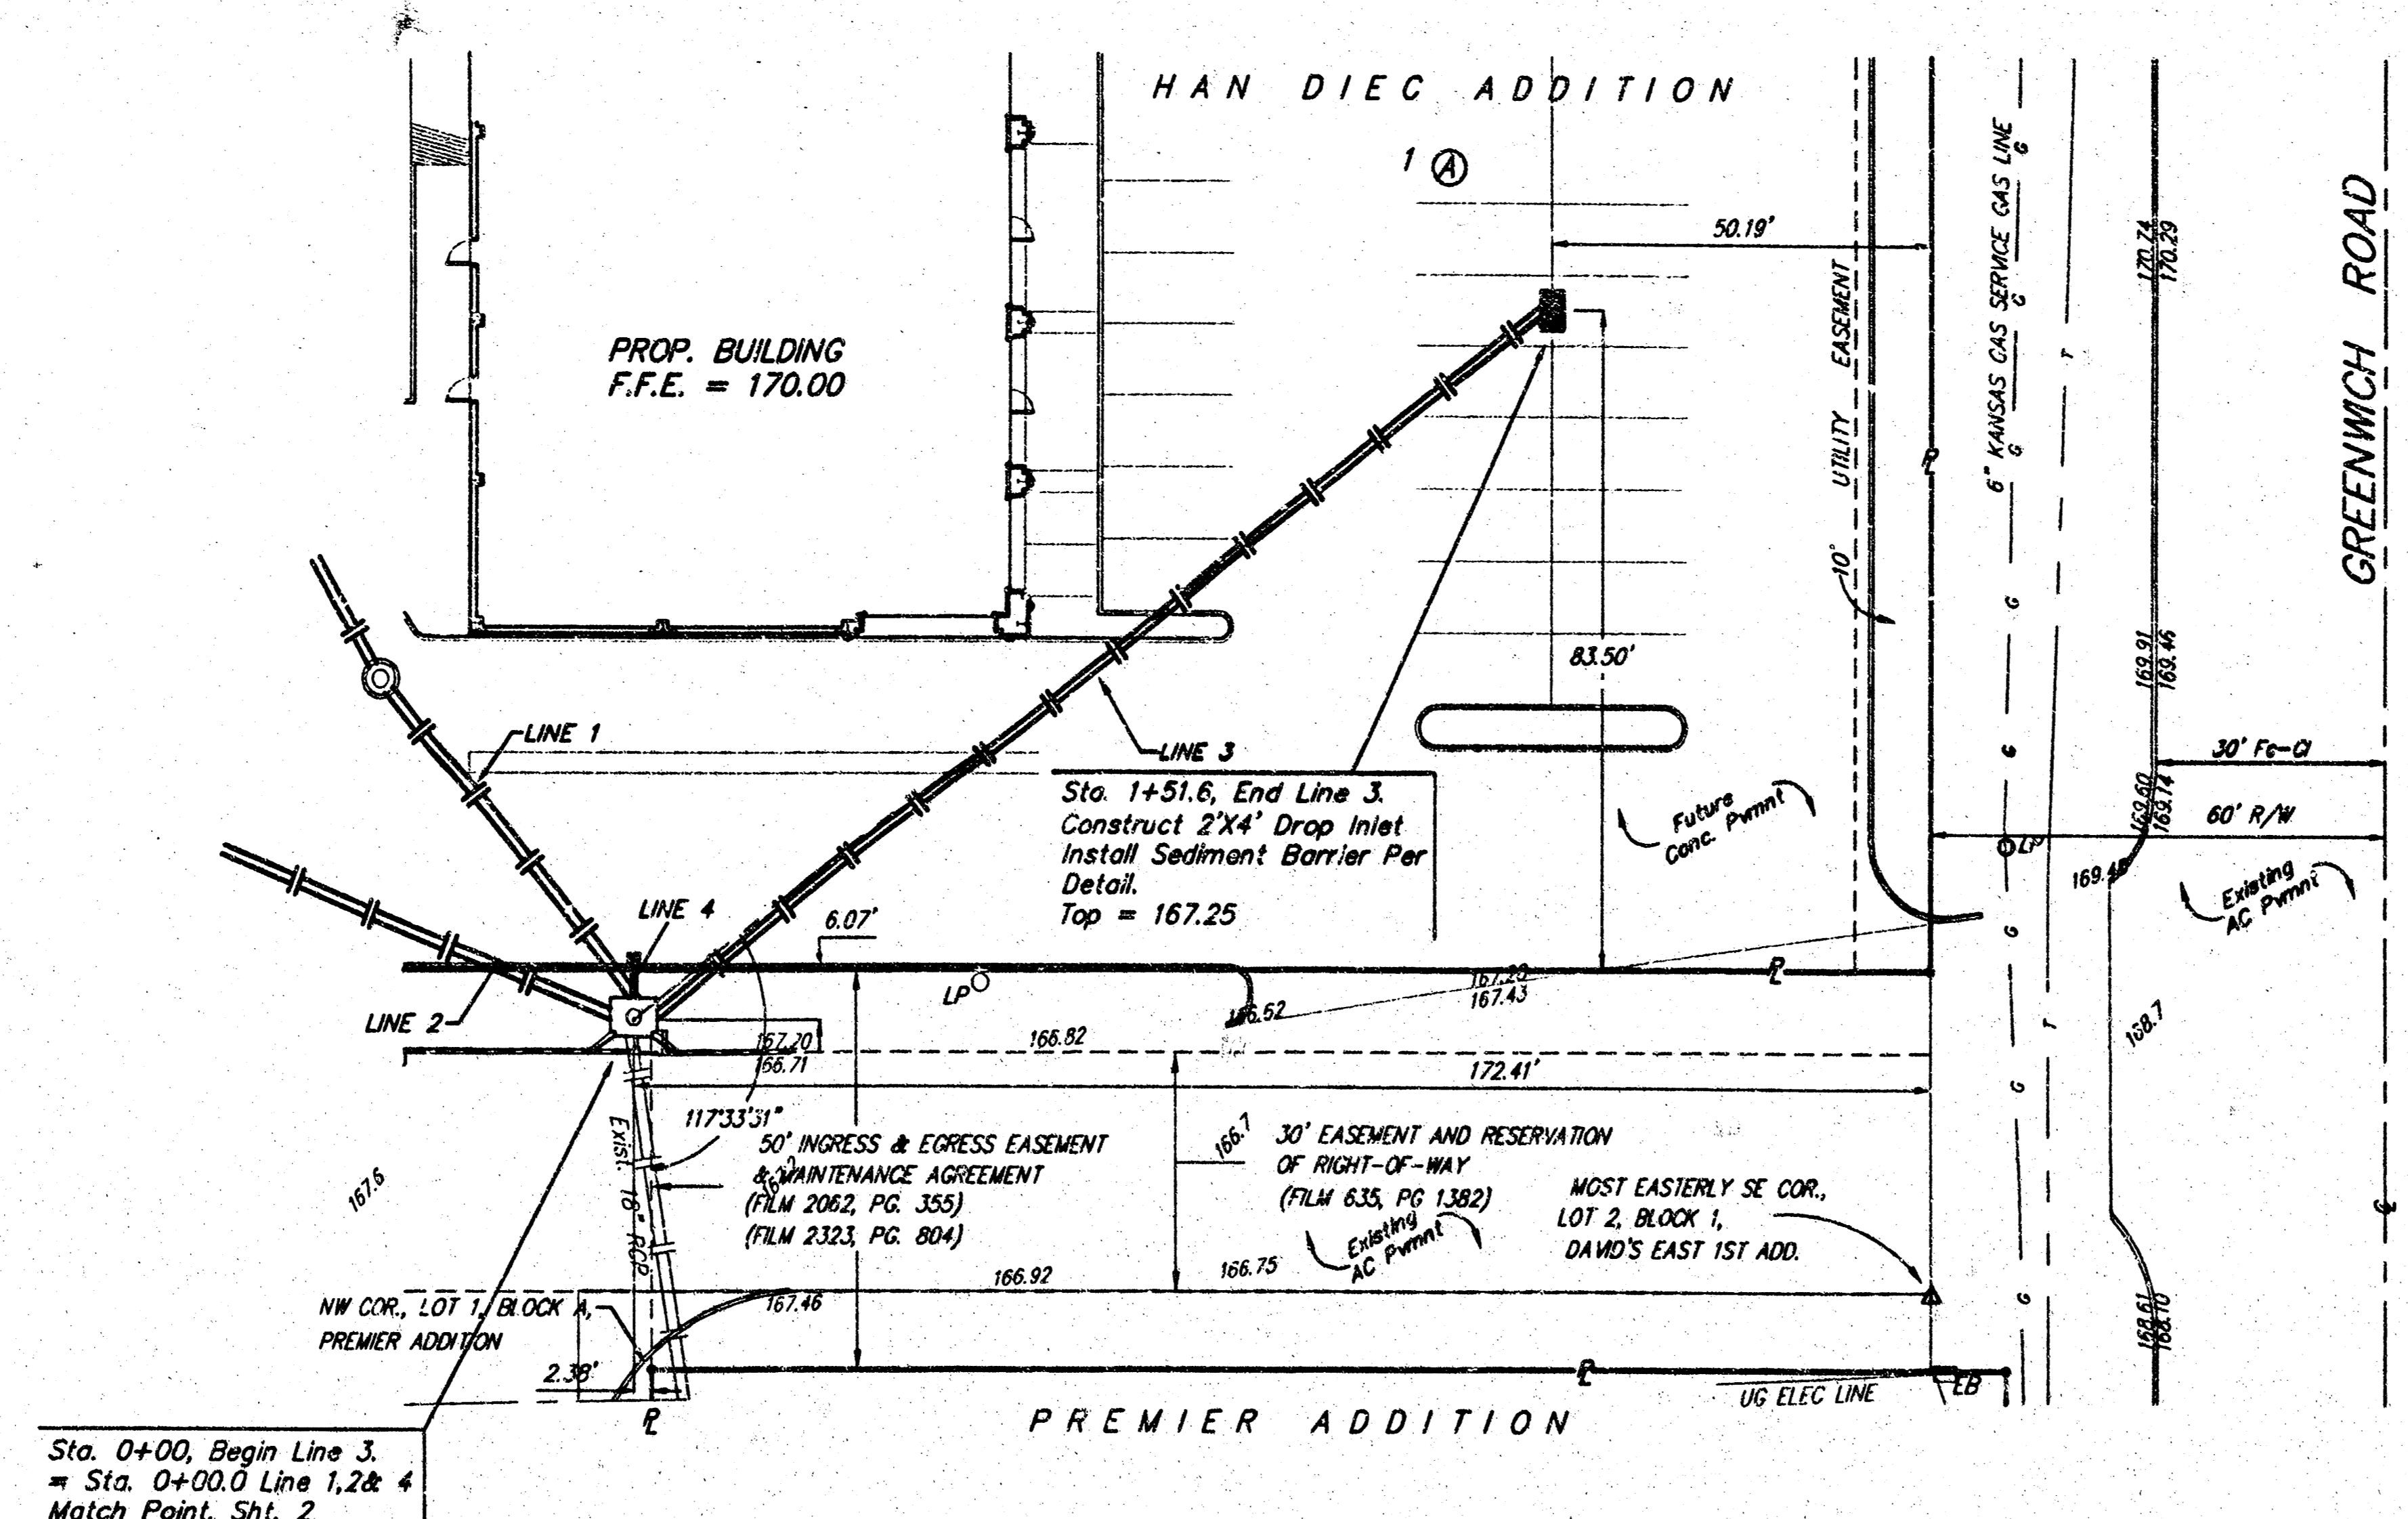


Scale:  
 1" = 20' Horizontal  
 1" = 5' Vertical  
 • = Iron

Sta. 0+00, Begin Line 3.  
 = Sta. 0+00.0 Line 1, 2 & 4  
 Match Point, Sht. 2

As Built 11/21/04 K.V.

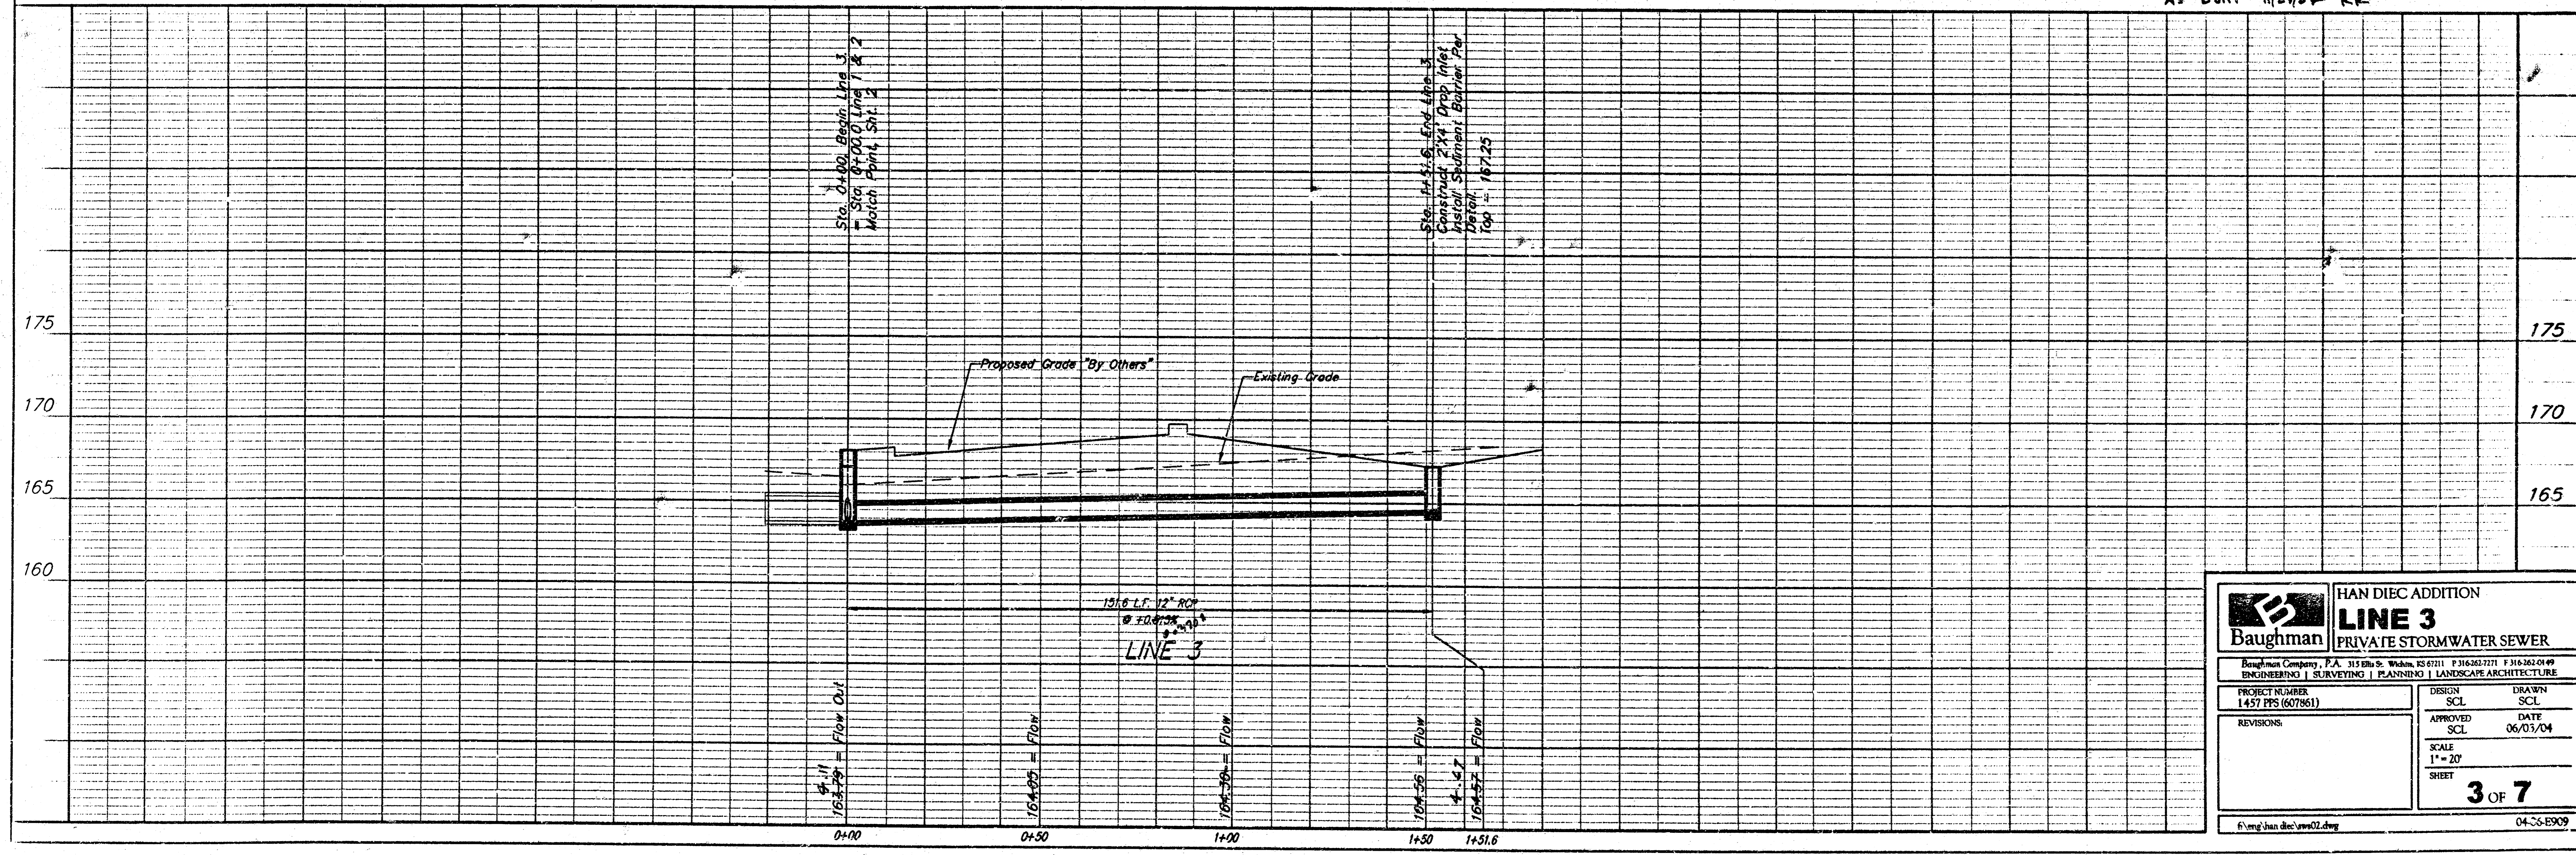


<b>Baughman</b>		HAN DIEC ADDITION	
PROJECT NUMBER 1457 PPS (607861)		DESIGN SCL	
APPROVED SCL		DRAWN SCL	
DATE 06/03/04		DATE 06/03/04	
SCALE 1" = 20'		SCALE 1" = 20'	
SHEET 3 OF 7		SHEET 3 OF 7	

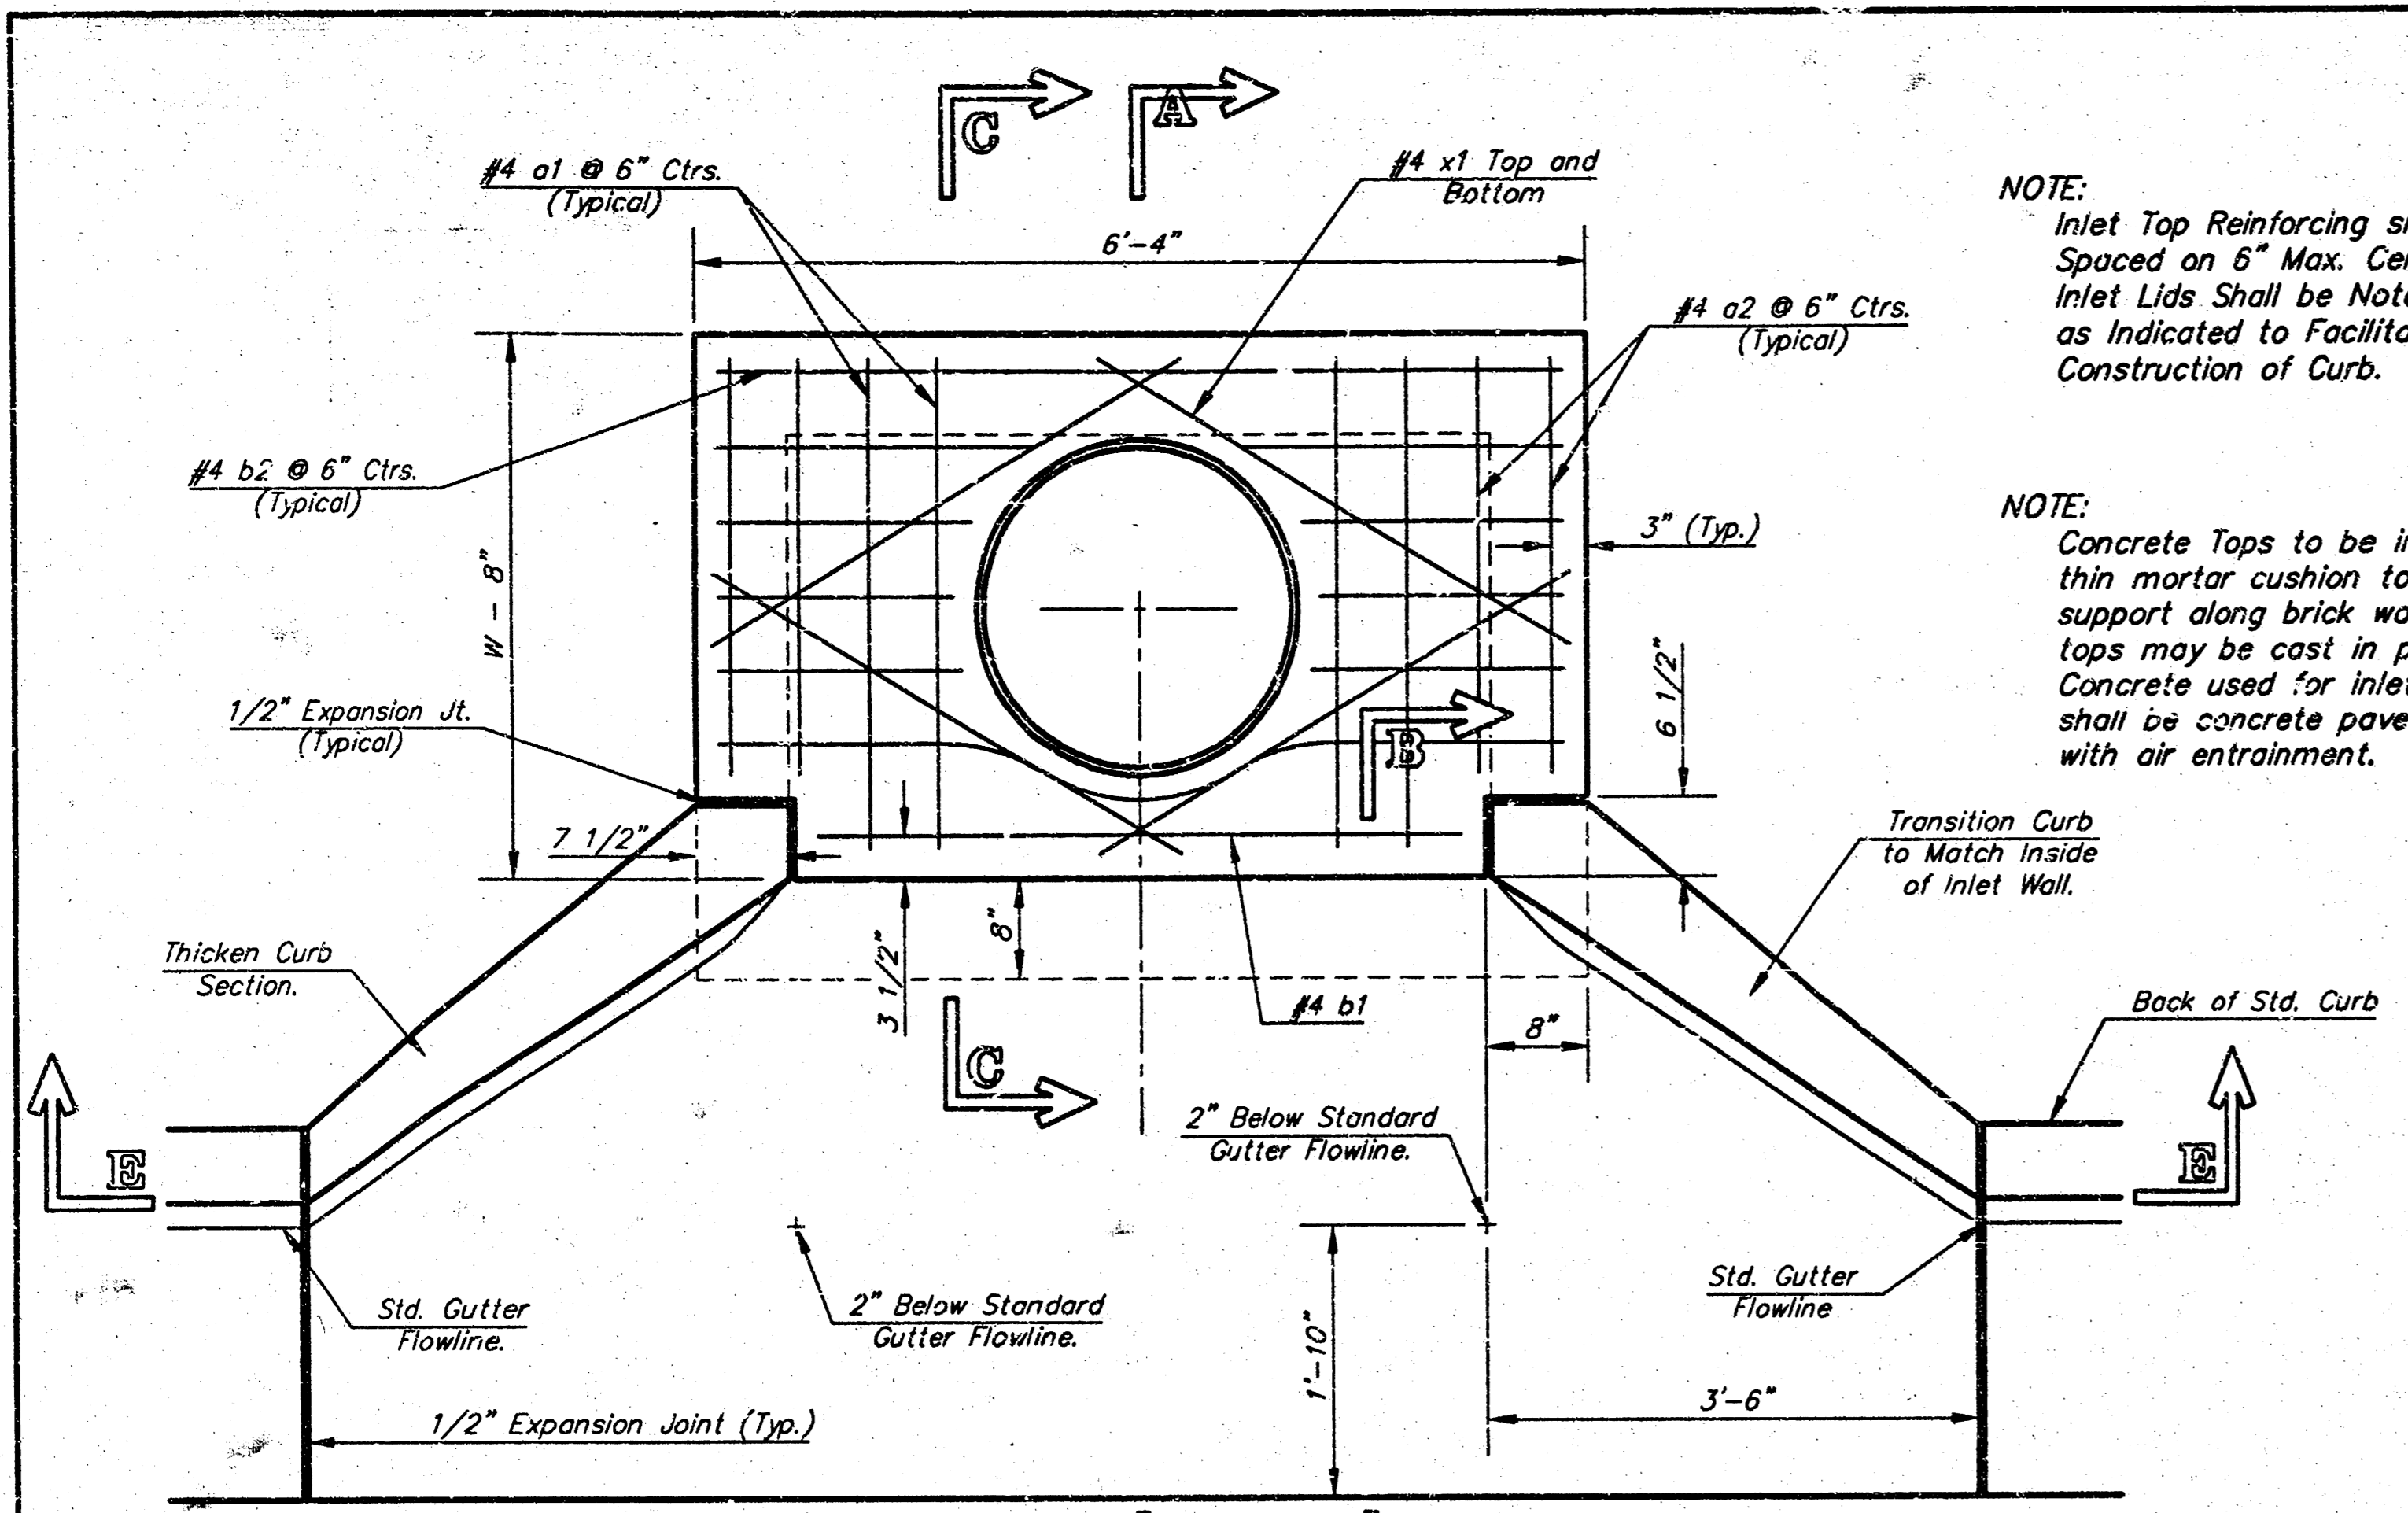


NOTE: Expansion Joint Only in Curb Area With Concrete Pavement.

PLAN

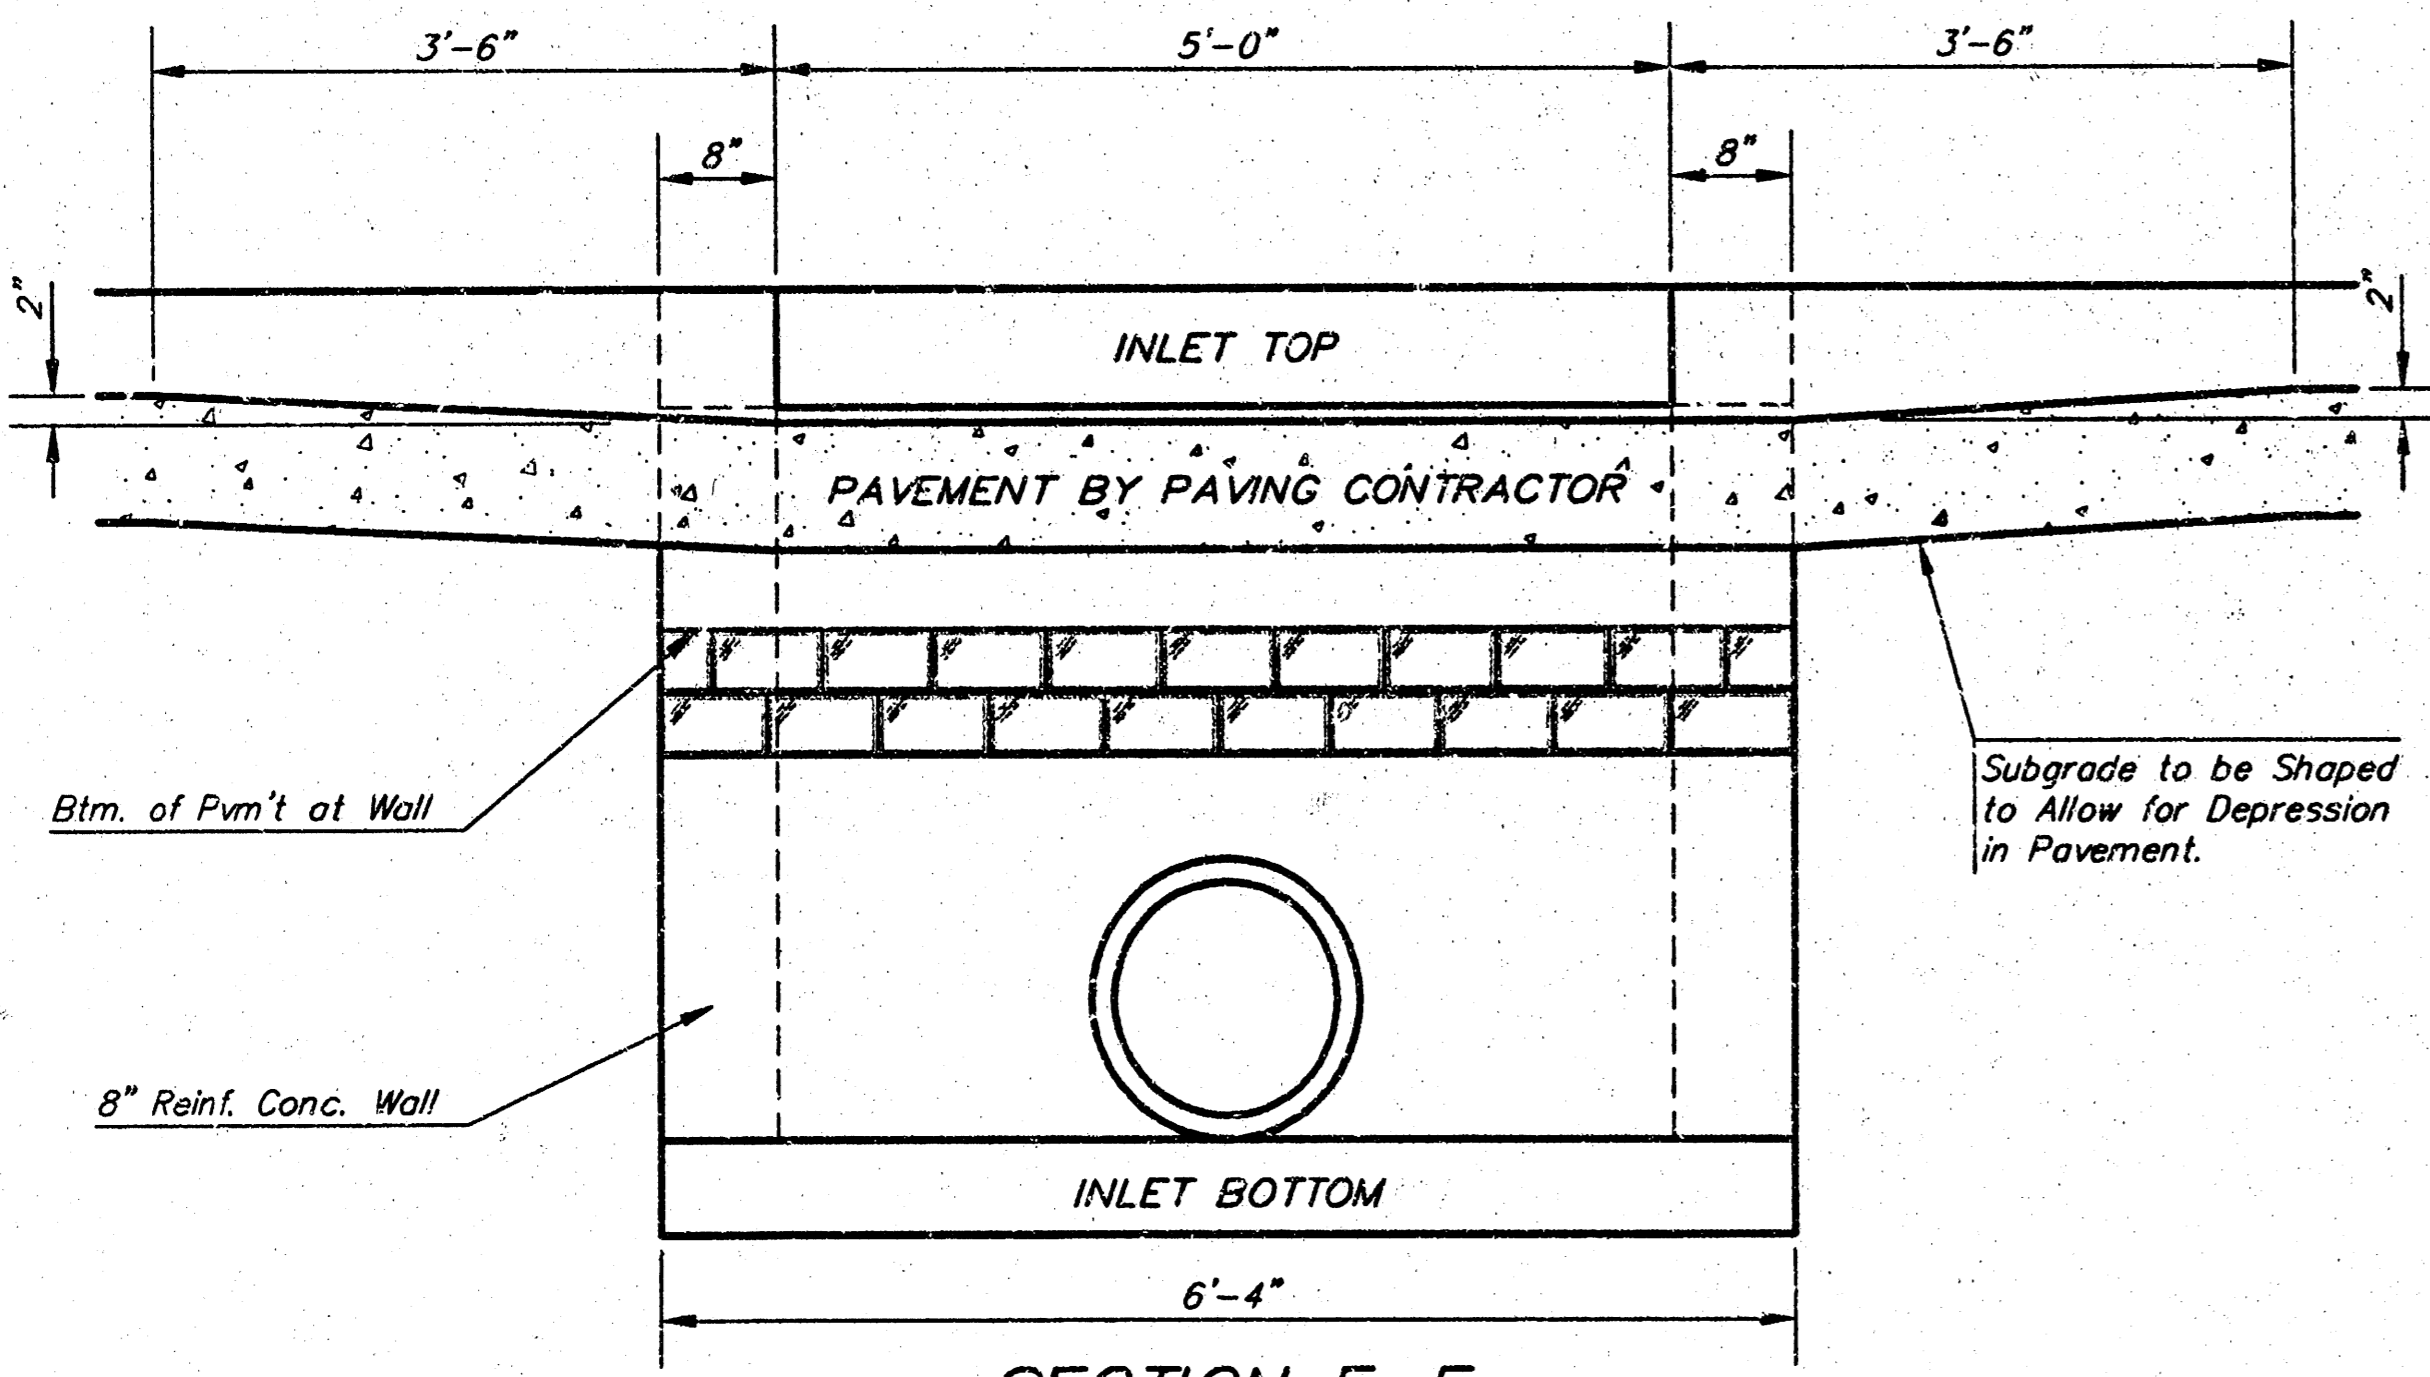

SECTION E-E

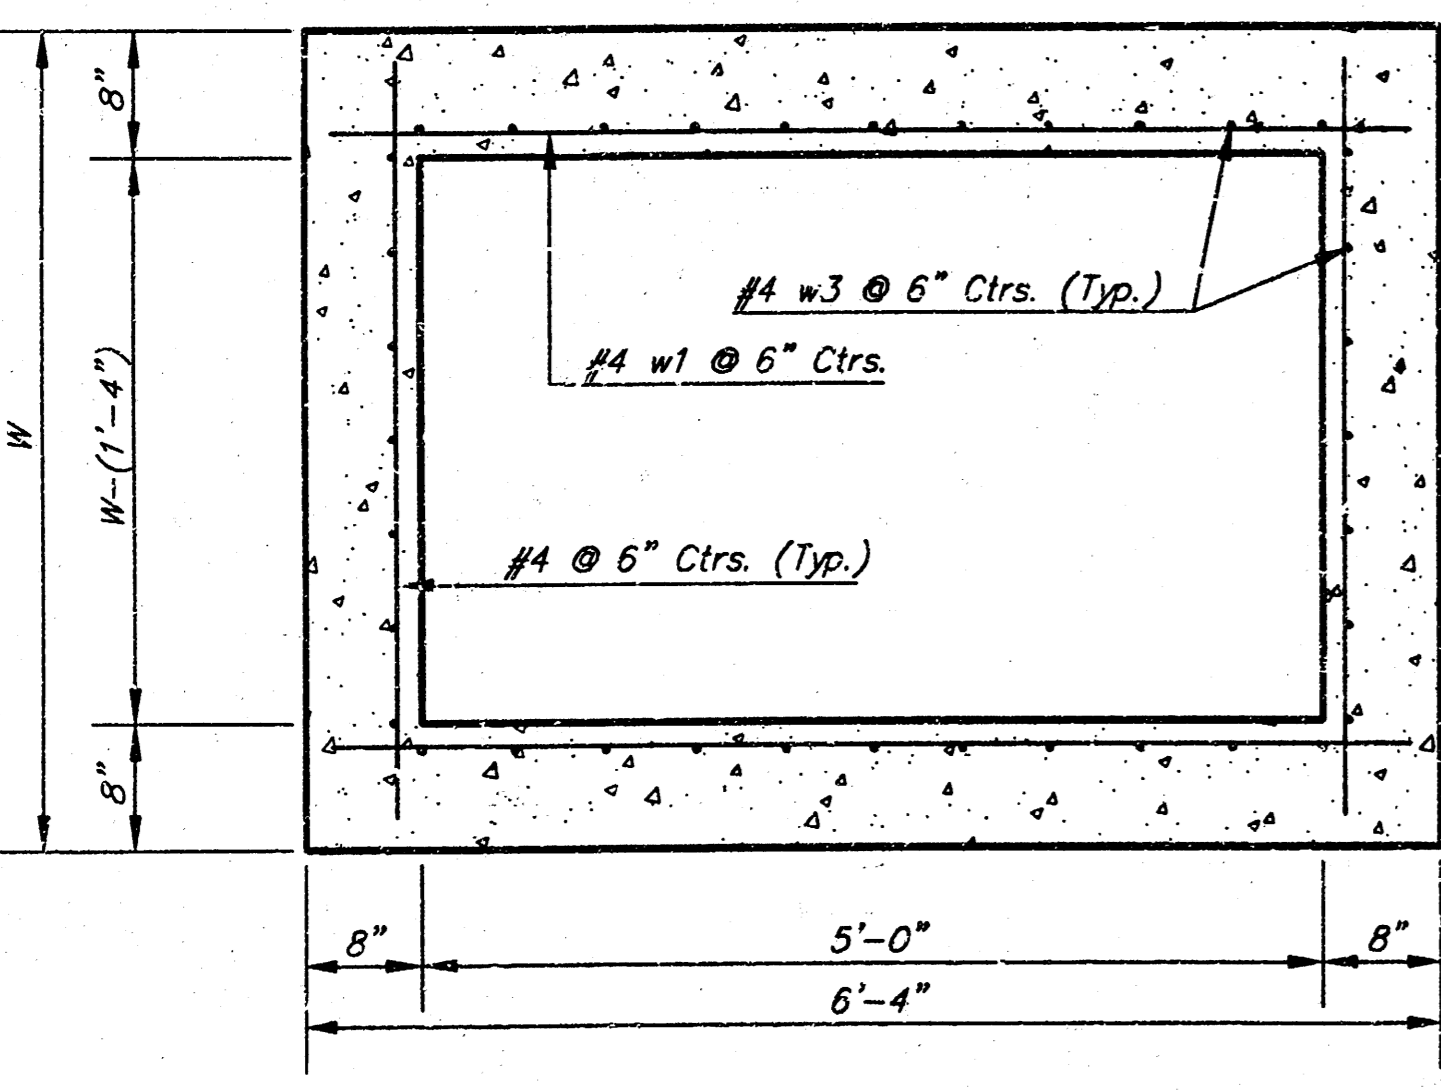

SECTION D-D

NOTE: Contractor shall have the option of constructing 8\"/>

Additional curb and gutter construction necessary to connect set-back inlet to pavement will be paid for at the unit price bid for each inlet hookup.


Inlet invert shall be shaped with 8 sack sand mix concrete to create flow channels and to increase hydraulic efficiency such that the inlet will be self-cleaning between all inlet and/or outlet pipes.

The ends of all pipes installed in inlets shall be cut off flush with the inside face of the inlet wall

NOTE: Inlet Top Reinforcing shall be Spaced on 6\"/>


Inlet Lids Shall be Notched Out as Indicated to Facilitate Construction of Curb.

NOTE: Concrete Tops to be installed on thin mortar cushion to insure full support along brick walls. Concrete tops may be cast in place or precast. Concrete used for inlet construction shall be concrete pavement mix with air entrainment.

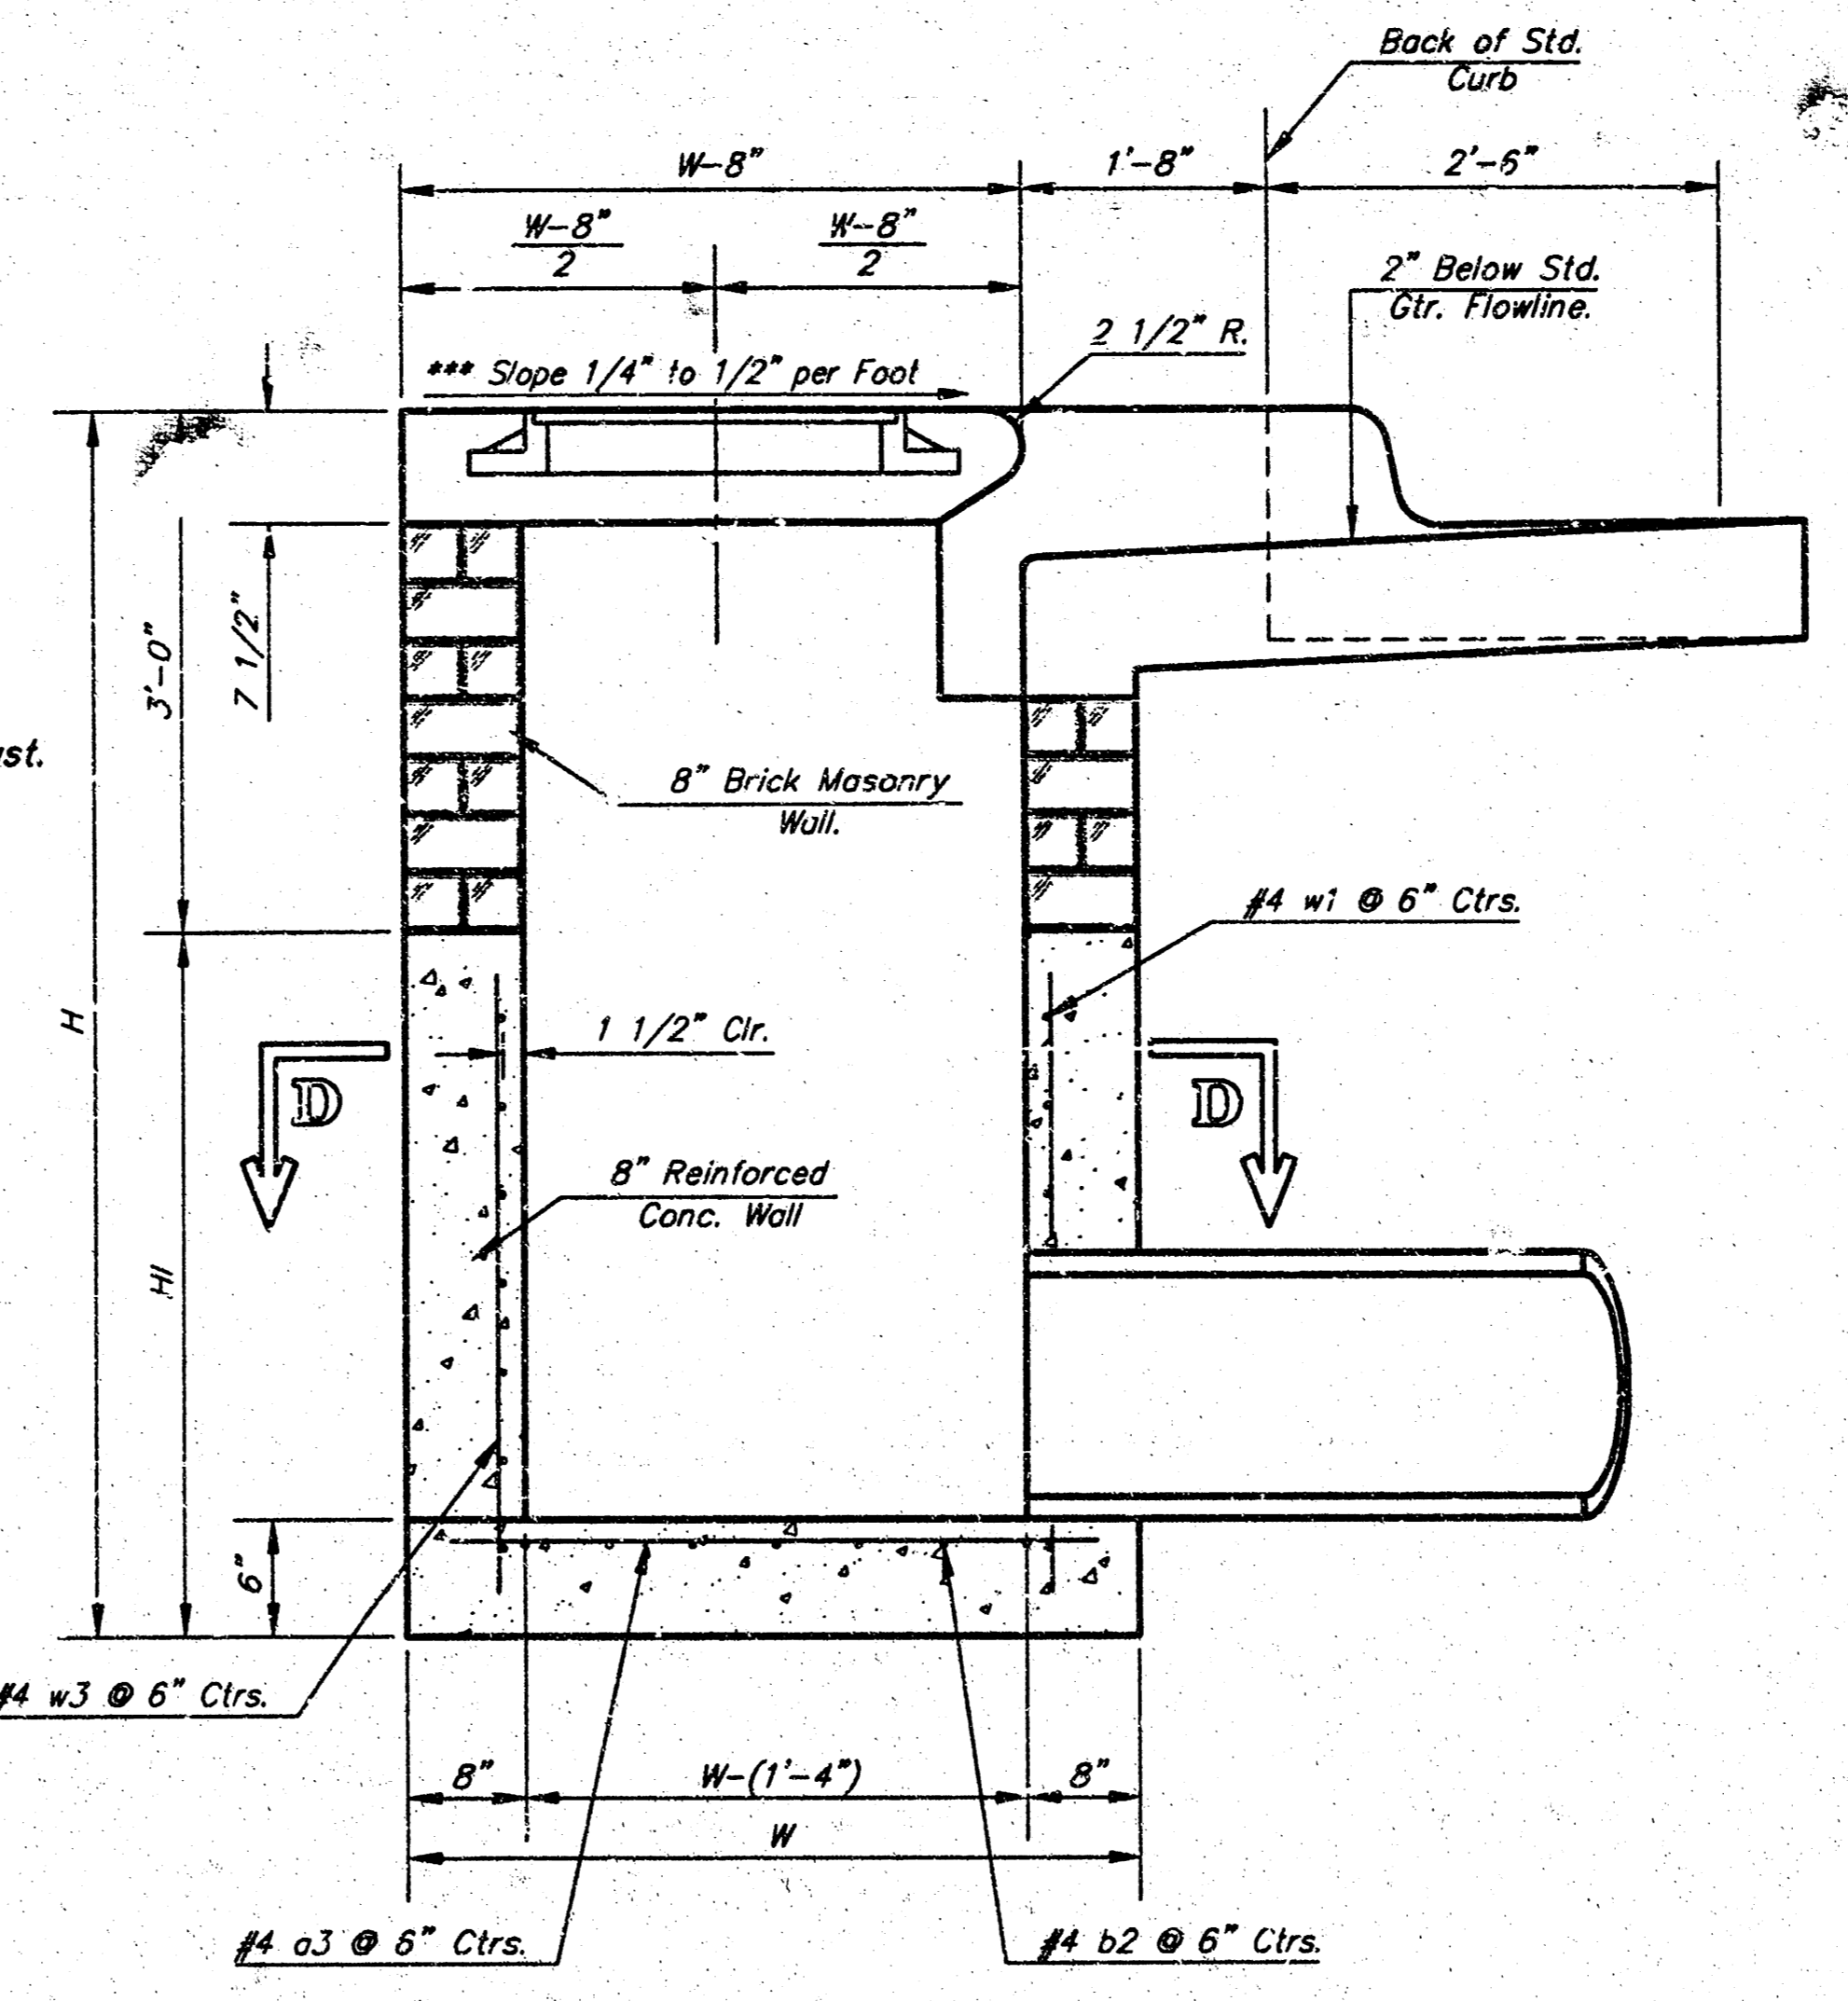


SECTION A-A

NOTE: Slope of Inlet tops to Match Sidewalk or Parking Slopes within Limits Indicated.

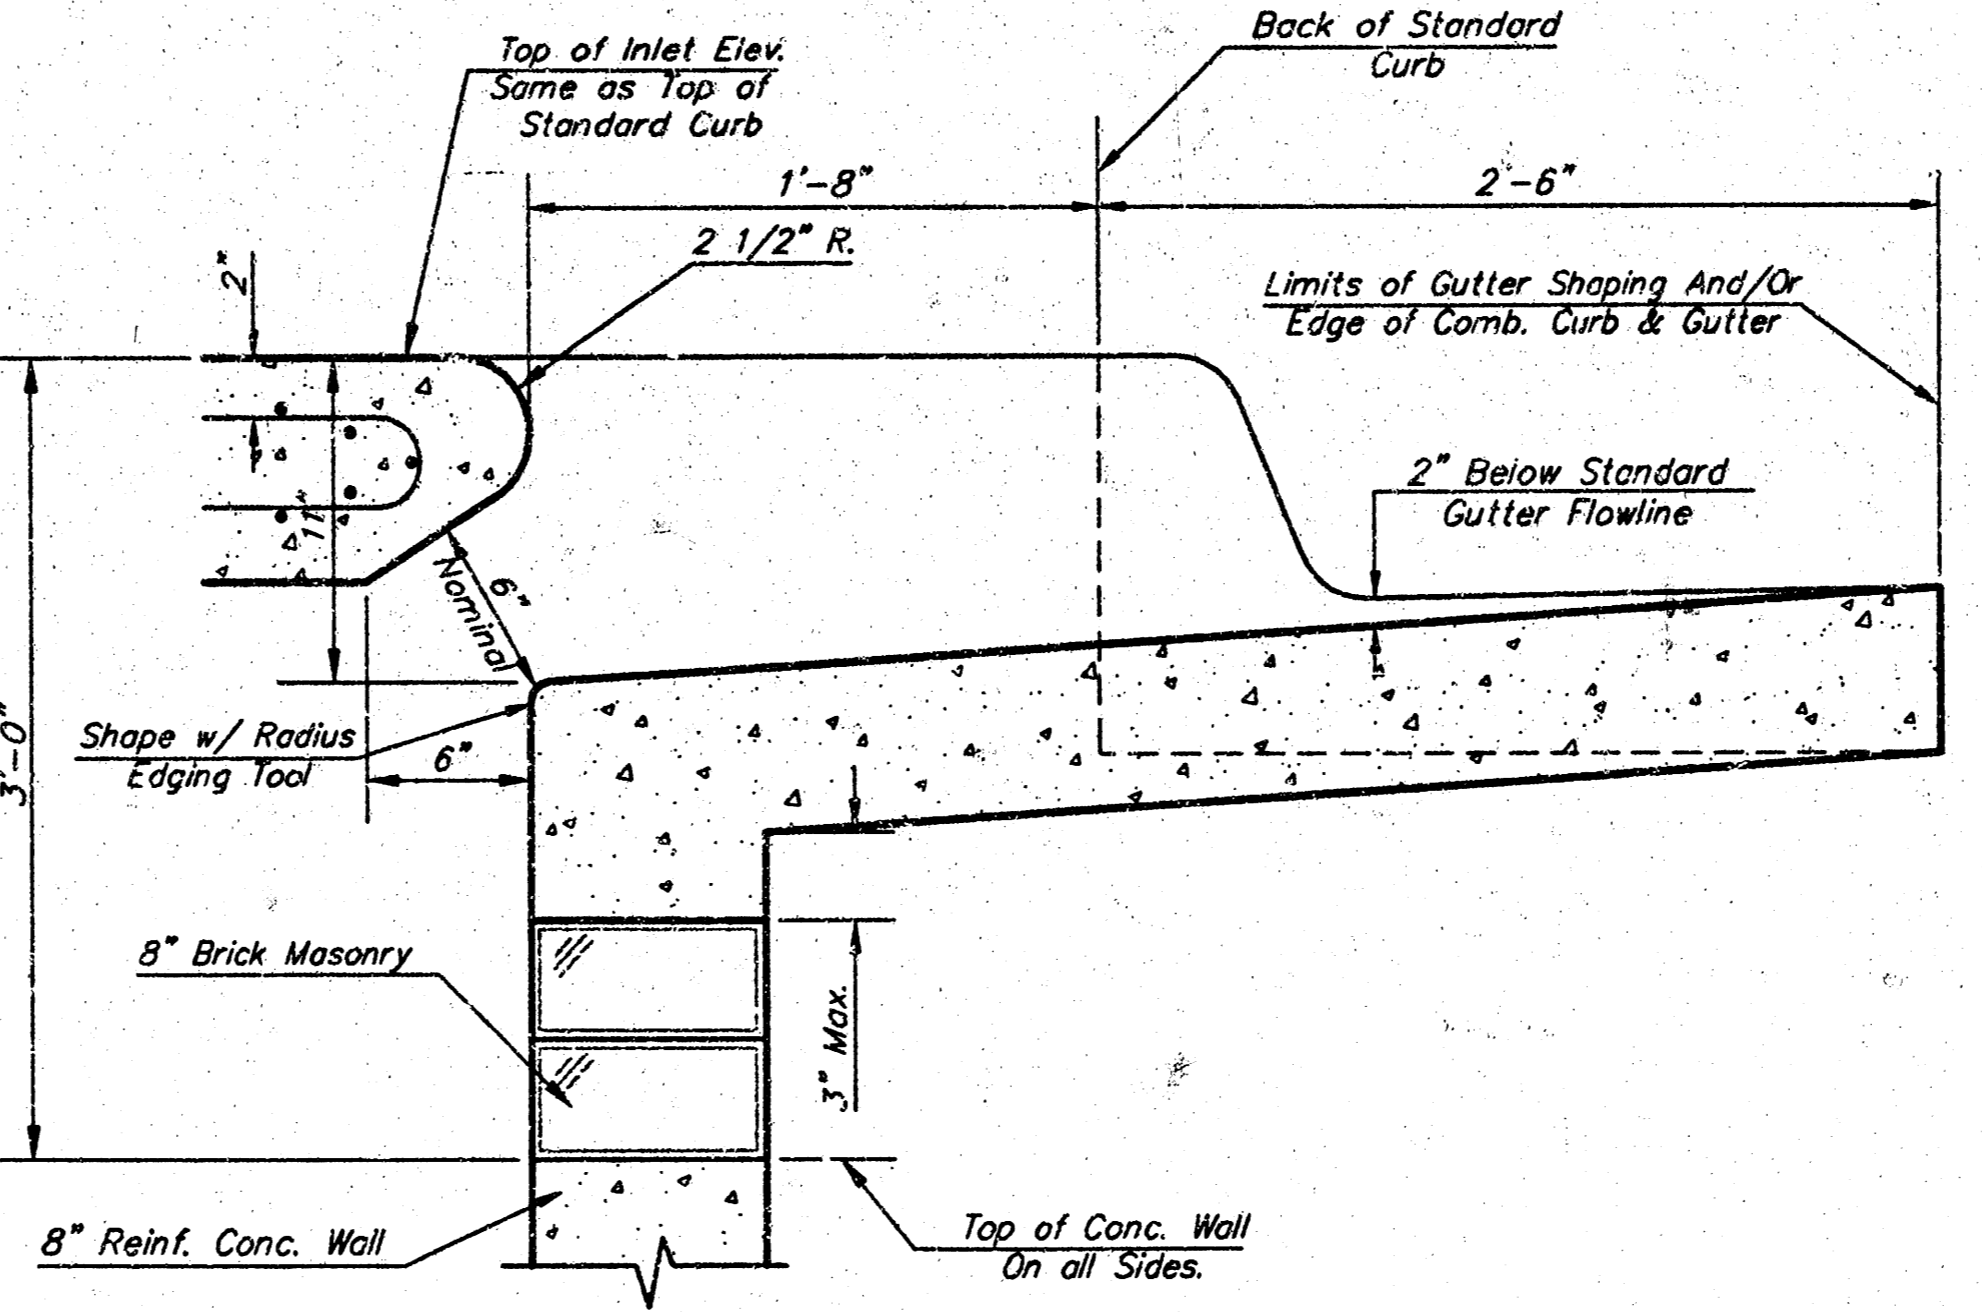


SECTION B-B

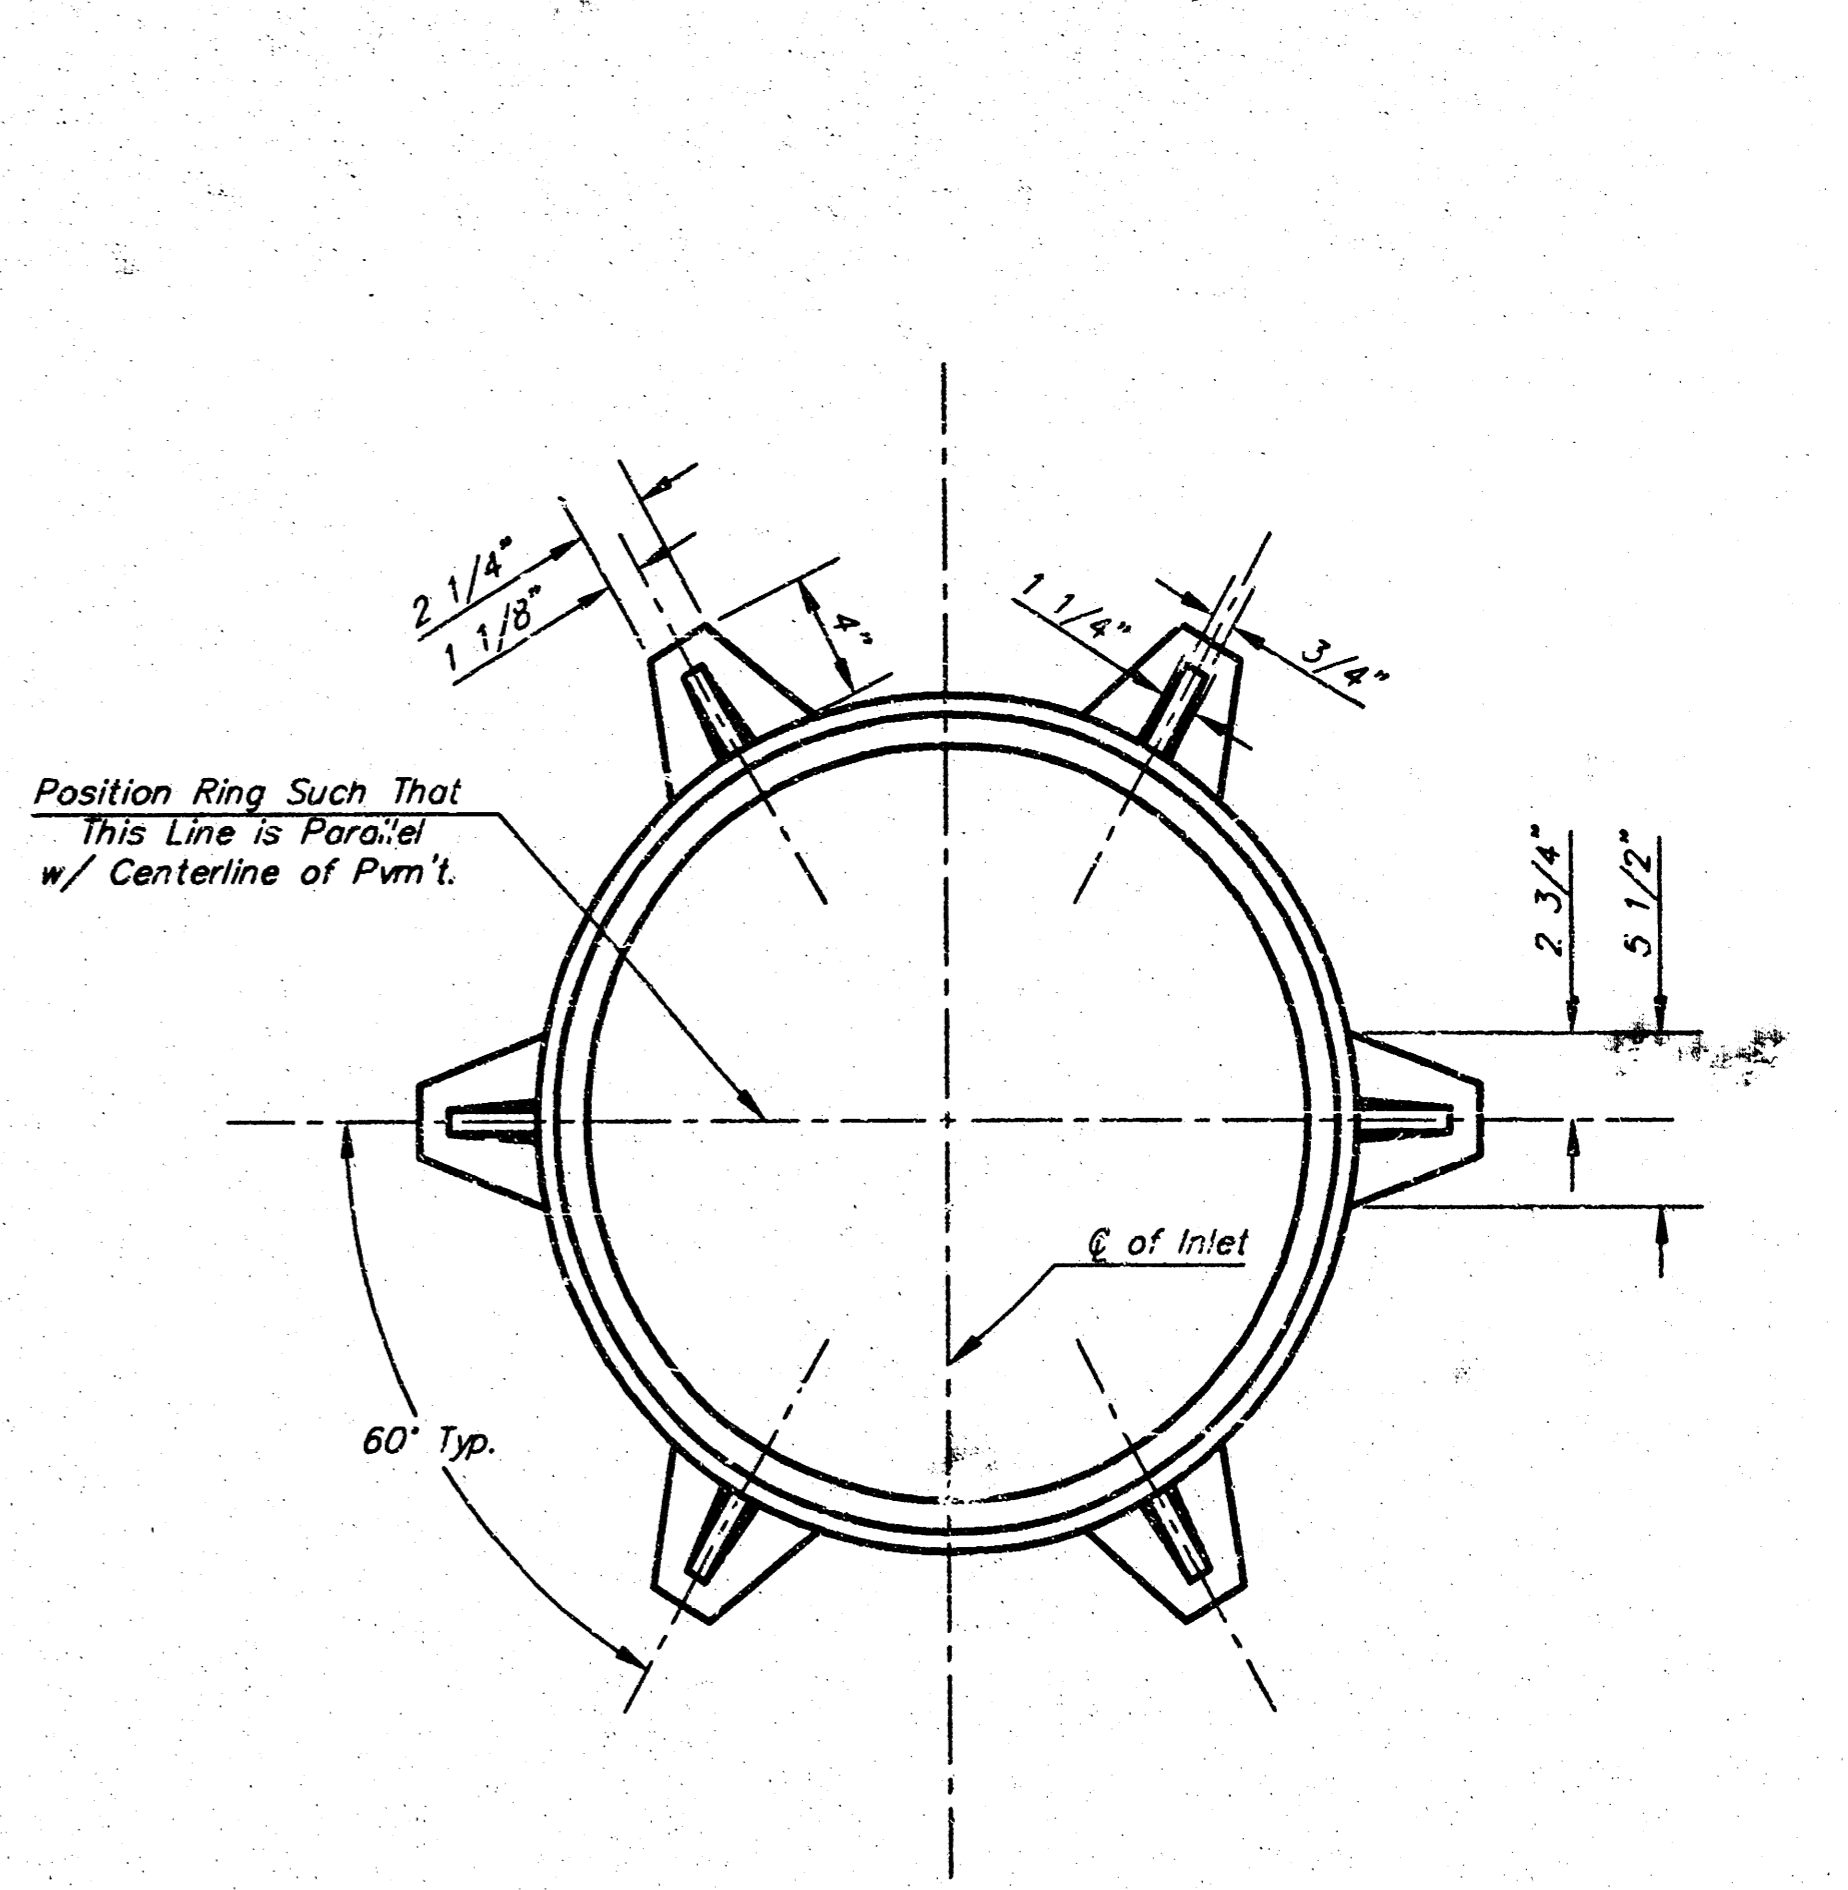

MANHOLE RING AND COVER

Weight = 180 Lbs.  
 \*See City of Wichita Standard Manhole Ring and Cover Detail Sheet for Cover Details to Be Used With Inlet Frame.

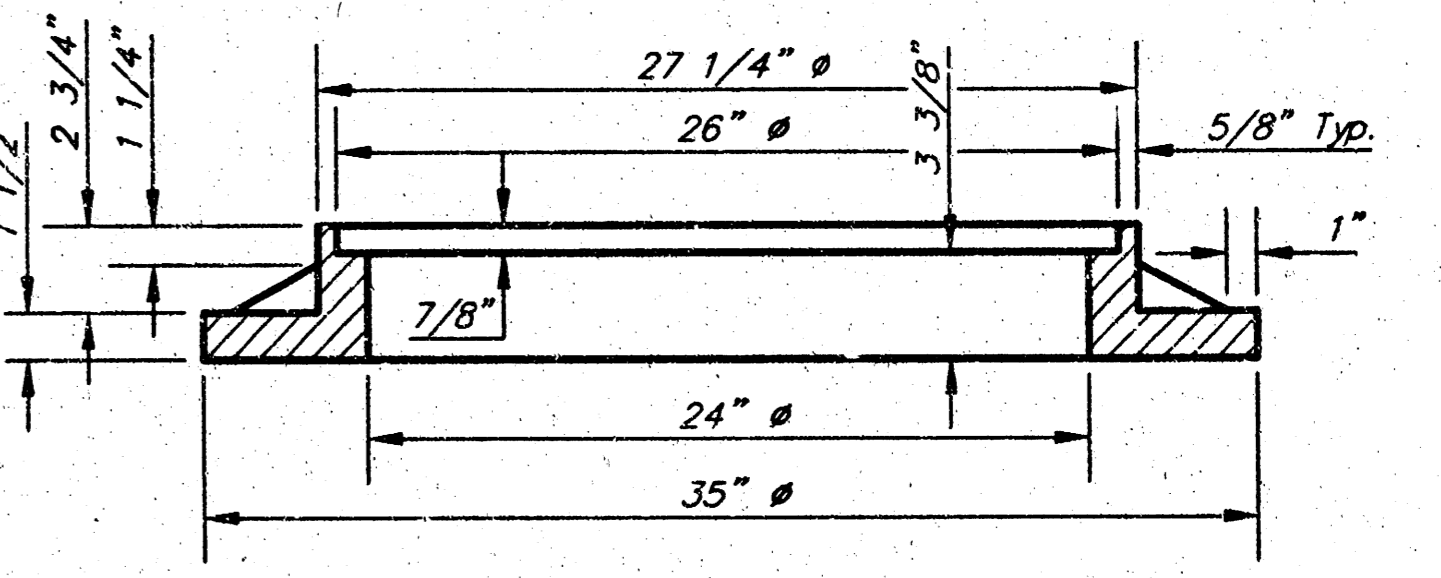


SECTION C-C

PRECAST SLAB AND FLOOR REINFORCING											
MARK	SIZE	W = 4'-4"		W = 5'-4"		W = 6'-4"		W = 7'-4"		W = 8'-4"	
		NO.	LENGTH	NO.	LENGTH	NO.	LENGTH	NO.	LENGTH	NO.	LENGTH
a1	#4	6	6'-7"	6	8'-2"	6	10'-7"	6	12'-7"	6	14'-7"
a2	#4	4	6'-0"	4	8'-0"	4	10'-0"	4	12'-0"	4	14'-0"
a3	#4	13	4'-1"	13	5'-1"	13	6'-1"	13	7'-1"	13	8'-1"
b1	#4	7	4'-9"	7	4'-9"	7	4'-9"	7	4'-9"	7	4'-9"
b2	#4	23	6'-1"	29	6'-1"	35	6'-1"	41	6'-1"	47	6'-1"
x1	#4	8	3'-10"	8	4'-2"	8	4'-6"	8	4'-10"	8	5'-2"

WALL REINFORCING											
MARK	SIZE	W = 4'-4"		W = 5'-4"		W = 6'-4"		W = 7'-4"		W = 8'-4"	
		NO.	LENGTH	NO.	LENGTH	NO.	LENGTH	NO.	LENGTH	NO.	LENGTH
w1	#4	1	6'-1"	1	6'-1"	1	6'-1"	1	6'-1"	1	6'-1"
w2	#4	1	4'-1"	1	5'-1"	1	6'-1"	1	7'-1"	1	8'-1"
w3	#4	32	6'-1"	36	6'-1"	40	6'-1"	44	6'-1"	48	6'-1"

\* Field Bend or Cut Reinforcing as Required for Clearance.  
 ① 4 (H - 12") (H - 21") Rounded down to nearest 0.5'  
 ② H - 3"

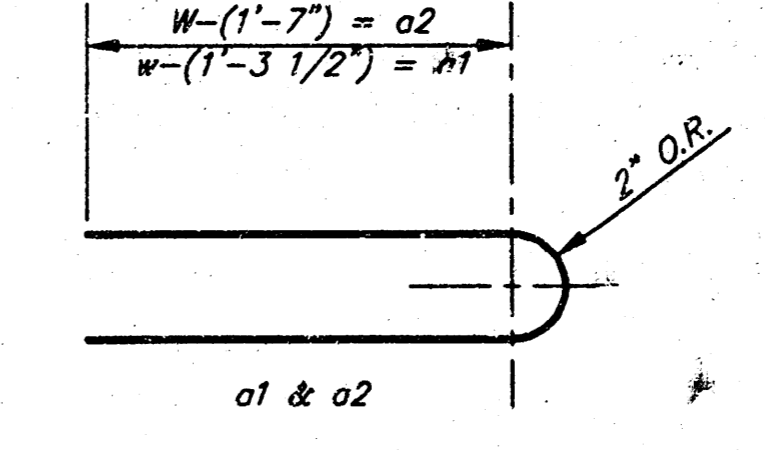

BENDING DIAGRAM

STANDARD CURB INLET PRECAST TOPS			
W	PRE-CAST TOP SIZE	PIPE SIZE	CU. YD. CONC.
4'-4"	3'-8" x 6'-4" x 7 1/2"	21" & SMALLER	0.38±
5'-4"	4'-8" x 6'-4" x 7 1/2"	24" & 30"	0.51±
6'-4"	5'-8" x 6'-4" x 7 1/2"	36" & 42"	0.64±
7'-4"	6'-8" x 6'-4" x 7 1/2"	48" & 54"	0.77±
8'-4"	7'-8" x 6'-4" x 7 1/2"	60" & 66"	0.90±





**Baughman** City of Wichita Standard Type 1A  
**Curb Inlet Details**  
 Inlet Opening = 6' X 50"

Be-John Company, P.A. 315 18th St. Wichita, KS 67211 P 316-263-7271 F 316-263-6749  
 ENGINEERING | SURVEYING | PLANNING | LANDSCAPE ARCHITECTURE

PROJECT NUMBER 1457 PPS (607861)	DESIGN C.O.W.	DRAWN Staff
REVISIONS Revised Feb. 16, 1999	APPROVED	DATE
SCALE None	SHEET	

**4 OF 7**



P:\Eng\Detail\Drawings\Types\1A.dwg 04-06-F909

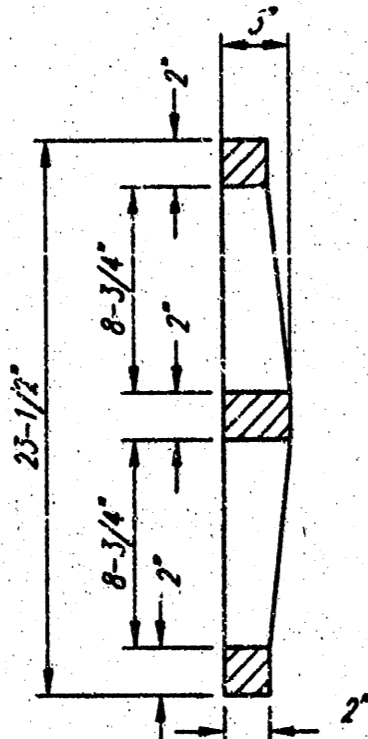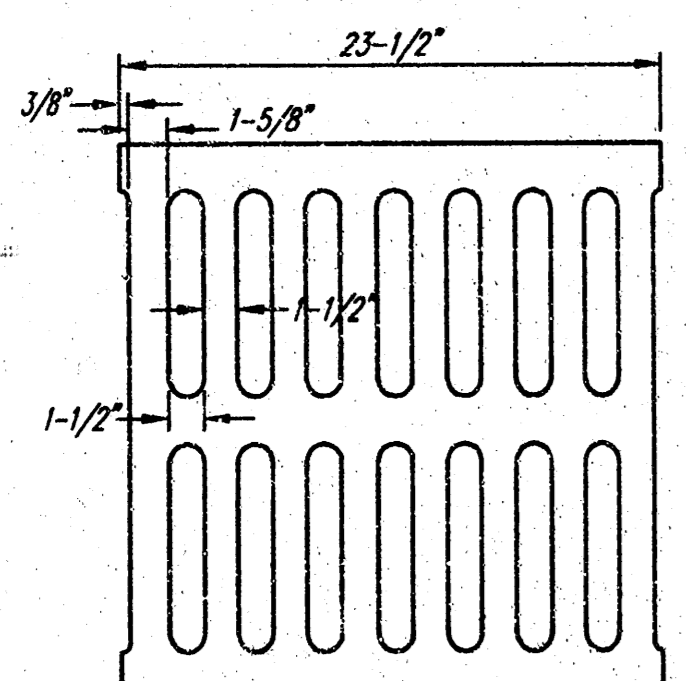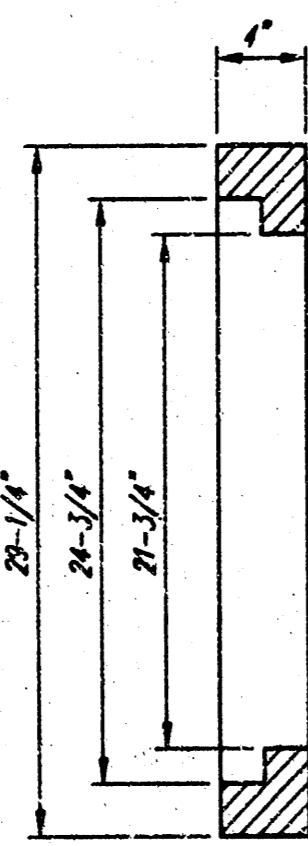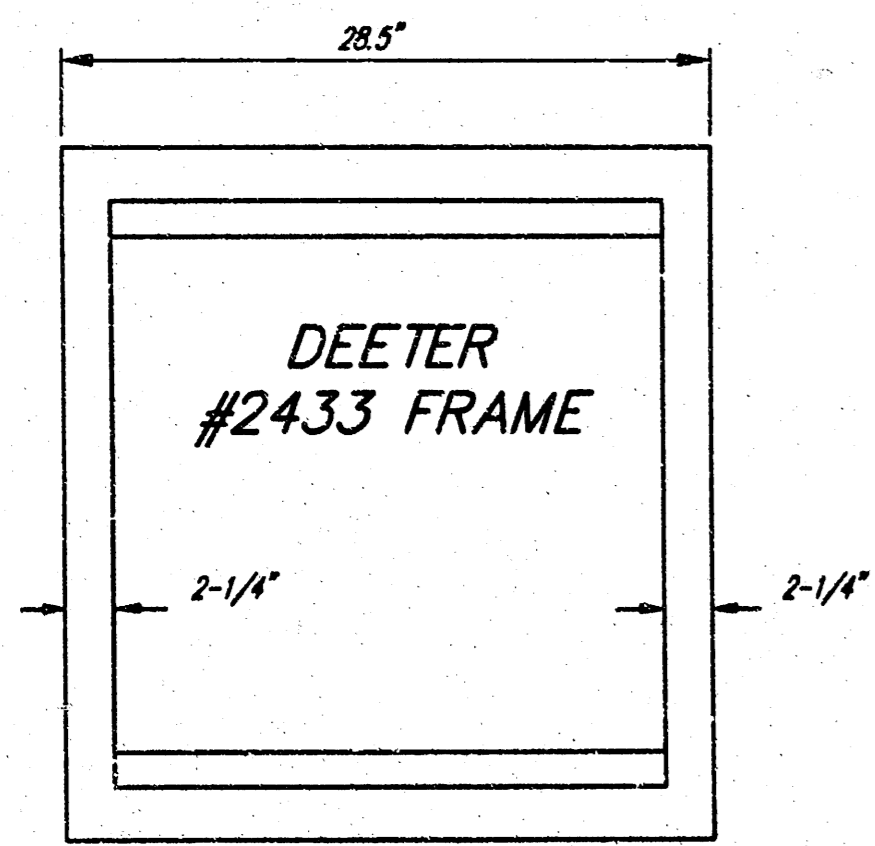




DEETER #2433 GRATE

24" x 24" Frame and Grate Detail


NOTE: Grates shall be imprinted on the top surface with "CITY OF WICHITA" using letters at least 1" in height. Other marking methods may be approved by the engineer.

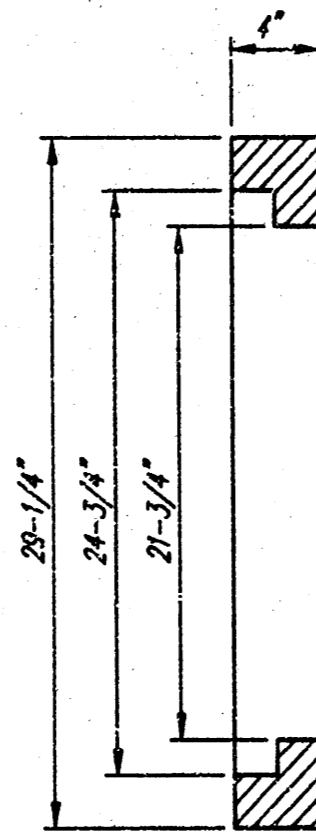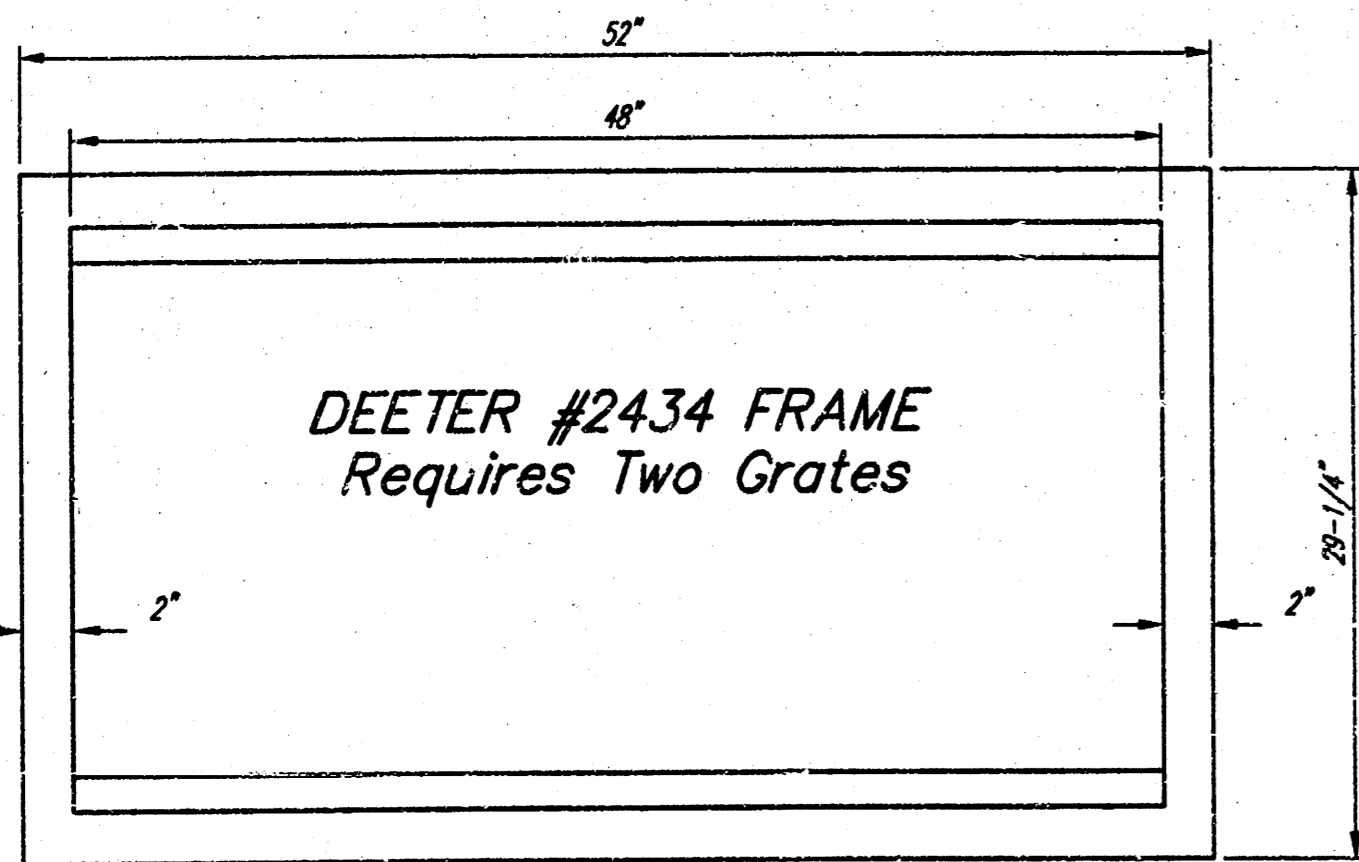

Double 24" x 24" Frame Detail

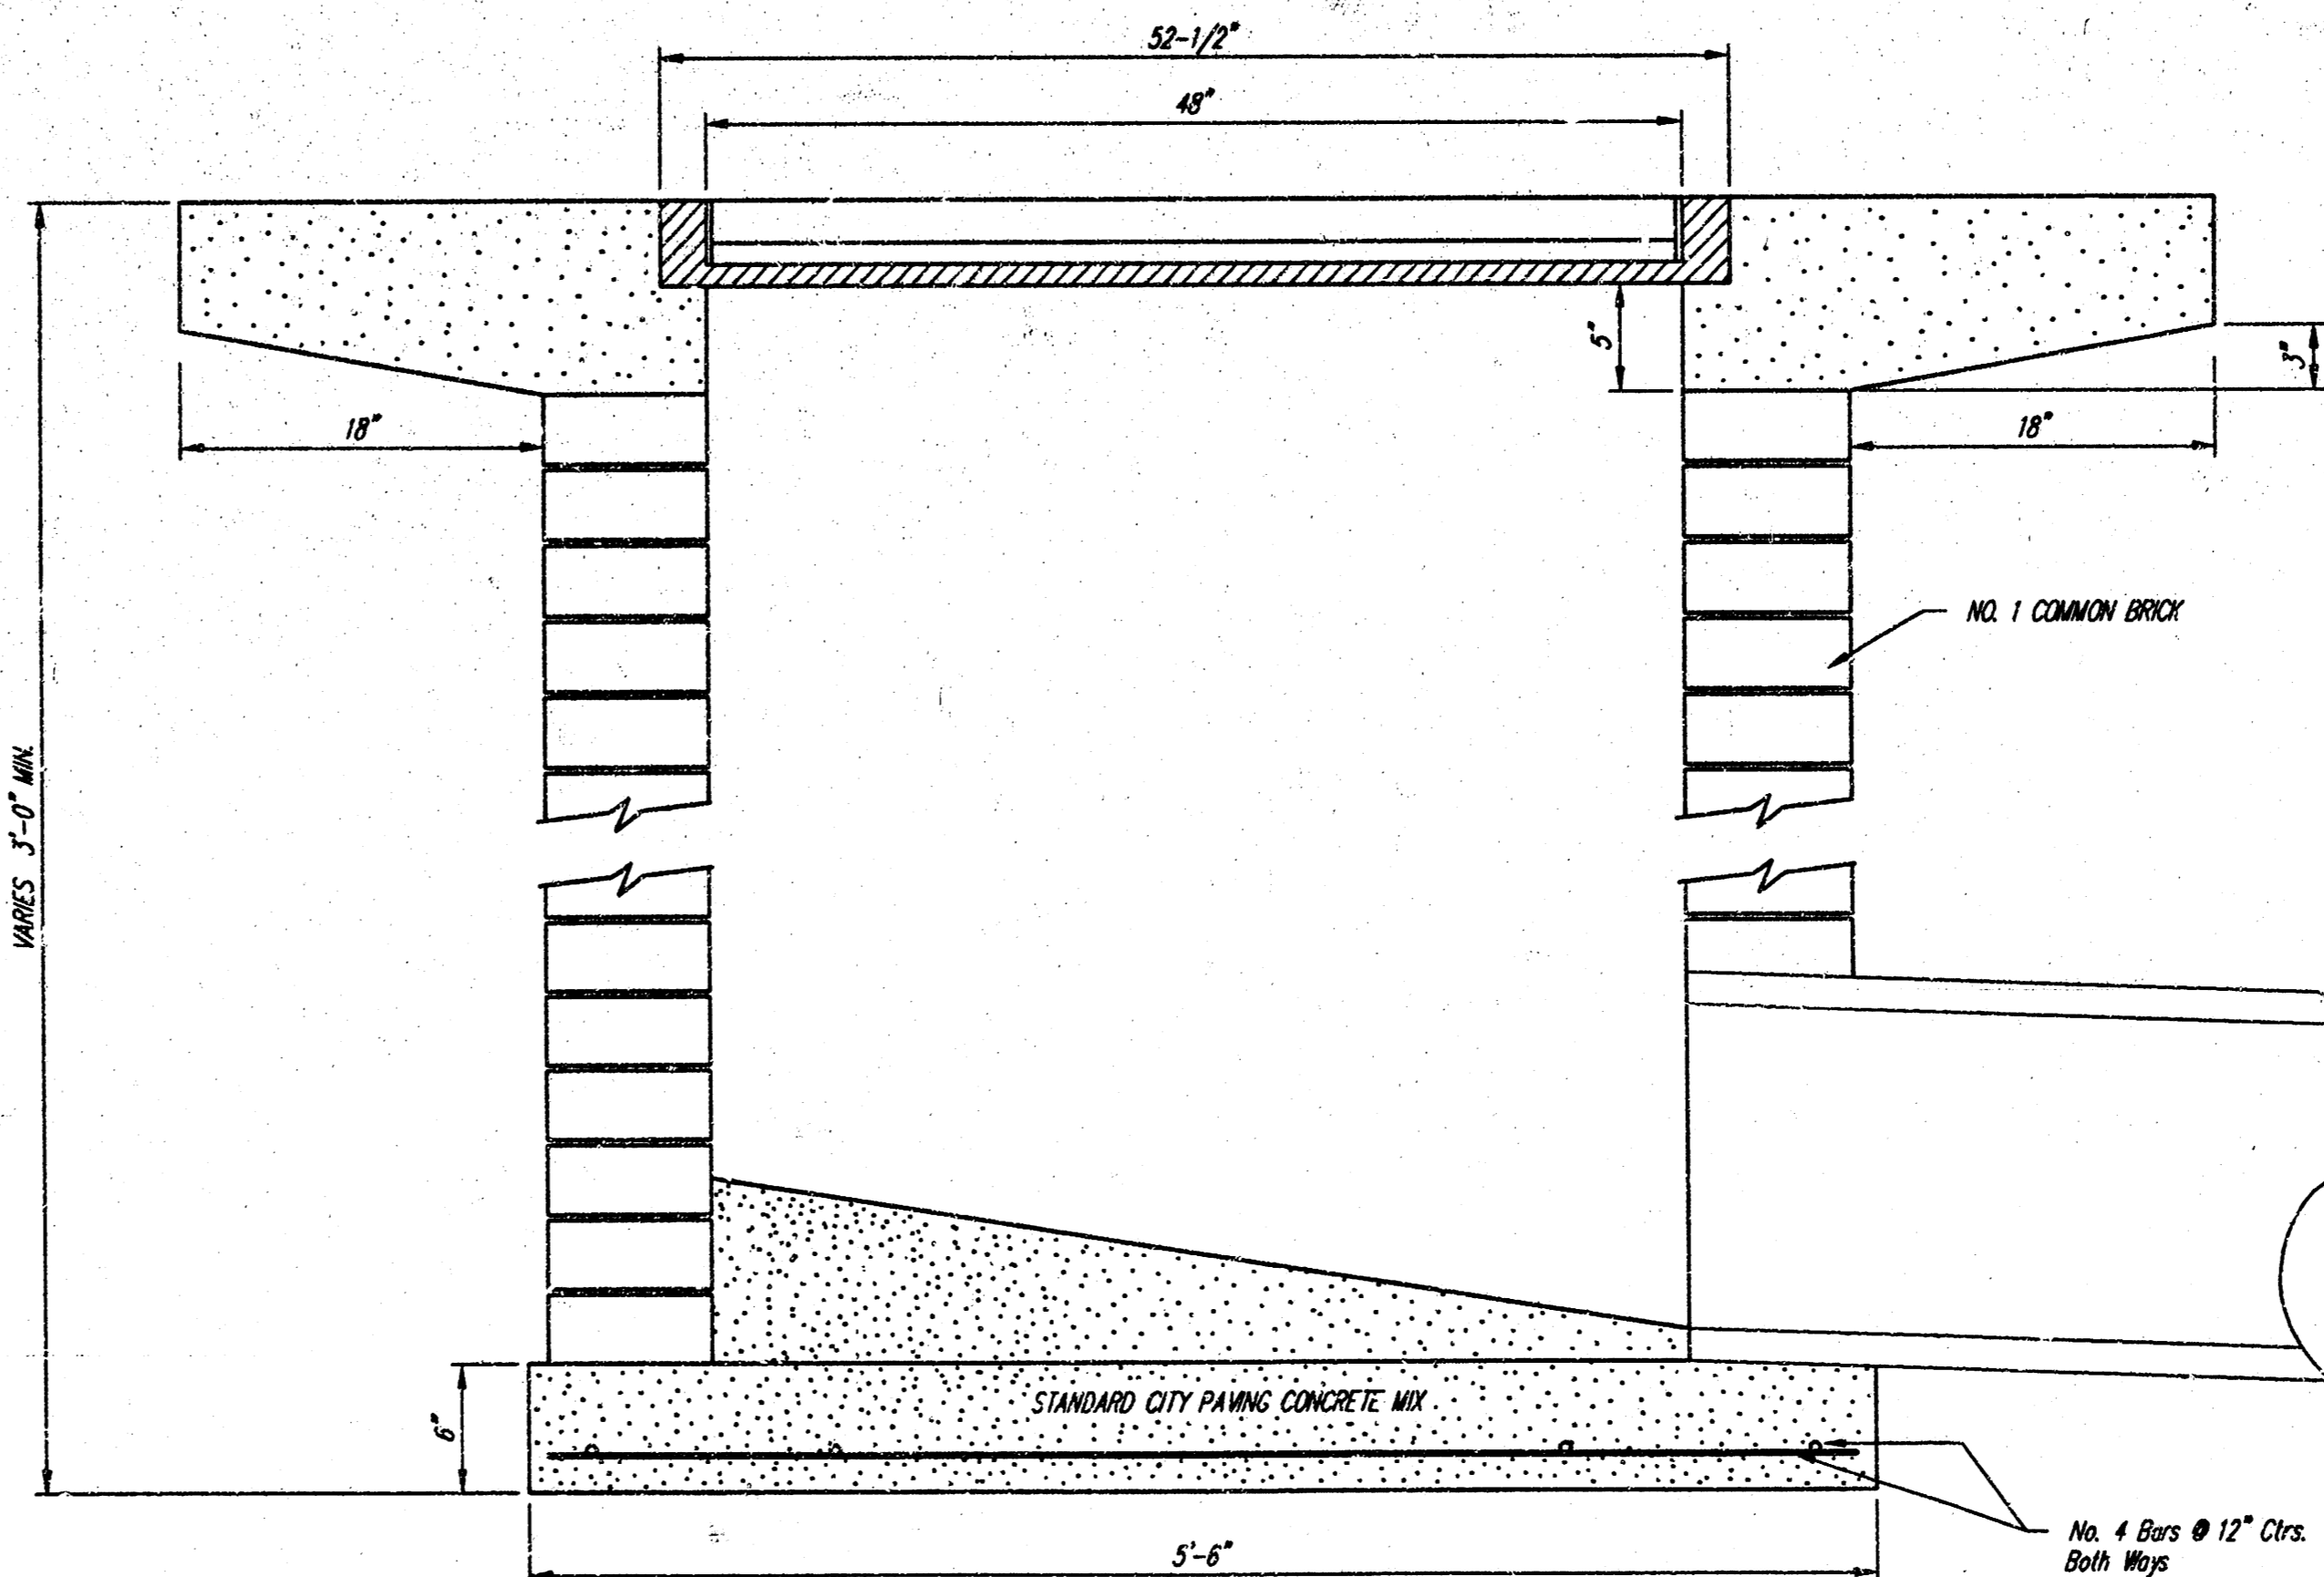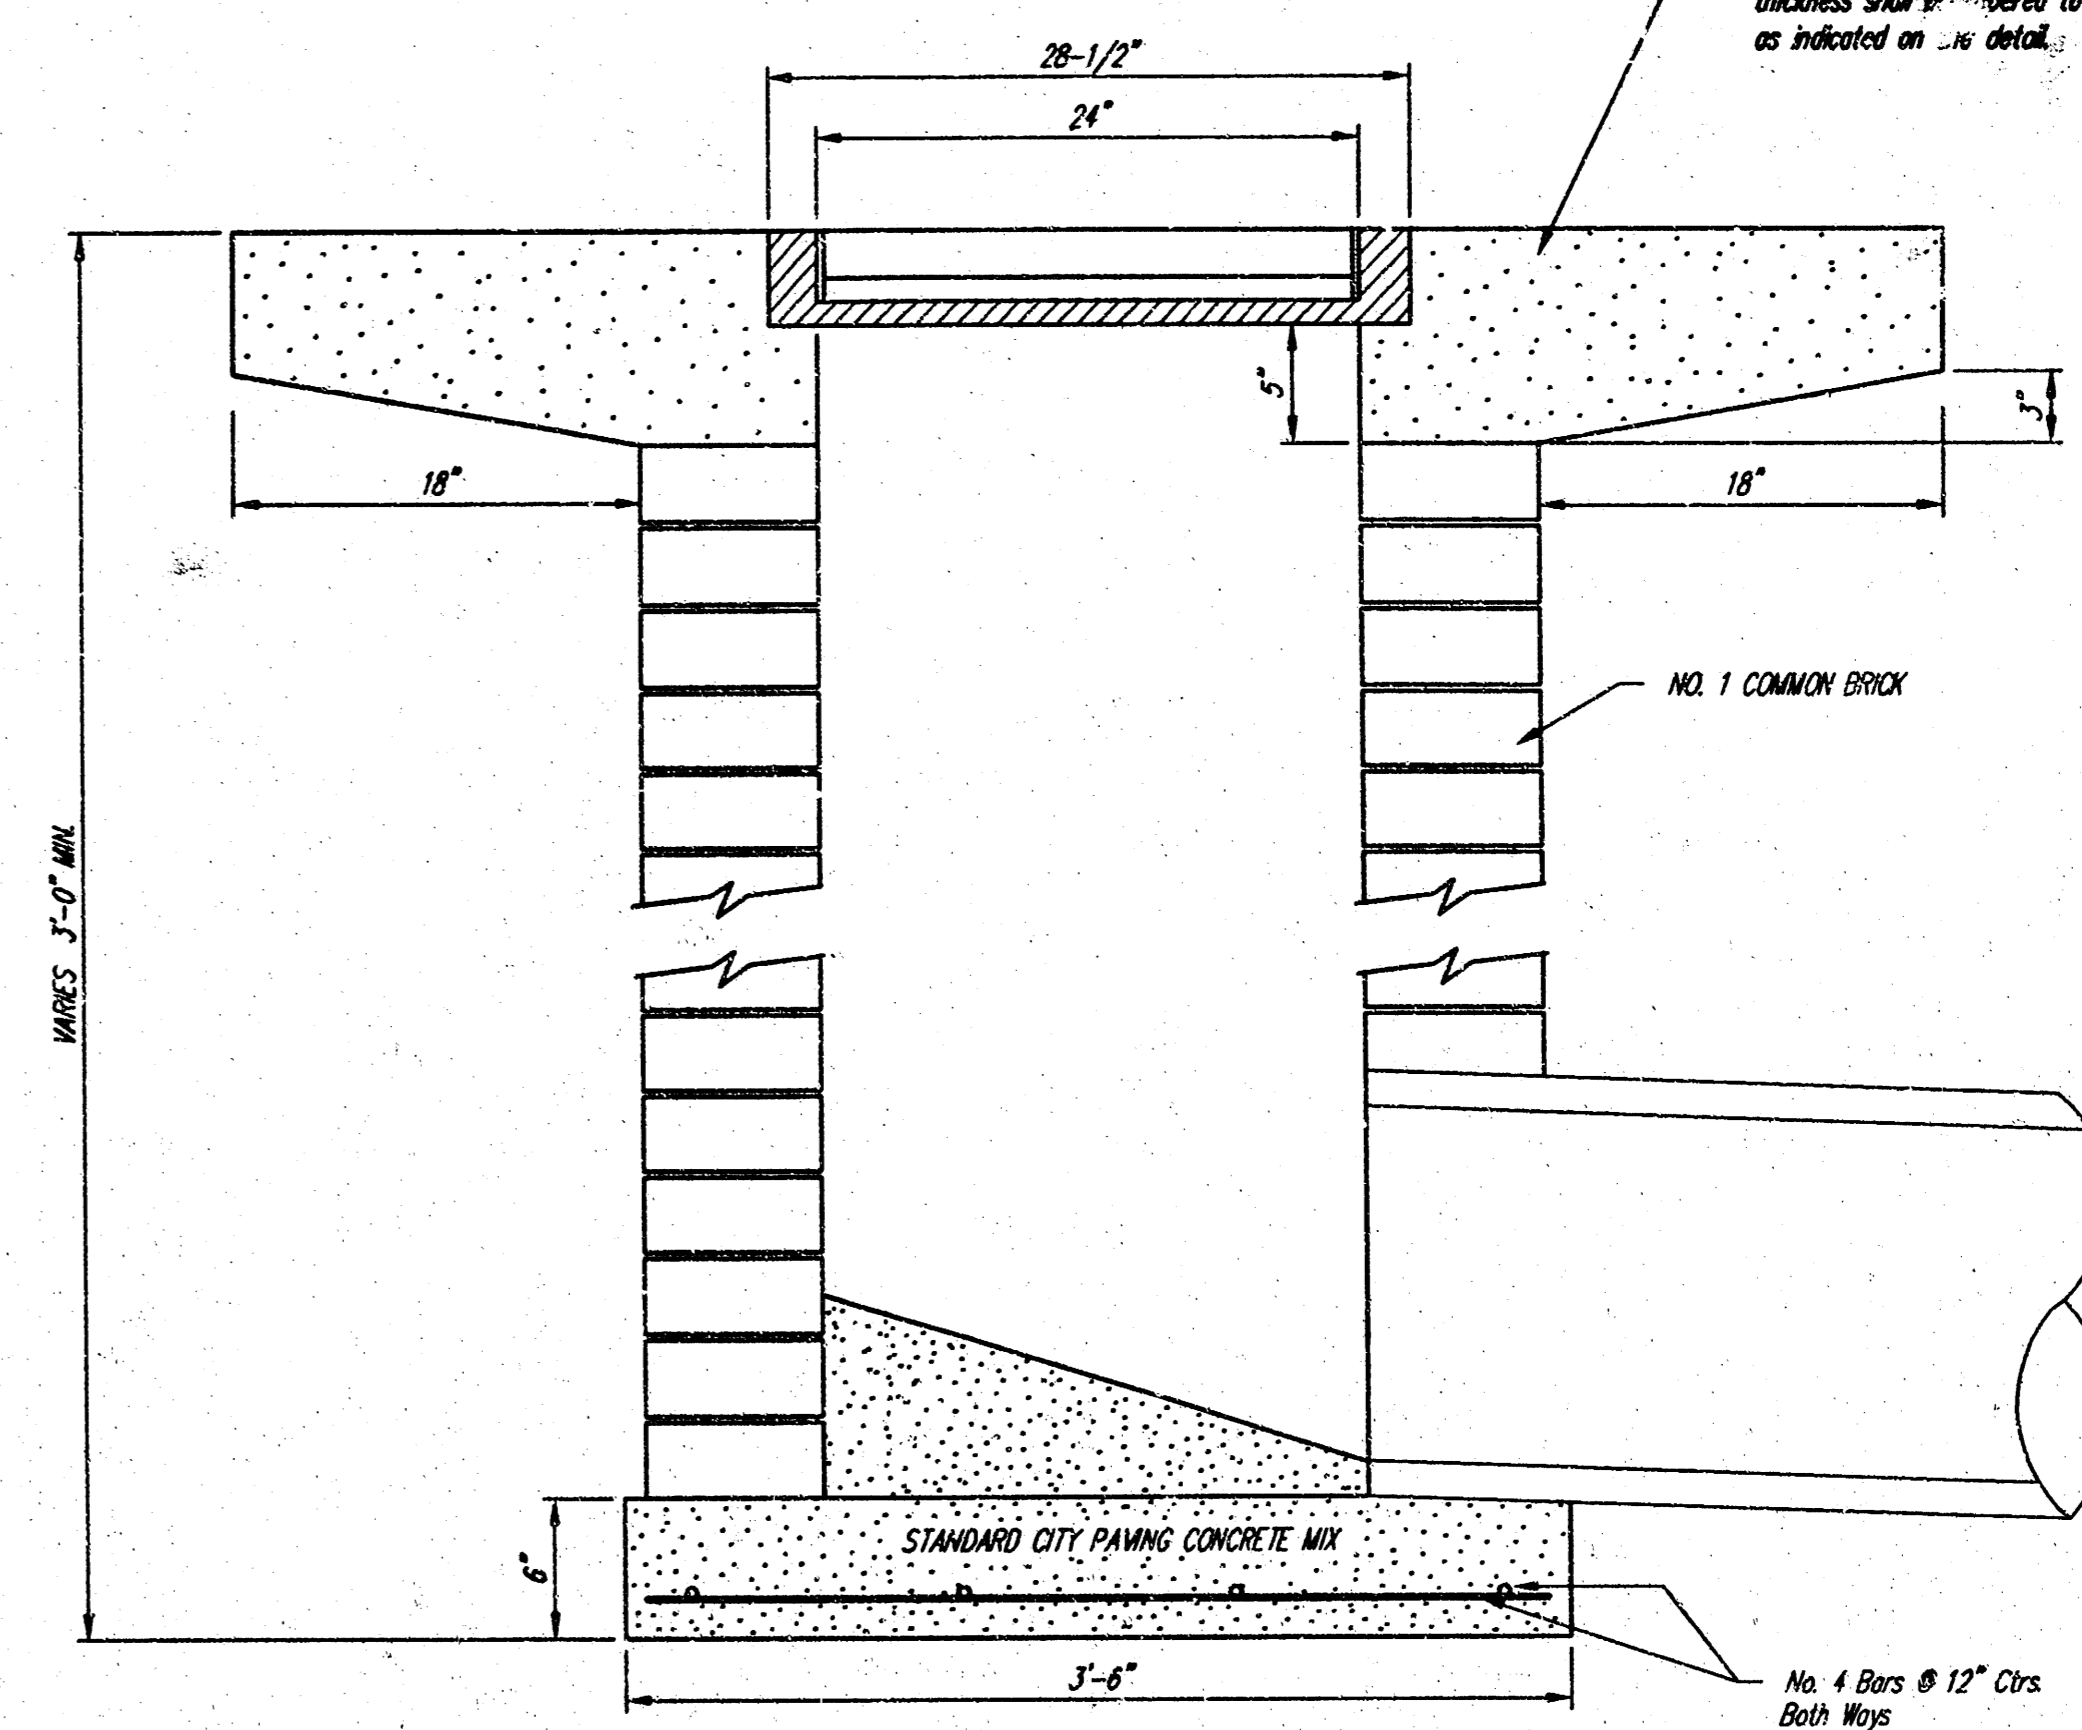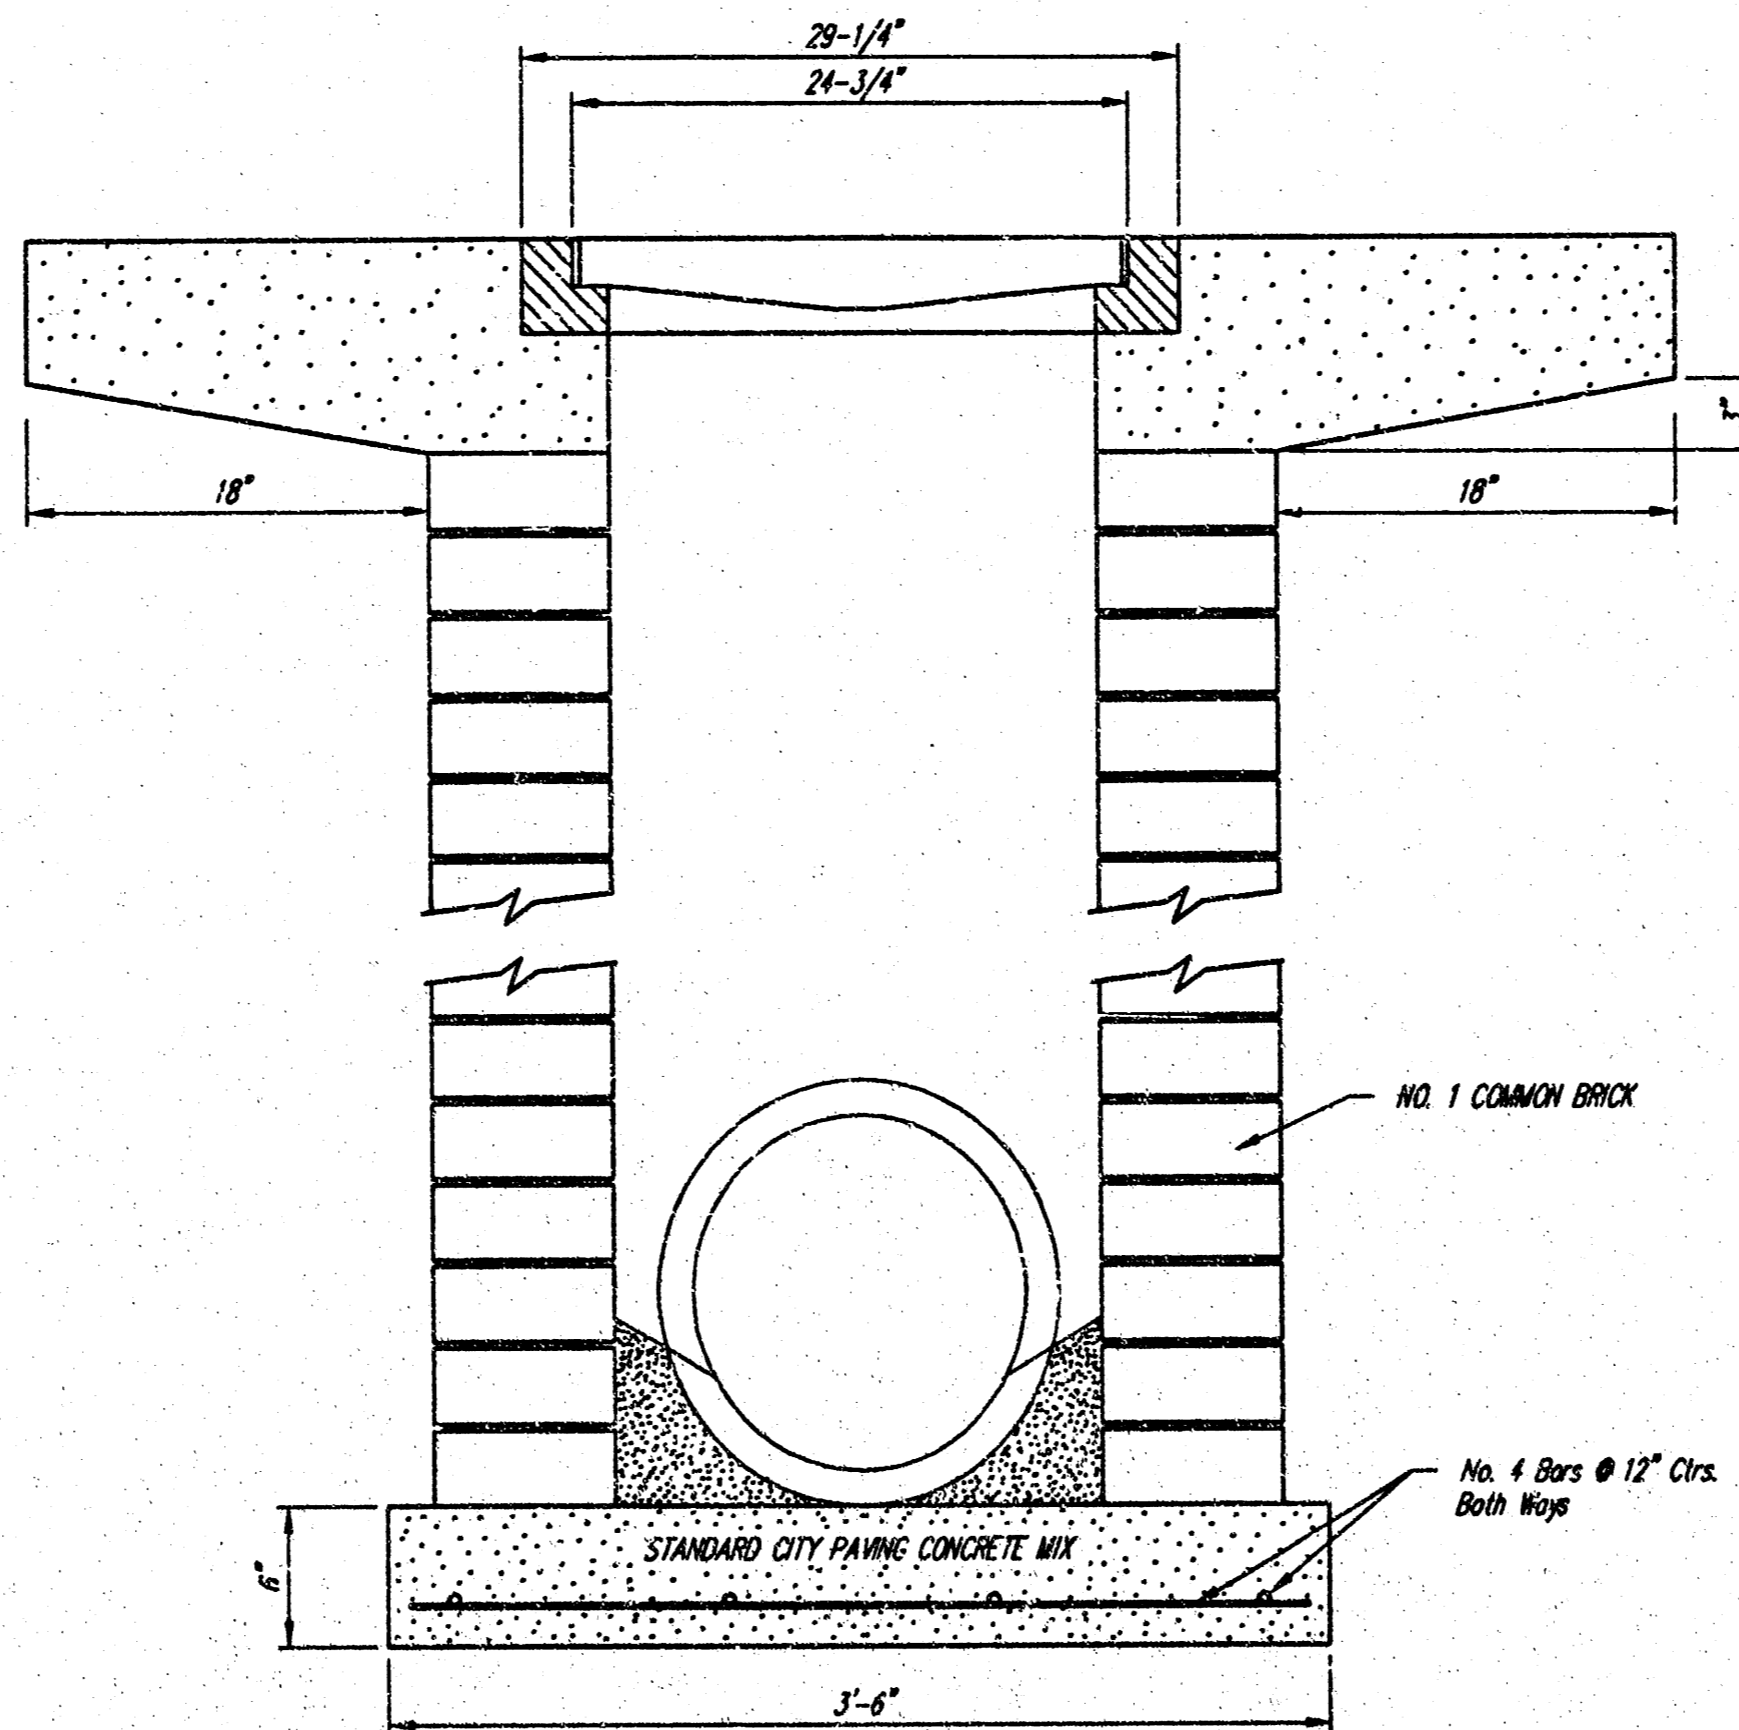

	City of Wichita Standard Type 1A	
	<b>DROP INLET</b>	
Inlet Opening = 2' x 4'		
Baughman Company, P.A. 3119th St., Wichita, KS 67211 P 316-263-7271 F 316-263-0149		
ENGINEERING   SURVEYING   PLANNING   LANDSCAPE ARCHITECTURE		
PROJECT NUMBER 1457 PPS (607861)	DESIGN C.O.W.	DRAWN Staff
REVISIONS Revised Feb. 16, 1989	APPROVED	DATE
	SCALE None	SHEET
	<b>5 OF 7</b>	
E:\Eng\Drawn\Drawn\DropInlet.dwg		04-06-E909

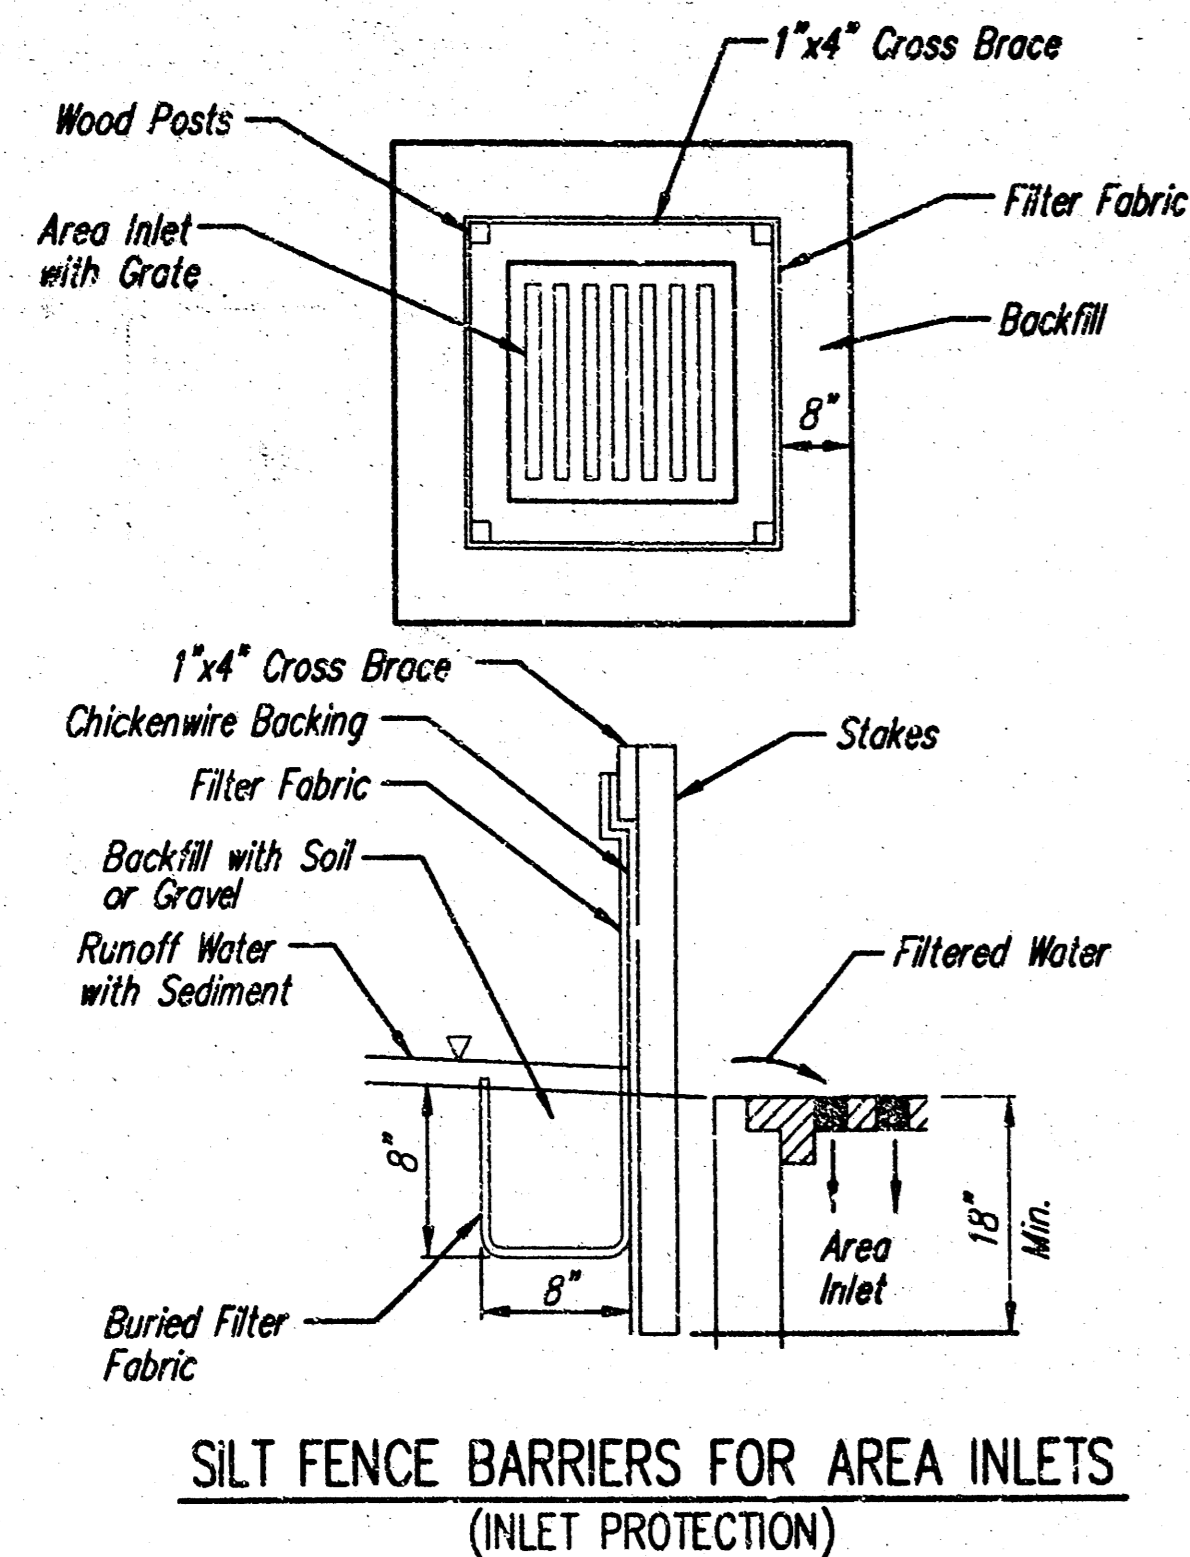

**SILT FENCE BARRIERS FOR AREA INLETS**  
(INLET PROTECTION)

**Material Specification:**

Silt fence fabric should conform to the AASHTO M288 96 silt fence specification. The wire or polymeric mesh backing used to help support the silt fence fabric should conform to the AASHTO M288 96 silt fence specification. The posts used to support the silt fence fabric should be a hardwood material with the following minimum dimensions: 2" square (nominal) by 4' long. The material used to frame the tops of the posts should be 1" by 4" boards. Silt fence fabric and support backing should be attached to the wooden posts and frame with staples, wire, zip ties, or nails.

**Placement:**

Place a silt fence drop inlet barrier in a location where it is unlikely to be overtopped. Water should flow through silt fence, not over it. Silt fence barriers for area inlets often fail when repeatedly overtopped. When used as a barrier for area inlets, silt fence fabric and posts must be supported at the top by a wooden frame. When a silt fence barrier for area inlets is located near an inlet that has steep approach slopes, the storage capacity behind the barrier is drastically reduced. Timely removal of sediment must occur for a barrier to operate properly in this location.

**Proper installation method:**

Excavate a trench around the perimeter of the area inlet that is at least 8" deep by 8" wide. Drive posts to a depth of at least 18" around the perimeter of the area inlet. The distance between posts should be 4' or less. If the distance between two adjacent corner posts is more than 4', add another post(s) between them. Connect the tops of all the posts with a wooden frame made of 1" by 4" boards. Use nails or screws for fastening. Attach the wire or polymeric-mesh backing to the outside of the post/frame structure with staples, wire, zip ties, or nails. Roll out a continuous length of silt fence fabric long enough to wrap around the perimeter of the area inlet. Add more length for overlapping the fabric joint. Place the edge of the fabric in the trench, starting at the outside edge of the trench. Line all three sides of the trench with the fabric. Backfill over the fabric in the trench with the excavated soil and compact. After filling the trench, approximately 24" to 36" of silt fence fabric should remain exposed. Attach the silt fence to the outside of the post/frame structure with staples, wire, zip ties, or nails. The joint should be overlapped to the next post.

Note: When a silt fence barrier for area inlet is placed in a shallow median ditch, make sure that the top of the barrier is not higher than the paved road. In this configuration, water may spread onto the roadway causing a hazardous condition.


**List of common placement/installation mistakes to avoid:**

Water should flow through a silt fence barrier for area inlet—not over it. Place a silt fence barrier for area inlet in a location where it is unlikely to be overtopped. Silt fence barrier for area inlets often fail when repeatedly overtopped. Do not place posts on the outside of the silt fence barrier for area inlet. In this configuration, the force of the water is not resisted by the posts, but only by the staples (wire, zip-ties, nails, etc.). The silt fence will rip and fail. Do not install silt fence barrier for area inlets without framing the top of the posts. The corner posts around area inlets are stressed in two directions whereas a normal silt fence is only stressed in one direction. This added stress requires more support.


**Inspection and Maintenance:**

Silt fence barrier for area inlets should be inspected every 7 days and within 24 hours of a rainfall of 1/2" or more. The following is a list of questions that should be addressed during each inspection:

- Does water flow under the silt fence?
- Does the silt fence sag excessively?
- Has the silt fence torn or become detached from the posts?
- Does sediment need to be removed from behind the area inlet barrier?

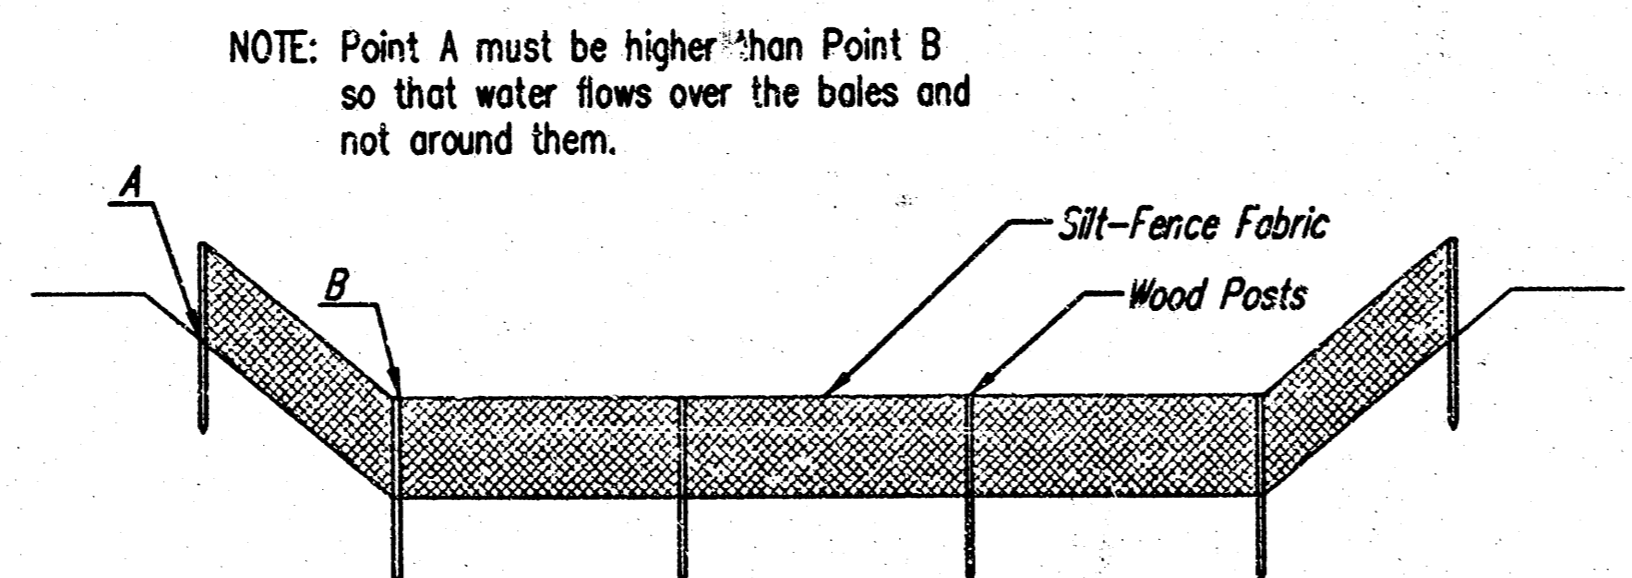

**SILT FENCE DITCH CHECKS**  
(STREAM PROTECTION)

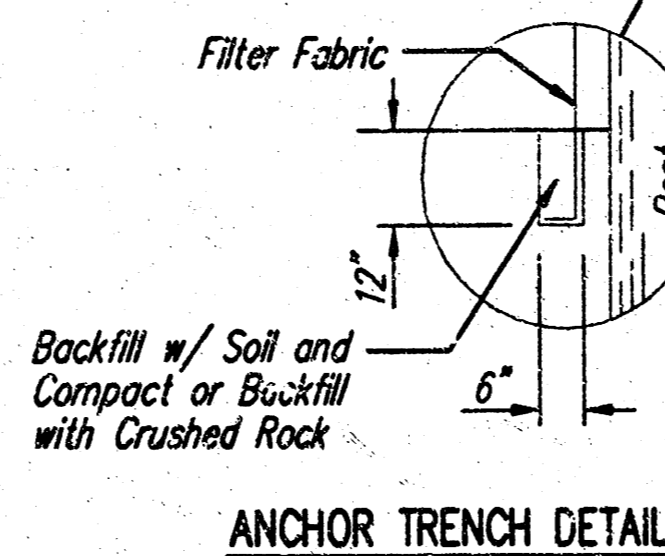

**ANCHOR TRENCH DETAIL**

**Material Specification:**

Silt fence fabric should conform to the AASHTO M288 96 silt fence specification. The posts used to support the silt fence fabric should be a hardwood material with the following minimum dimensions: 2" square (nominal) by 4' long. Silt fence fabric should be attached to the wooden posts with staples, wire, zip ties, or nails.

**Placement:**

Place silt fence in ditches where it is unlikely that it will be overtopped. Water should flow through a silt fence ditch check, not over it. Silt fence ditch checks often fail when overtopped. Silt fence ditch checks should be placed perpendicular to the flowline of the ditch. The silt fence should extend far enough so that the ground level at the ends of the fence is higher than the top of the low point of the fence. This prevents water from flowing around the check. Checks should not be placed in ditches where high flows are expected. Rock checks should be used instead. Silt fence should be placed in ditches with slopes of 6% or less. For slopes steeper than 6%, rock checks should be used.

The following table provides check spacing for a given ditch grade:




Ditch Check Ditch grade (%)	Spacing Check Spacing (feet)
0.5	200
1.0	200
2.0	100
3.0	65
4.0	50
5.0	40
6.0	30

**Proper installation method:**

Excavate a trench perpendicular to the ditch flowline that is at least 12" deep by 6" wide. Extend the trench in a straight line along the entire length of the proposed ditch check. Place the soil on the upstream side of the trench for later use. Roll out a continuous length of silt fence fabric on the downstream side of the trench. Place the edge of the fabric in the trench starting at the top upstream edge of the trench. Line two sides of the trench with the fabric as shown on detail. Backfill over the fabric in the trench with the excavated soil and compact. After filling the trench, approximately 24" to 36" of silt fence fabric should remain exposed. Lay the exposed silt fence on the upstream side of the trench to clear an area for driving in the posts. Just downstream of the trench, drive posts into the ground to a depth of at least 24". Place posts no more than 4' apart. Attach the silt fence to the anchored post with staples, wire, zip ties, or nails.

**List of common placement/installation mistakes to avoid:**

Water should flow through a silt fence ditch check—not over it. Place silt fence in ditches where it is unlikely that it will be overtopped. Silt fence installations quickly deteriorate when water overtops them. Do not place silt fence posts on the upstream side of the silt fence fabric. In this configuration, the force of the water is not restricted by the posts, but only by the staples (wire, zip ties, nails, etc.). The silt fence will rip and fail. Do not place a silt fence ditch check directly in front of a culvert outlet. It will not stand up to the concentrated flow. Do not place silt fence ditch checks in ditches that will likely experience high flows. They will not stand up to concentrated flow. Follow prescribed ditch check spacing guidelines. If spacing guidelines are exceeded, erosion will occur between the ditch checks. Do not allow water to flow around the ditch check. Make sure that the ditch check is long enough so that the ground level at the ends of the fence is higher than the low point on the top of the fence. Do not place silt fence ditch checks in channels with shallow soils underlain by rock. If the check is not anchored sufficiently, it will wash out.

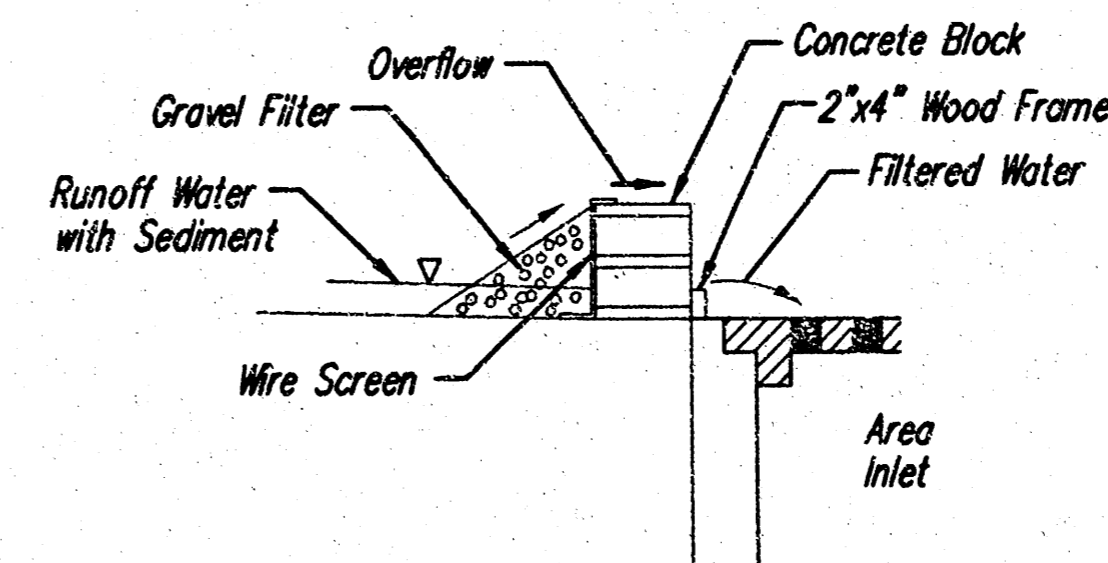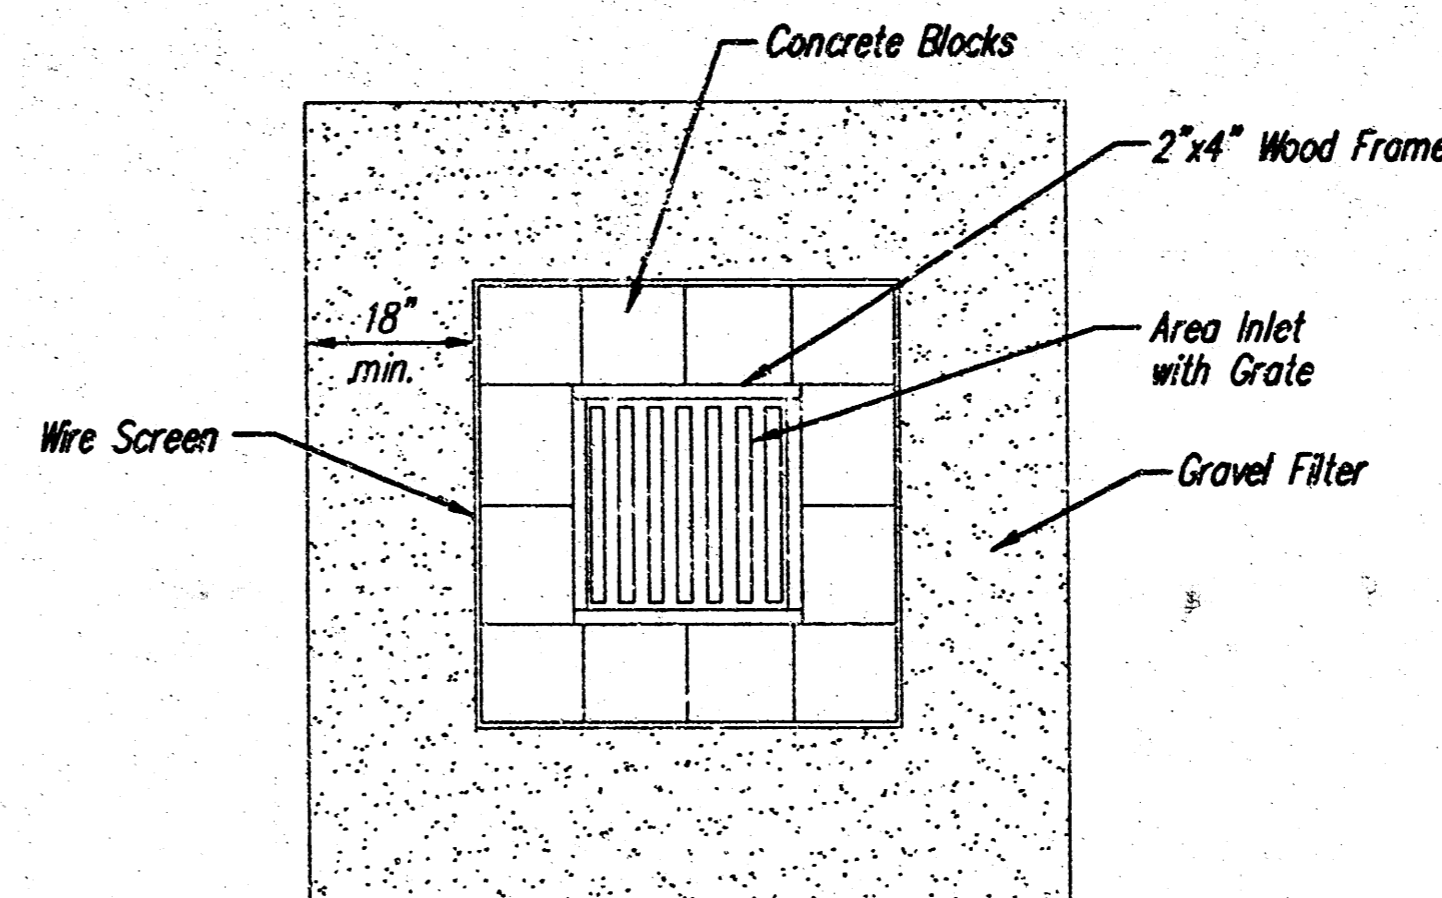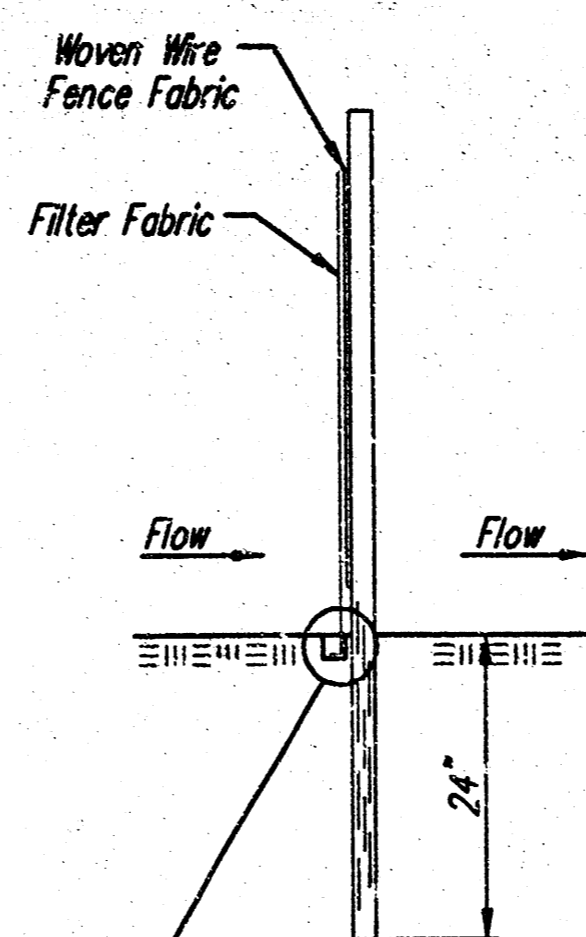

**CONCRETE BLOCK FILTER FOR AREA DRAIN**  
(INLET PROTECTION)

Gravel barriers provide little filtering of large inflow waters. However, when installed correctly and maintained, they can effectively treat low runoff flows.

Placement of gravel filters around area drains must be completed in a manner that will not cause local flooding.

Gravel filters can be used if the immediate and adjacent area to the area drain consists of soil or pavement.

Only gravel filters are to be installed on top of the pavement.

**Instructions for Installing:**

- STEP 1: Place concrete blocks around the grate. The blocks can be stacked one or two high and should be supported by a 2"x4" board.
- STEP 2: Wrap 1/2" mesh wire screen around the concrete blocks.
- STEP 3: Place 1" to 1-1/2" diameter rock around the blocks and wire screen. Be sure the rock extends down from the top of the concrete block.
- STEP 4: To prevent damage to vehicles, signs warning drivers about the structures may be necessary.

An alternative method is use of gravel bags that are supported to prevent collapsing.

Use of rock having diameters smaller than 1" may result in clogging of pores and reduce the amount of water flowing into an inlet.

**Maintenance:**

All gravel filters installed around area drains should be inspected and repaired after each runoff event. Sediment should be removed when material is within 3" of the top of any block. Periodically, the gravel should be raked to increase infiltration and filtering of runoff waters. Accumulated sediment is to be removed immediately from roads and streets after every runoff event.

**Inspection and Maintenance:**

Silt fence ditch checks should be inspected every 7 days and within 24 hours of a rainfall of 1/2" or more. The following is a list of questions that should be addressed during each inspection:


- Does water flow around the ditch check?
- Does water flow under the ditch check?
- Does the silt fence sag excessively?
- Has the silt fence torn or become detached from the posts?
- Does sediment need to be removed from behind the ditch check?

**SOIL EROSION  
BMP DETAILS**

CHRISTOPHER M. CARRIER, P.E.  
STORM WATER ENGINEER

PROJECT NUMBER	O&A NO.
1457 PPS (607861)	-
DATE	SHEET 6 OF 7
MAY 2001	

# HAN DIEC ADDITION WICHITA, SEDGWICK COUNTY, KANSAS

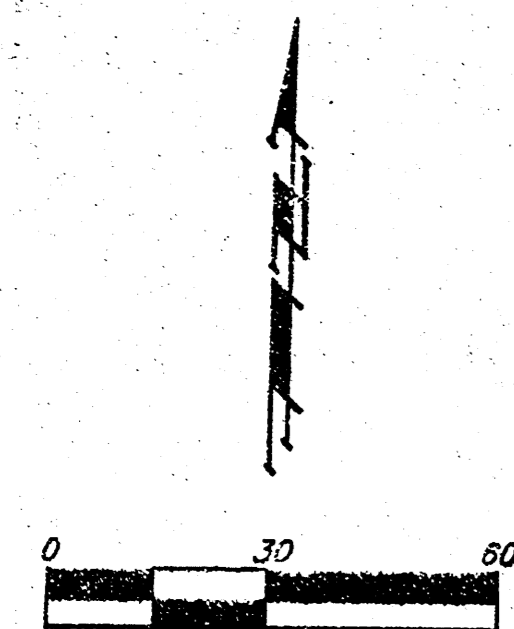


NOTE:  
ADDITIONAL BUILDING SETBACKS AND OTHER REQUIREMENTS ON LOT 1, BLOCK A, ARE PER DECLARATION OF COVENANTS, CONDITIONS, AND RESTRICTIONS ON FILM 2323, PAGE 813.

NOTE "A":  
EASEMENT AS SHOWN IS BASED ON FIELD LOCATION OF CONCRETE FOUNDATION AS CALLED FOR IN MISC. BOOK 456, PAGE 244. THE SIZE OF SAID EASEMENT IS UNDEFINED. THE EAST-WEST LOCATION OF SAID EASEMENT IS CALLED FOR IN TEXT. THE NORTH-SOUTH LOCATION OF SAID EASEMENT IS TO BE NO GREATER THAN 40 FEET SOUTH OF THE NORTH LINE OF THE AFFECTED TRACT AS DEFINED IN TEXT.

NOTE:  
A DRAINAGE PLAN HAS BEEN DEVELOPED FOR THIS SUBDIVISION AND IS ON FILE WITH THE CITY OF WICHITA, KANSAS. DRAINAGE INTENT SHALL REMAIN AS DEPICTED OR AS MODIFIED WITH THE APPROVAL OF THE CITY ENGINEER OF THE CITY OF WICHITA, KANSAS. NO OBSTRUCTIONS WHICH IMPED THE FLOW OF THIS DRAINAGE PLAN SHALL BE ALLOWED.

- #4 REBAR W/ "BAUGHMAN" CAP (SET)
- "7"-K" NAIL IN ASPHALT (SET)
- #4 REBAR W/ "DARBAR" CAP (FOUND)
- △ 3/4" IRON (FOUND)
- ⊖ 1/2" IRON (FOUND)
- "7"-K" NAIL IN CONC. (SET)
- #4 REBAR W/ "BAUGHMAN" CAP (FOUND)
- #4 REBAR (FOUND)

- (M) = MEASURED
- (P) = PLATTED
- (D) = DESCRIBED
- (C-P) = CALCULATED PER PLATTED INFO
- (C) = CALCULATED

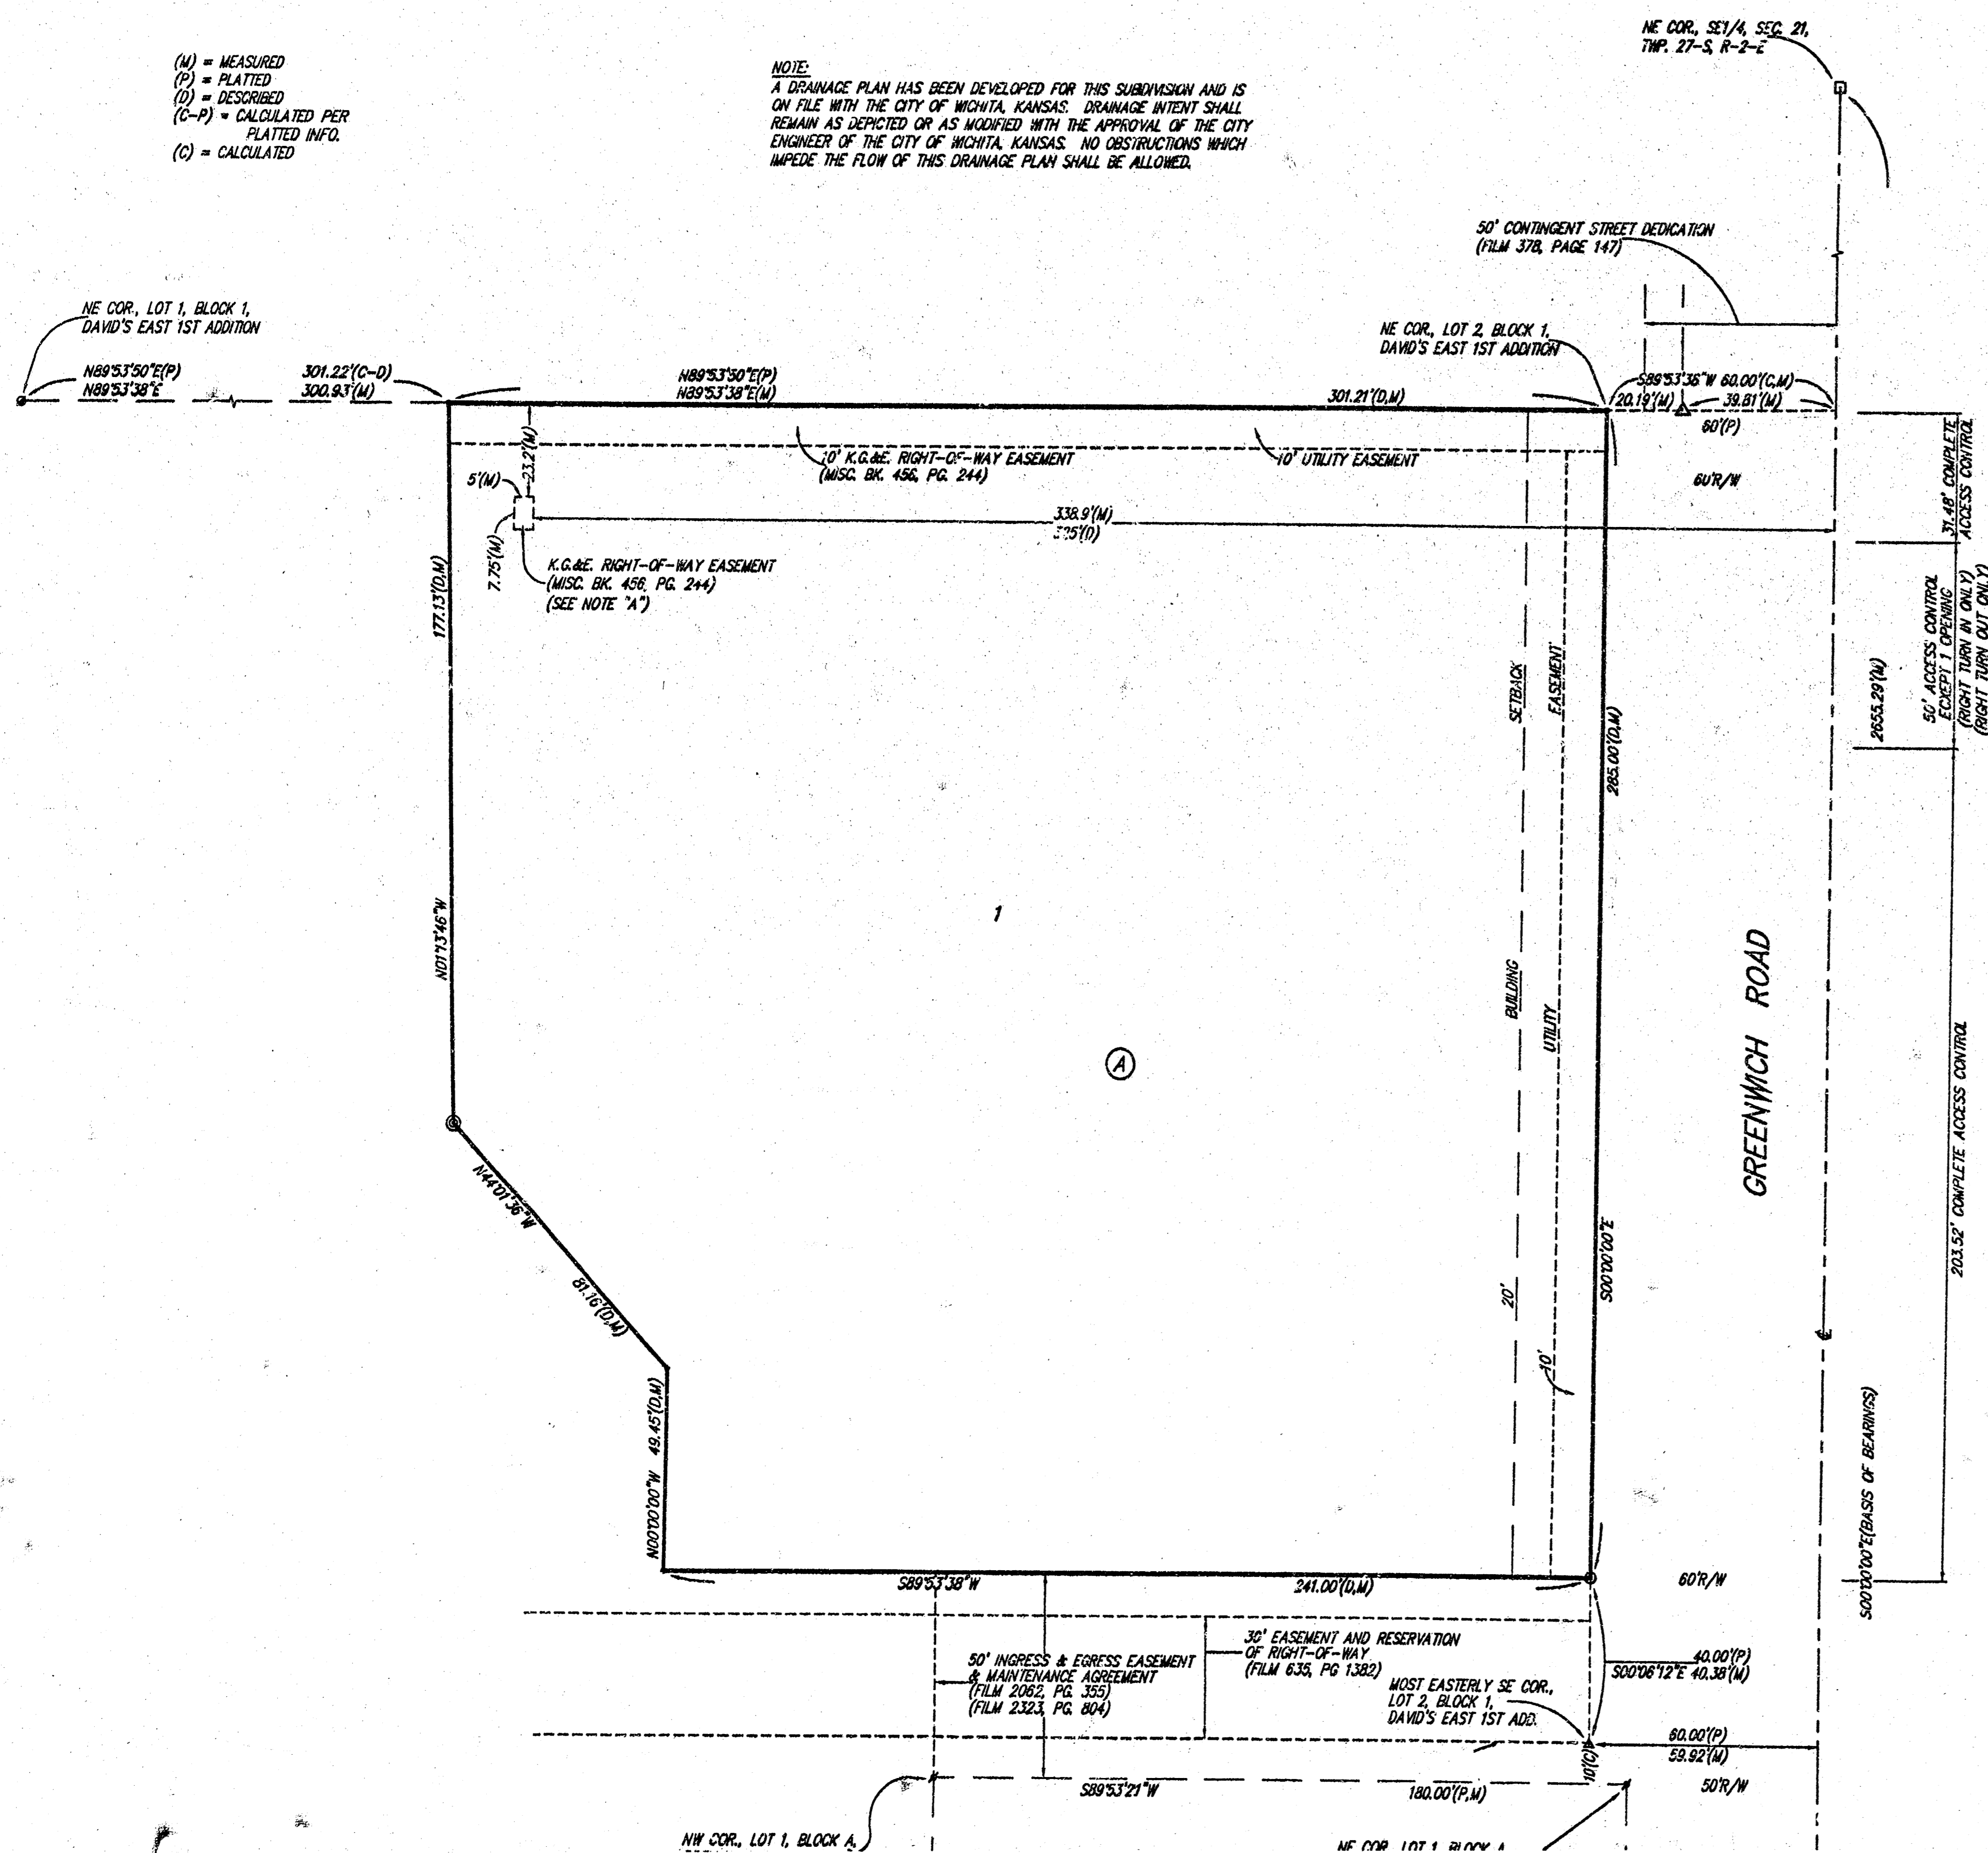

State of Kansas) SS We, Baughman Company, P.A., Surveyors in  
Sedgwick County) above county and state do hereby certify that we have surveyed and  
platted "HAN DIEC ADDITION", Wichita, Sedgwick County, Kansas and that  
the accompanying plat is a true and correct exhibit of the property  
surveyed, described as:

Part of Lot 2, Block 1, David's East 1st Addition to Wichita, Sedgwick  
County, Kansas, described as beginning at the northeast corner of said  
Lot 2; thence S00°00'00"E along the east line of said Lot 2, 285.00 feet;  
thence S89°53'38"W, 241.00; thence N00°00'00"W, 49.45 feet; thence  
N44°01'36"W, 81.16 feet; thence N01°13'46"W, 177.13 feet to a point on  
the north line of said Lot 2; thence N89°53'38"E, 301.21 feet to the  
point of beginning.

Existing public easements and dedications  
being vacated by virtue of K.S.A. 12-512(b).

All being situated in the SE 1/4 of Sec. 21, Twp. 27-S,  
R-2-E of the 6th P.M., Sedgwick County, Kansas.

Baughman Company, P.A.

*Michael A. Conrey*  
Michael A. Conrey, Surveyor

Know all men by these presents that we,  
the undersigned, have caused the land in the surveyors certificate to be  
platted into a Lot, a Block, and a Street, to be known as "HAN DIEC  
ADDITION", Wichita, Sedgwick County, Kansas. The utility easements are  
hereby granted as indicated for the construction and maintenance of all  
public utilities. All abutters rights of access shall be as depicted on the  
face of the plat and are hereby granted to the City of Wichita, Kansas.  
The permitted opening locations shall be as determined by the City  
Engineer of the City of Wichita, Kansas.

Greenview Plaza, L.L.C., a Kansas  
limited liability company

*Han H. Diec*  
Han H. Diec, Manager

*Yolinda Diec*  
Yolinda Diec, Manager

*Phuong Thao Diec*  
Phuong Thao Diec, Manager

State of Kansas) SS The foregoing instrument acknowledged before  
Sedgwick County) me, this 17th day of APRIL, 2002, by Han H. Diec, Manager  
of Greenview Plaza, L.L.C., a Kansas limited liability company, on behalf  
of the limited liability company.

JUDITH M. TERHUNE  
Notary Public - State of Kansas  
My Appl. Expires 11-7-2005  
*Judith M. Terhune*  
Judith M. Terhune, Notary Public

State of Kansas) SS The foregoing instrument acknowledged before  
Sedgwick County) me, this 17th day of APRIL, 2002, by Yolinda Diec, Manager  
of Greenview Plaza, L.L.C., a Kansas limited liability company, on behalf  
of the limited liability company.

JUDITH M. TERHUNE  
Notary Public - State of Kansas  
My Appl. Expires 11-7-2005  
*Judith M. Terhune*  
Judith M. Terhune, Notary Public

State of Kansas) SS

This plat of "HAN DIEC ADDITION", Wichita,  
Sedgwick County, Kansas has been submitted to and approved by the  
Wichita-Sedgwick County Metropolitan Area Planning Commission, Wichita,  
Kansas.

Dated this 8th day of December, 2001.  
Wichita-Sedgwick County Metropolitan Area Planning Commission



*J. V. Michaels*  
J. V. Michaels, Chair

*Marvin S. Kraut*  
Marvin S. Kraut, Secretary

This plat approved and all dedications  
shown hereon accepted by the City Council of the City of Wichita,  
Kansas, this 21st day of May, 2002.

At the direction of the City Council



*Chris Churches*  
Chris Churches, City Manager

*Pat Burnett*  
Pat Burnett, City Clerk

Reviewed in accordance with K.S.A. 58-2005  
on this 25th day of April, 2002.



*Tricia L. Robello*  
Tricia L. Robello, L.S. #1246  
Deputy County Surveyor  
Sedgwick County, Kansas

Entered on transfer record this 11th day  
of June, 2002.

*Don Brace*  
Don Brace, County Clerk

State of Kansas) SS This is to certify that this plat has been  
Sedgwick County) filed for record in the office of the Register of Deeds, this 11th day  
of June, 2002 at 2:49 o'clock P.M. and is duly recorded.

*Bill Meek*  
Bill Meek, Register of Deeds



*Linda Kizz*  
Linda Kizz, Deputy

\* 2093806

We the undersigned holders of a mortgage on the  
above described property, do hereby consent to this plat of "HAN DIEC  
ADDITION", Wichita, Sedgwick County, Kansas.

Mulvane State Bank  
*Frank L. Carson*  
Frank L. Carson

State of Kansas) SS The foregoing instrument acknowledged before  
Sedgwick County) me, this 29th day of May, 2002, by Frank L. Carson, III

10 08 03 02