


STORM WATER SEWER NO. 252

PROJECT NO.
468 76 245 81276 000 000 001



As BUILT PLAN
9/84
M.C. GREENE

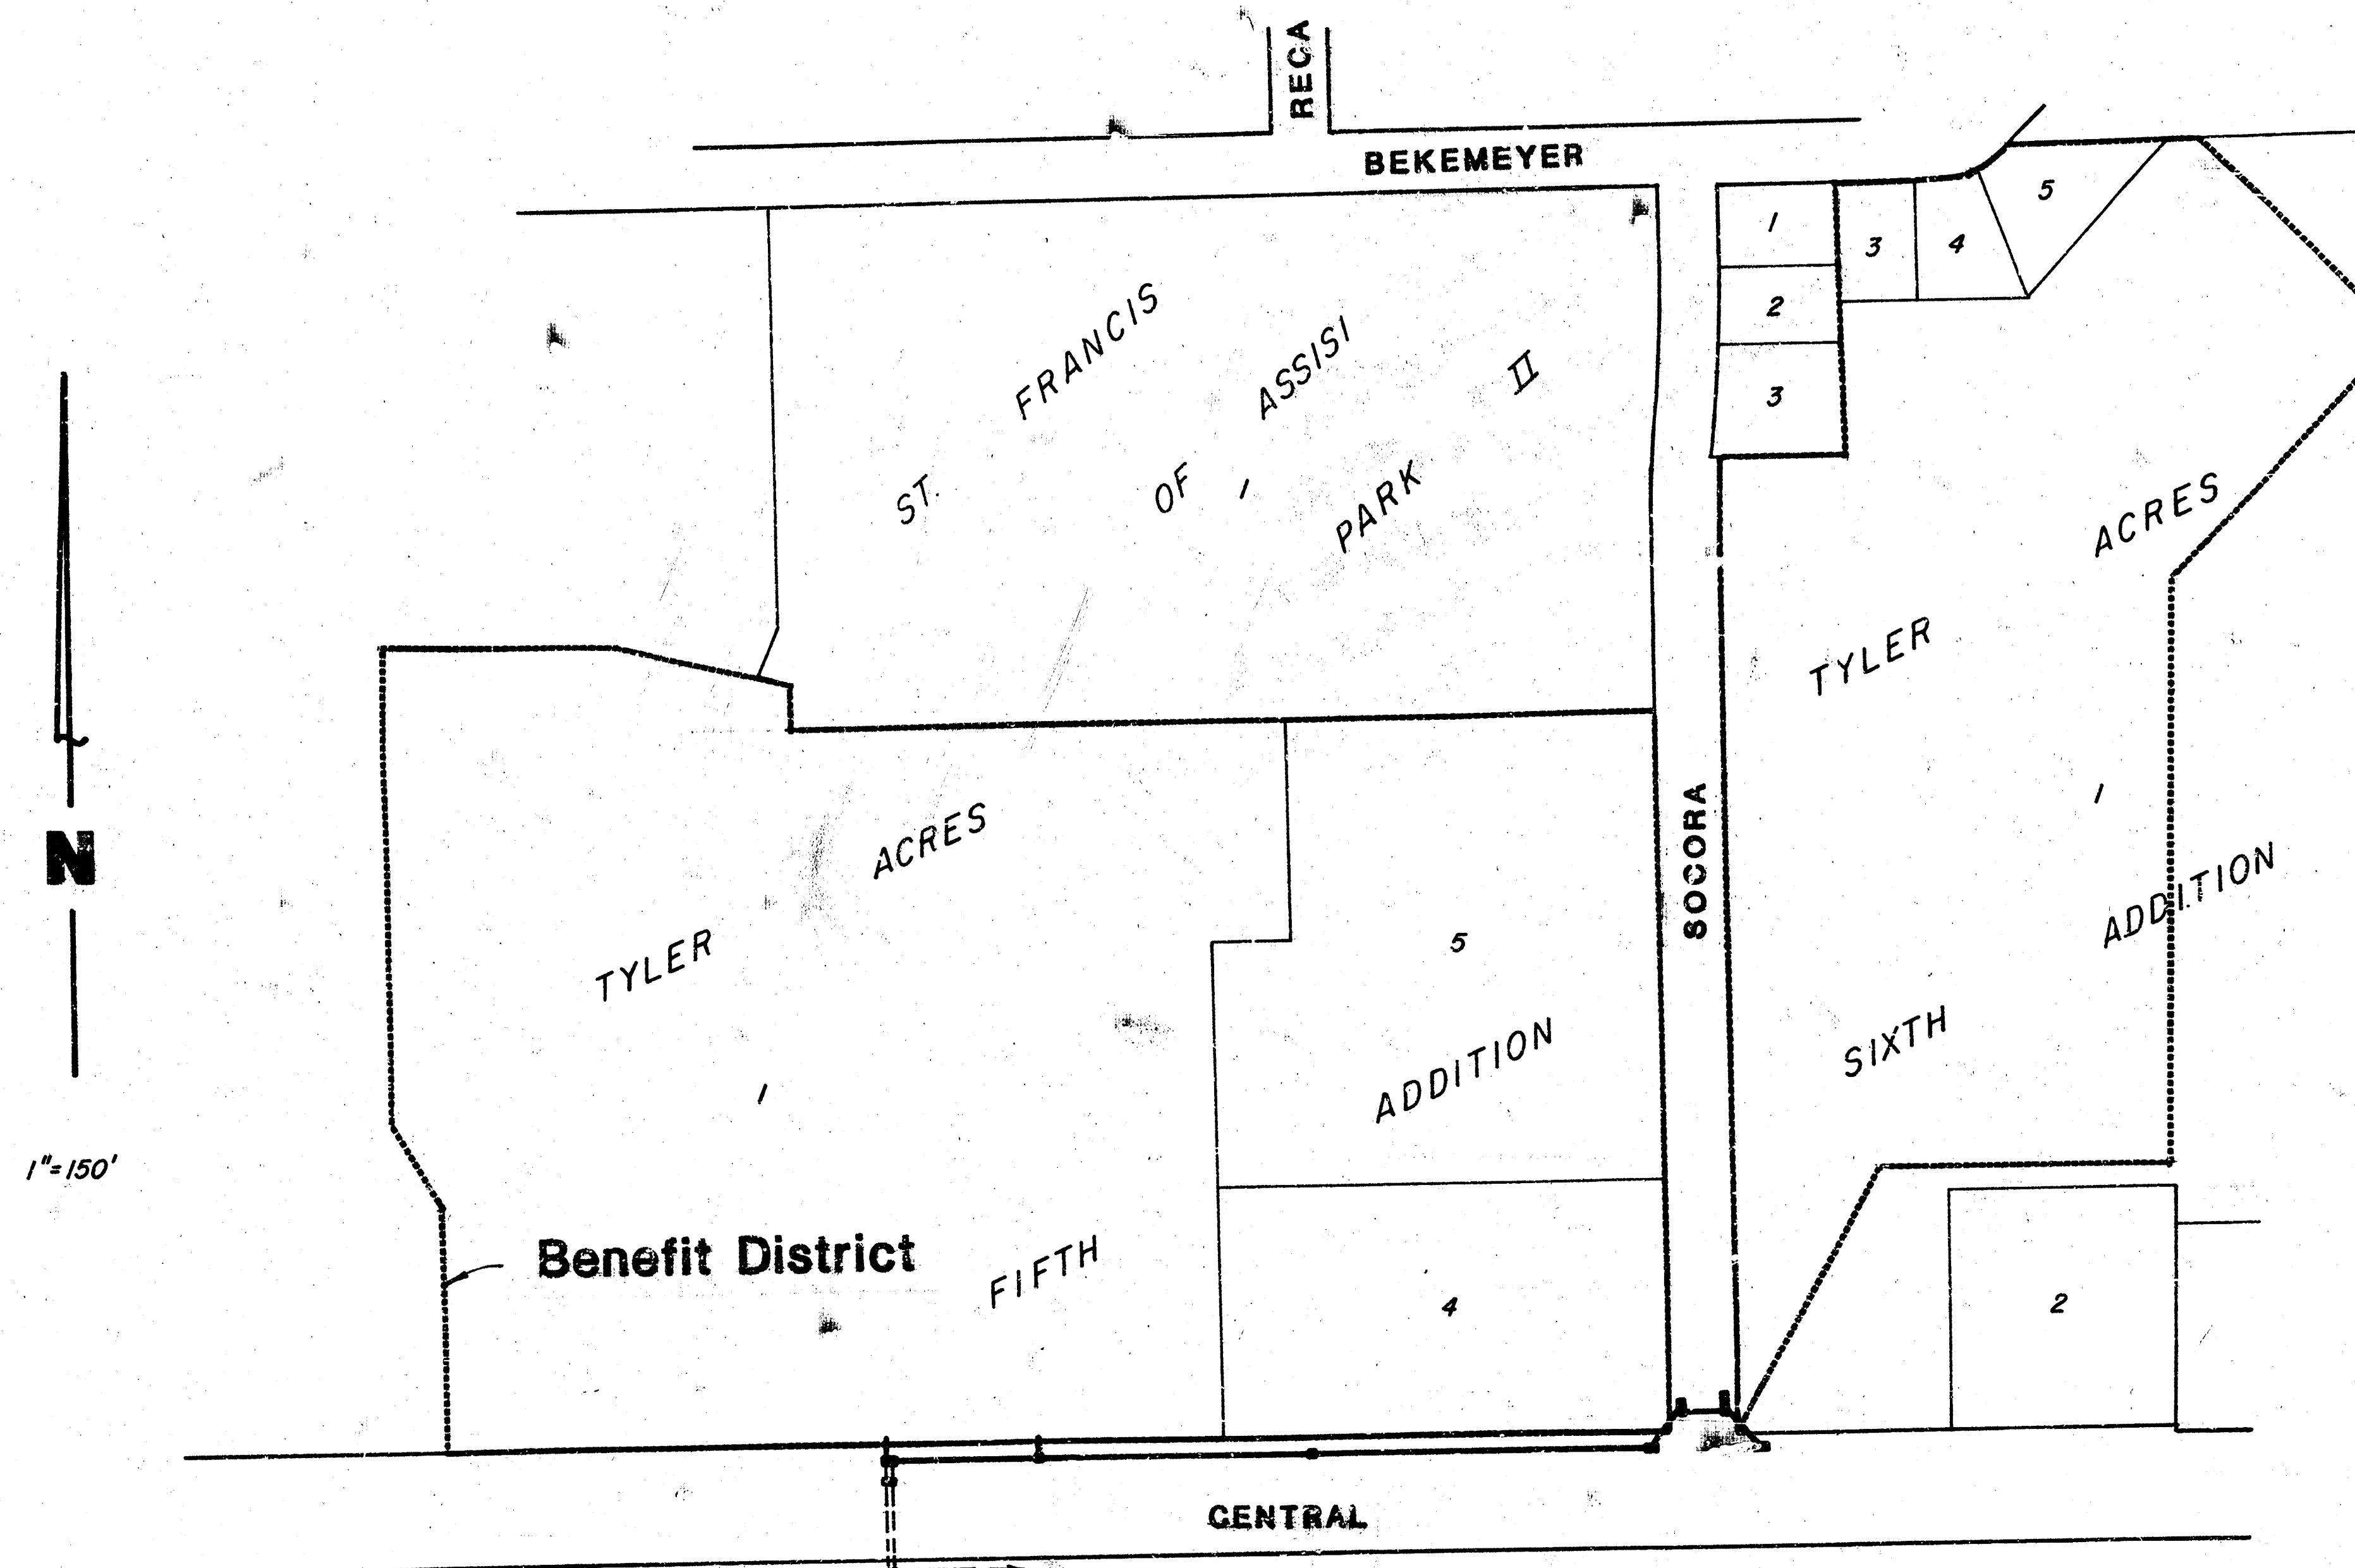


CITY OF WICHITA, KS.
MIKE E. LINDEBAK CITY ENGINEER

General Notes, Sheet 4

MAY 84

BAUGHMAN COMPANY, P.A.
SURVEYING & ENGINEERING
316/262-7271 • 339 LAURA • WICHITA, KANSAS 67211


1/6

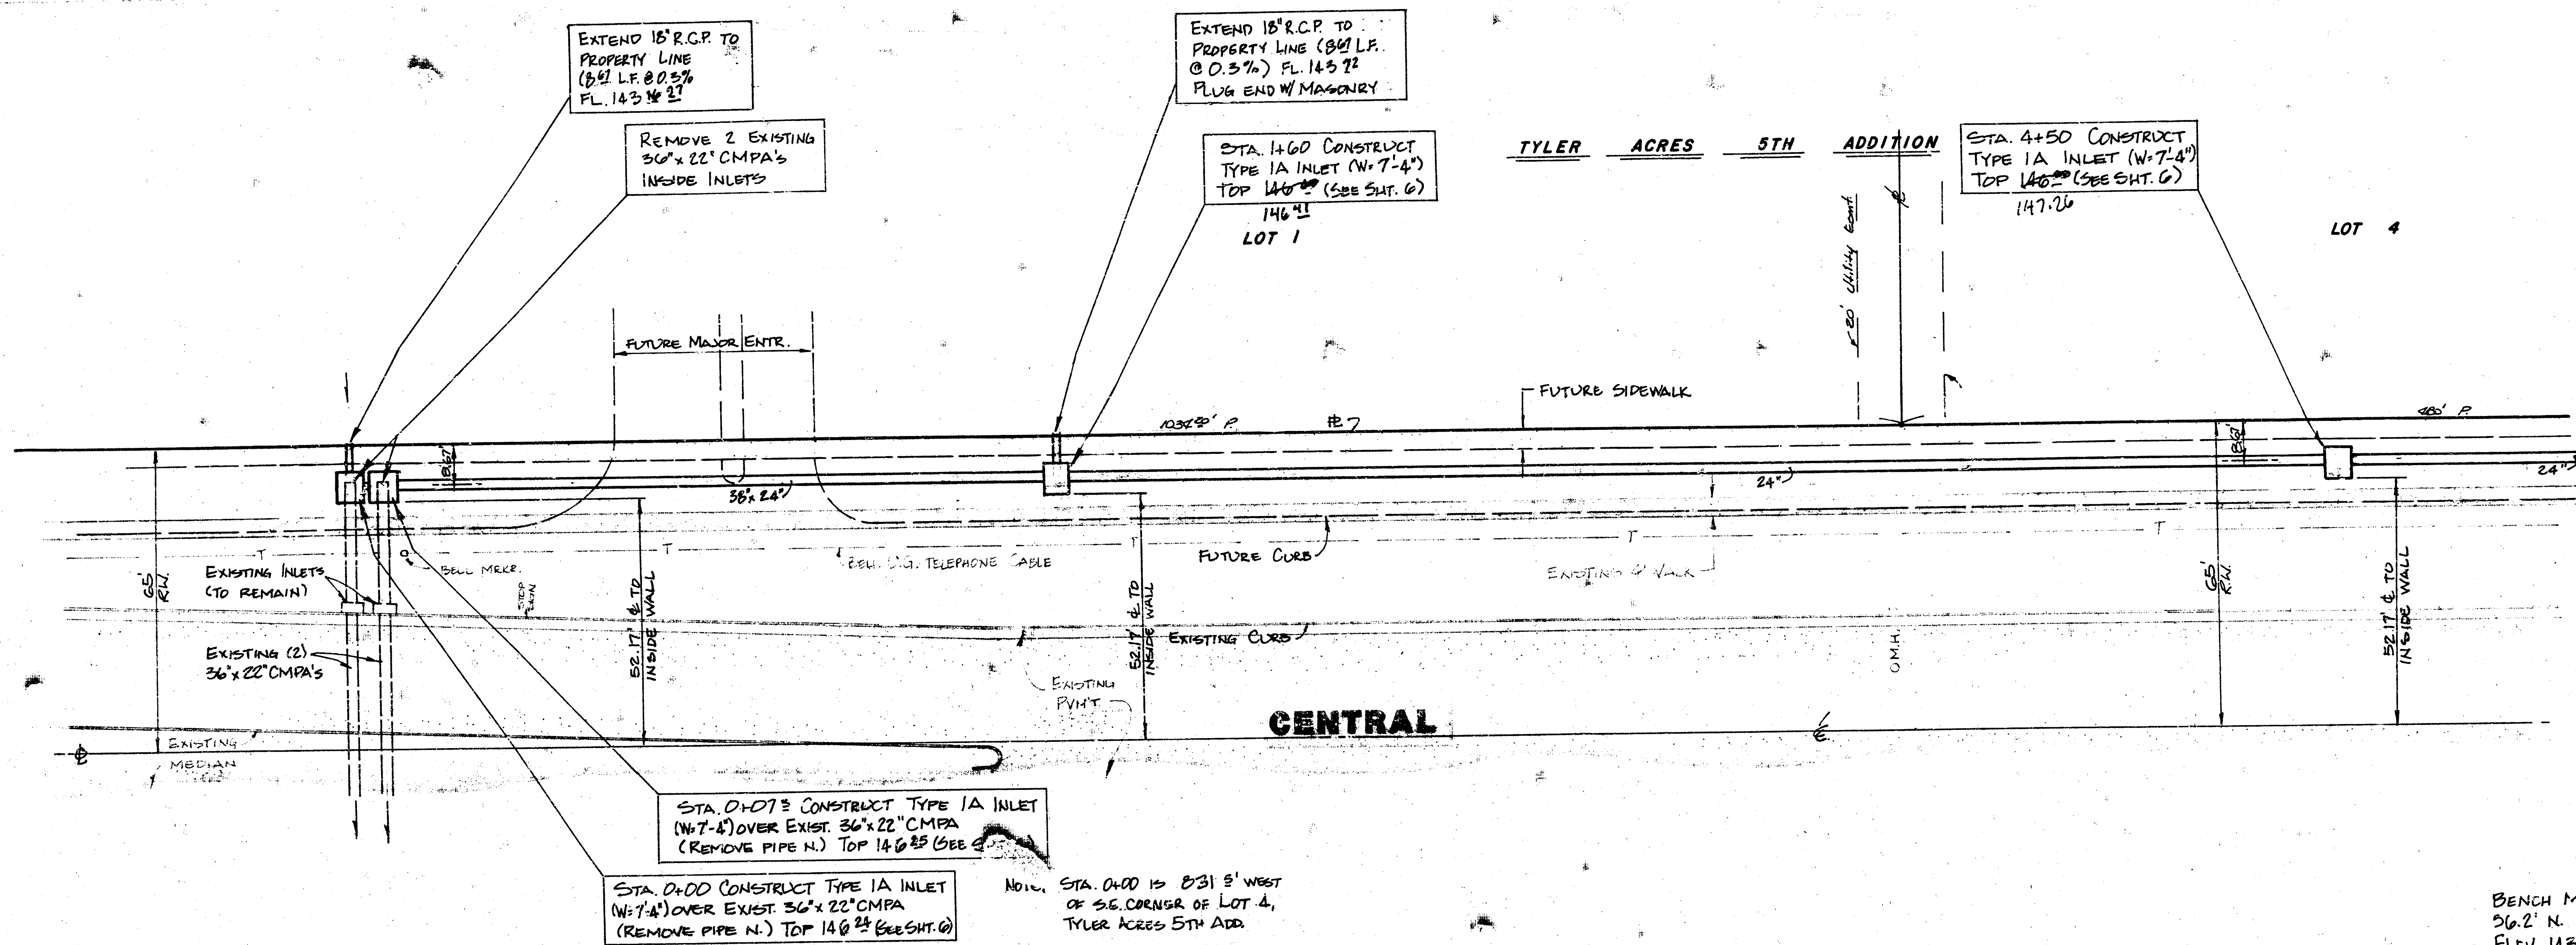

As Built Plans
9/84
McGraw-Hill

BENCH MARK: CITY OF WICHITA DISC.
26.2' N. & 38' W. OF E. CENTRAL & TYLER,
ELEV. 143.90

PROFILE SCALE
1"=20' HORIZ.
1"=5' VERT.

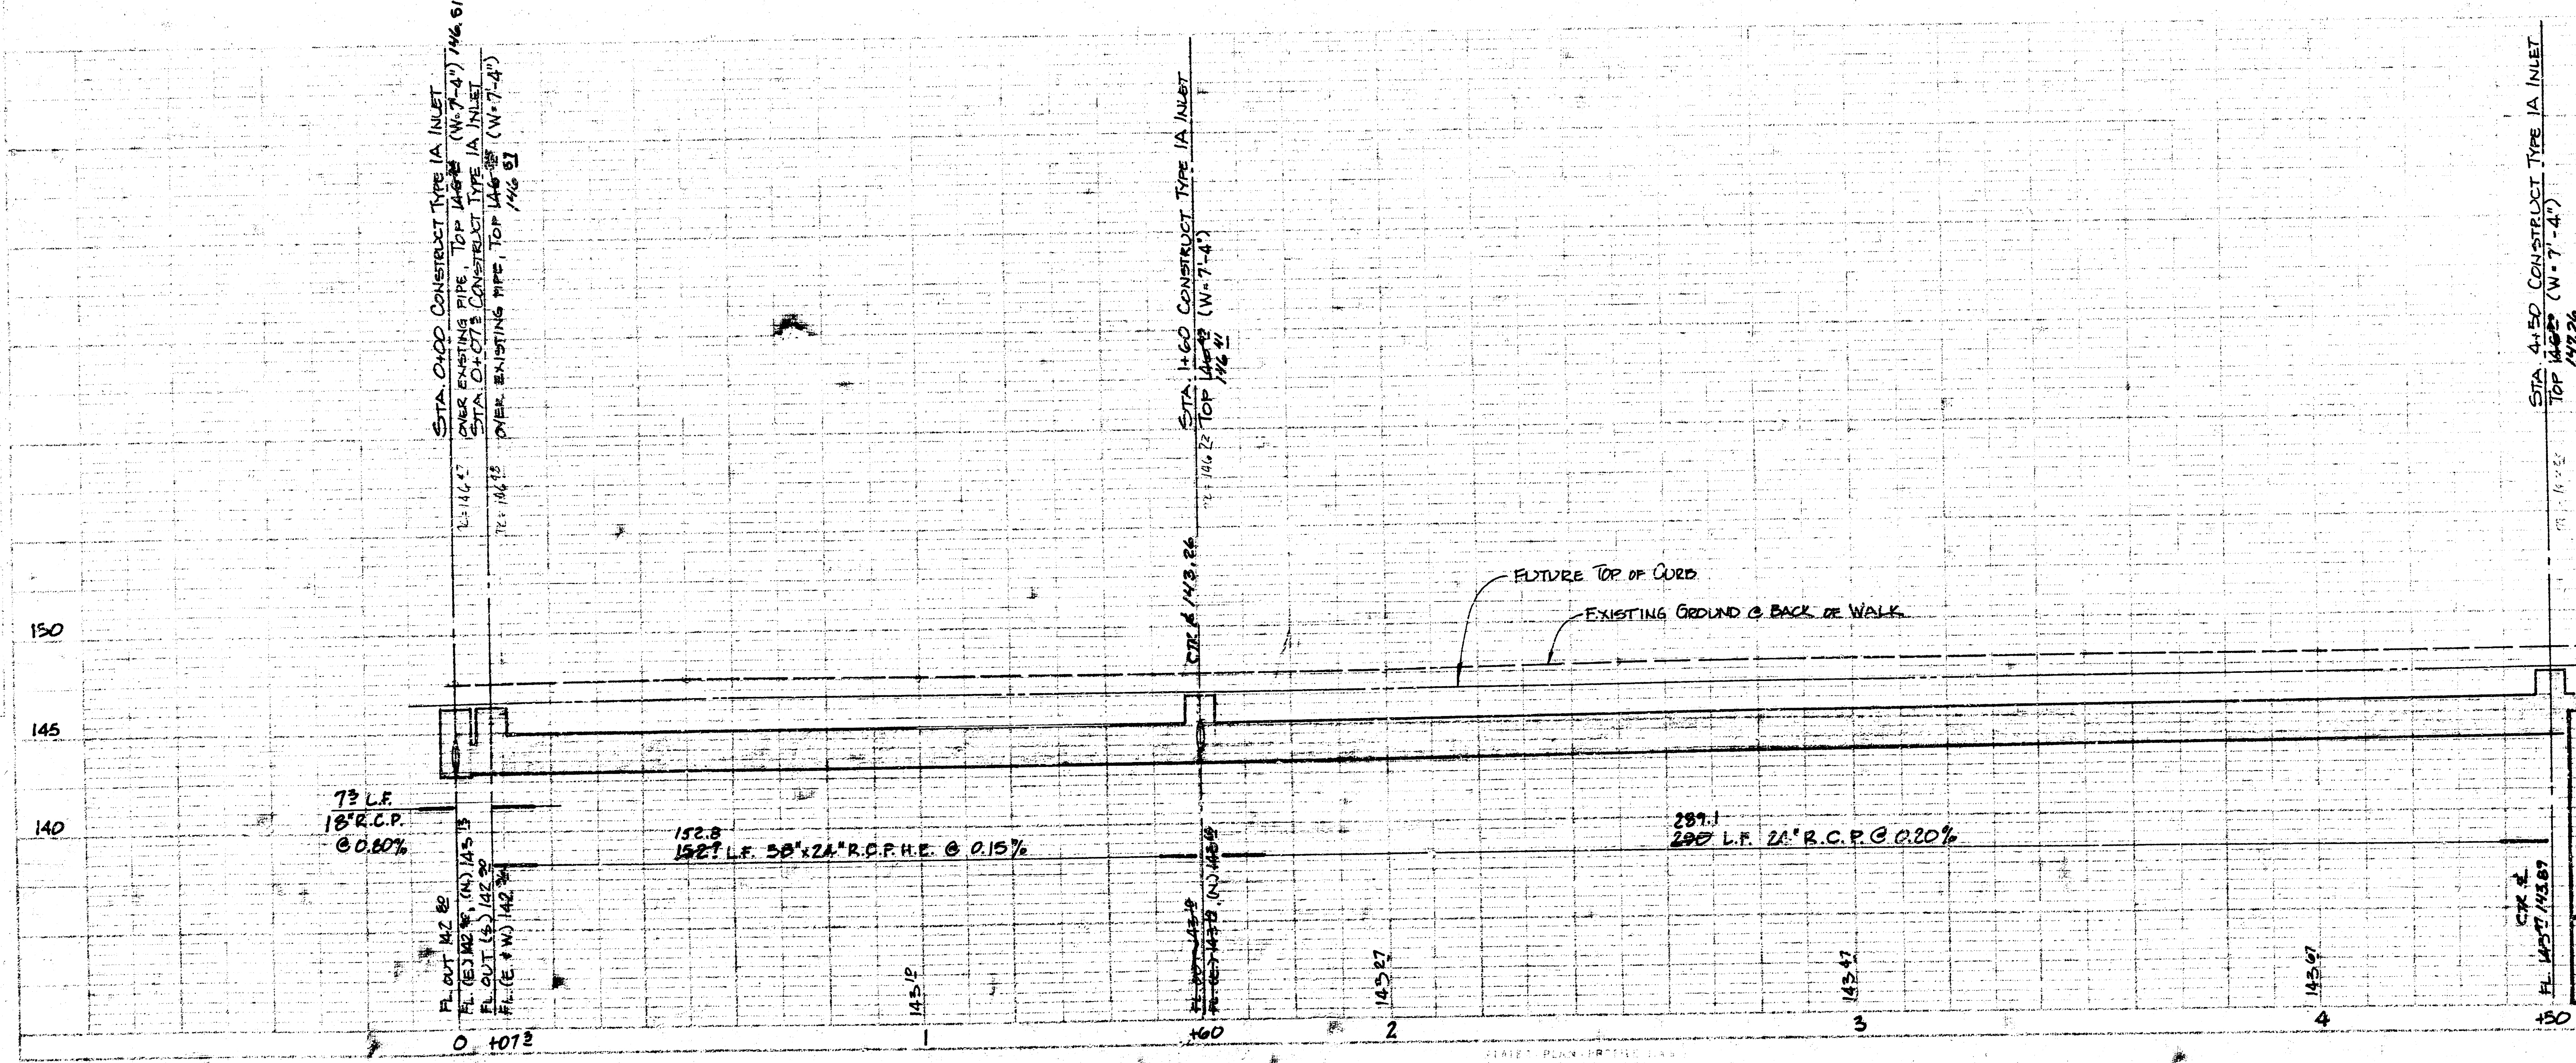


STORM WATER SEWER #252

PLAN and PROFILE

Project no. 468-76-245-81276-000-000-001

BAUGHMAN COMPANY, P.A.
SURVEYING & ENGINEERING
316/262-7271 • 330 LAURA • WICHITA, KANSAS 67211


2/6

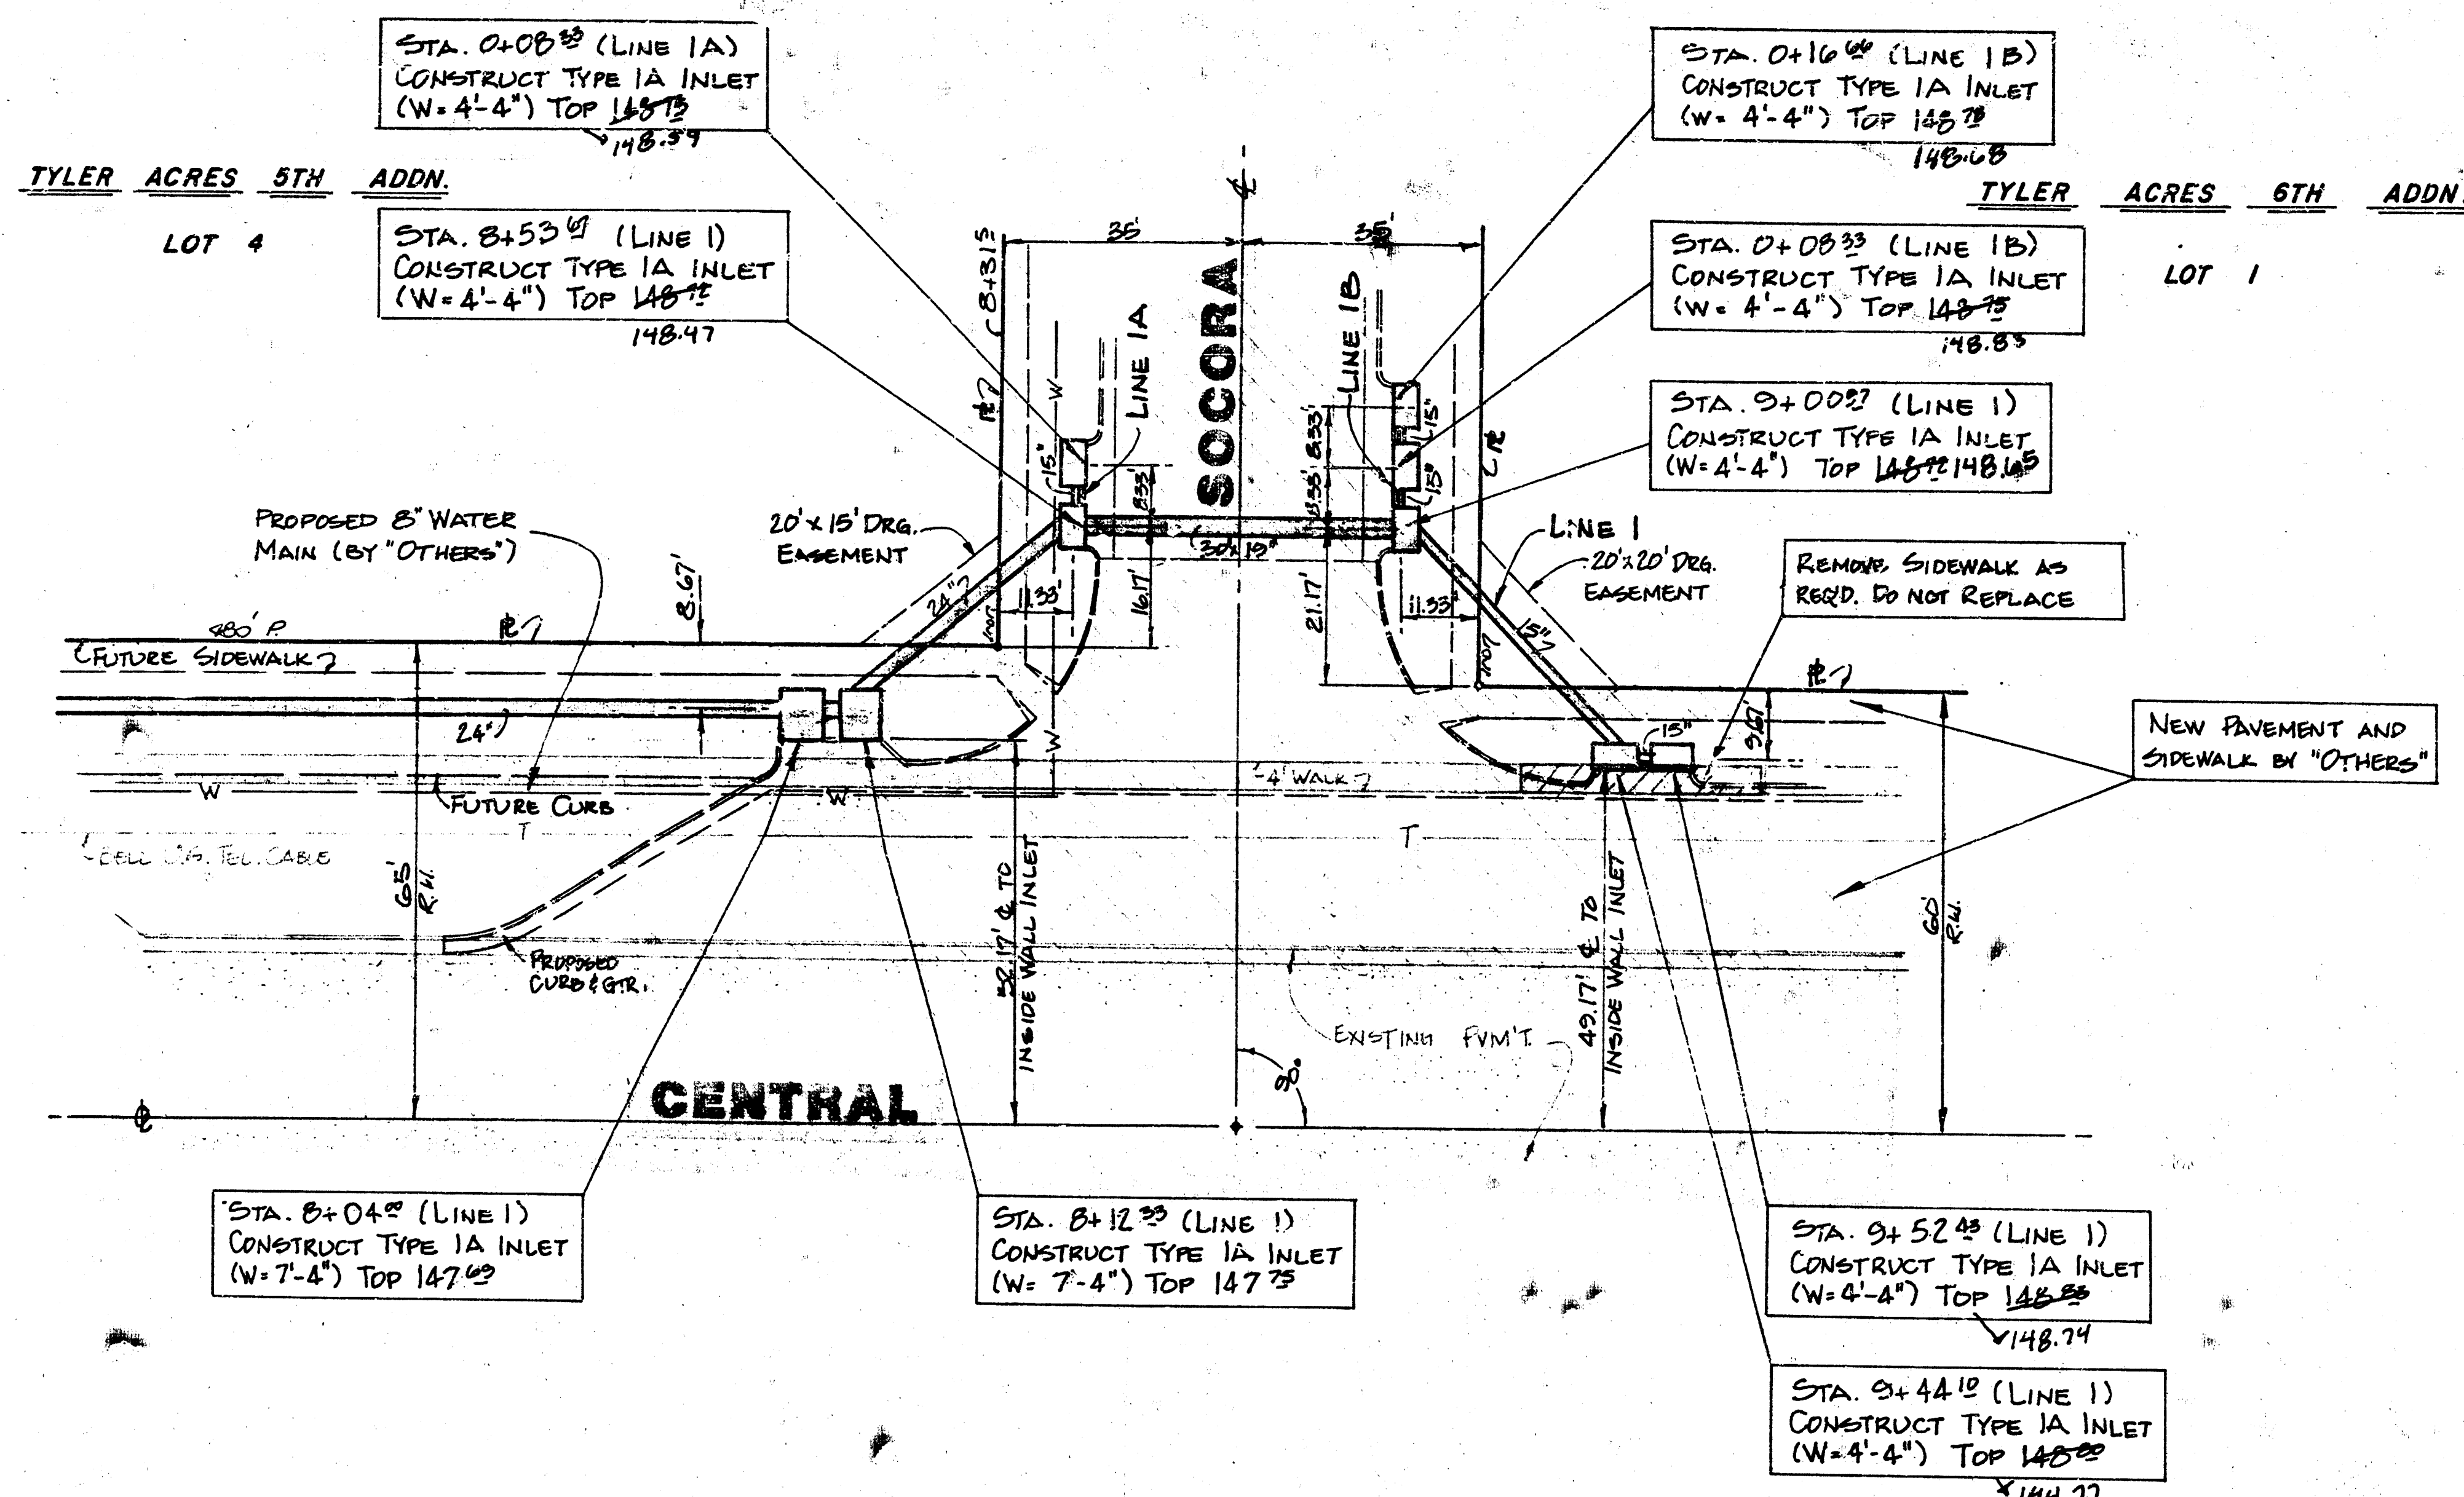

GENERAL NOTES


1. The Contractor shall be responsible for preserving property irons. The Contractor shall be required to re-establish any property irons which are destroyed by his construction operations. Such irons shall be re-established by a licensed land surveyor or a professional engineer, according to state laws.
2. The Contractor shall co-ordinate construction with the water main contractor in order to avoid construction conflicts.
3. The Contractor shall preserve sidewalk along the north side of Central west of Socora during construction. Any such walk damaged or removed shall be replaced at the Contractor's expense. Sidewalk east of Socora may be removed only as required for inlet construction.
4. All inlets in this project along Central shall be backfilled to match existing grade. Inlet openings shall be sealed with brick masonry to prevent entry of dirt or debris.
5. Inlets from Sta. 0+00 to and including Sta. 8+12.33 shall be constructed according to Modified Details, sheet 6. All other inlets in this project shall be constructed according to Standard Details, sheet 5.

AS BUILT PLAN
9/84
MCGEE

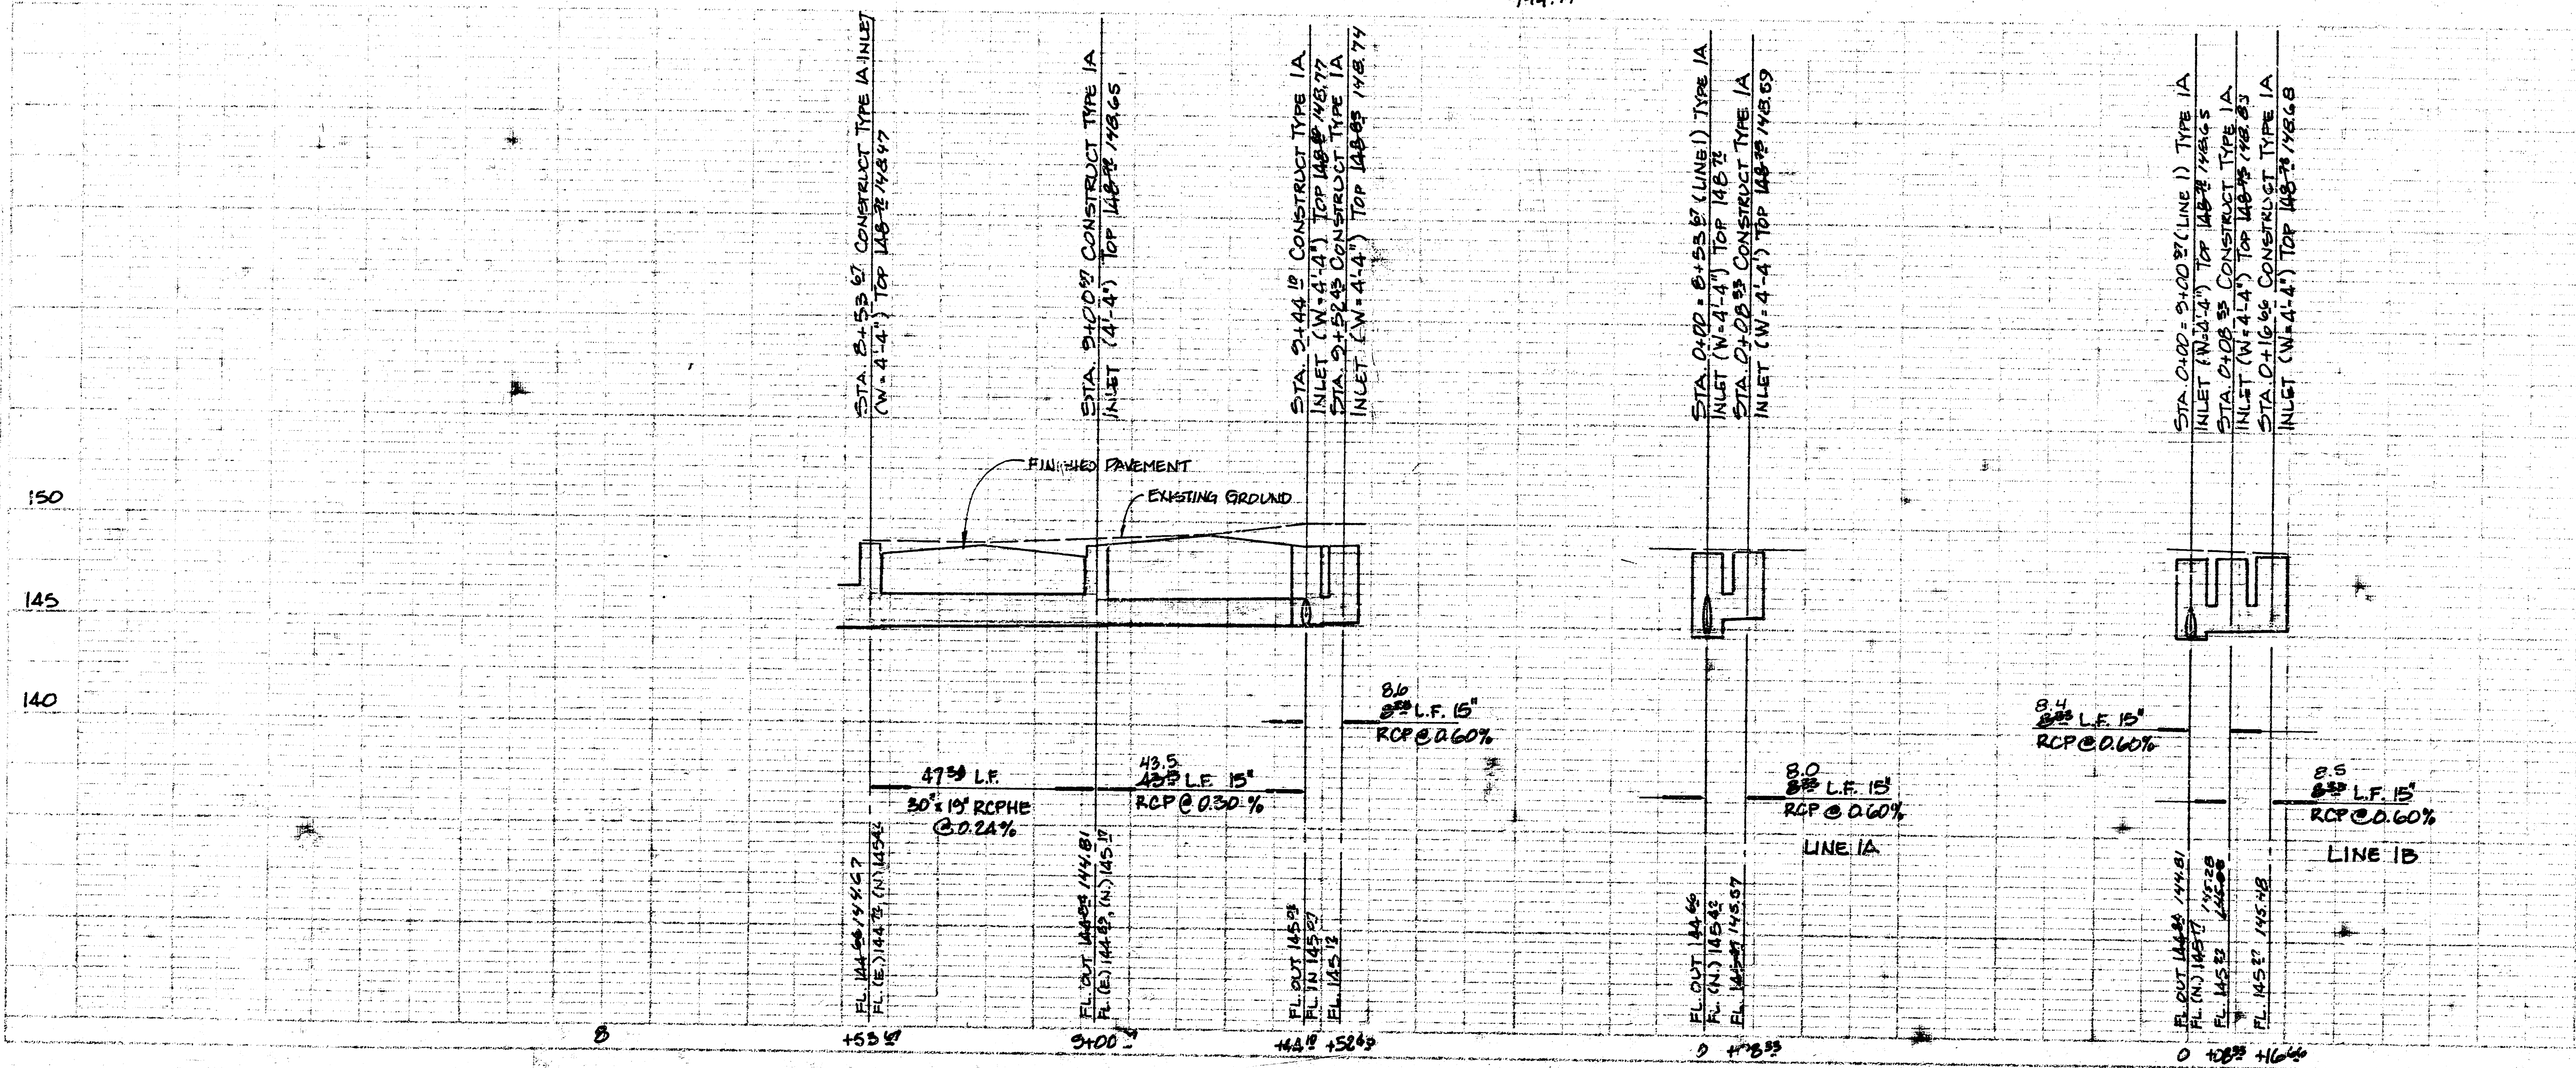

PROFILE SCALE
1"=20' HORIZ.
1"=5' VERT.

STORM WATER SEWER #252
PLAN and PROFILE
 Project no. 488-76-245-81276-000-000-001
BAUGHMAN COMPANY, P.A.
 SURVEYING & ENGINEERING
 314/262-7271 • 350 LAURA • WICHITA, KANSAS 67211

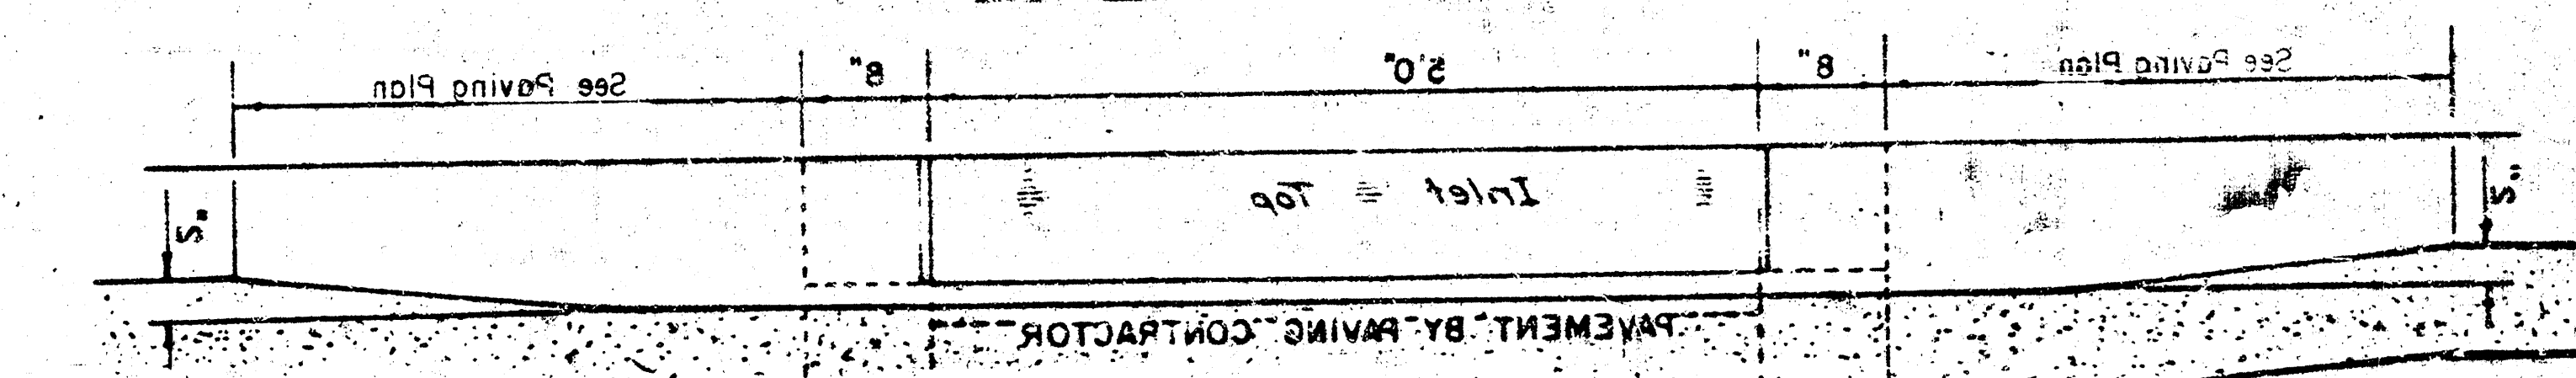

W	PRECAST TOP SIZE	Pipe Size	CU YD CONC
4' 0"	36" x 60" x 12.5'	36" x 60" x 12.5'	0.372
4' 6"	42" x 66" x 15'	42" x 66" x 15'	0.517
5' 0"	48" x 72" x 15'	48" x 72" x 15'	0.641
5' 6"	54" x 78" x 15'	54" x 78" x 15'	0.771
6' 0"	60" x 84" x 15'	60" x 84" x 15'	0.902

WT	BAR										NUMBER	SIZE	LENGTH				
	01	02	03	04	05	06	07	08	09	10			W=4.0	W=5.0	W=6.0	W=7.0	
120	13.0	8.0	-	-	-	-	-	-	-	-	1.0	1.0	1.0	1.0			
130	14.0	9.0	-	-	-	-	-	-	-	-	1.0	1.0	1.0	1.0			
140	15.0	10.0	-	-	-	-	-	-	-	-	1.0	1.0	1.0	1.0			
1290	130.0	125.0	-	-	-	-	-	-	-	-	1.0	1.0	1.0	1.0			
1300	131.0	126.0	-	-	-	-	-	-	-	-	1.0	1.0	1.0				

BENDING DIAGRAM

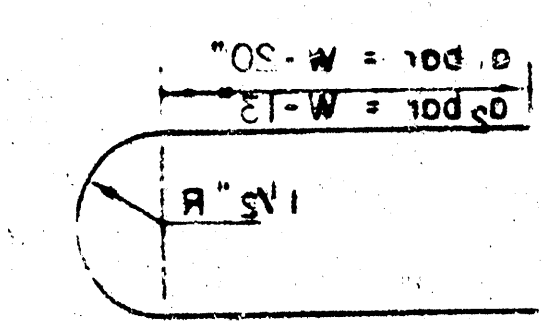
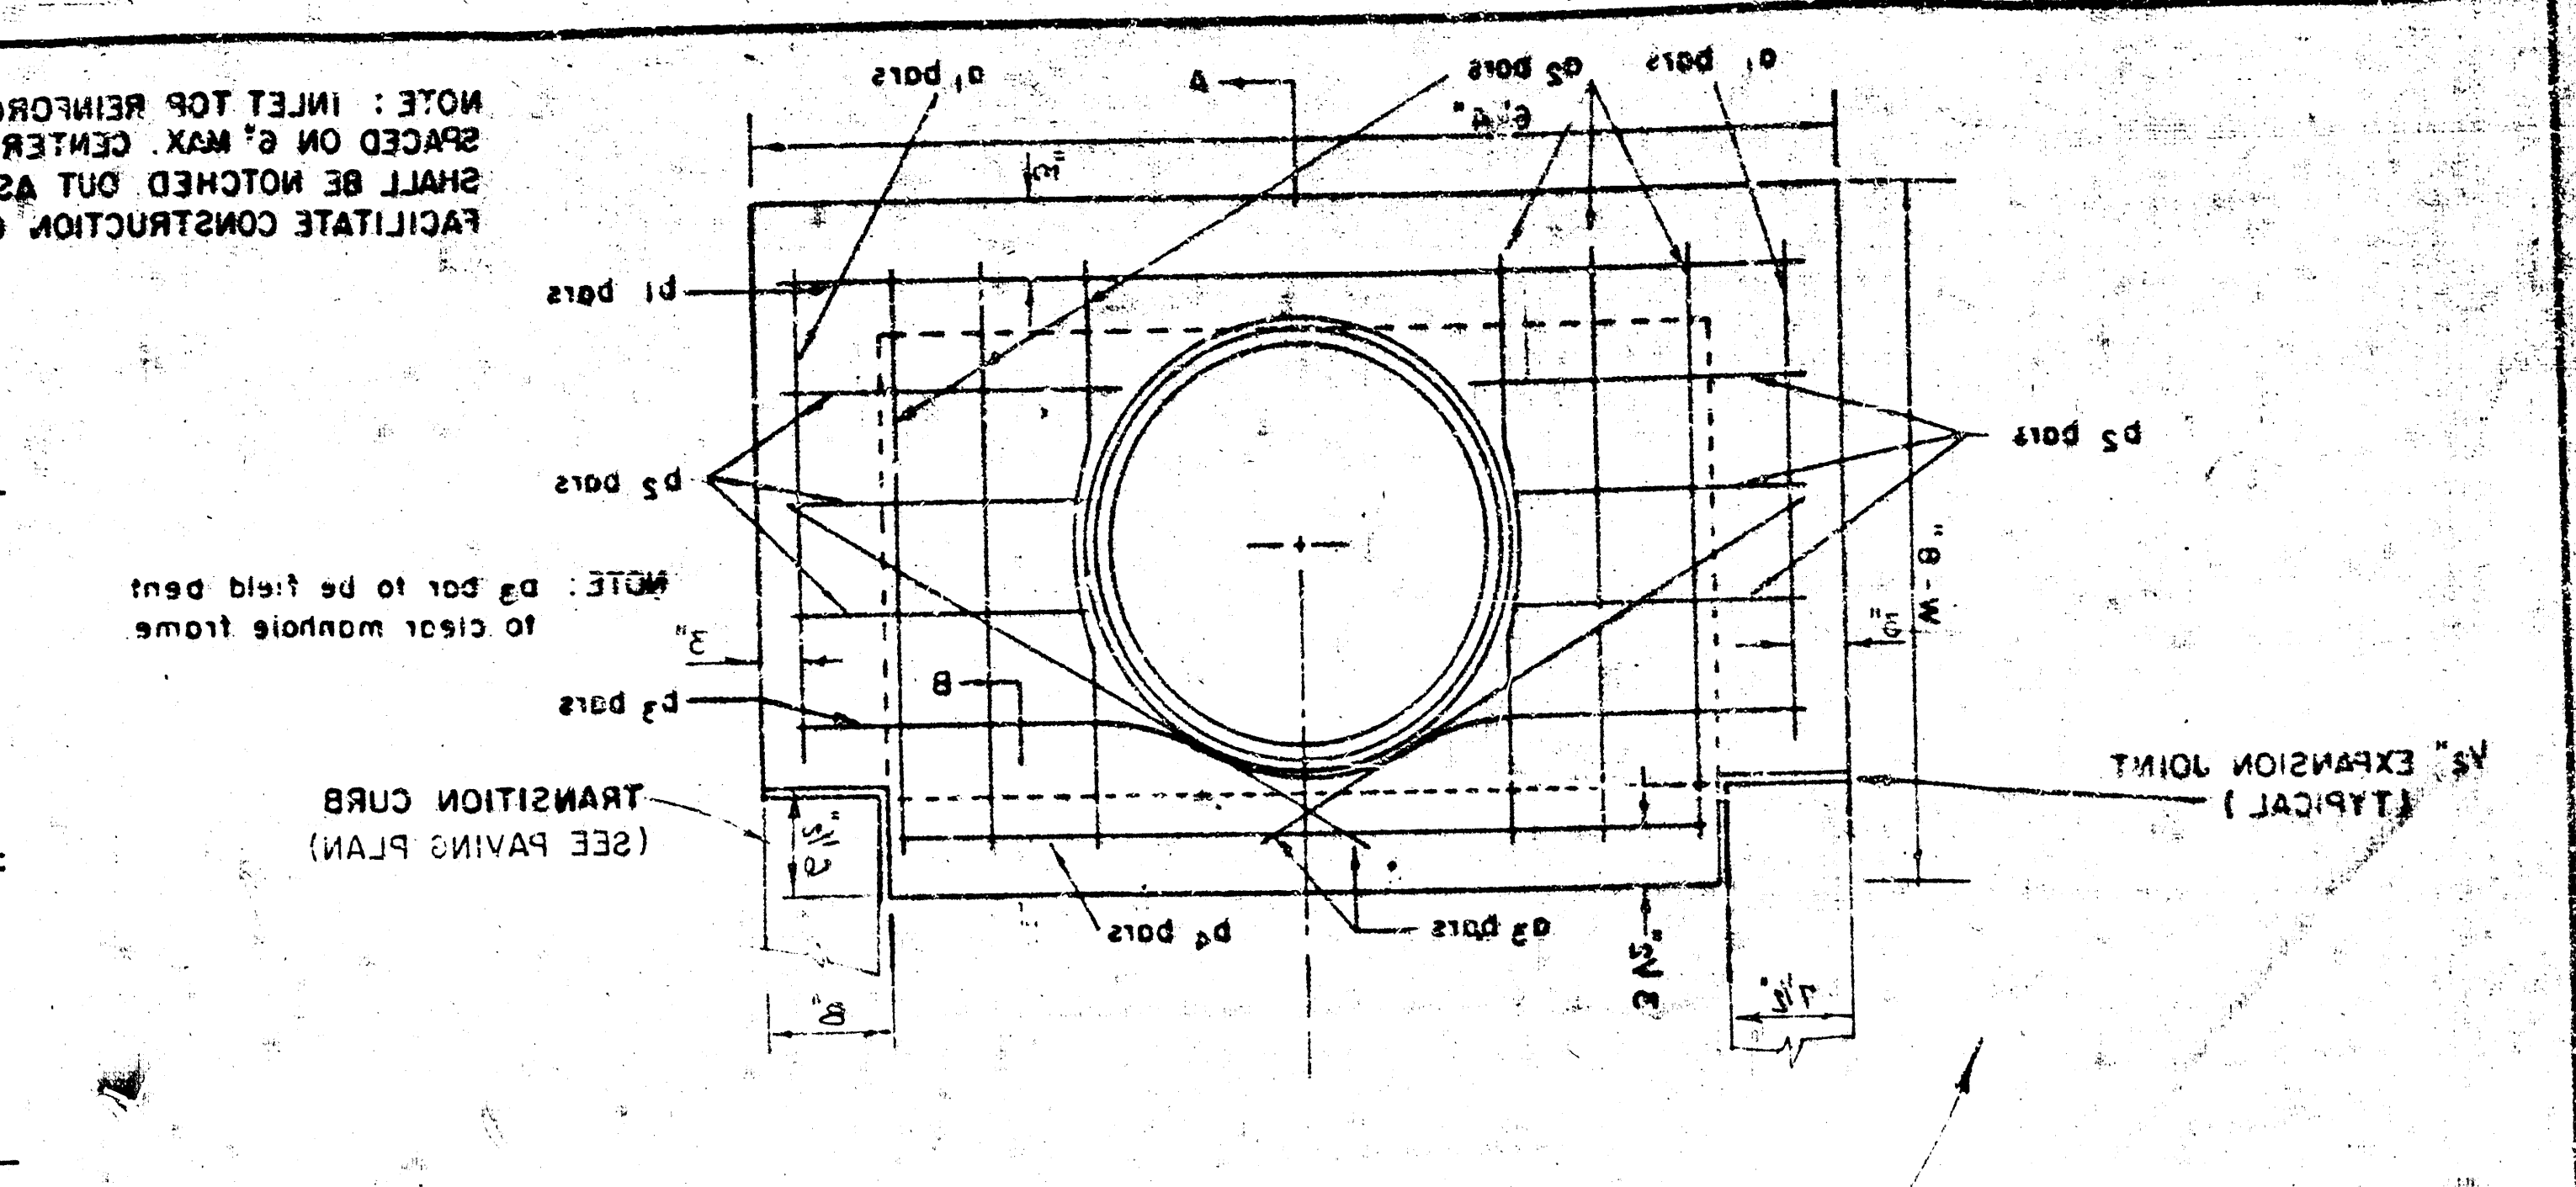
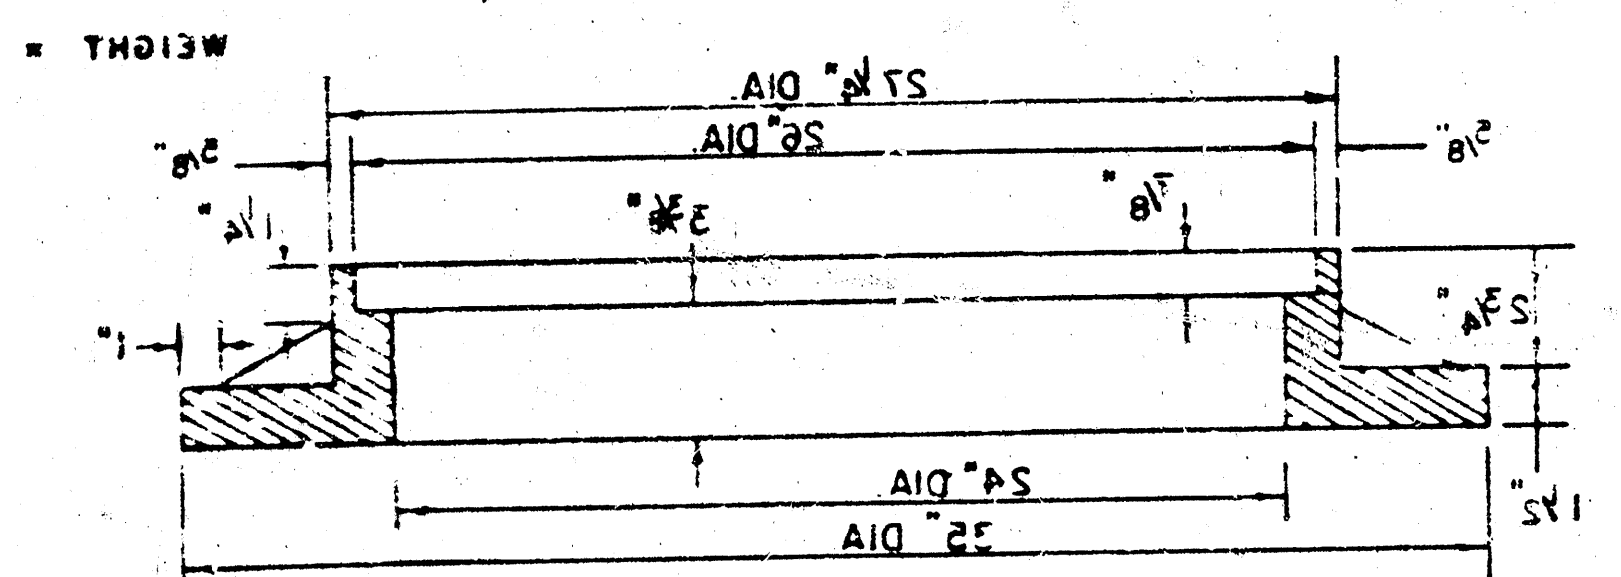


Diagram illustrating the plan view of a gutter installation. The gutter is shown as a horizontal line. The flow direction is indicated by an arrow pointing from right to left, labeled "FLOW LINE". The gutter is labeled "STD. GUTTER". The layout dimensions are indicated by a curved arrow pointing to the gutter, labeled "SEE CENTRAL PAVING PLAN FOR INLET LAYOUT DIMENSIONS". The gutter is shown with a vertical line on the right side, labeled "C".

[illegible]

TO BE USED WITH INLET FRAME.
AND COVER DETAIL SHEET FOR COVER DETAILS
SEE CITY OF WICHITA STANDARD MANHOLE FRAME