

STORM SEWER PLANS FOR

S.W.S. NO. 318

GOLF PARK WEST

PROJECT NO.

468-76-245-81612-000-000-001



INDEX TO DRAWINGS

SHEET NO.	DESCRIPTION
1	Title Sheet
2	Plan and Profile

CITY OF WICHITA  
MICHAEL E. LINDEBAK, CITY ENGINEER  
MARCH, 1988


GENERAL NOTES

THE CONTRACTOR SHALL BE RESPONSIBLE FOR PRESERVING PROPERTY IRONS. THE CONTRACTOR SHALL BE REQUIRED TO RE-ESTABLISH ANY PROPERTY IRONS WHICH ARE DAMAGED OR DESTROYED BY HIS CONSTRUCTION OPERATIONS. SUCH IRONS SHALL BE RE-ESTABLISHED BY A LICENSED LAND SURVEYOR OR A LICENSED PROFESSIONAL ENGINEER IN ACCORDANCE WITH STATE LAWS.

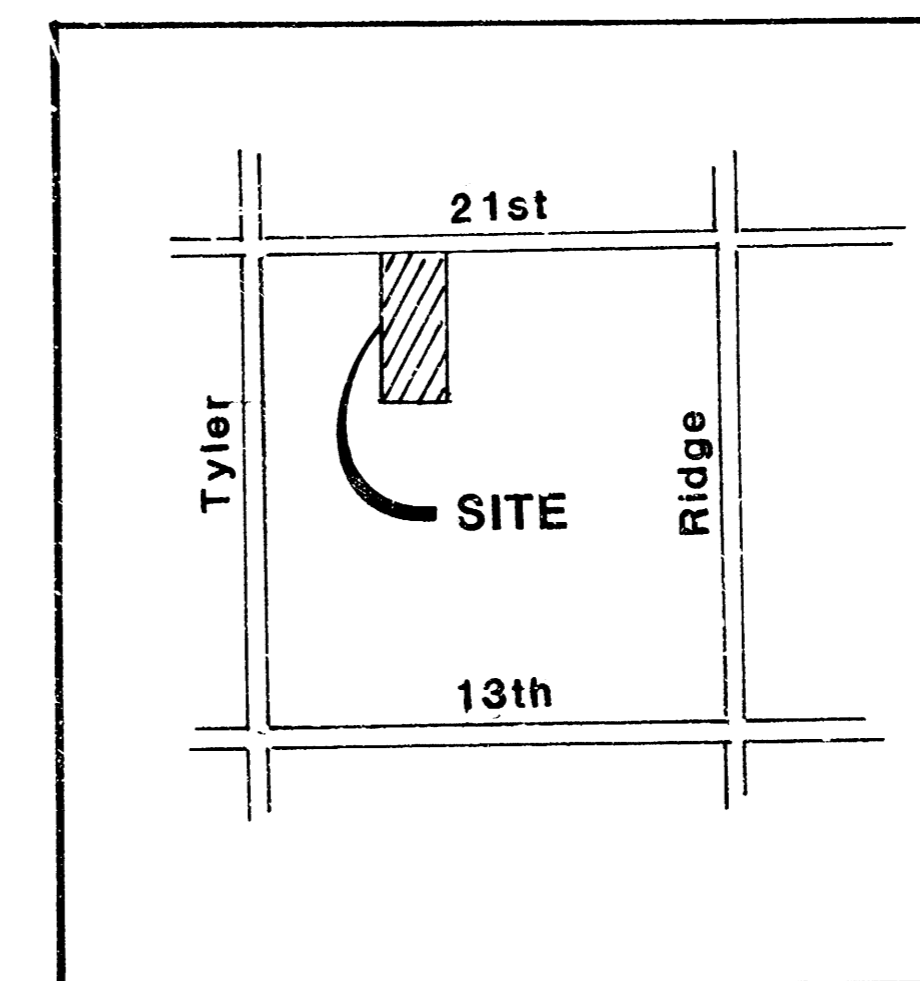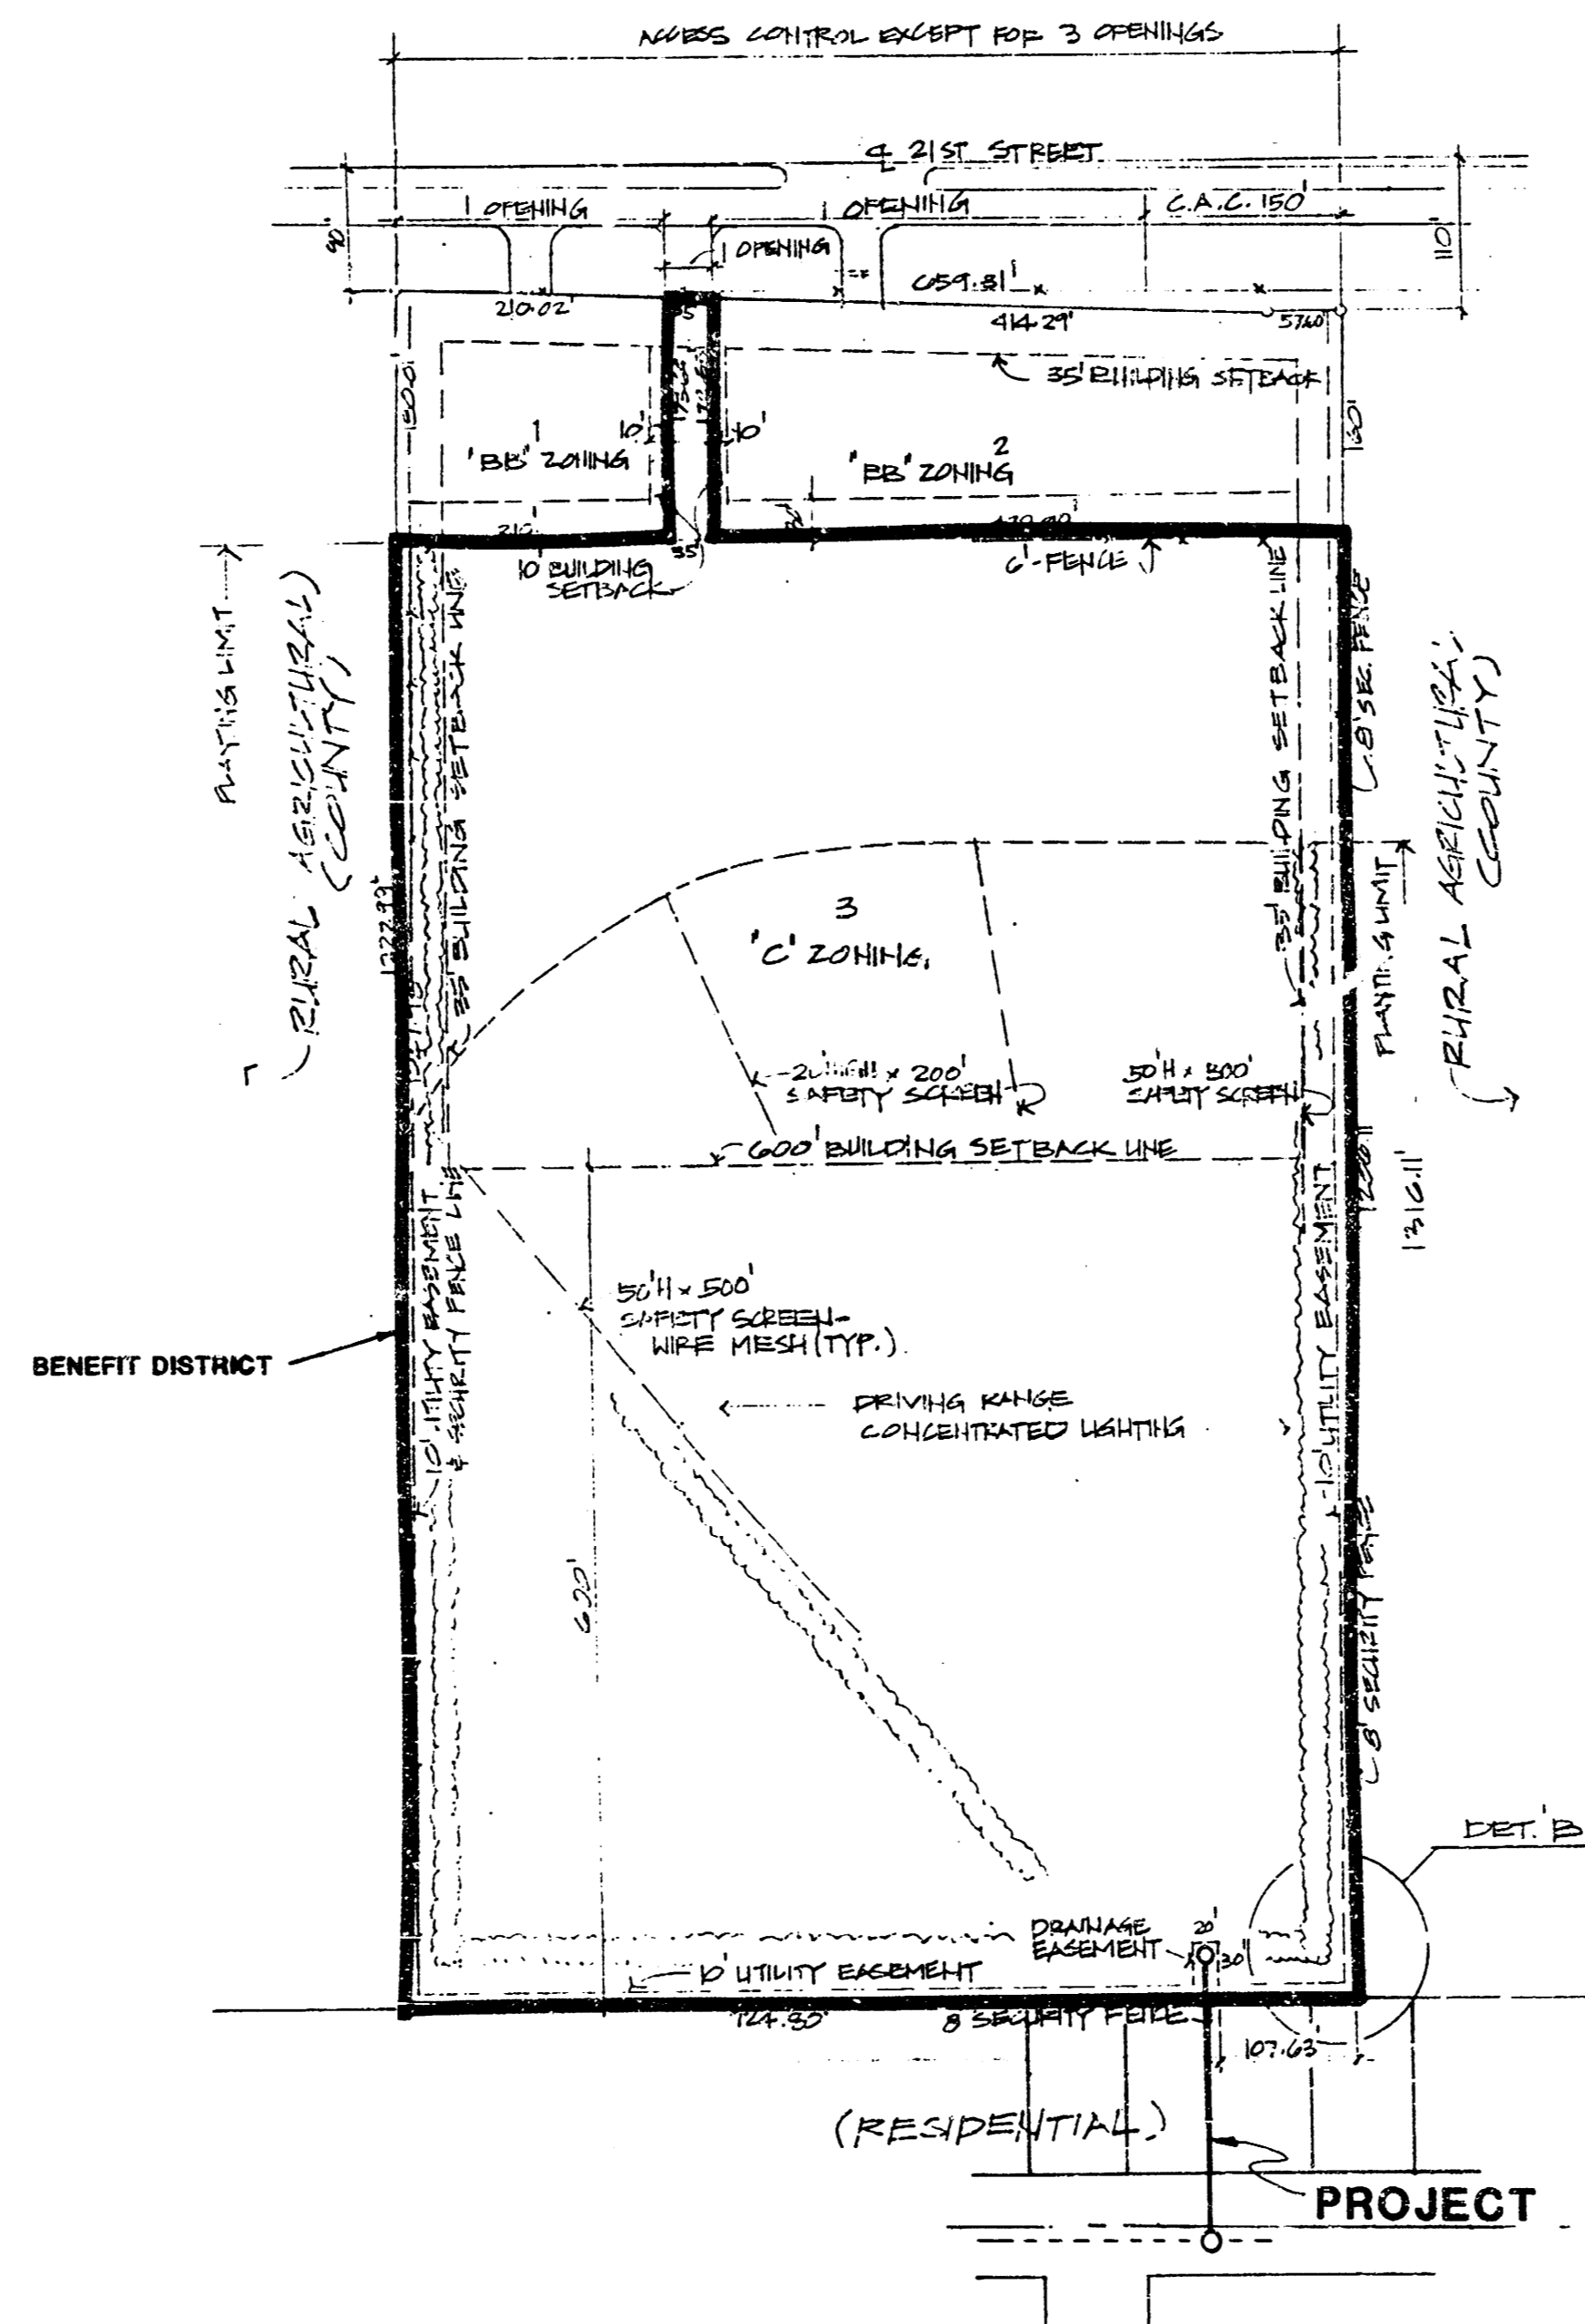

LOCATION MAP





*BOULEVARD: FURNISHED  
AS BUILTS  
6/88  
MCC  
D-101*

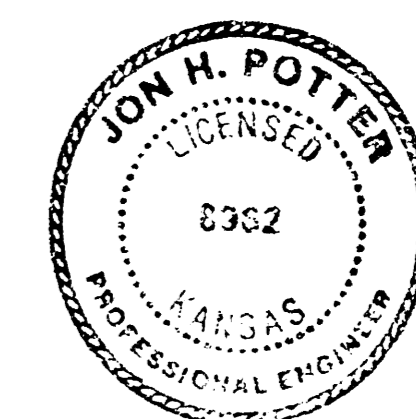

1/2

FILMED FROM THE BEST AVAILABLE COPY ...



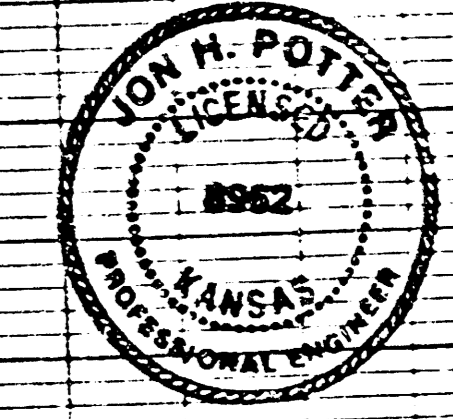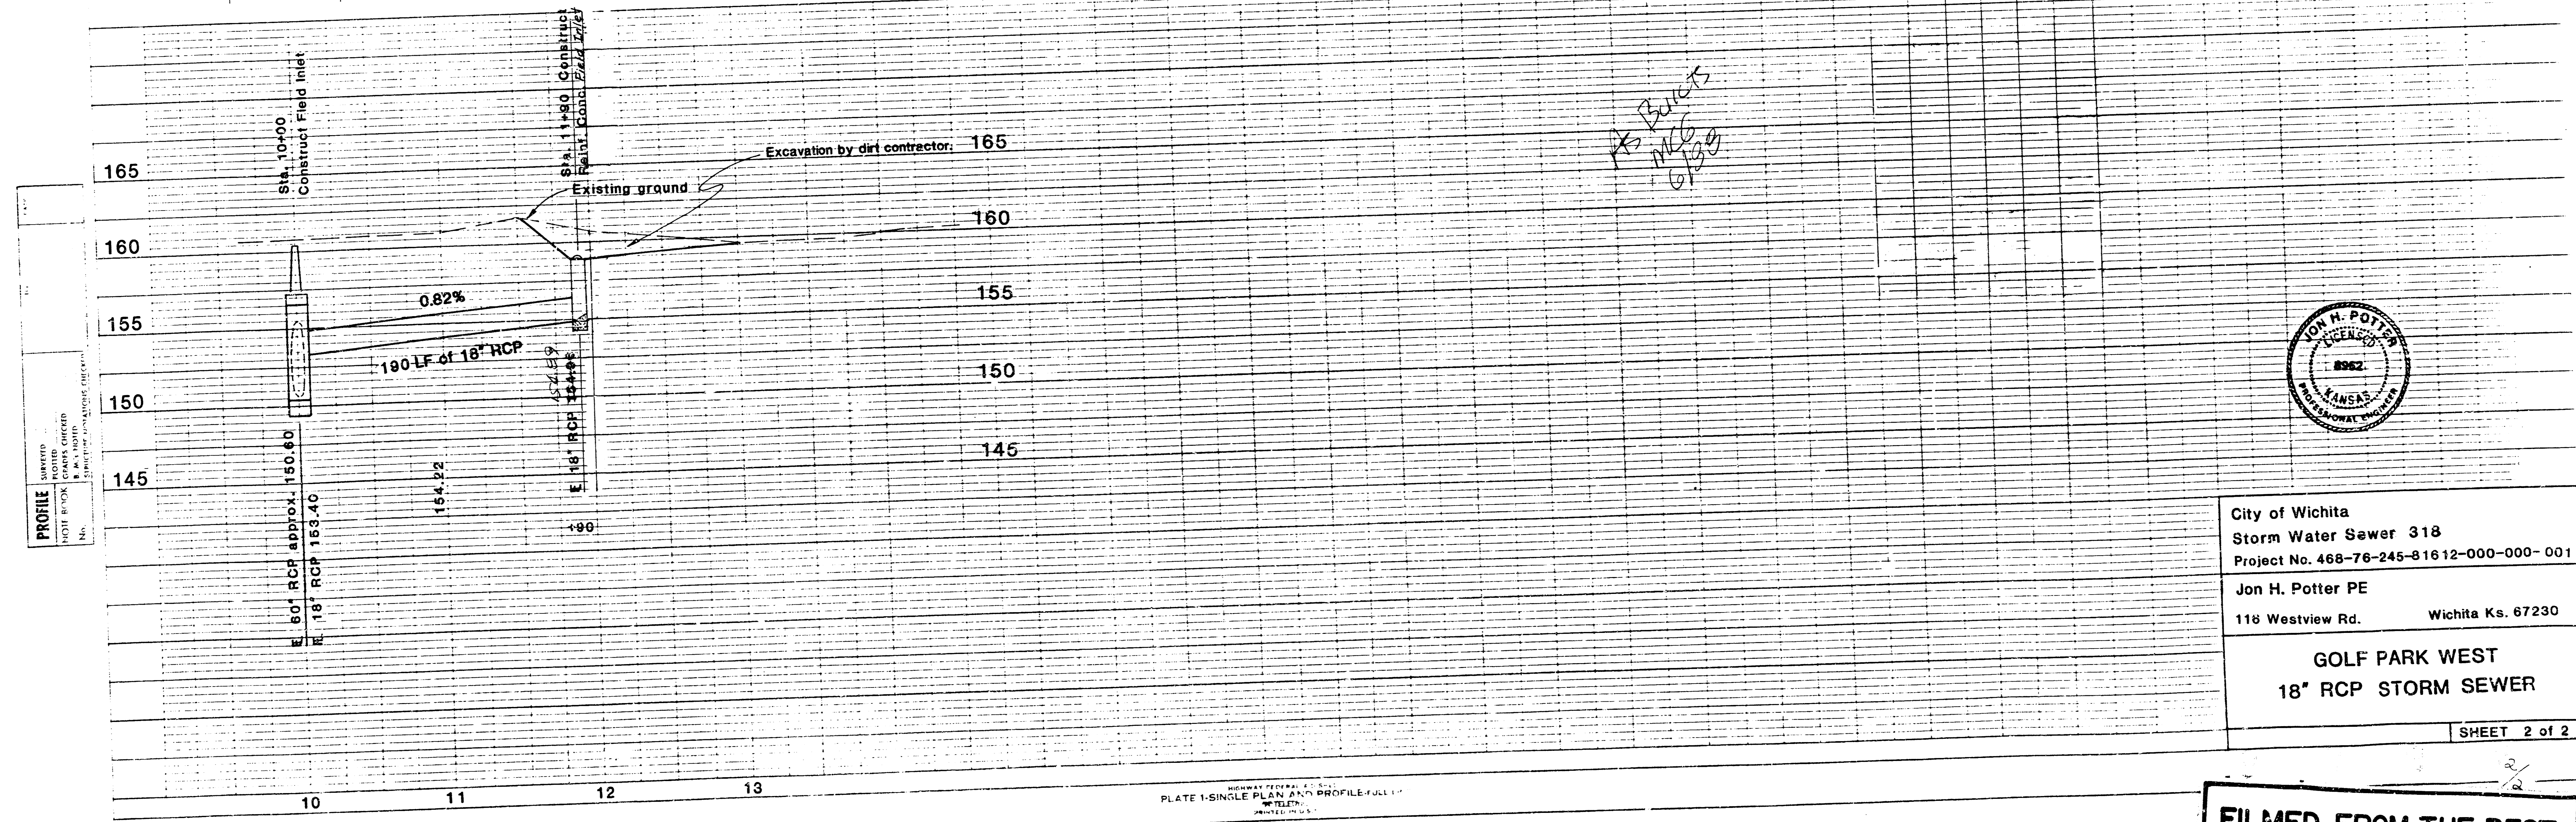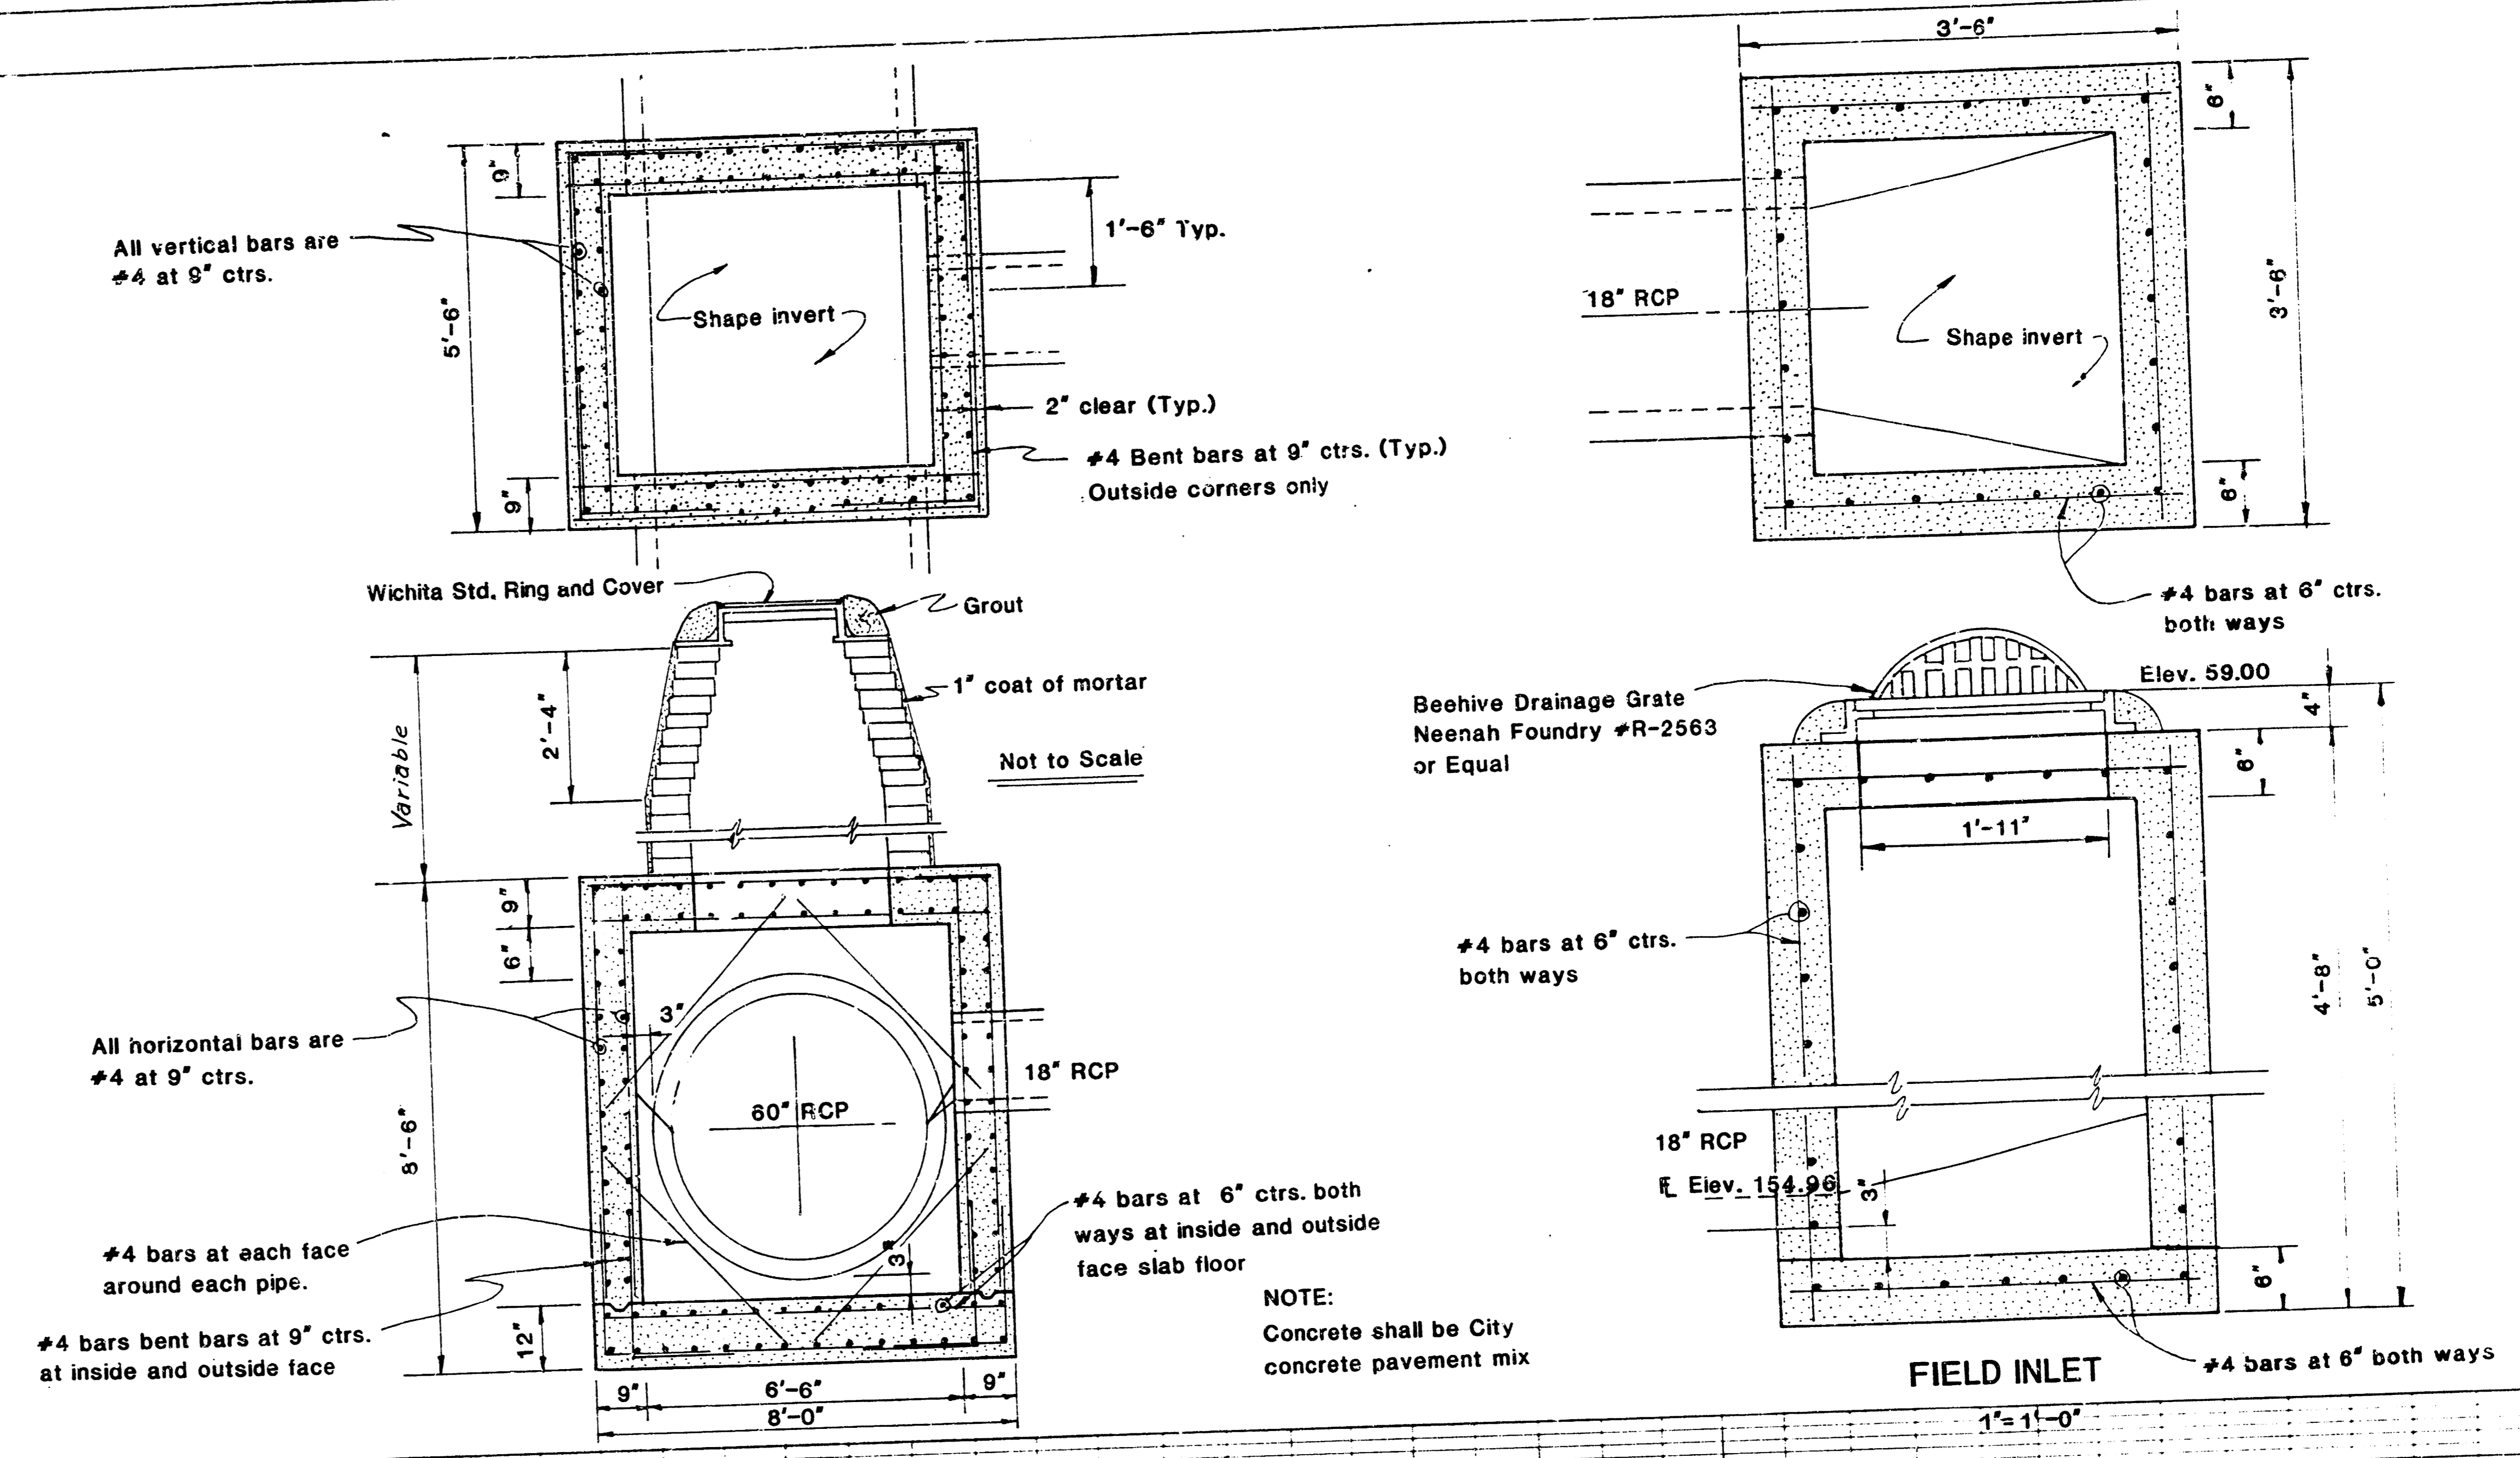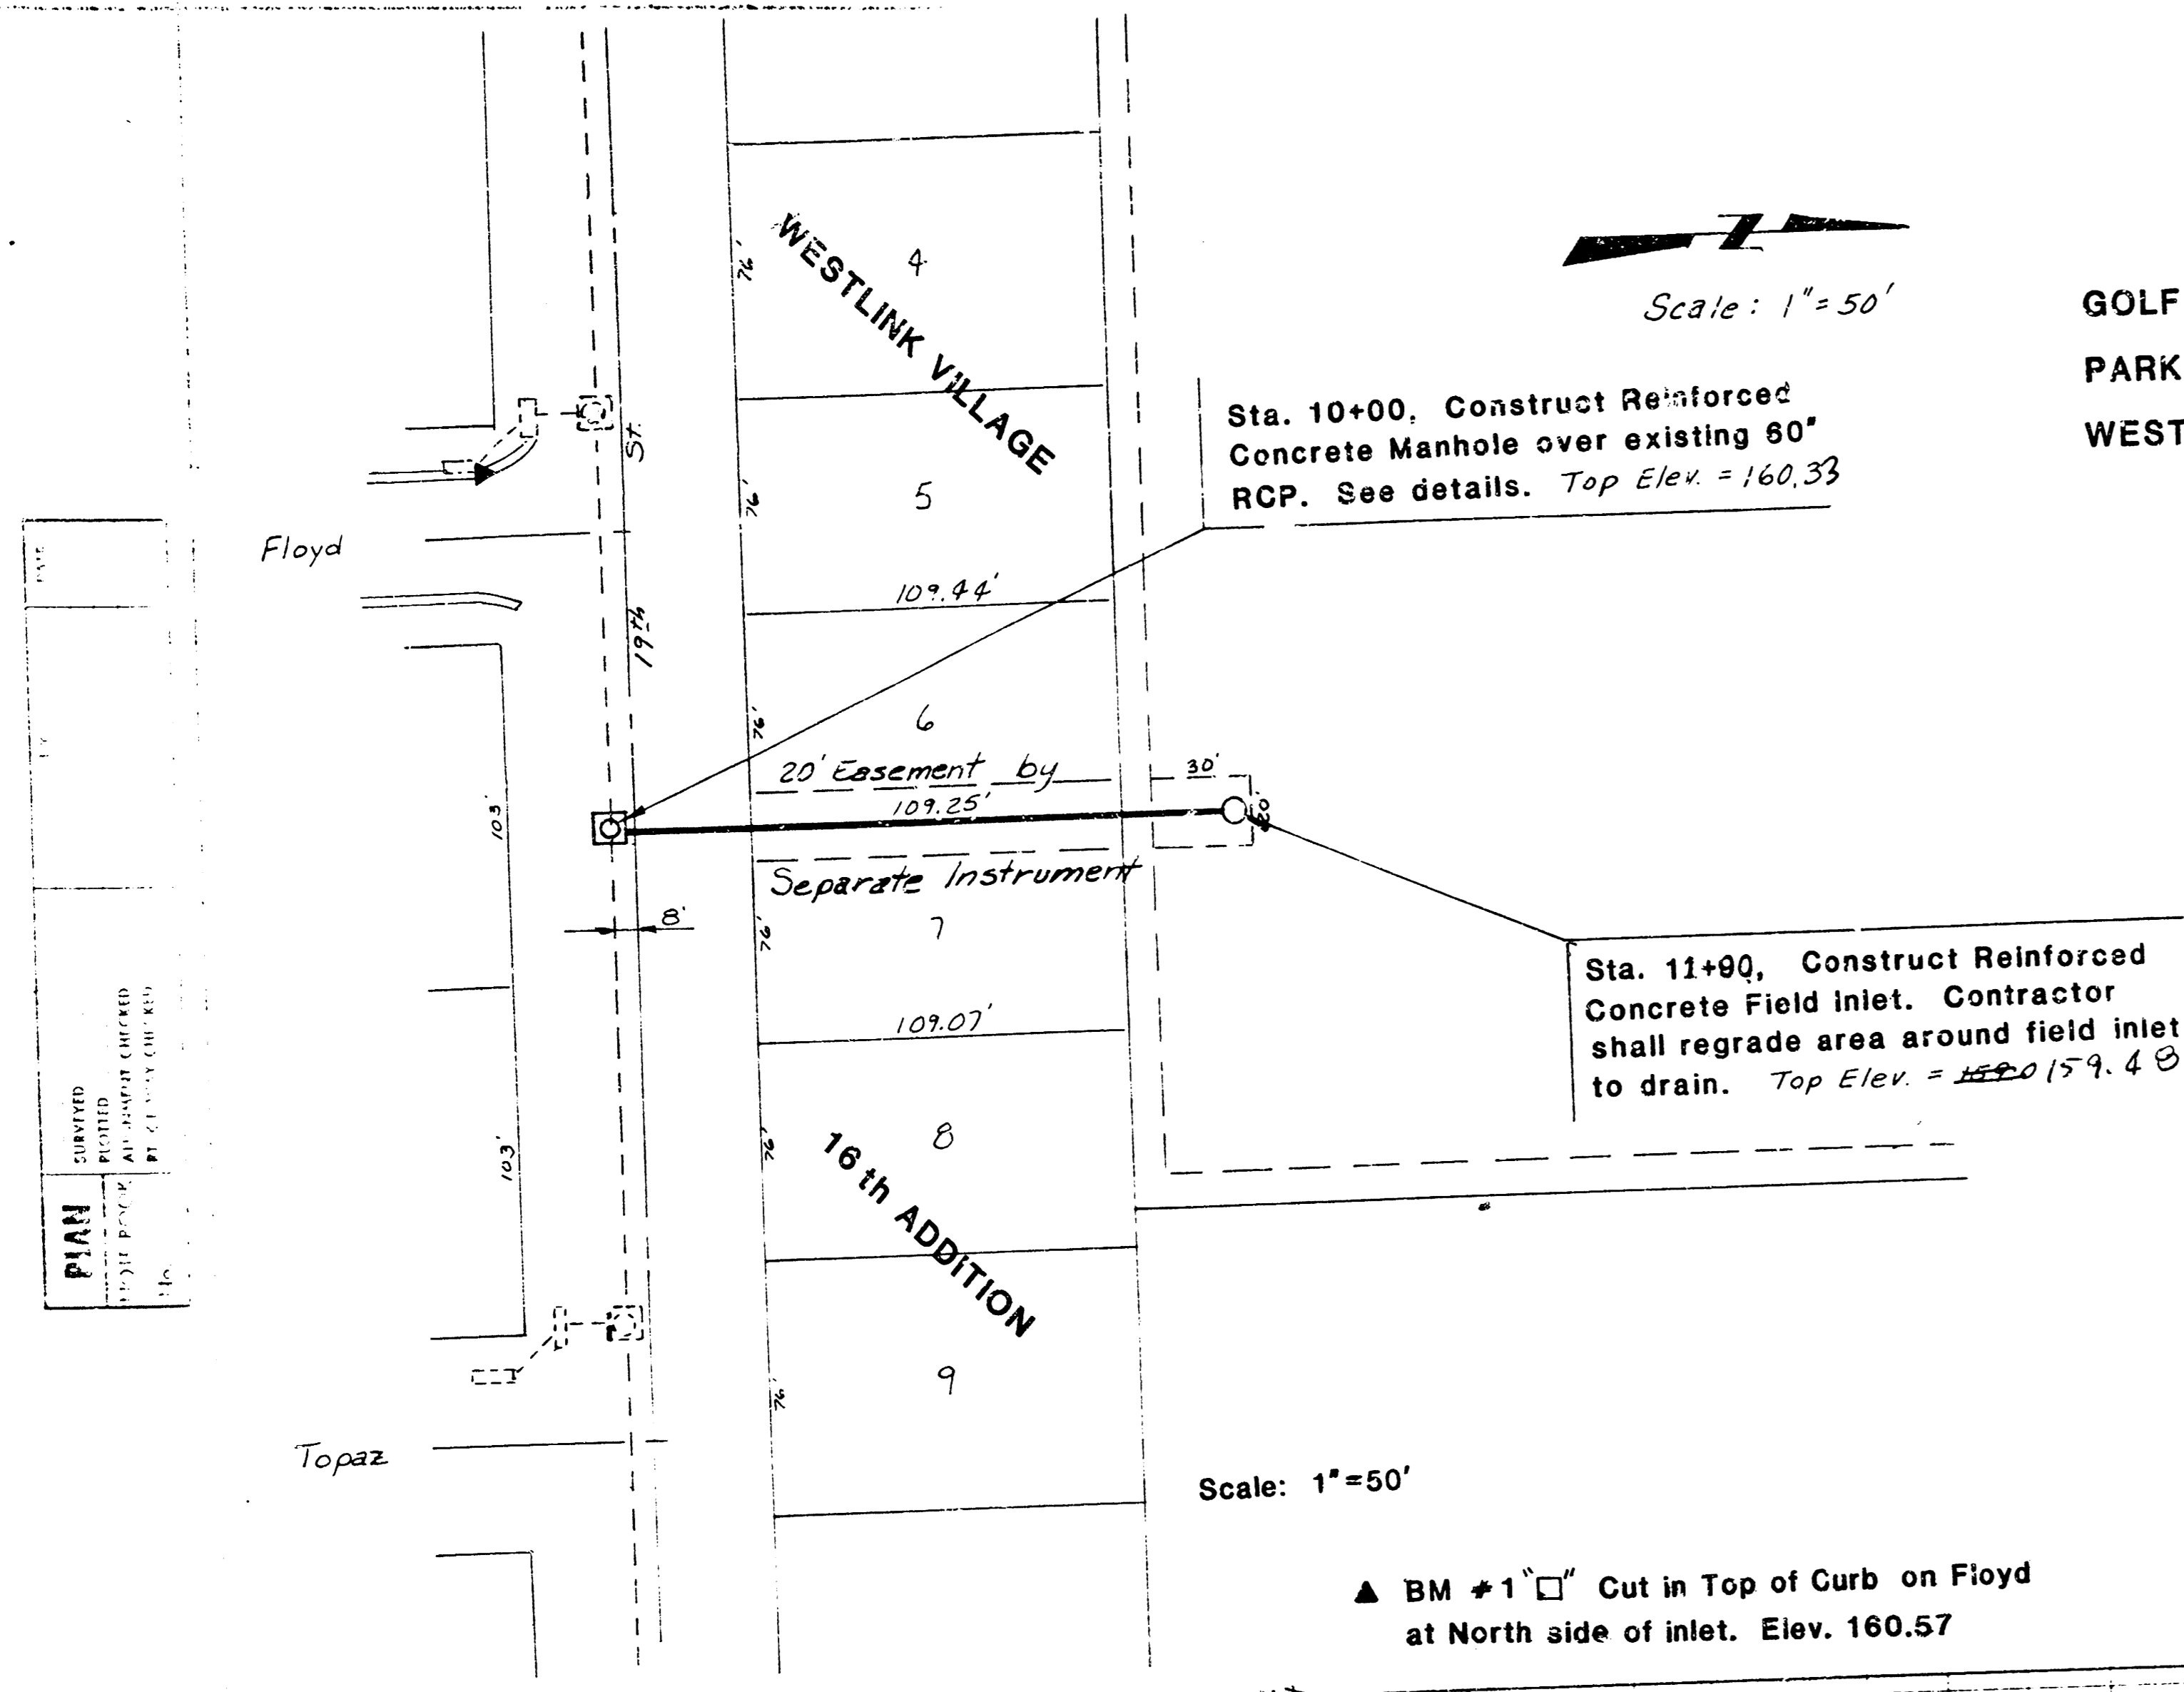

City of Wichita  
 Storm Water Sewer 318  
 Project No. 468-76-245-816 12-000-001

Jon H. Potter PE  
 118 Westview Rd. Wichita Ks. 67230

GOLF PARK WEST  
 18" RCP STORM SEWER

SHEET 2 of 2

FILMED FROM THE BEST AVAILABLE COPY....