


Shown W/G  
 JEA  
 10/2/63

B.M. 114.02 "X" cut top N. End 6" Conc. Ref. Wall on S.W. corner Water & First Street.

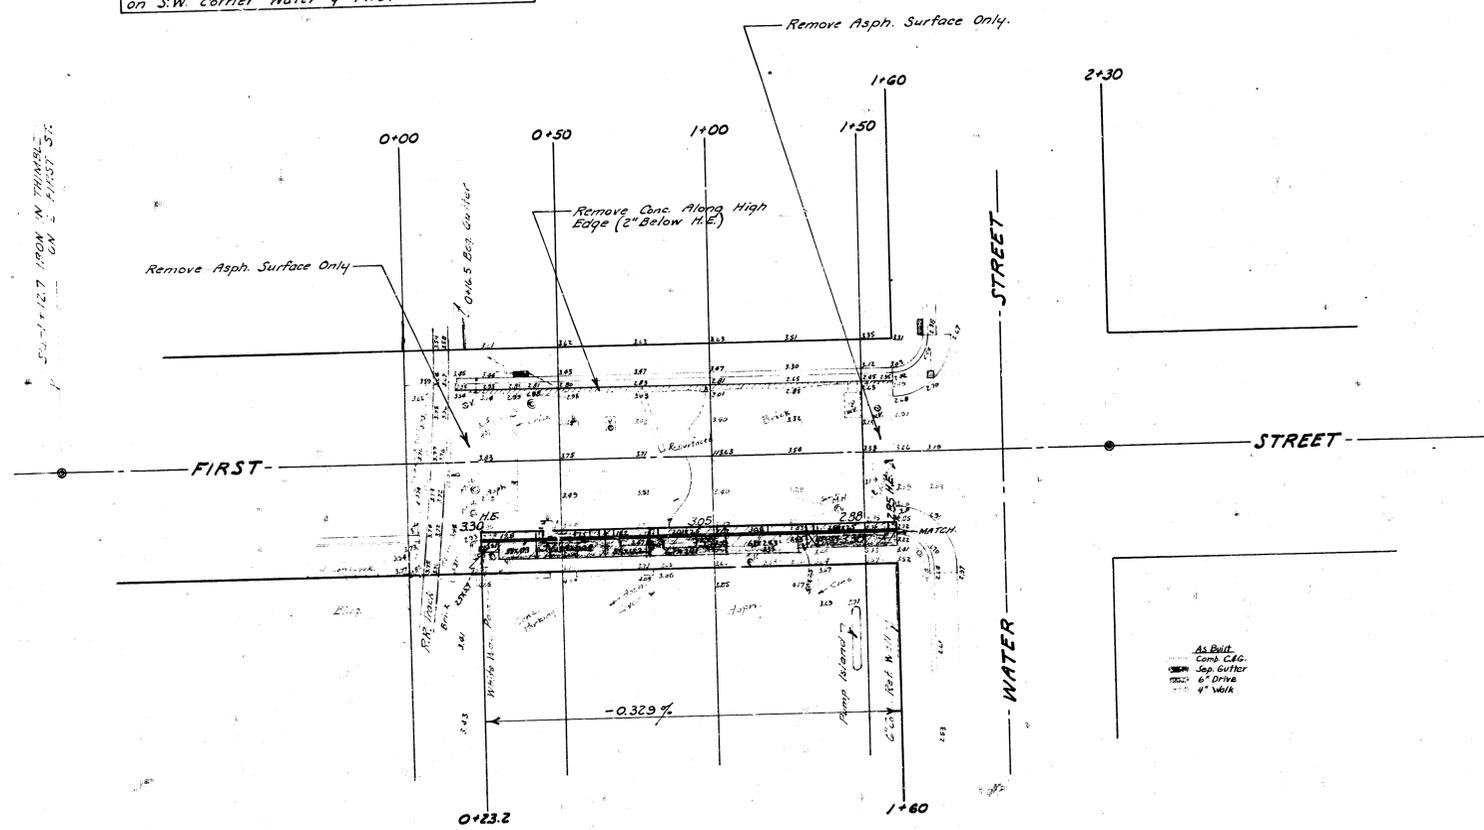

As Built  
 Comb. C&G.  
 Sep. Gutter  
 6" Drive  
 4" Walk

NOTE: Walk & Drive Removal South of South Curb to be held to a minimum.

**FIRST STREET**  
 FROM 160' W. of W.L. WATER ST.  
 to the W.L. WATER STREET  
 Comb. Curb & Gutter - 2" Asph.  
 Surface Improve & Re-Improve.  
 B.E. SMITH CITY ENGINEER  
 CITY OF WICHITA, KANSAS  
 SEPT. 1963 Project No. T16-33

