

B.M. 12706 "T" in TROY Fire Hydrant S.E. Cor. 25th & Market
 3.M. 12874 N.E. Cor. Coping N.W. Cor. Canal Bridge on Market

Stationing on &


Exc.	Prop.	Exc.	Prop.
74.5	14.5	22.0	22.0
41.5	11.5	23.0	23.0
Total 88.0 cu yds.	Total 16.1 cu yds.	Total 37.0 cu yds.	Total 10.0 cu yds.

NOTE TO FIELD ENGINEER:
 Get ties to iron @ 25th & Market
 before construction of this project


15" X 20" C.M.P. to be installed
 by Street Department

Open ditch to be dug
 by Street Department

Surveyed by A-E
 Plan 100
 Checked J.D.

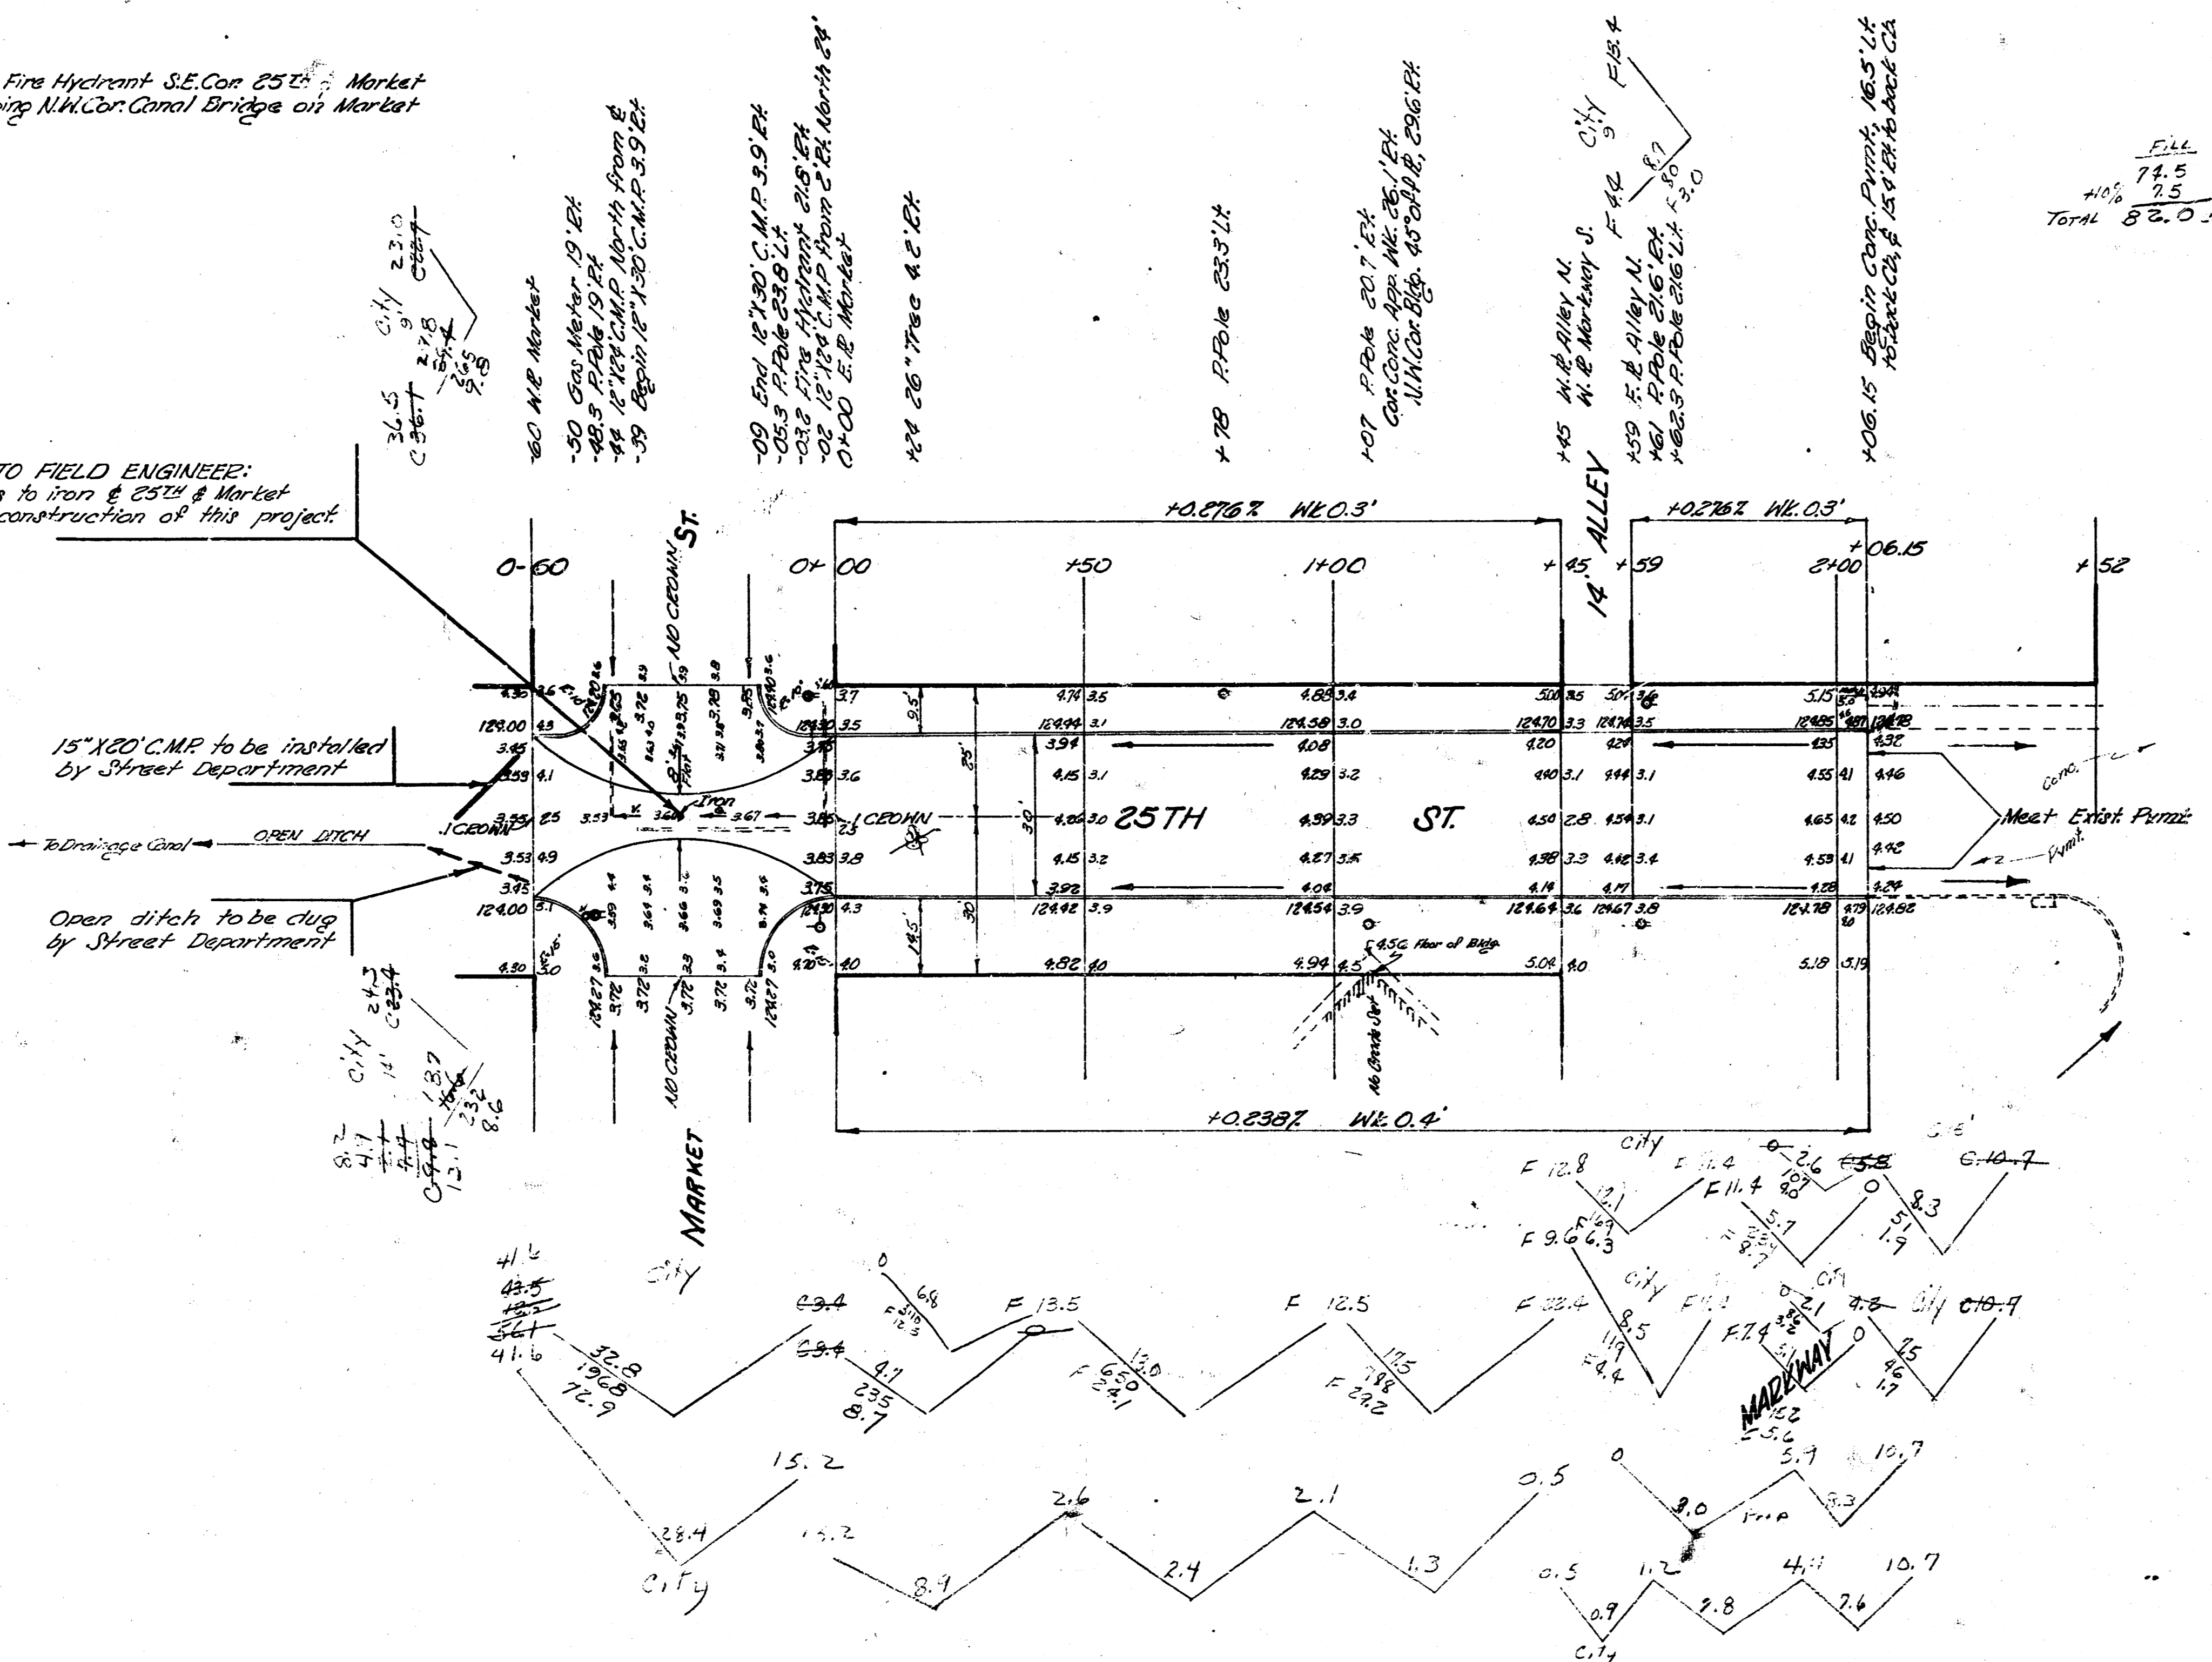

BROADWAY

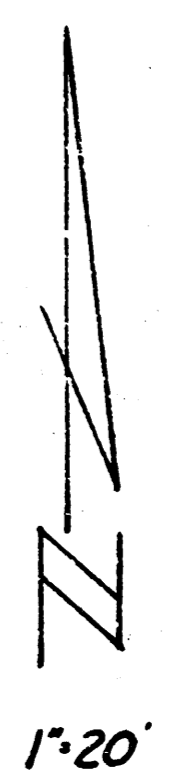

1"=20'

25th St.
 W.L. Market to W.L. Broadway
 30" CONC. CB.
 8" CONC.
 CITY OF WICHITA, KANSAS
 B.E. SMITH CITY ENGINEER
 JAN. 17, 1953 Proj. No. C12-190

