

EVERGREEN FOUR CORNER LOT GRADING

N.W. Corner, S. 1/4
Sec. 6, T2S, R1W
of the 6th P.M.
Found 3/4" Iron Pipe

N.W. Corner, S. 1/2, NE. 1/4
Sec. 6, T2S, R1W
of the 6th P.M.
Found #4 Rebar



SCALE: 1"=100'
• = IRON SET
B.M.: CITY OF WICHITA STD. BENCH MARK DISC 64" EAST AND 99" SOUTH
OF THE INTERSECTION OF THE CENTERLINES MAIZE ROAD AND
21ST STREET NORTH.
ELEV.=164.3 CITY DATUM
ELEV.=1351.7 M.S.L.
ESTABLISHED MINIMUM PAD (LOWEST OPENING) AS FOLLOWS:
LOTS 1 THROUGH 26, BLOCK 7, = 165.6 CITY DATUM = 1353.0 M.S.L.



* Match Existing Elevation
HP High Point

N.W. Corner
Newmarket Square Add.
Found 3/4" I.P.

Revised 7-22-98 KER

[illegible]

SHEET 2 OF 2

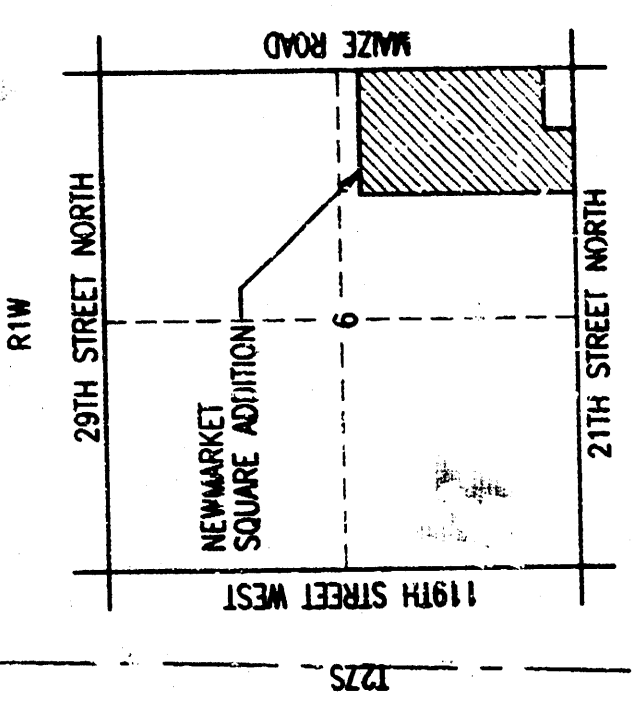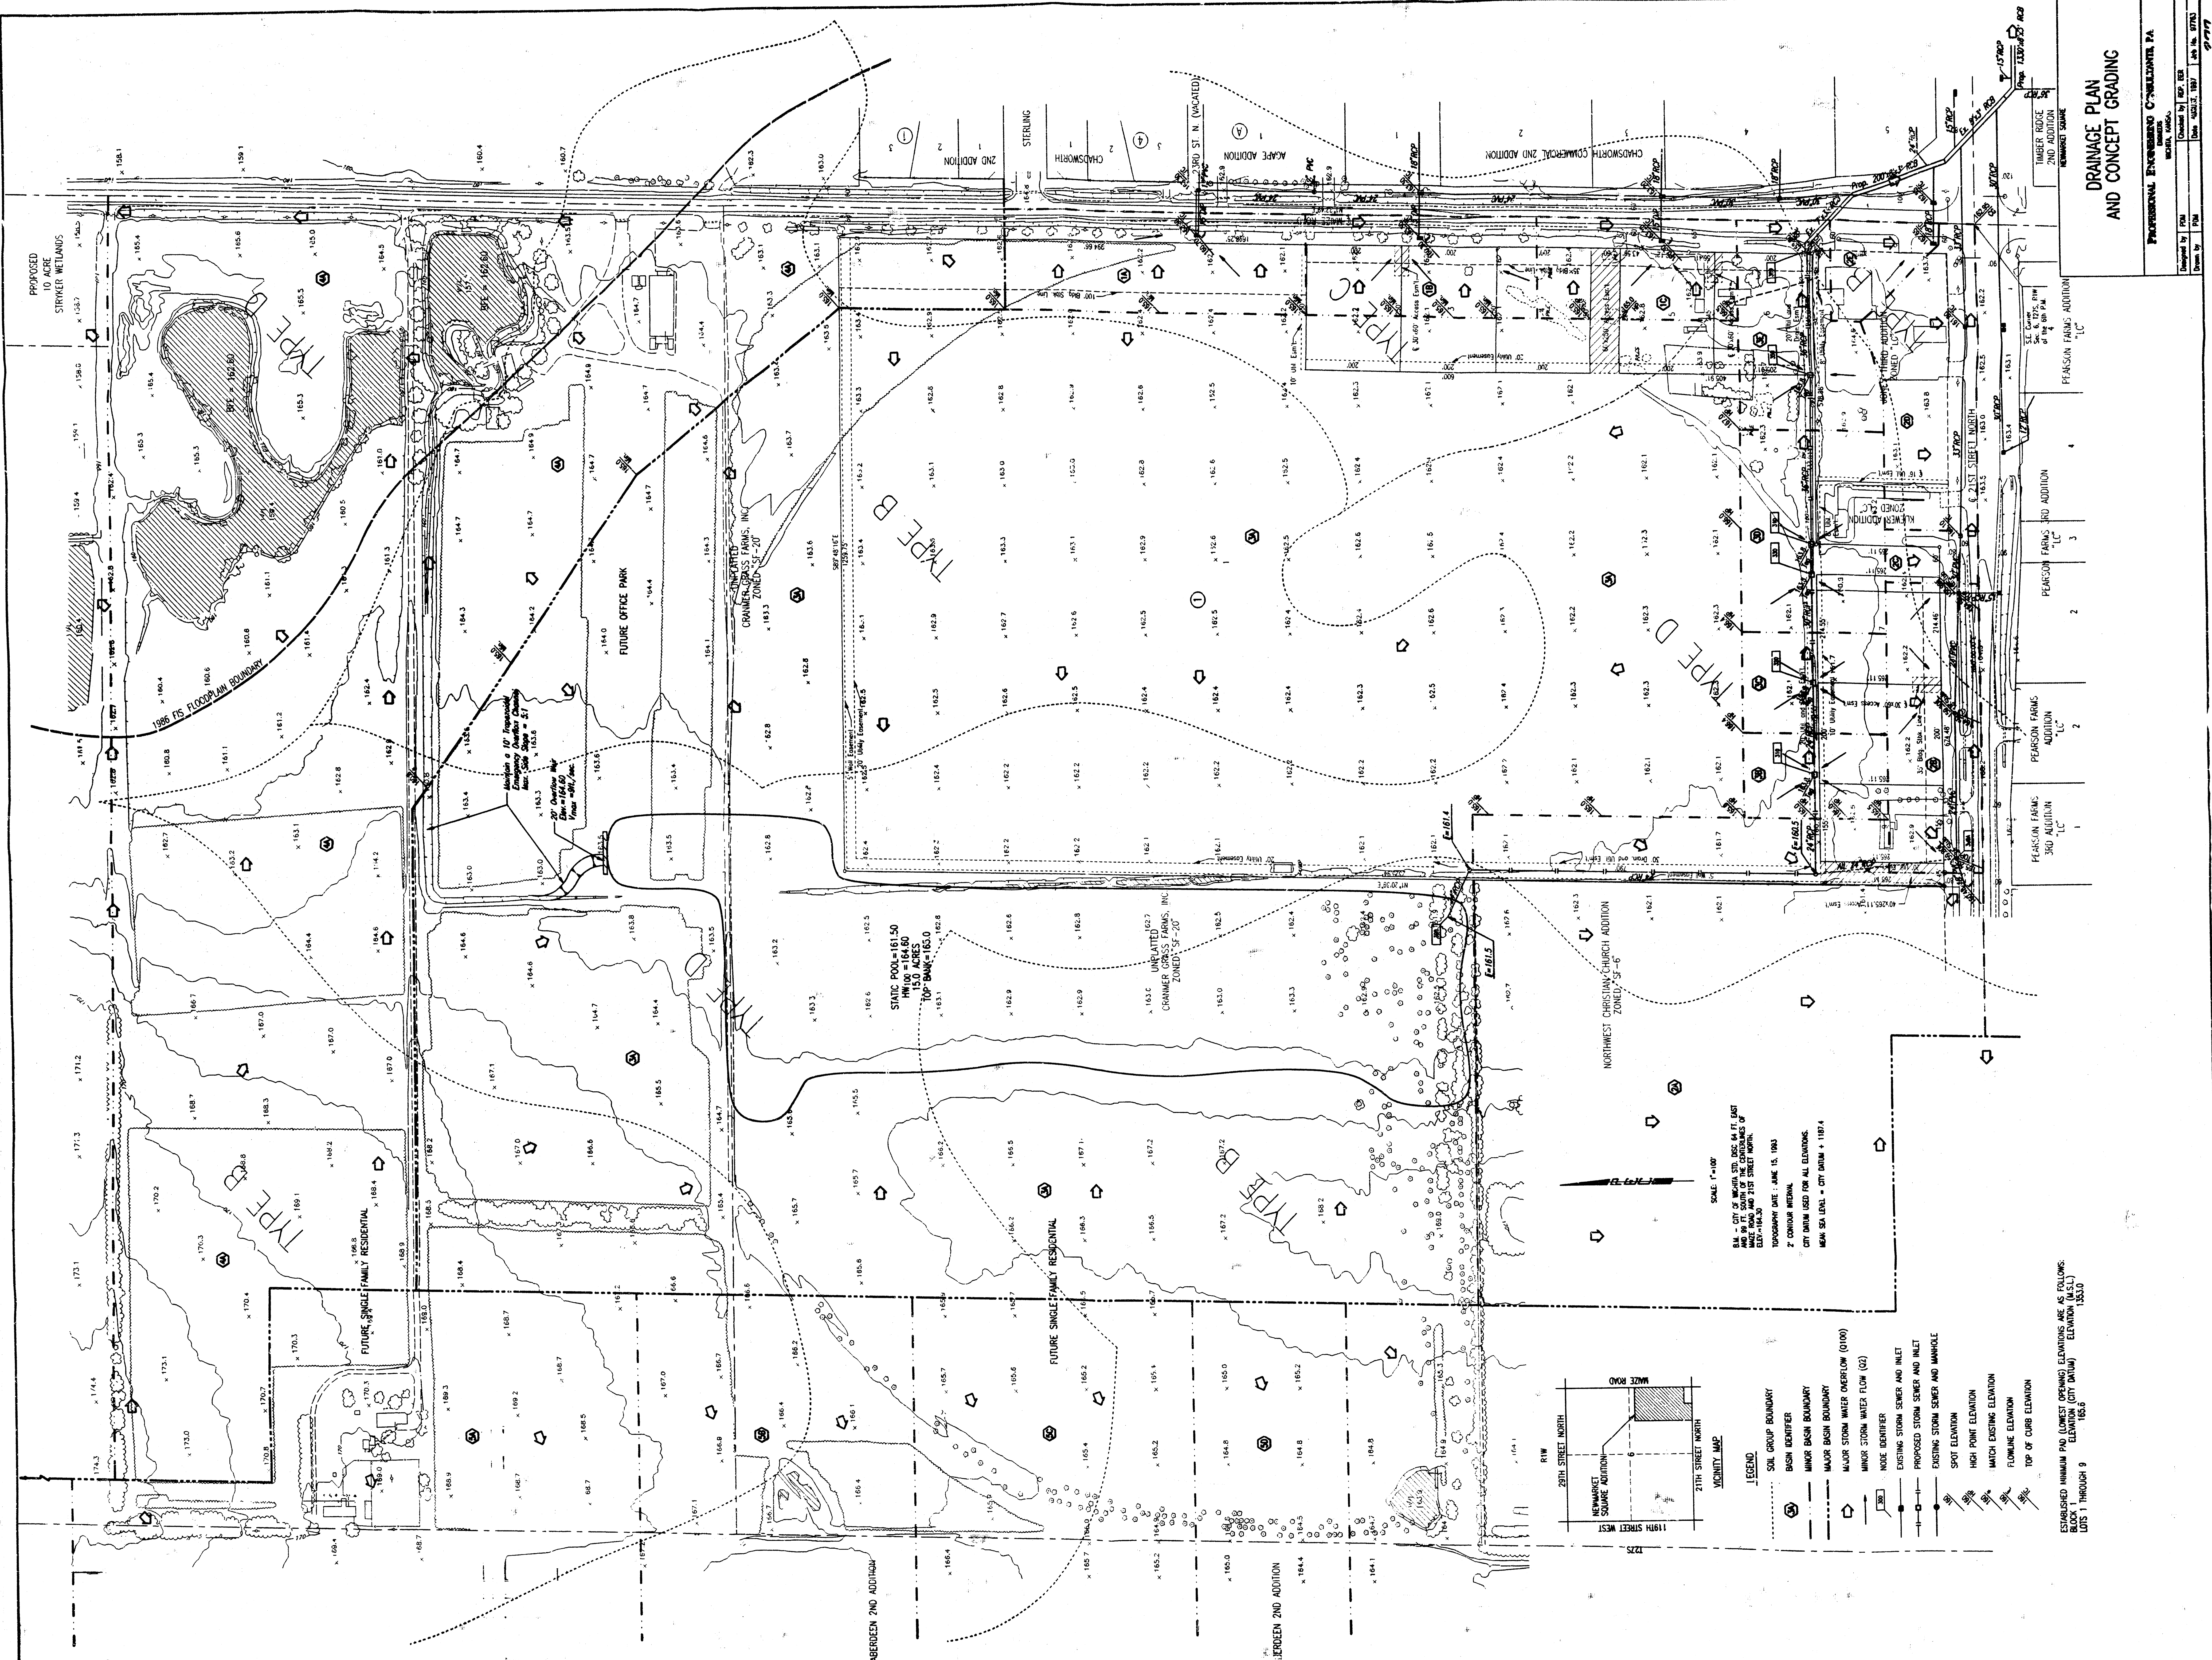

SCALE 1"=100'
B.M. - CITY OF MICHIGAN STD. DIS. 64 FT. EAST AND 94 FT. SOUTH OF THE CORNERS OF LOT 10 AND LOT 11, BLOCK 10, 1ST STREET NORTH.
TOPOGRAPHY DATE - JUNE 15, 1993
2" CONTOUR INTERVAL
CITY DATA USED FOR ALL ELEVATIONS
MEAN SEA LEVEL - CITY DATUM + 1187.4

- LEGEND**
- SOIL GROUP BOUNDARY
 - BASIN IDENTIFIER
 - MINOR BASIN BOUNDARY
 - MAJOR BASIN BOUNDARY
 - MAJOR STORM WATER OVERFLOW (0100)
 - MINOR STORM WATER FLOW (02)
 - NODE IDENTIFIER
 - EXISTING STORM SEWER AND INLET
 - PROPOSED STORM SEWER AND INLET
 - EXISTING STORM SEWER AND MANHOLE
 - SPOT ELEVATION
 - HIGH POINT ELEVATION
 - WATCH EXISTING ELEVATION
 - FLOWLINE ELEVATION
 - TOP OF CURB ELEVATION

RECALCULATED MINIMUM PFD (LOWEST OPENING) ELEVATIONS ARE AS FOLLOWS:
BLOCK 10, 1ST STREET NORTH ELEVATION (CITY DATA) 1353.0
LOTS 1 THROUGH 9 165.6

Drainage Plan and Concept Grading

Professional Engineer's Seal			
Designed by	PAUL	Checked by	PAUL
Drawn by	PAUL	Date	06/15/93
Professional Engineer's Seal			