


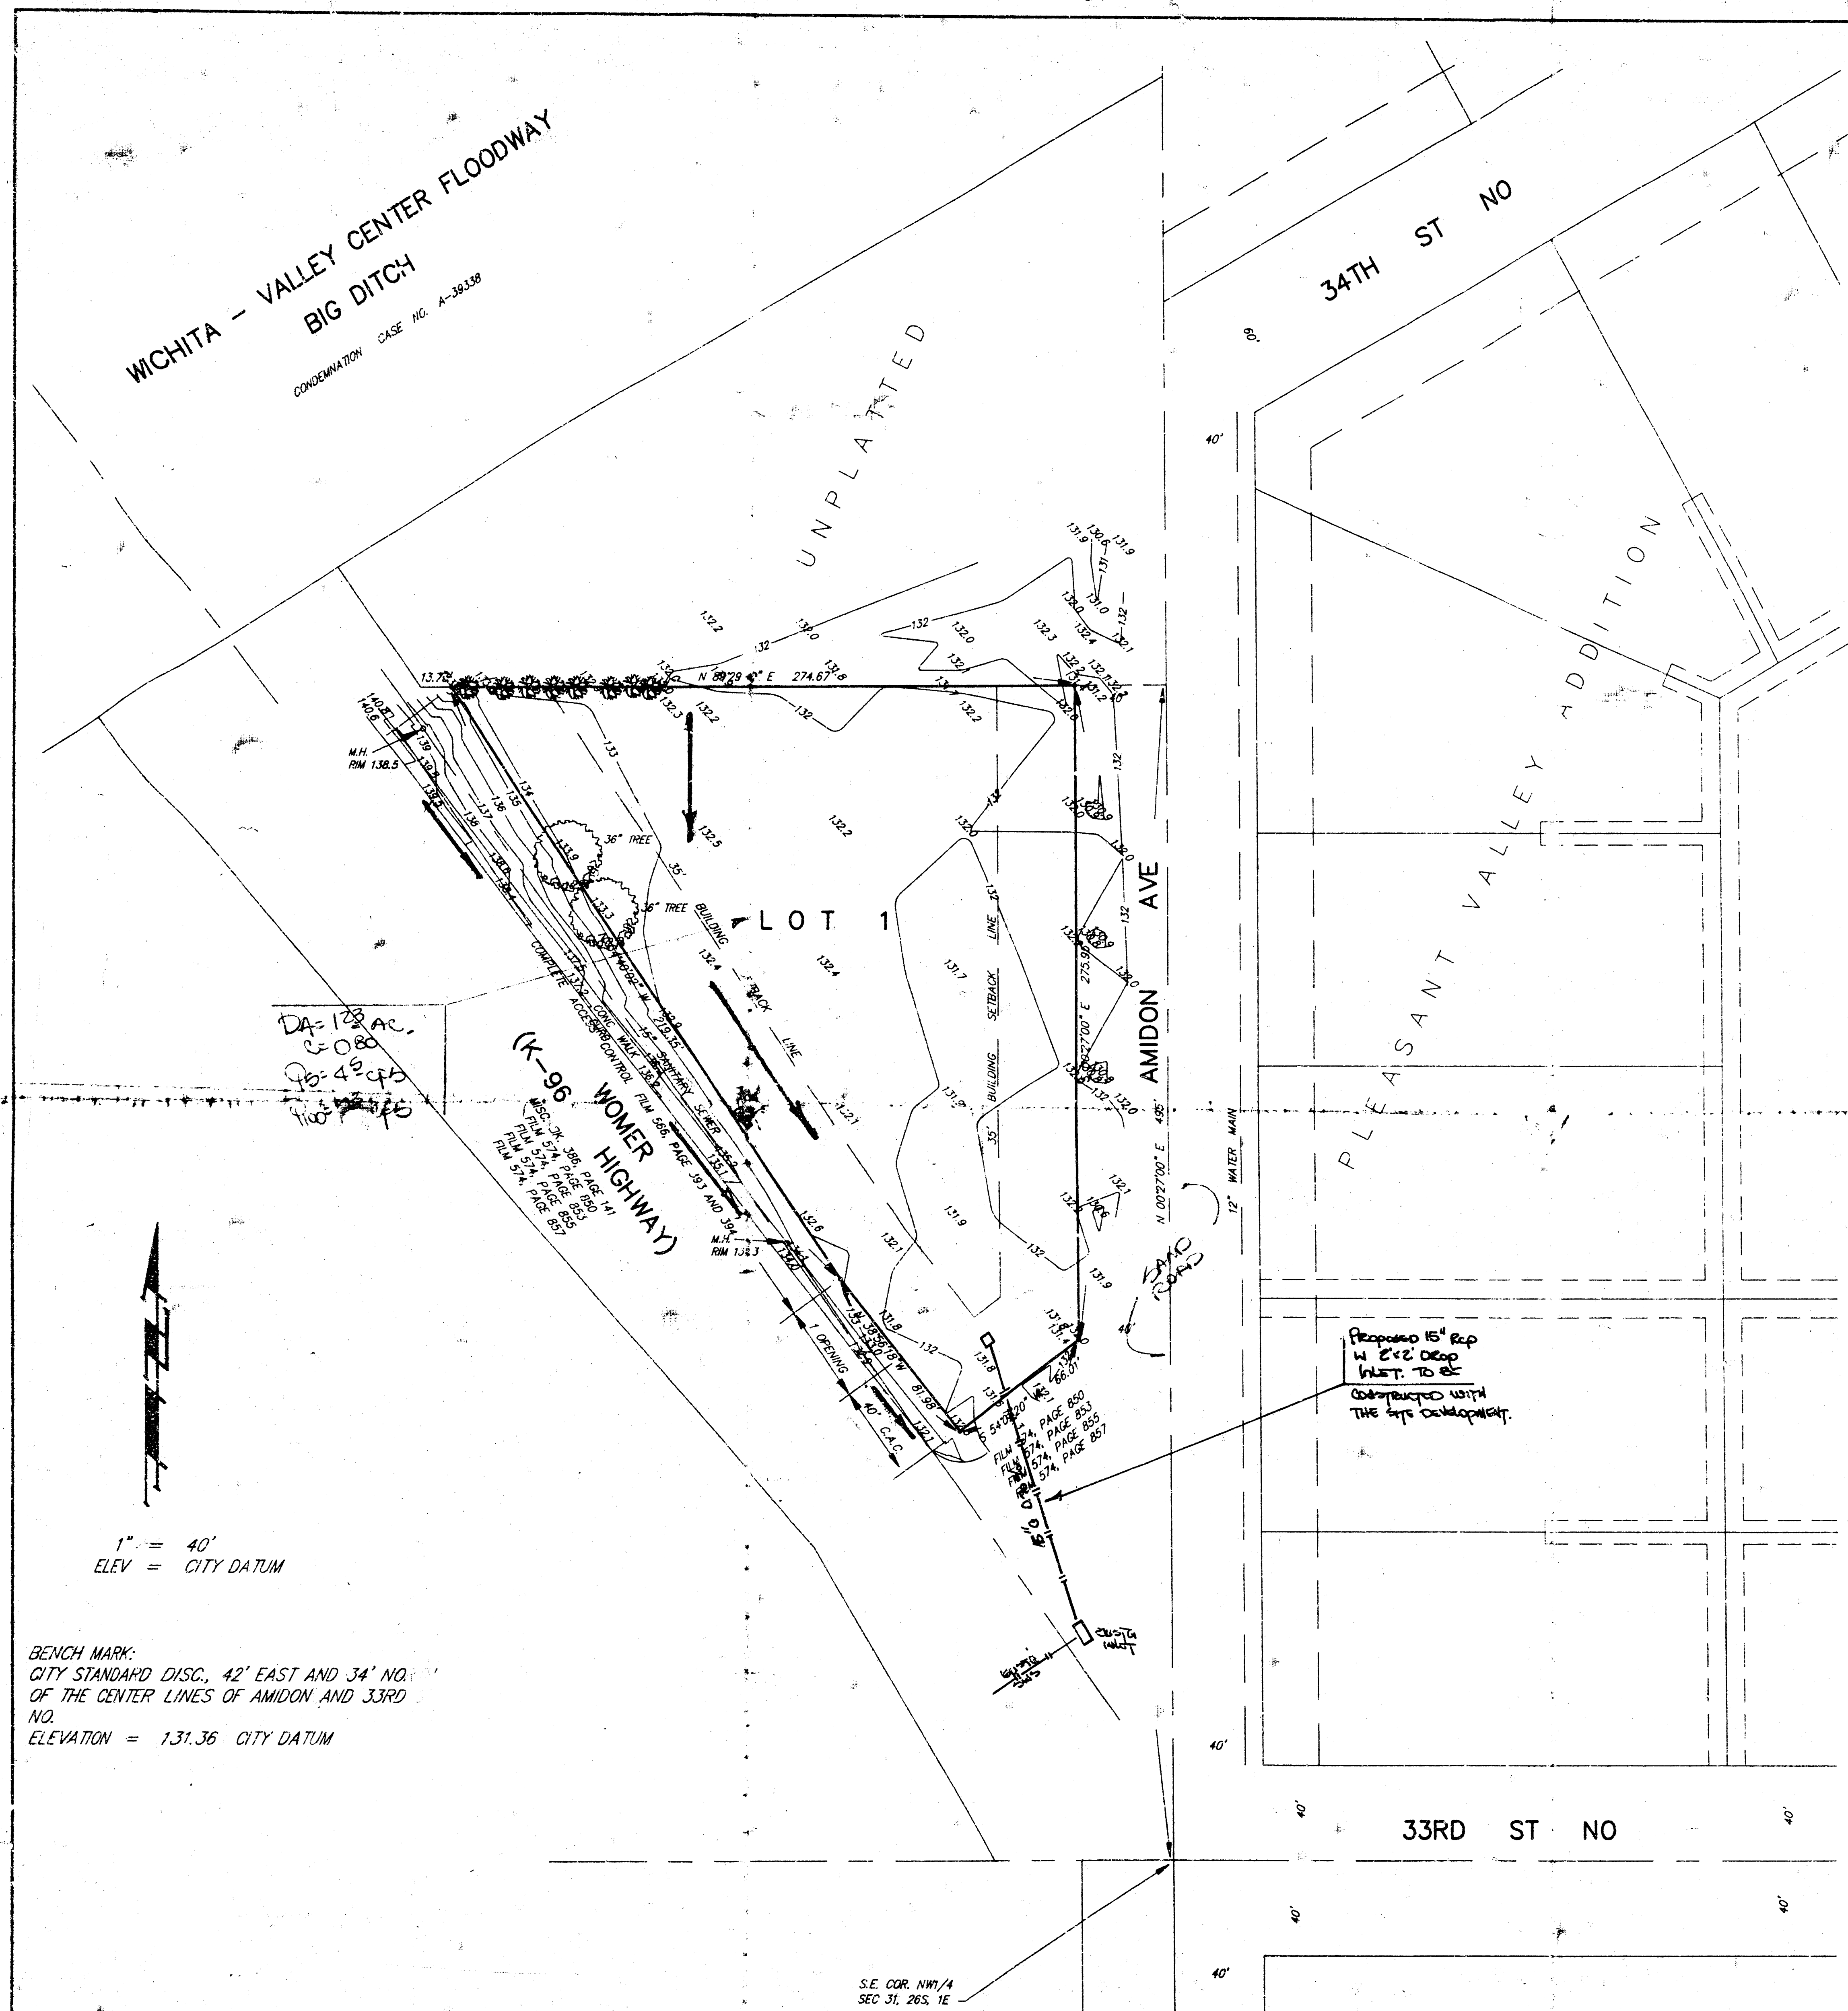

SKETCH PLAT
**NORTH AMIDON
 MEDICAL CENTER
 ADDITION**
 WICHITA, SEDGWICK COUNTY, KANSAS

LEGAL DESCRIPTION:
 The north 363 feet of the south 495 feet of the east 630 feet of the SE 1/4 of the NW 1/4 of Sec. 31, Twp. 26-S, R-1-E of the 6th P.M., Sedgwick County, Kansas, except that portion lying south and west of the easterly right-of-way line of K-96 Highway (Misc. Bk. 386, Page 141) and except the east 40 feet for road right-of-way and except those portions added for K-96 Highway right-of-way on Film 574, Page 850, Film 574, Page 853, Film 574, Page 855, and Film 574, Page 857.

Containing 51,440 Sq. Ft.
 1.2 Acres

LEOTA ZICKFOOD & AZIER
 3400 N. CHARLES
 WICHITA, KS 67214

DAVID M. WALL AND MAUREEN P. ROOS
 % JOHN F. REAGAN
 250 N. WATER, S. 17, 215
 WICHITA, KS 67214-180

DRAINAGE PLAN