

STA. 10+00.0, LINE 1=  
BL#2 STA. 46+52.88, 26.37' RT.  
REMOVE EXIST. CURB INLET AND  
CONSTRUCT STD. C.O.W. DRIVEWAY  
GRADED INLET (SINGLE)  
TOP=154.75

PROTECT EXIST.  
POWER POLE

HARRY STREET

CONTRACTOR SHALL COORDINATE W/CITY OF WICHITA  
FOR REMOVAL & REPLACEMENT OF SIDEWALK  
WITHIN RIGHT-OF-WAY. SIDEWALK SHALL BE  
REMOVED AND REPLACED TO THE NEAREST  
EXISTING JOINT BY A UTILITY CUT CONTRACTOR  
APPROVED BY C.O.W. TO COMPLETE THIS WORK.  
CONTACT LINDA FIRSCHING AT 268-4501 FOR A  
UTILITY CUT PERMIT.

STA. 11+00.3, LINE 1=  
BL #2 STA. 47+32.28, 86.33' RT.  
CONST. TYPE 1A INLET (5'x3')  
W/SEDIMENT BARRIER &  
PAVEMENT UNDERDRAIN  
TOP=156.61

CAUTION!  
OVERHEAD ELECTRIC


CAUTION!  
UNDERGROUND GAS  
PIPE LINE.

42' wide  
Ingress/Egress Esmt.

NOTE:  
CONTRACTOR TO VERIFY LOCATION & DEPTH OF EXISTING  
UTILITIES PRIOR TO CONSTRUCTION.

PLAN LINE 1

SCALE: 1"=20'

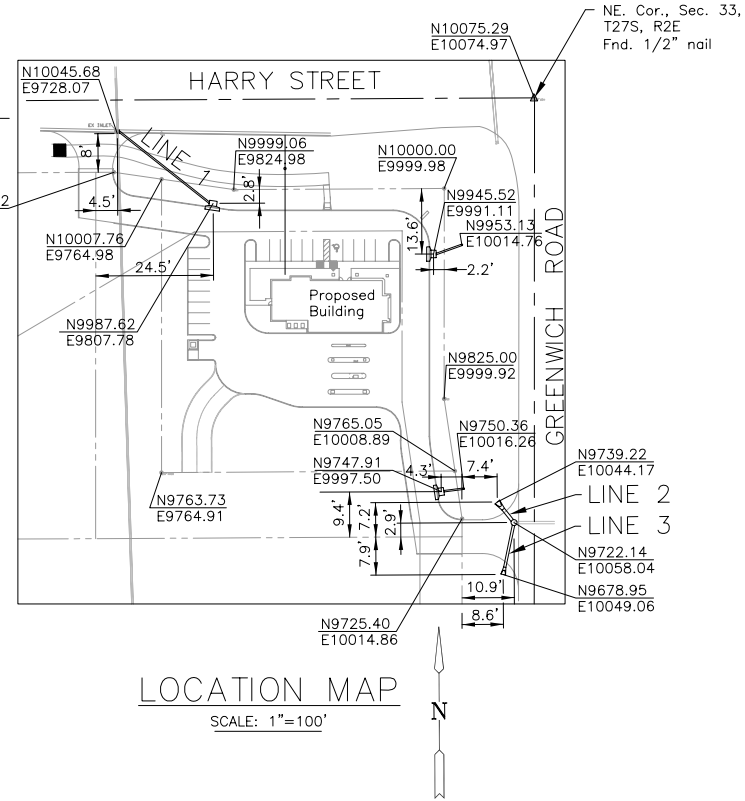

GENERAL NOTES

- UNLESS SHOWN OR OTHERWISE STATED ON THESE DRAWINGS, MATERIALS AND CONSTRUCTION SHALL BE IN ACCORDANCE WITH THE CITY OF WICHITA STANDARD SPECIFICATIONS.
- THE TOPS OF INLETS AND MANHOLES AS NOTED ON THE PLANS MAY VARY SO AS TO MEET PROPOSED TOP OF CURB ELEVATIONS OR PAVEMENT ELEVATIONS. THE FIELD ENGINEER SHALL LOCATE INLETS AND MANHOLES WITH REFERENCE TO PROPOSED PAVING PLANS OF THE PERTINENT STREETS.
- ALL CONCRETE SHALL BE STANDARD PAVING MIX UNLESS OTHERWISE NOTED.
- THE CONTRACTOR SHALL BE RESPONSIBLE FOR PRESERVING PROPERTY IRONS. THE CONTRACTOR SHALL BE REQUIRED TO RE-ESTABLISH ANY PROPERTY IRONS WHICH ARE DAMAGED OR DESTROYED BY HIS CONSTRUCTION OPERATIONS. SUCH IRONS SHALL BE RE-ESTABLISHED BY A LICENSED LAND SURVEYOR IN ACCORDANCE WITH STATE LAWS.
- TREES TO BE REMOVED ARE MARKED . ALL TREES WHICH IN THE OPINION OF THE FIELD ENGINEER CAN BE SAVED, SHALL BE SAVED.
- CONTRACTOR SHALL NOTIFY UTILITY COMPANIES OF CONSTRUCTION SCHEDULING.
- EXISTING UTILITIES AND THEIR LOCATIONS, AS SHOWN ON THE PLANS REPRESENT THE BEST INFORMATION OBTAINABLE FOR DESIGN. LOCATION INFORMATION HAS BEEN OBTAINED FROM THE VARIOUS UTILITIES COMPANIES AND IS EITHER FROM COMPANY UTILITY DRAWINGS OR COMPANY PROVIDED FIELD LOCATIONS. THE PLAN LOCATIONS SHOWN ARE NOT GUARANTEED. ADDITIONAL EXISTING UTILITIES MAY ALSO BE ENCOUNTERED.
- CONTRACTOR WILL BE REQUIRED TO PROVIDE A MINIMUM ADVANCE NOTICE OF SEVENTY-TWO (72) HOURS TO UTILITY COMPANIES PRIOR TO STARTING ANY EXCAVATION AS FOLLOWS:

KANSAS ONE-CALL 800-344-7233  
OR 687-2470 (LOCAL)

THE CONTRACTOR MUST NOTIFY THE FOLLOWING IN CASE OF EMERGENCY:

COX COMMUNICATIONS (CABLE)	262-0661
WESTAR (ELECTRIC)	261-6512
KANSAS GAS SERVICE (GAS)	832-3101
SBC (TELEPHONE)	800-870-8390
CITY OF WICHITA WATER & SEWER	262-6000
AQUILA (GAS)	946-0096

- RUBBLE FROM THE REMOVAL OF MISCELLANEOUS STRUCTURES AND EXCESS EXCAVATION WHICH IS TO BE WASTED SHALL BE DISPOSED OF ON SITES TO BE PROVIDED BY THE CONTRACTOR. THESE SITES SHALL BE APPROVED BY THE ENGINEER AS TO SUITABILITY, APPEARANCE AND SITE LOCATION. LOCATIONS THAT, IN THE OPINION OF THE ENGINEER, WILL LEAVE AN UNSIGHTLY APPEARANCE WILL NOT BE APPROVED. ALL DISPOSAL SITES MUST BE APPROVED BY THE KANSAS DEPARTMENT OF HEALTH AND ENVIRONMENT. MATERIAL EITHER STOCKPILED OR DISPOSED OF IN A FLOOD PLAIN WOULD REQUIRE A KANSAS STATE BOARD OF AGRICULTURE PERMIT. ANY MATERIAL DUMPED IN WATERS OF THE UNITED STATES OR WETLANDS IS SUBJECT TO U.S. CORPS OF ENGINEERS PERMITTING REGULATIONS. ANY MATERIAL BURIED OR STOCKPILED BEYOND APPROVED CONSTRUCTION LIMITS WOULD REQUIRE ADDITIONAL ARCHAEOLOGICAL INVESTIGATIONS UNLESS BURIED IN A PREVIOUSLY APPROVED BORROW LOCATION.
- CONTRACTOR SHALL RESEED AND MULCH ALL DISTURBED AREAS NOT REQUIRED TO BE SODDED. COST SHALL BE CONSIDERED SUBSIDIARY TO SITE RESTORATION.

**As Built Plans:**  
**CONTRACTOR: McCullough Excavation**  
**INSPECTOR: Tom Jones, K E Miller Engineering**  
**.PDF by: NWS, 11-09-07**

LEGAL DESCRIPTION:

A PORTION OF LOT 7, BLOCK A, SMITHMOOR COMMERCIAL  
ADDITION WICHITA, SEDGWICK COUNTY, KANSAS

CITY OF WICHITA  
PRIVATE PROJECT  
NO. 1753 PPS (607861)



APPROVED AS NOTED

BY CITY ENGINEER OF WICHITA

STORM SEWERS \_\_\_\_\_

NOTE TO CONTRACTOR

INSPECTION AND TESTING FOR THIS PROJECT IS TO BE PROVIDED BY A LICENSED CONSULTING ENGINEERING FIRM UNDER CONTRACT WITH THE OWNER/DEVELOPER. SAID INSPECTION TO BE IN ACCORDANCE WITH THE CITY OF WICHITA STANDARD CONSTRUCTION ENGINEERING PRACTICES AND CERTIFIED BY A LICENSED PROFESSIONAL ENGINEER. NO WORK SHALL BE PERFORMED IN DEDICATED EASEMENTS OR THE PUBLIC RIGHT-OF-WAY BY THE CONTRACTOR WITHOUT SUCH INSPECTION NOR SHALL ANY WORK BE COMMENCED IN DEDICATED EASEMENTS OR PUBLIC RIGHT-OF-WAY WITHOUT WRITTEN AUTHORIZATION BY THE CITY ENGINEER.

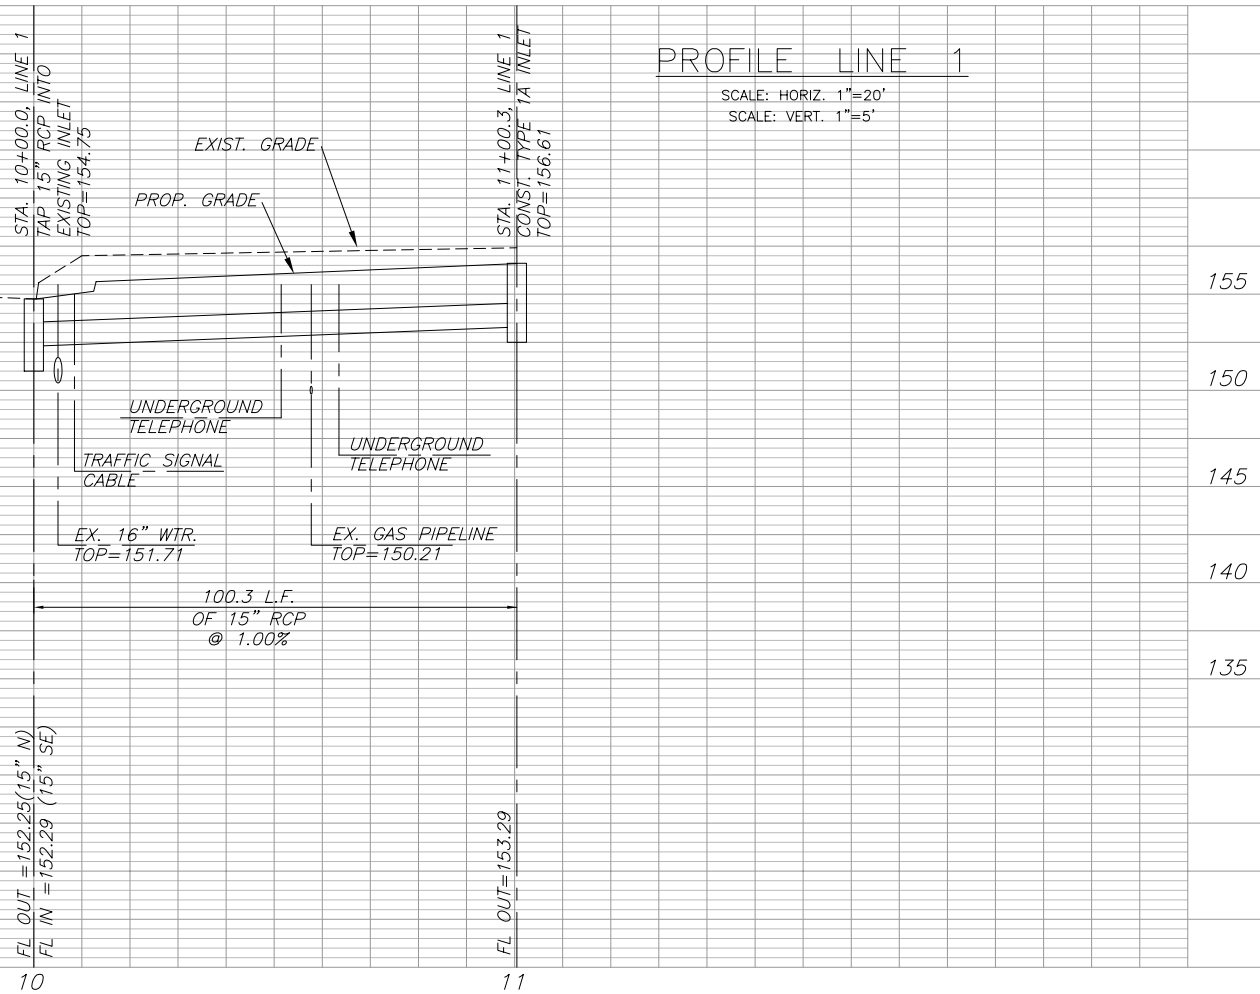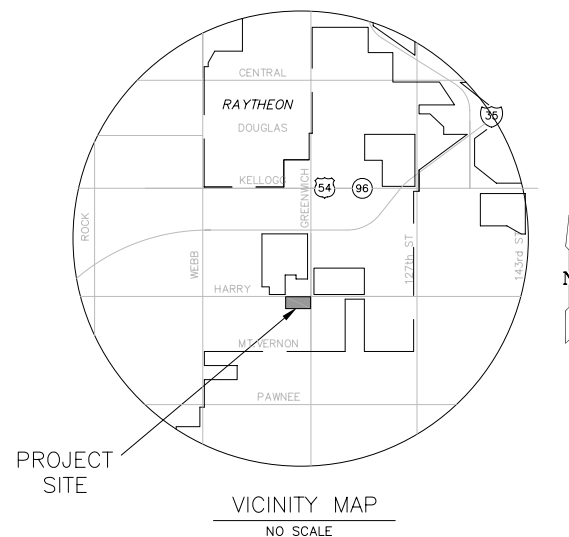

**MKEC**  
ENGINEERING  
CONSULTANTS

HARRY & GREENWICH  
PROJECT NAME  
STORM WATER SEWER  
LINE 1  
SHEET TITLE

SRS DESIGN BY DM DRAWN BY GJA CHECKED BY  
411 N. WEBB ROAD WICHITA, KANSAS 67207  
316-262-6000

5 / 13  
SHEET / OF