



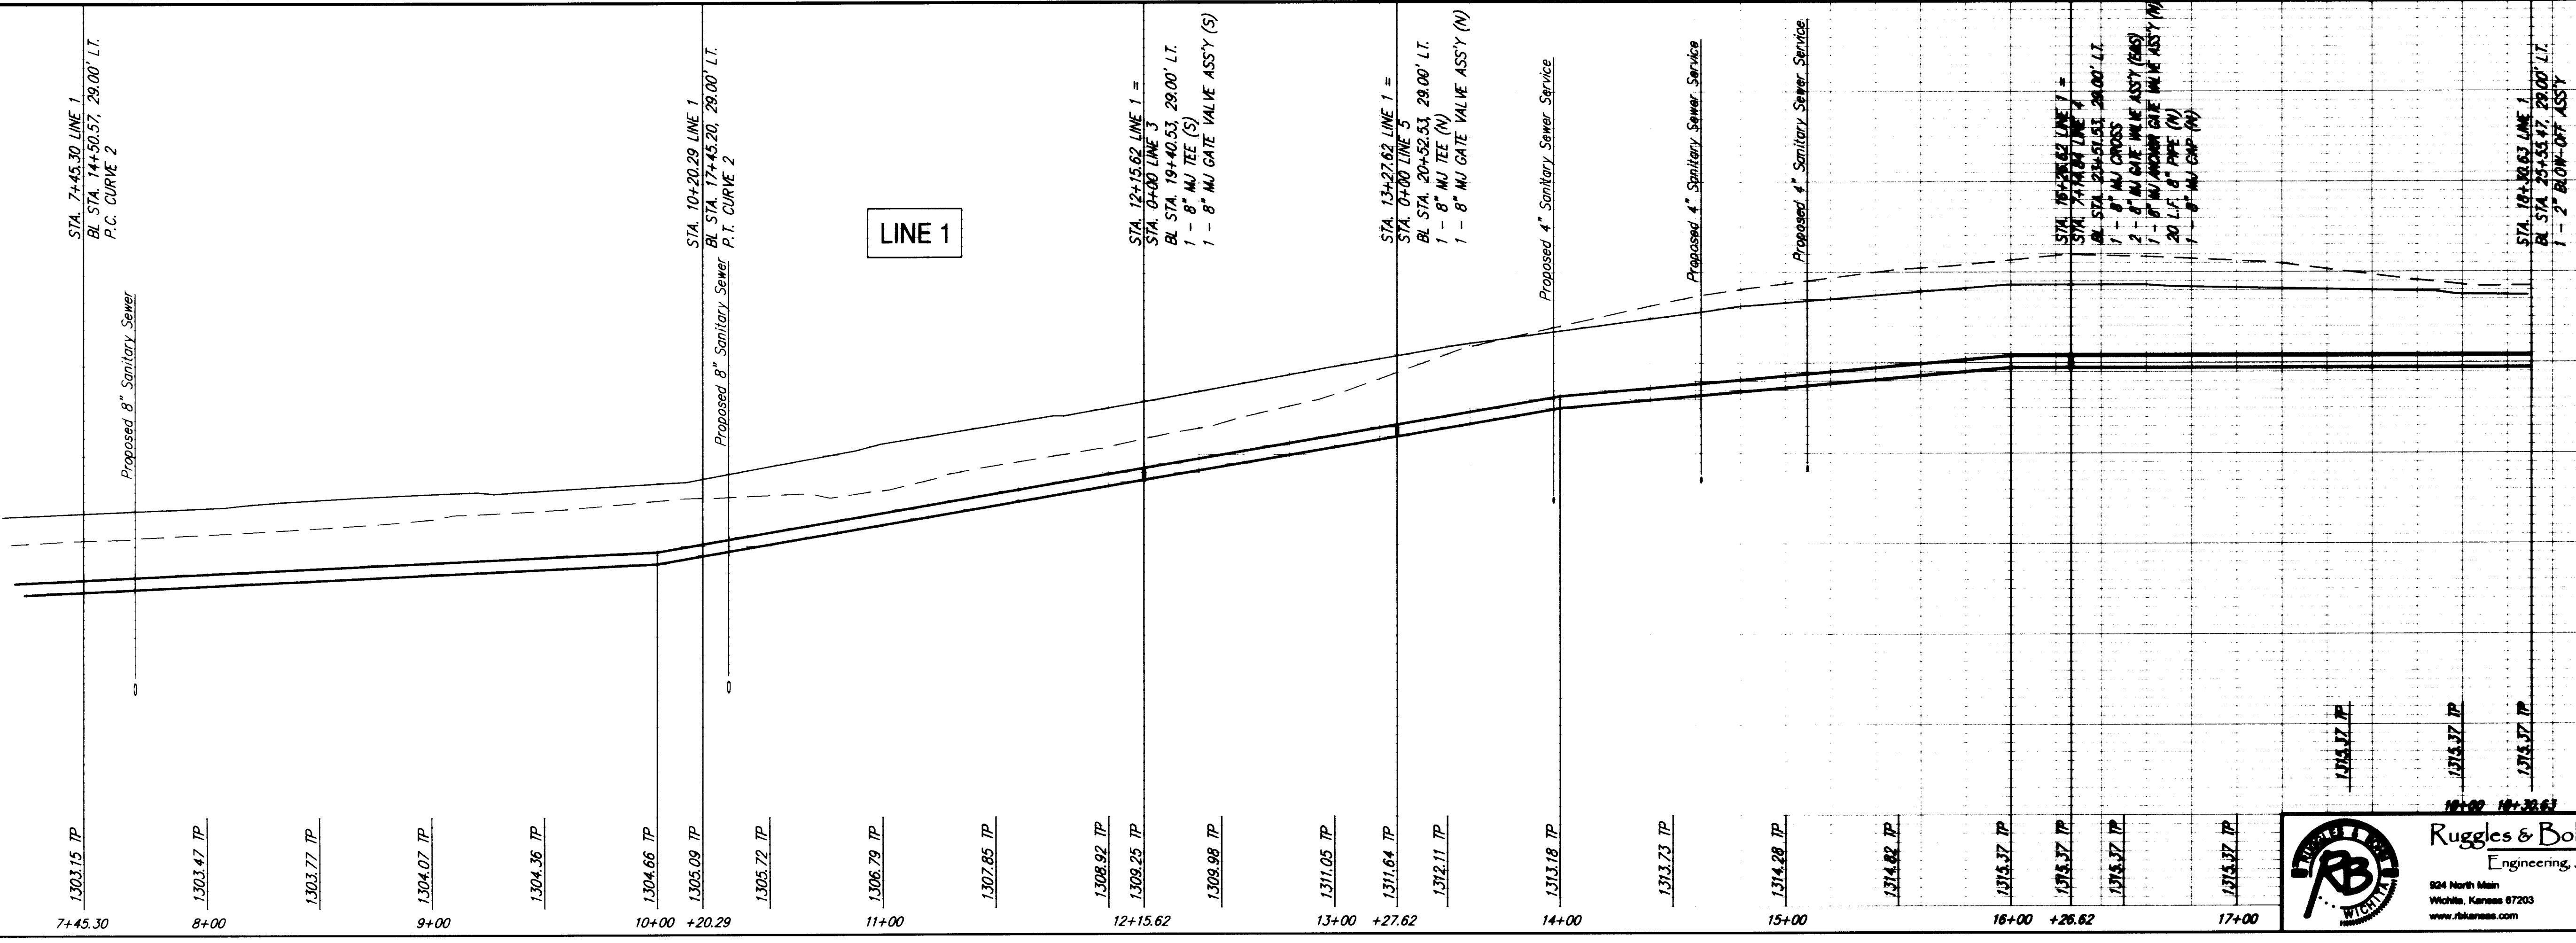

SCALE 1" = 40'
IRON = ●

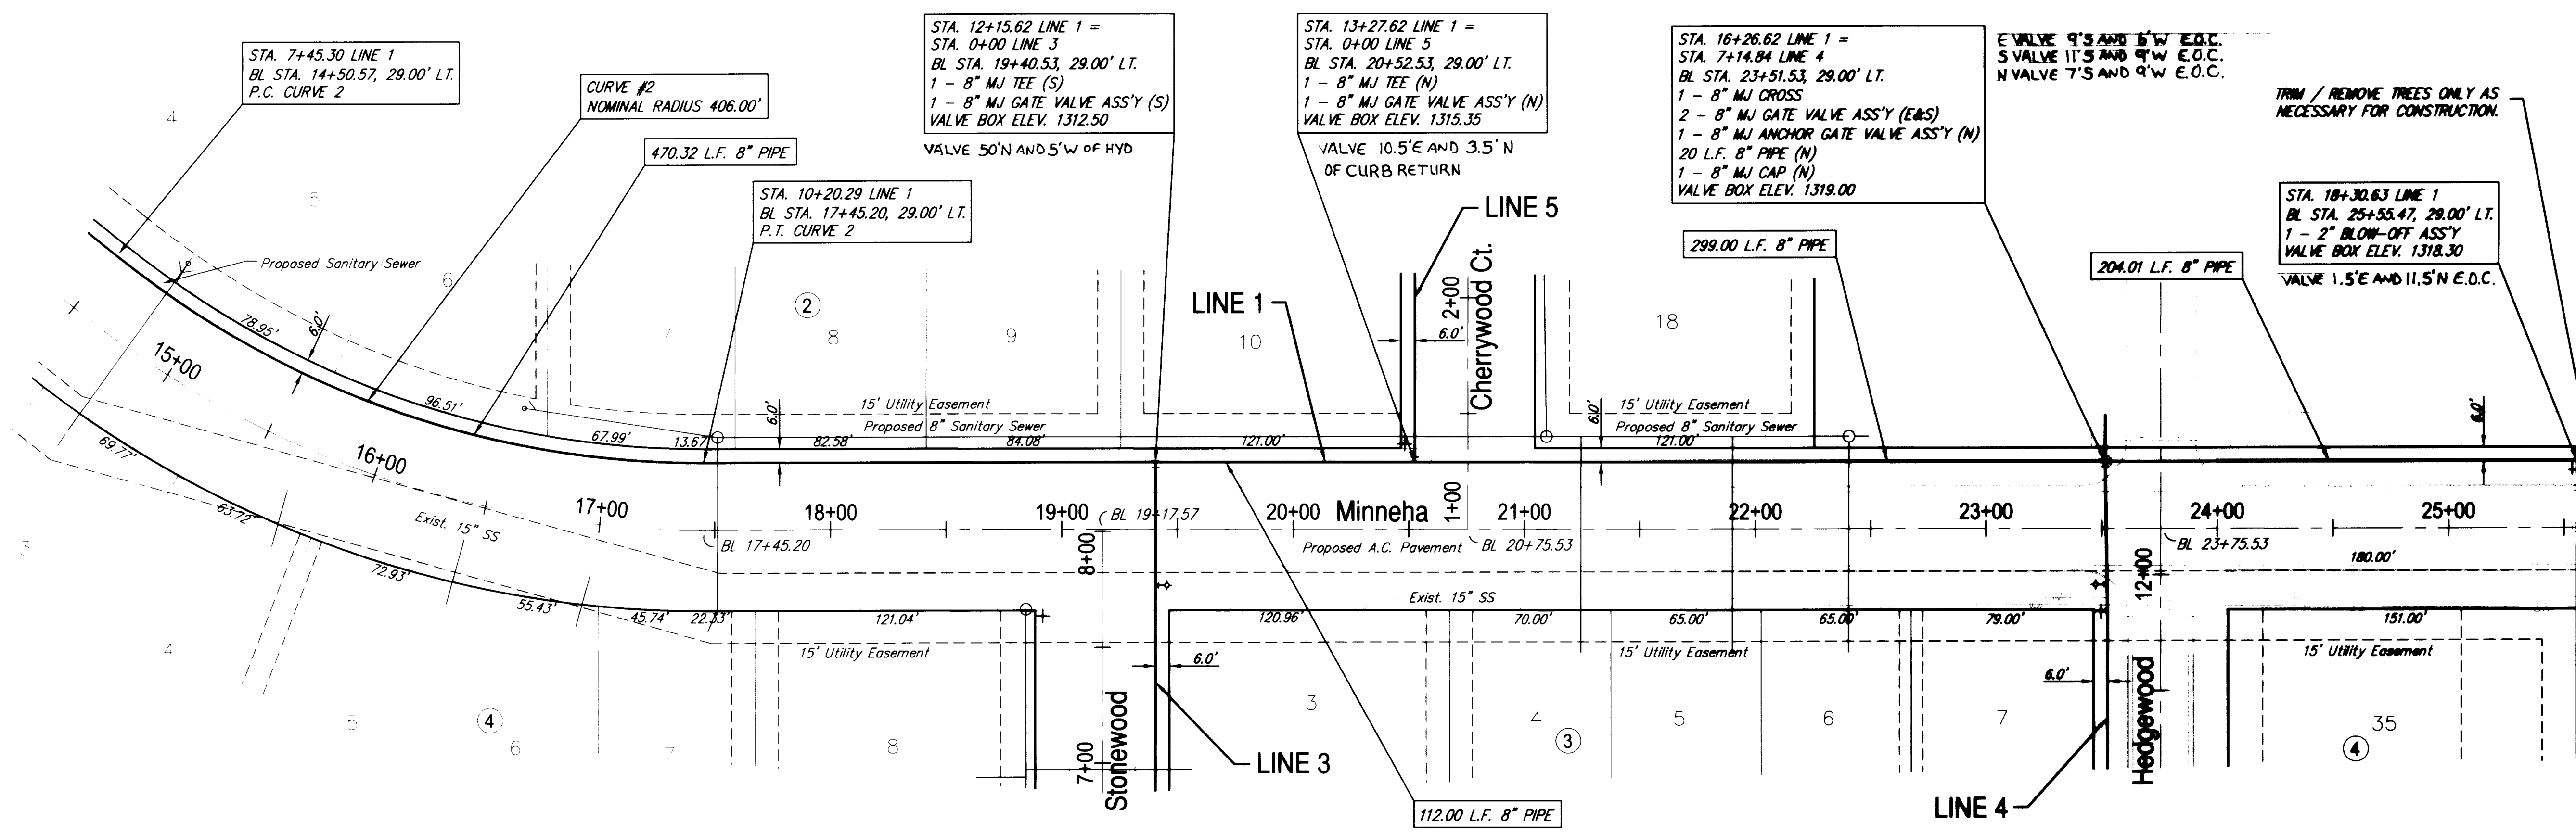

DESIGN	DRAWN	REVIEWED
K/W/L	R/A	R/A
UTILITY	DATE	REVIEW
	Dec. 31, 2004	

PROJECT NUMBER	DRAWING FILE
1320	water LINE 1 cont'd

ELEVATION	STATION	DESCRIPTION
1295	7+45.30	1 - 8" MJ GATE VALVE ASS'Y (S)
1300	10+00	1 - 8" MJ GATE VALVE ASS'Y (S)
1305	12+15.62	1 - 8" MJ GATE VALVE ASS'Y (S)
1310	14+00	1 - 8" MJ GATE VALVE ASS'Y (S)
1315	16+00	1 - 8" MJ GATE VALVE ASS'Y (S)
1320	18+00	1 - 8" MJ GATE VALVE ASS'Y (S)

DATE	BY	DESCRIPTION
11-13-08	JDM	AS BUILT

Ruggles & Bohm, P.A.
Engineering, Surveying, Land Planning
824 North Main
Wichita, Kansas 67203
www.rbkansas.com
(316) 264-8008
(316) 264-4621 fax
E-mail: info@rbkansas.com