




SCALE 1" = 40'
IRON = •

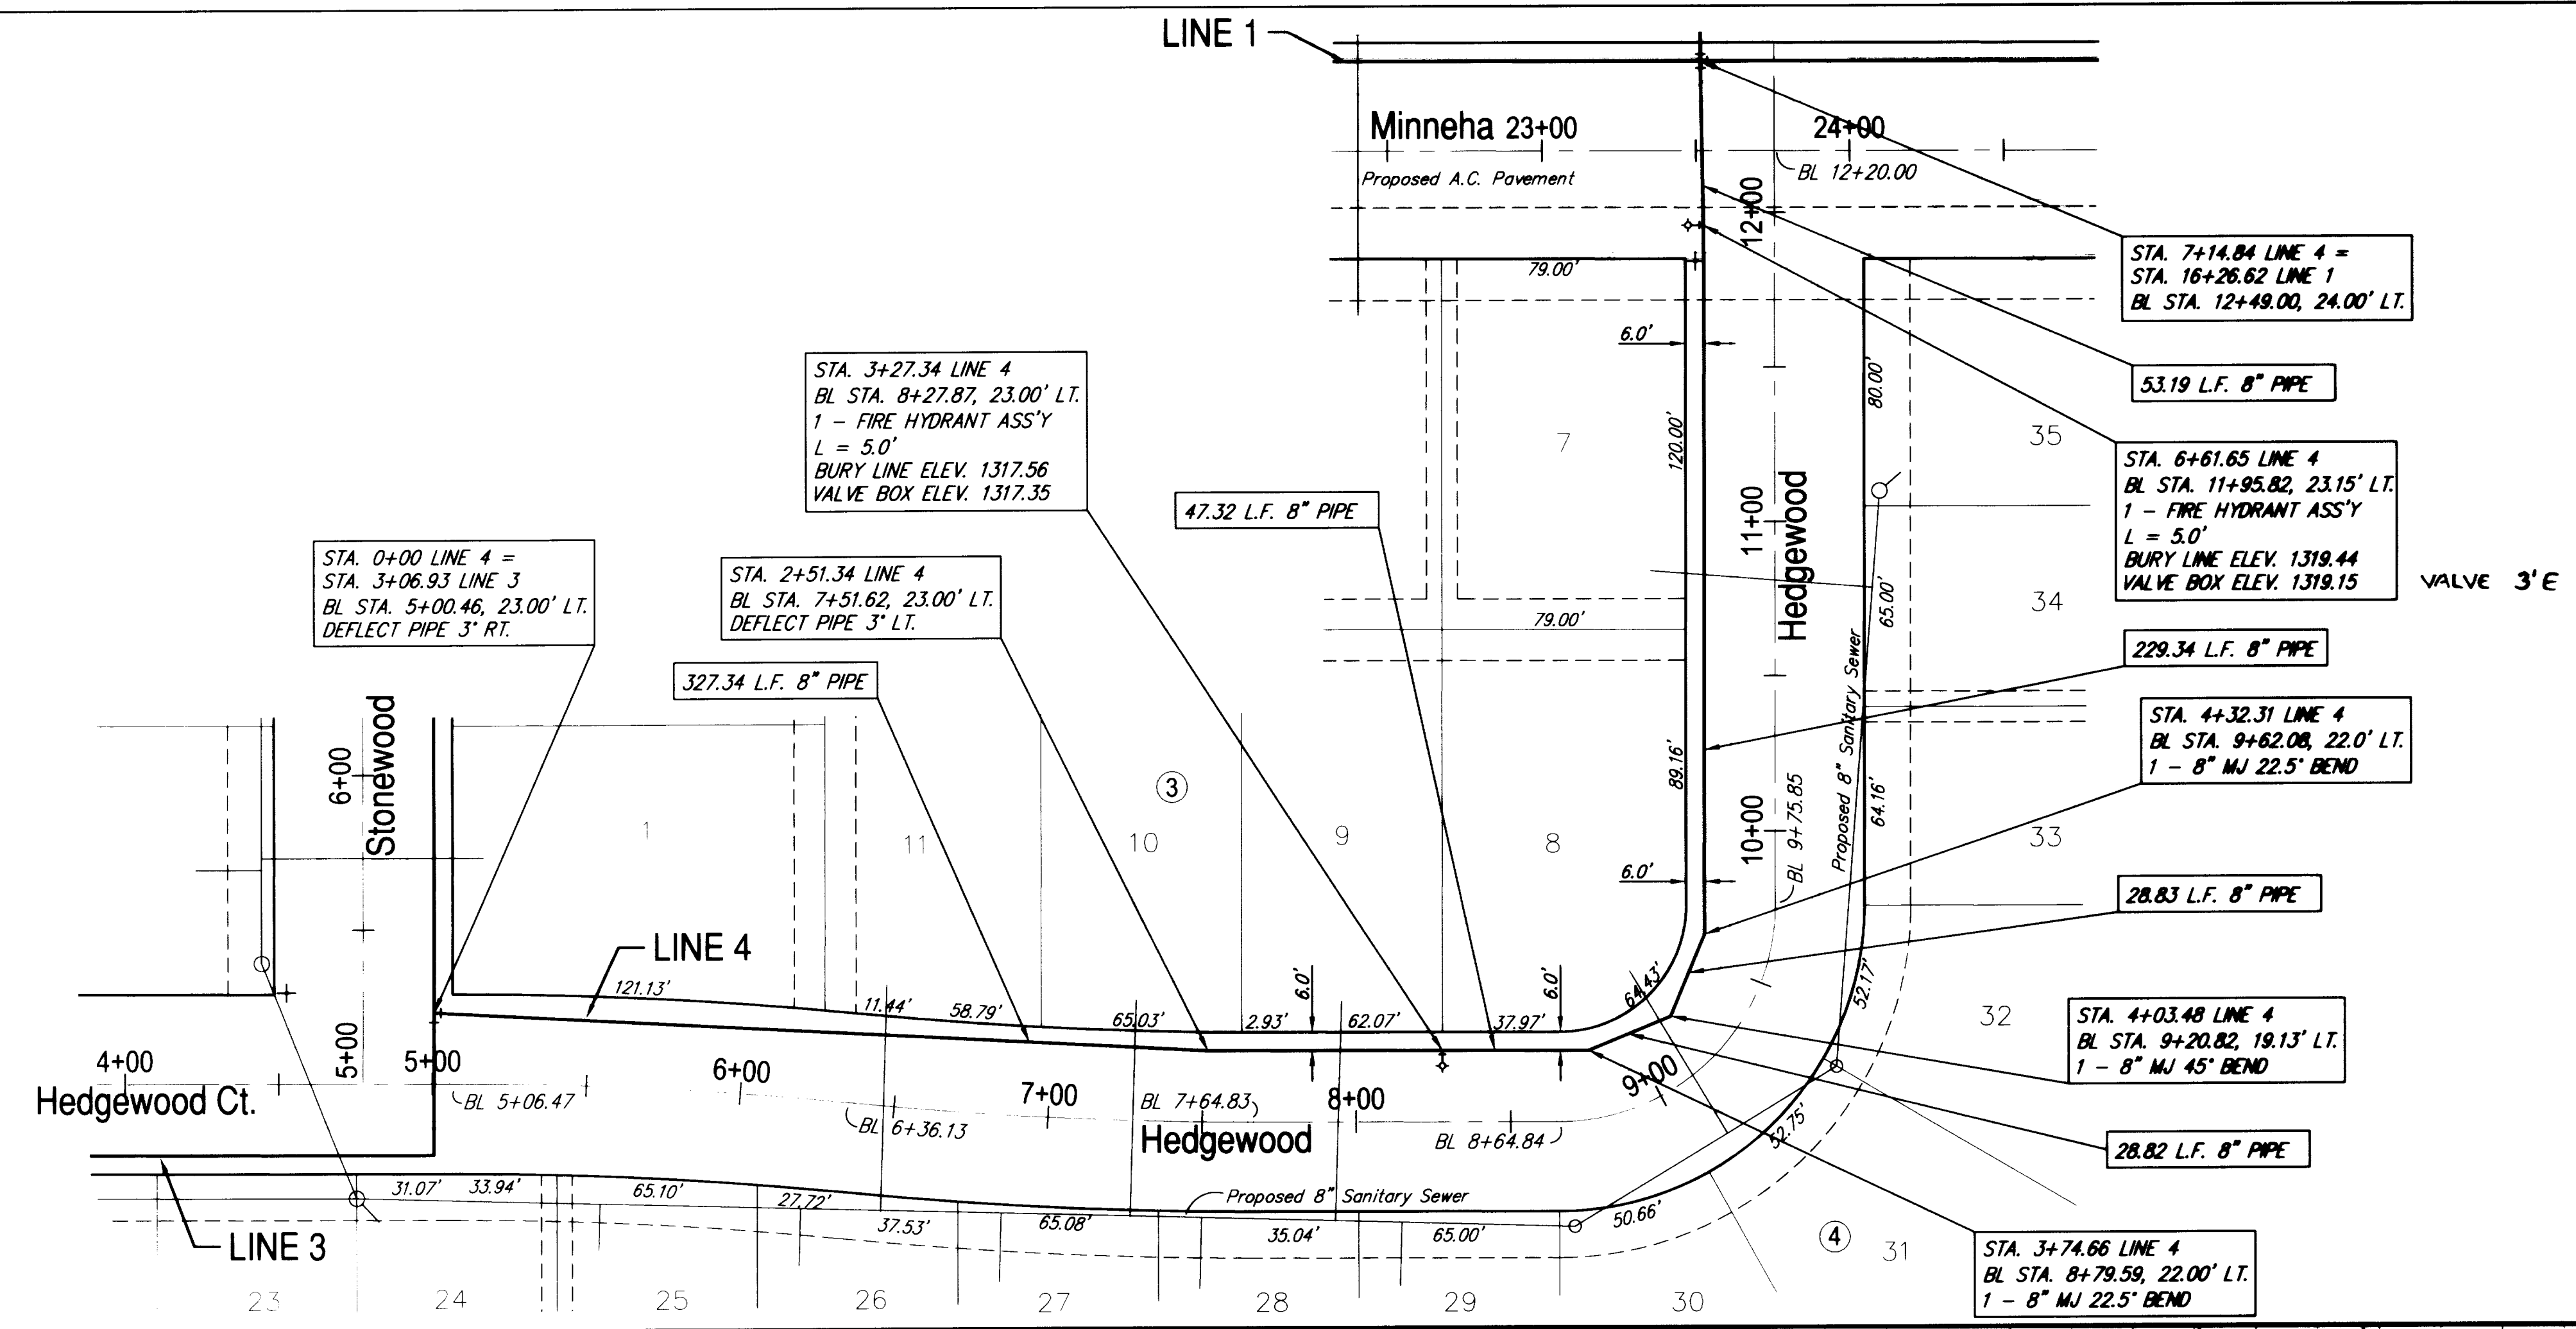

STATION	DESCRIPTION	PROJECT NUMBER	DESIGN	REVISION
4+00	STA. 0+00 LINE 4 = STA. 3+06.93 LINE 3 BL STA. 5+00.46, 23.00' LT. DEFLECT PIPE 3° RT.	1320	KWL UTILITY	DATE Dec. 3, 2004
1+00	Proposed 4" Sanitary Sewer Service			
2+00	Proposed 4" Sanitary Sewer Service			
2+51.34	STA. 2+51.34 LINE 4 BL STA. 7+51.62, 23.00' LT. DEFLECT PIPE 3° LT.			
3+00	Proposed 4" Sanitary Sewer Service			
3+27.34	STA. 3+27.34 LINE 4 BL STA. 8+27.87, 23.00' LT. 1 - FIRE HYDRANT ASS'Y			
+74.66	STA. 3+74.66 LINE 4 BL STA. 8+79.59, 22.00' LT. 1 - 8" MJ 22.5° BEND			
4+03.48	STA. 4+03.48 LINE 4 BL STA. 9+20.82, 19.13' LT. 1 - 8" MJ 45° BEND			
+32.41	STA. 4+32.31 LINE 4 BL STA. 9+62.08, 22.0' LT. 1 - 8" MJ 22.5° BEND			
5+00	Proposed 4" Sanitary Sewer Service			
+50	Proposed 4" Sanitary Sewer Service			
6+00	Proposed 4" Sanitary Sewer Service			
+50	STA. 4+61.65 LINE 4 BL STA. 7+51.62, 23.15' LT. 1 - FIRE HYDRANT ASS'Y			
7+00	STA. 7+14.84 LINE 4 BL STA. 12+49.00, 24.00' LT.			
7+14.84	Proposed 4" Sanitary Sewer Service			
1300	1309.82 TP	1315	DRAWN RA	REVIEW
1305	1310.42 TP			
1300	1311.02 TP			
1305	1311.62 TP			
1300	1312.22 TP			
1305	1312.83 TP			
1300	1313.41 TP			
1305	1313.74 TP			
1300	1314.01 TP			
1305	1314.31 TP			
1300	1314.66 TP			
1305	1315.00 TP			
1300	1315.29 TP			
1305	1316.10 TP			
1300	1316.92 TP			
1305	1315.62 TP	1310	PROJECT NUMBER	DRAWING FILE water [LINE 4]
1300	1315.62 TP			
1305	1315.62 TP			
1300	1315.62 TP			
1305	1315.62 TP			
1300	1315.62 TP			
1305	1315.62 TP	1300	PROJECT NUMBER	DRAWING FILE water [LINE 4]
1300	1315.62 TP			
1305	1315.62 TP			
1300	1315.62 TP			
1305	1315.62 TP			
1300	1315.62 TP			

Ruggles & Bohm, P.A.
Engineering, Surveying, Land Planning
924 North Main
Wichita, Kansas 67203
www.rbkansas.com
(316) 264-8008
(316) 264-4621 fax
E-mail: info@rbkansas.com

Reflection Lake at Cloud City 2nd Add.
WATER LINE 4
ANDOVER, KANSAS

AS BUILT
11-13-08
JDM

PROJECT NUMBER
DRAWING FILE
water [LINE 4]

DESIGN
KWL
UTILITY

DRAWN
RA

REVIEW

DATE
Dec. 3, 2004

NO. JOB
23006

SHEET
00 OF 01