


CONSTRUCTION PLANS FOR WATERLINE IMPROVEMENTS FOR HAYSVILLE EMERGENCY WATERLINE

THE CITY OF HAYSVILLE

PEC PROJECT NO. 34-95676-1263

PUBLIC OFFICIALS

MAYOR	TOM LINDSAY
CITY COUNCIL	SANDRA BRADSHAW
	DOROTHY BOOHER
	MICHAEL MORRISON, SR.
	BRUCE ARMSTRONG
	PHIL HARRIS
	WENDELL CORBETT
	LARRY EMERSON
CITY CLERK	TIM NORTON
	CAROL McBEATH

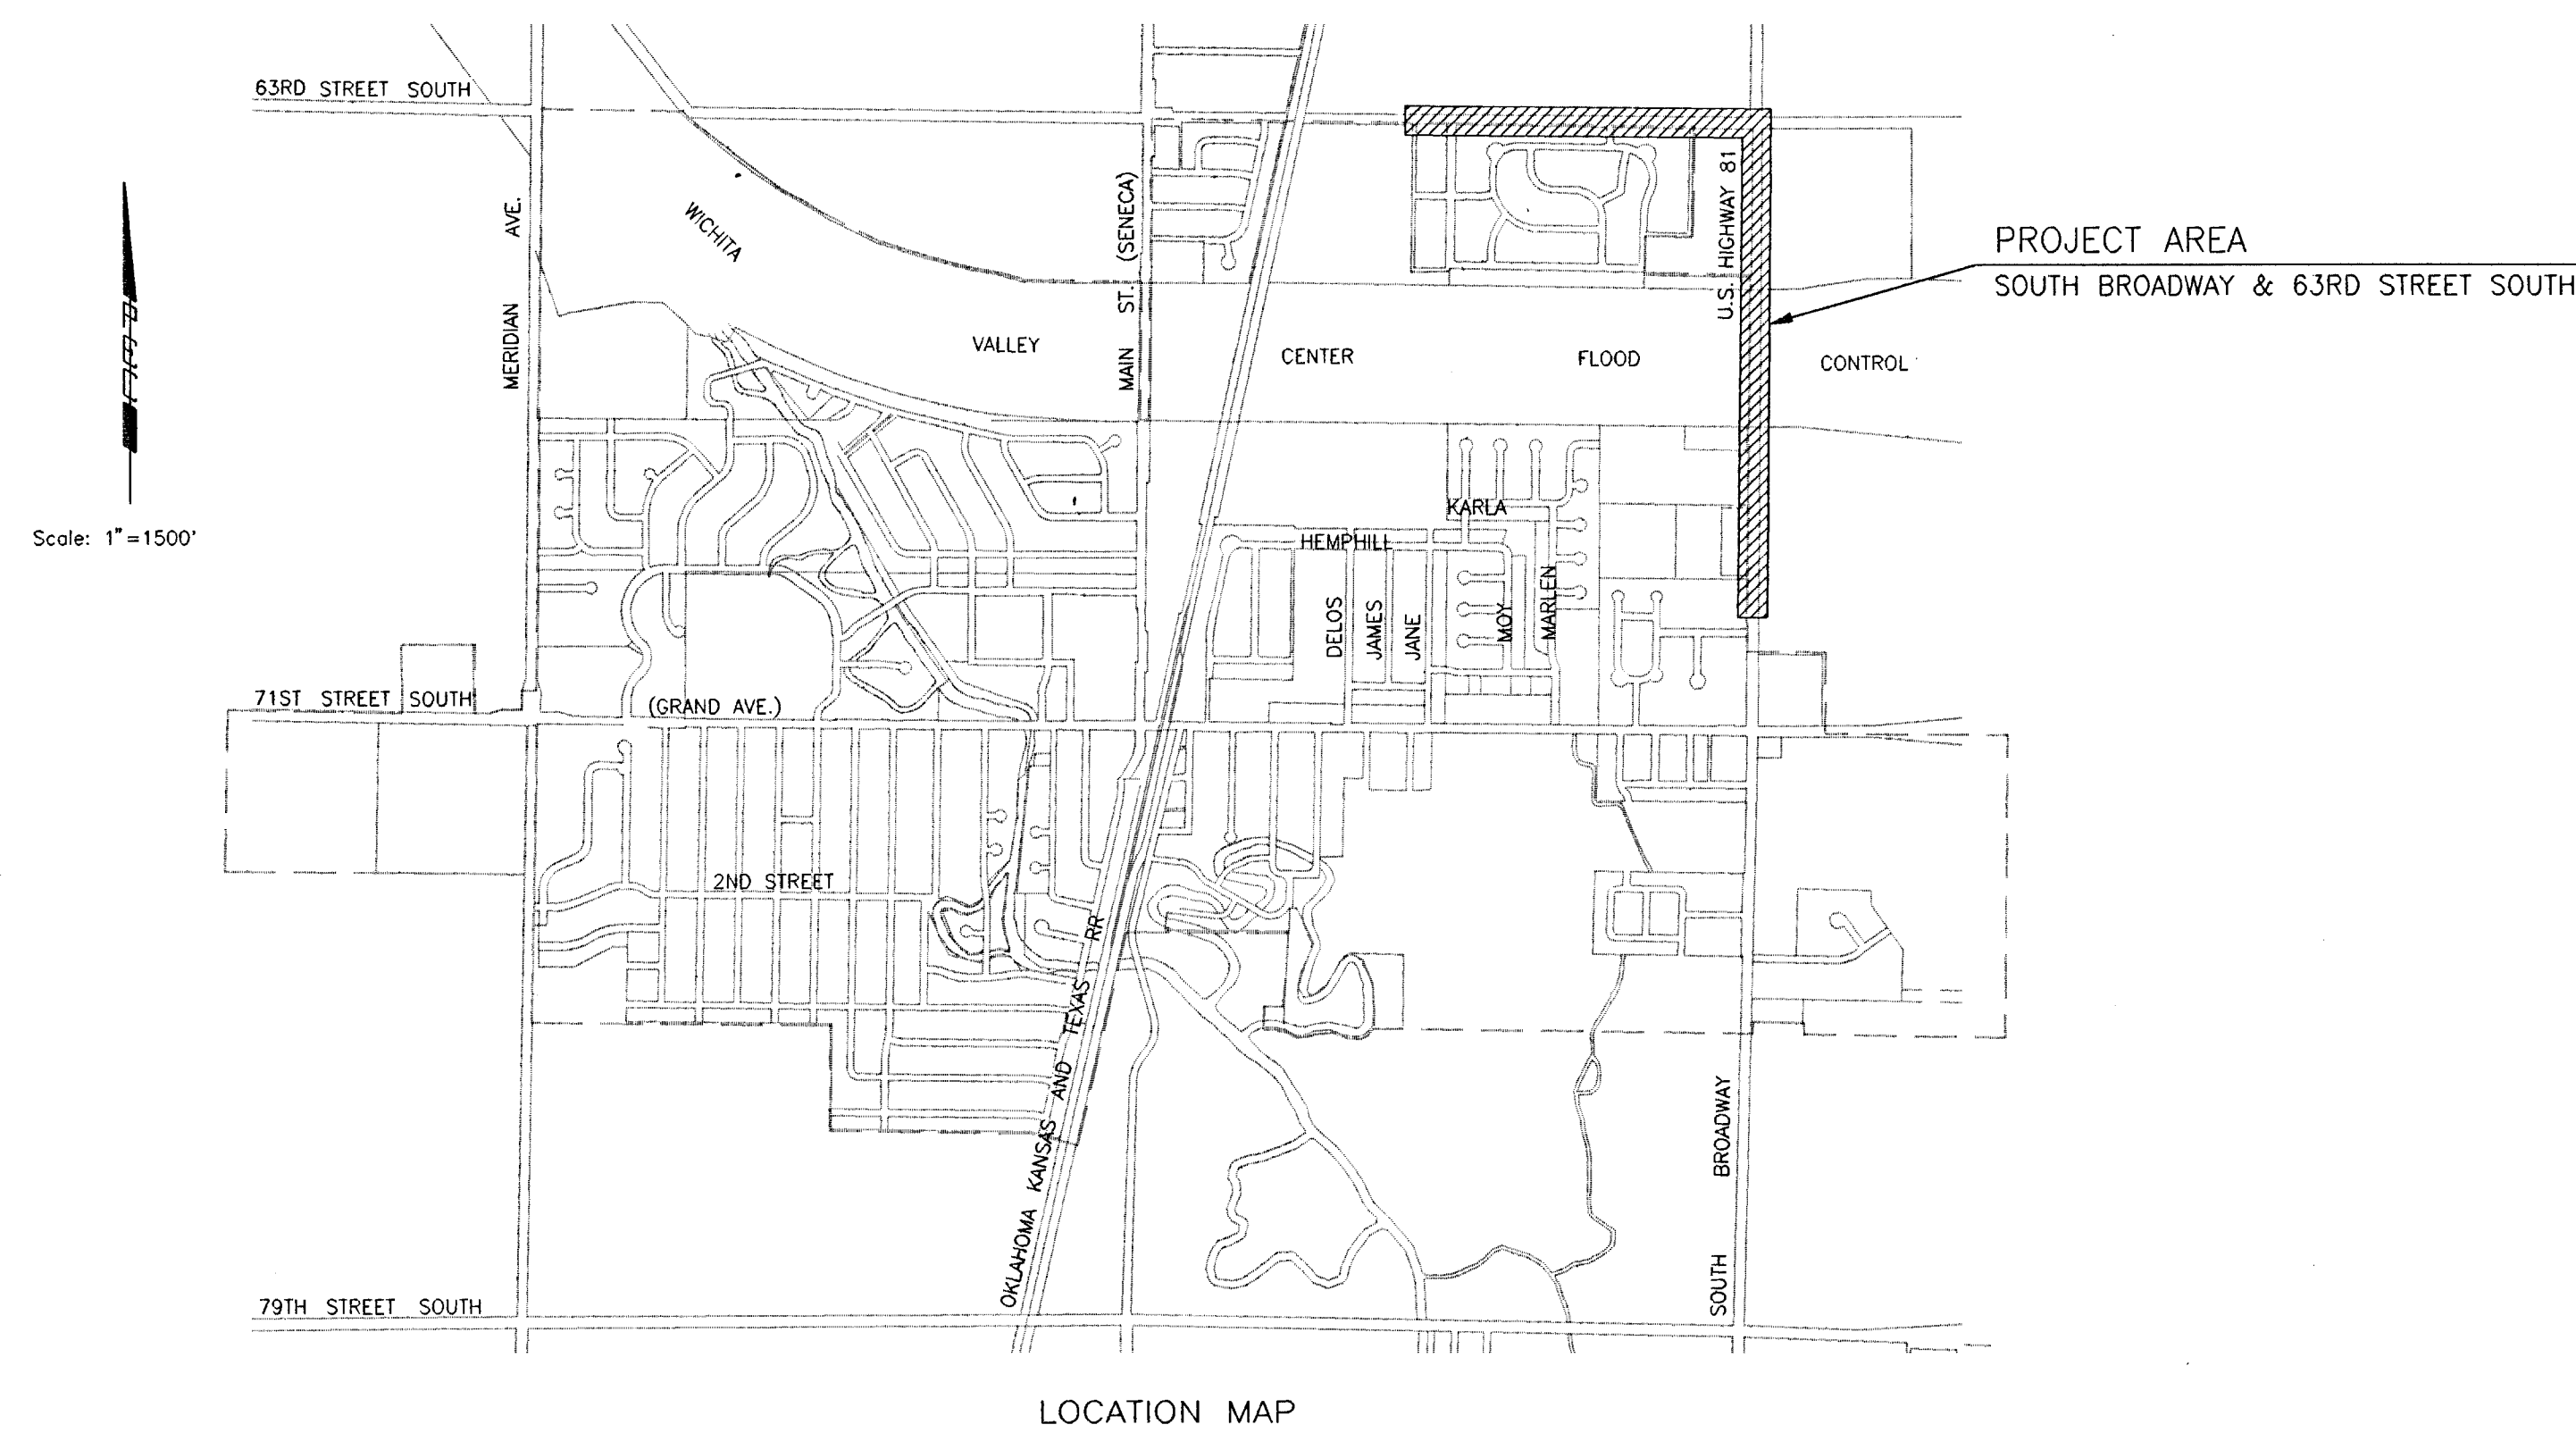

INDEX OF SHEETS

SHEET NO. 1	TITLE SHEET
SHEET NO. 2	KEY MAP
SHEET NO. 3	MISCELLANEOUS DETAILS
SHEET NO. 4-13	WATERLINE PLAN/PROFILE
SHEET NO. 14-15	BRIDGE ATTACHMENT DETAILS


OCTOBER 1995

PLANS PREPARED BY

PROFESSIONAL ENGINEERING CONSULTANTS, P.A.

ENGINEERS

WICHITA, KANSAS

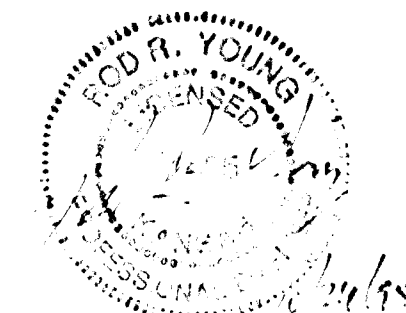

RECORD DRAWING
 10/1/95
 DATE