

RECORD DRAWING


DATE: 10/19/95

DESIGNER: MRS. CHA

PROF. R. YOUNG
LICENSED
11485
KANSAS
PROFESSIONAL ENGINEER

Unless noted otherwise, elevations shown are top of pipe

WATERLINE NO. 1

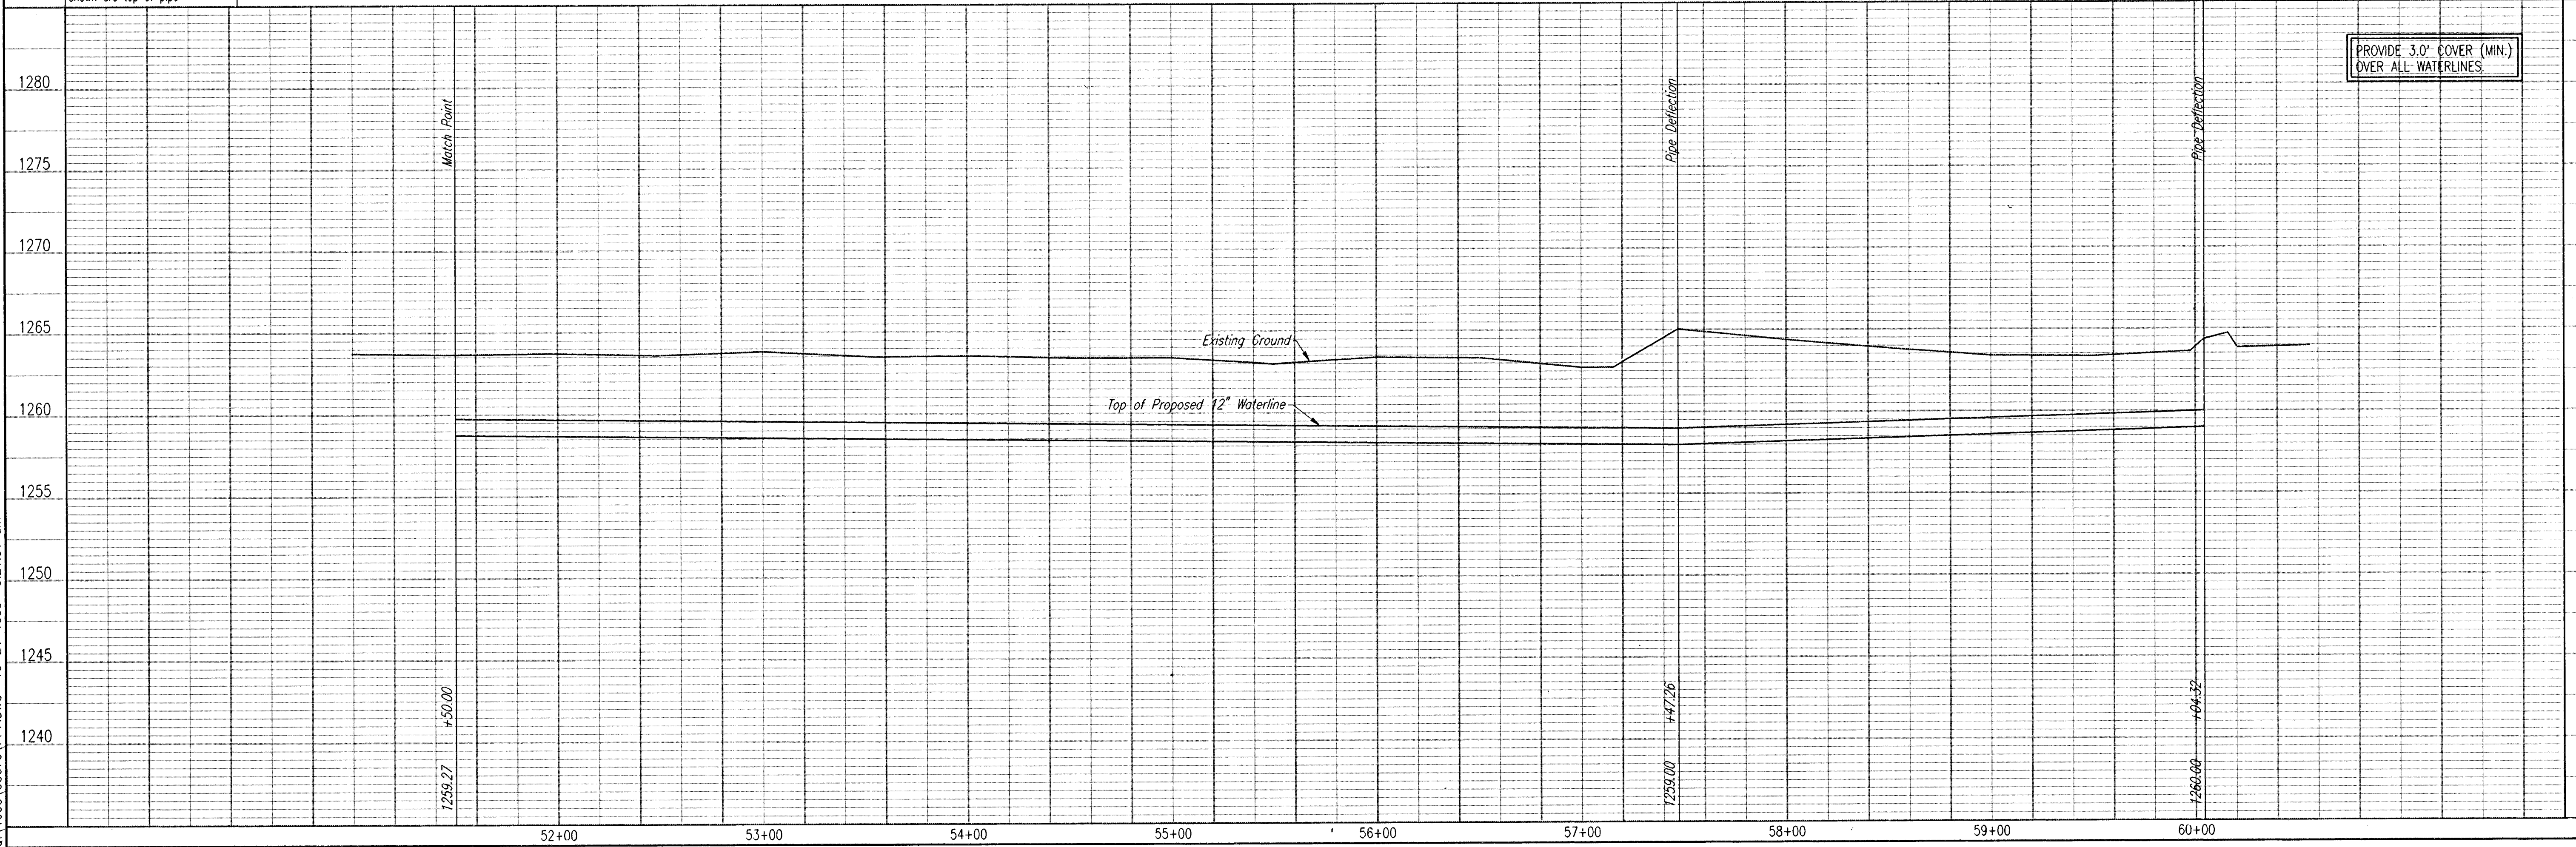

PROVIDE 3.0' COVER (MIN.) OVER ALL WATERLINES

DSNR: RFJ OPER: JLM SCALE: 1"=40.00
Q:\1995\95676\PP7.DWG 10-24-1995 9:21:51 am

CITY OF HAYSVILLE
SEDGWICK COUNTY, KANSAS

WATERLINE NO. 1

HAYSVILLE EMERGENCY WATERLINE
WATERLINE IMPROVEMENTS

PROFESSIONAL ENGINEERING CONSULTANTS, P.A.
DOCKERS
WICHITA, KANSAS

Job No. 34-95676
Date October 1995

Designed By MRS. MDK
Drawn By JLM

Sheet 10 of 15