


* PRIOR TO BEGINNING CONSTRUCTION, THE CONTRACTOR SHALL EXCAVATE THE UTILITIES TO VERIFY THEIR HORIZONTAL AND VERTICAL LOCATIONS. THE UTILITY LOCATION SHALL BE REPORTED TO THE ENGINEER SO THAT ANY NECESSARY PLAN MODIFICATIONS CAN BE MADE. ANY ADDITIONAL LABOR OR MATERIALS NECESSARY TO COMPLETE THE CONNECTIONS SHALL BE CONSIDERED SUBSIDIARY TO THE PROJECT.


Unless noted otherwise, elevations shown are top of pipe

WATERLINE NO. 1

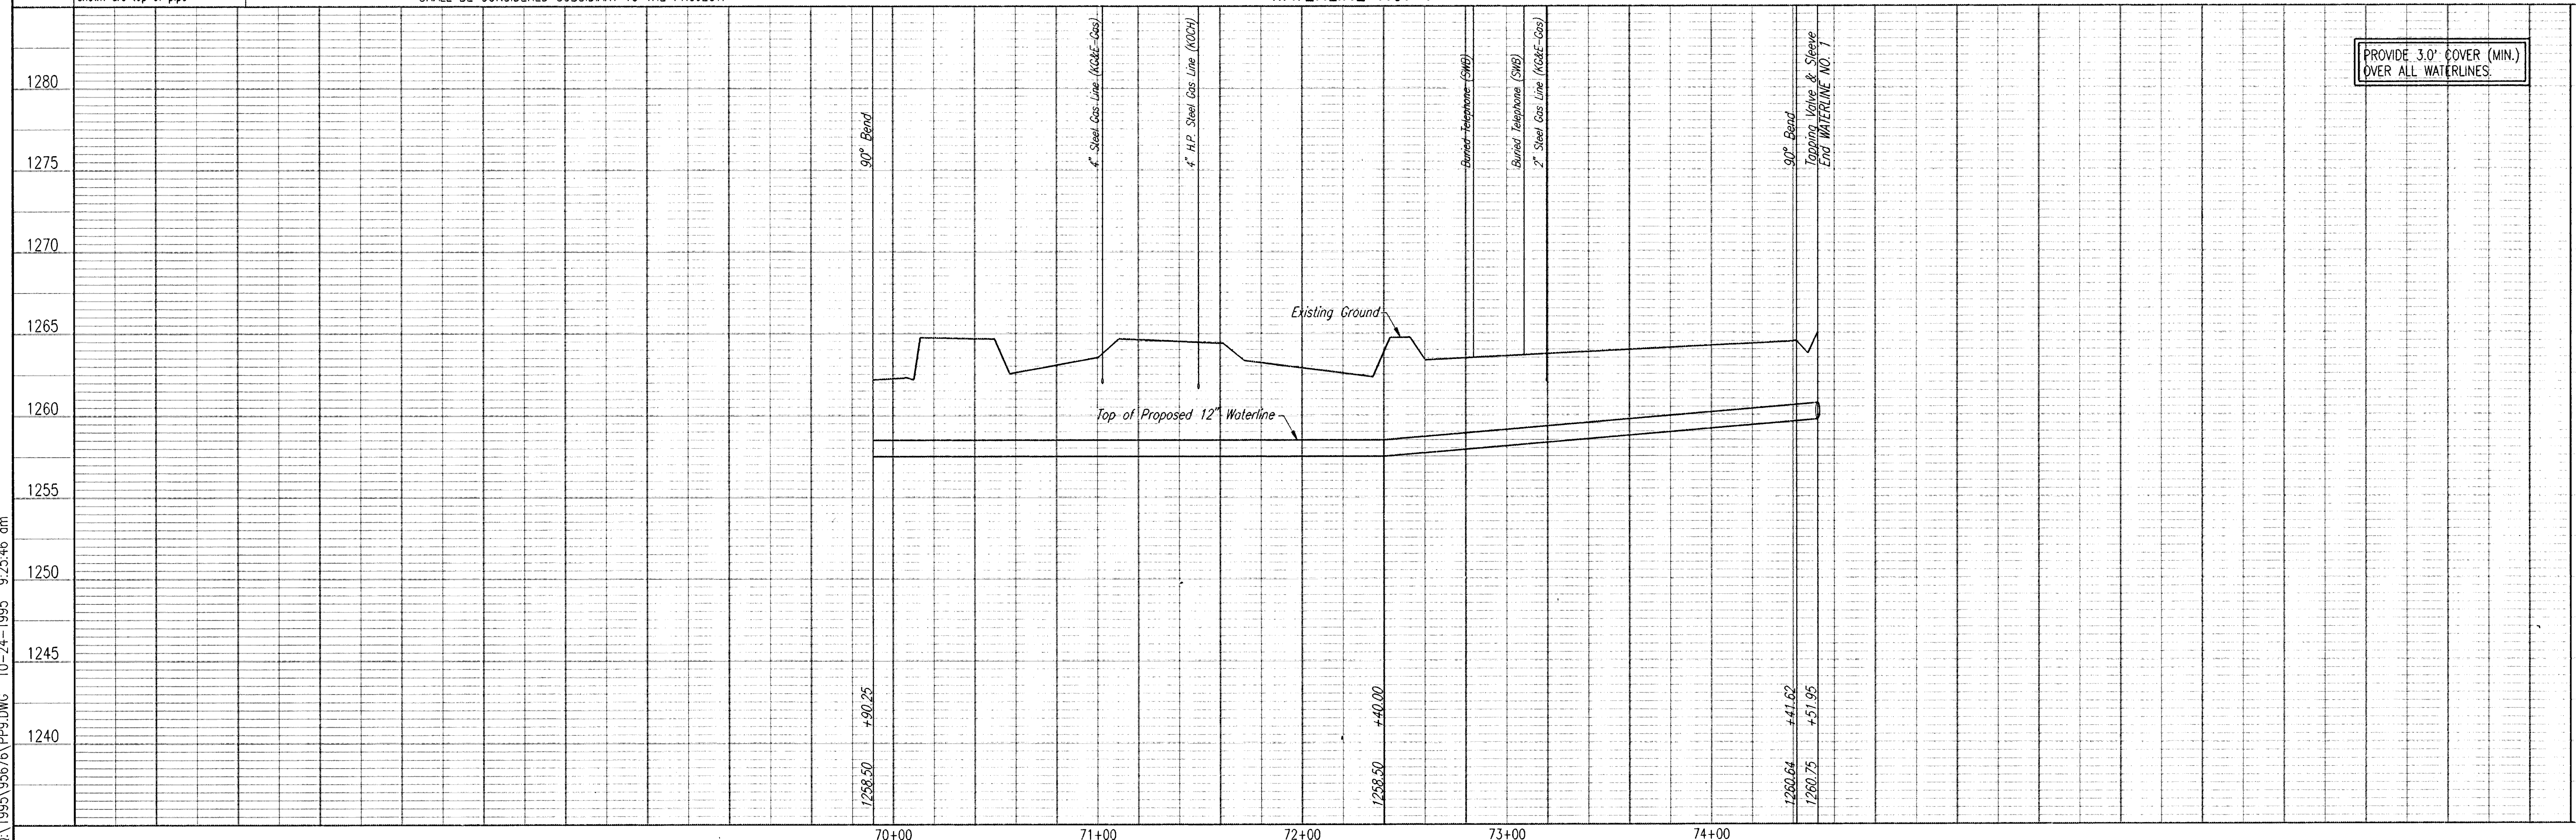

PROVIDE 3.0' COVER (MIN.) OVER ALL WATERLINES.

RECORD DRAWING
 DATE: 10/19/95
 DATE: 10/19/95

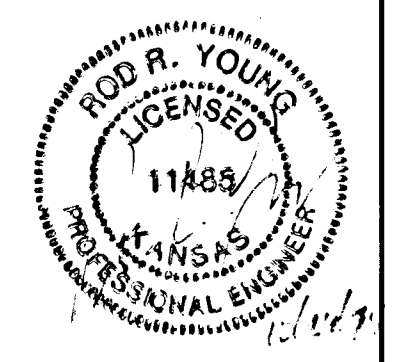

DSNR: REF. OPER. JLM. SCALE: 1=40.00
 O:\1995\95676\PP9.DWG 10-24-1995 9:25:46 am

CITY OF HAYSVILLE
 SEDGWICK COUNTY, KANSAS
WATERLINE NO. 1
 HAYSVILLE EMERGENCY WATERLINE
 WATERLINE IMPROVEMENTS

PROFESSIONAL ENGINEERING CONSULTANTS, P.A.
 ENGINEERS
 WICHITA, KANSAS

Job No. 34-59676
 Date October 1995

Designed By MDS, MDK
 Drawn By JLM

Sheet 12 of 15