


ELEVATION
(Bridge Rail not shown for clarity)

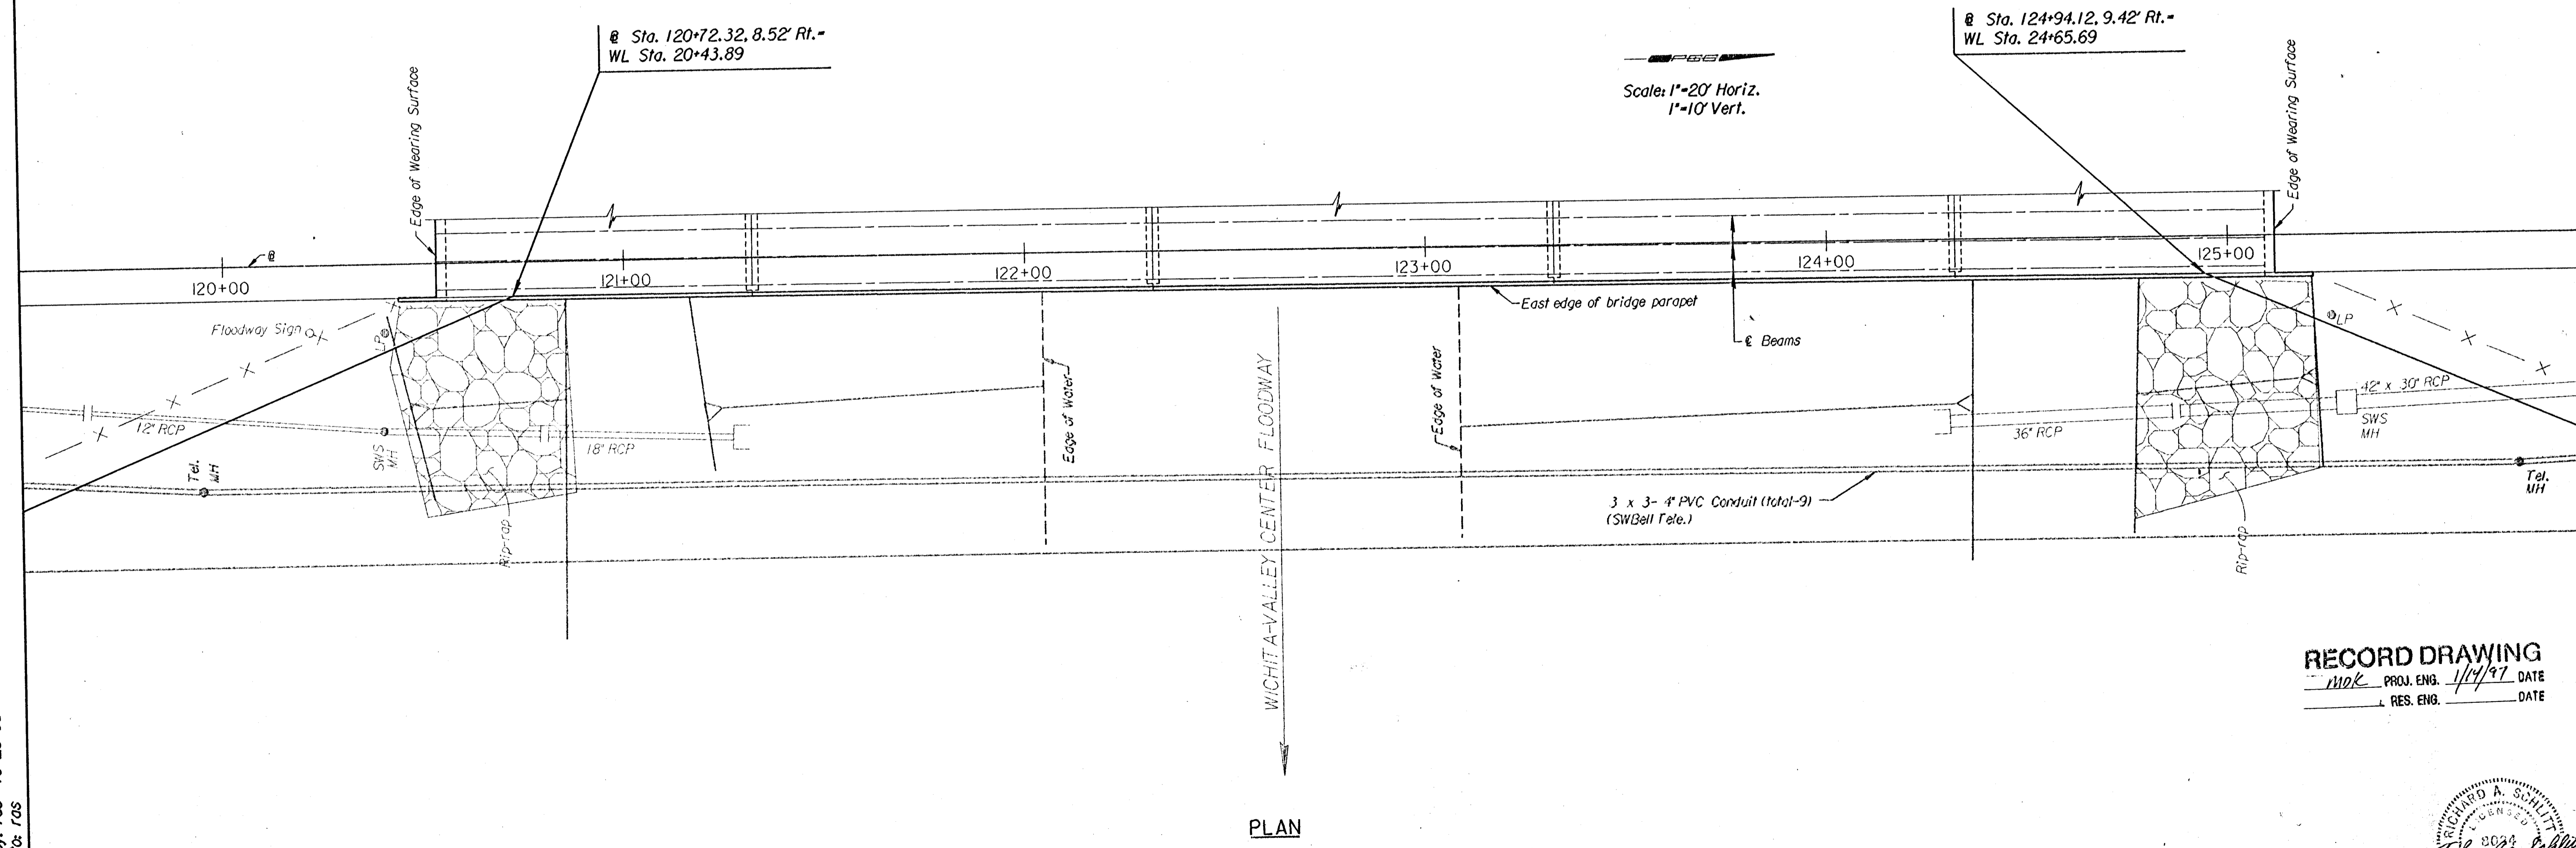


PLAN

Scale: 1"=20' Horiz.
1"=10' Vert.

i:\1995\95676\pbase.dgn
drawn by: maf
plotted by: ras 10-23-95
deliver to: ras

RECORD DRAWING
1102 PROJ. ENG. 1/14/97 DATE
RES. ENG. DATE

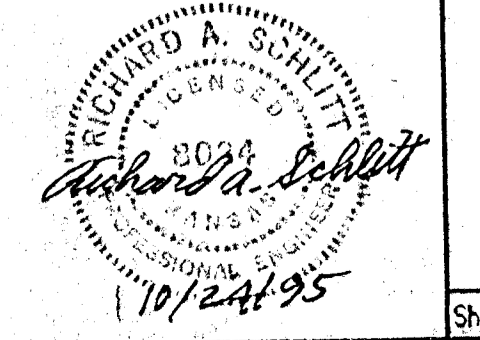

CITY OF HAYSVILLE
SEDWICK COUNTY, KANSAS
CONSTRUCTION LAYOUT
OVER WICHITA VALLEY CENTER FLOODWAY
HAYSVILLE EMERGENCY WATERLINE
WATERLINE IMPROVEMENTS

Prepared by: **Richard H. Schmitt, P.E.**
Wichita, Kansas

Job No. 22-95676
Date: October 1995

Designed by: RAS
Drawn by: MAF

Sheet 14 of 15