

**WICHITA COUNTRY CLUB  
SECOND ADDITION  
PARKING LOT EXPANSION PLANS**


**STORM WATER  
PLAN/PROFILE  
LINE 1**  
SHEET TITLE  
07038  
PROJECT NUMBER

SRS  
DESIGN BY  
MKEC  
DRAWN BY  
MAB  
CHECKED BY

ISSUED  
Sept. 2007  
REVISED

SHEET NO.  
12 of 20


**WICHITA COUNTRY CLUB  
SECOND ADDITION**

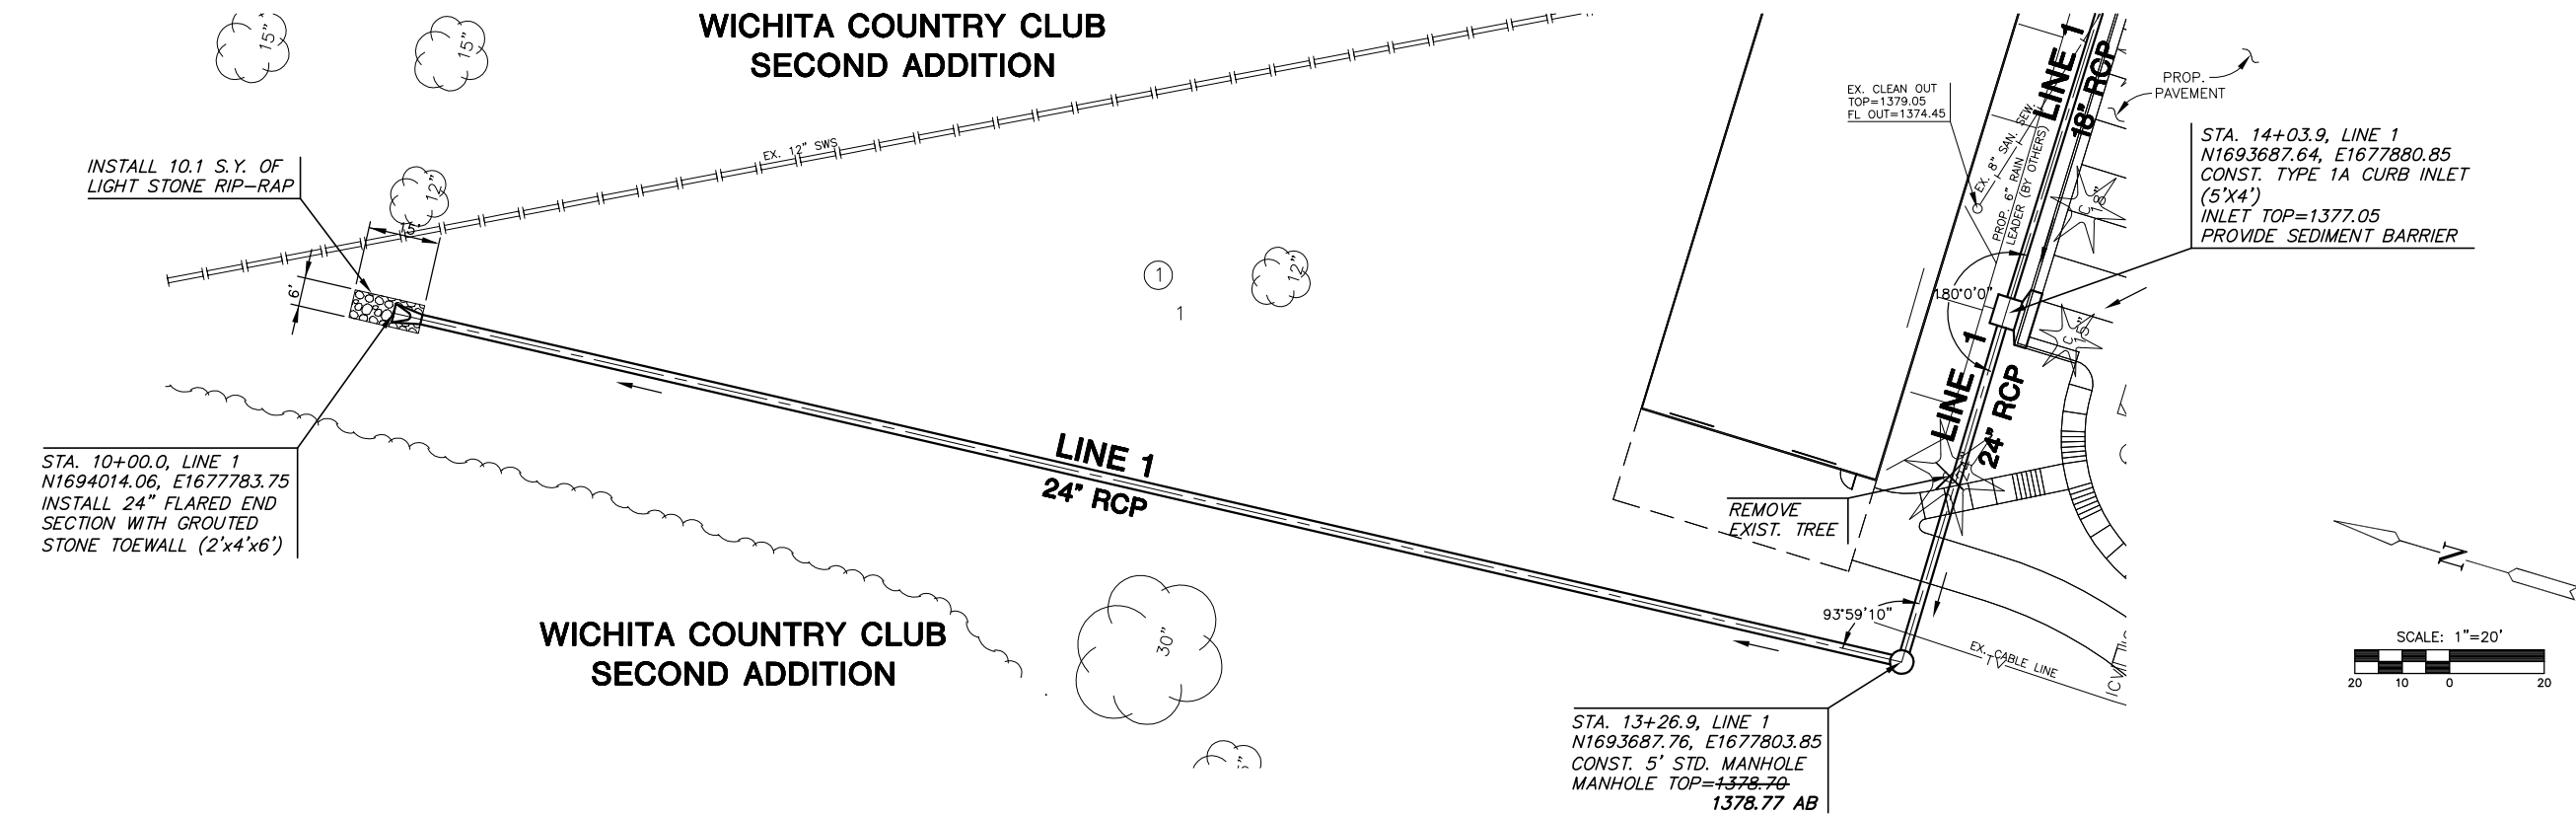

**PLAN LINE 1**

**AS-BUILT NOVEMBER 2007**

**PROFILE LINE 1**

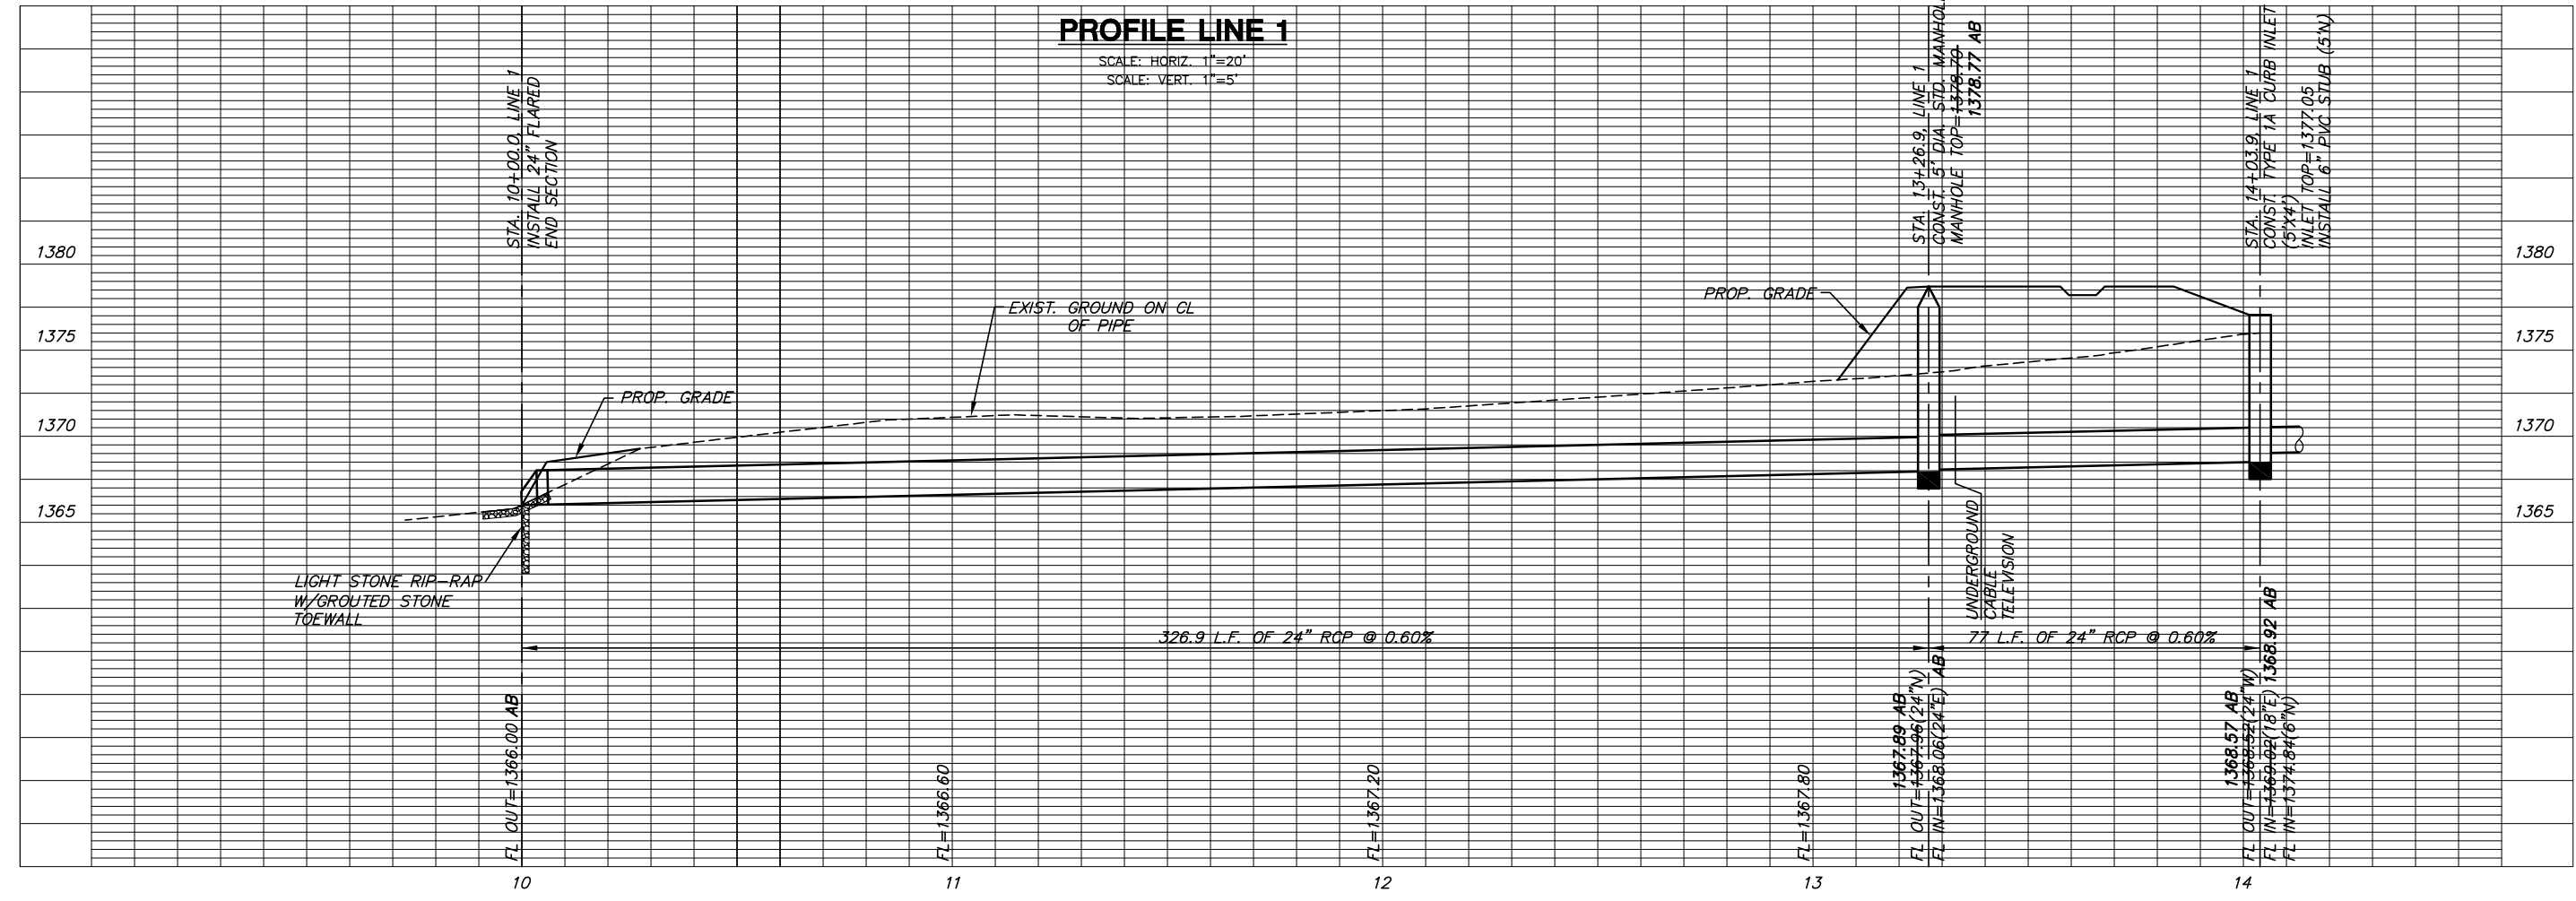

PLOTTED: Tuesday, November 20, 2007 @ 04:18PM

J:\CIVIL\07038.DWG SWS AS-BUILT\0703801.DWG