



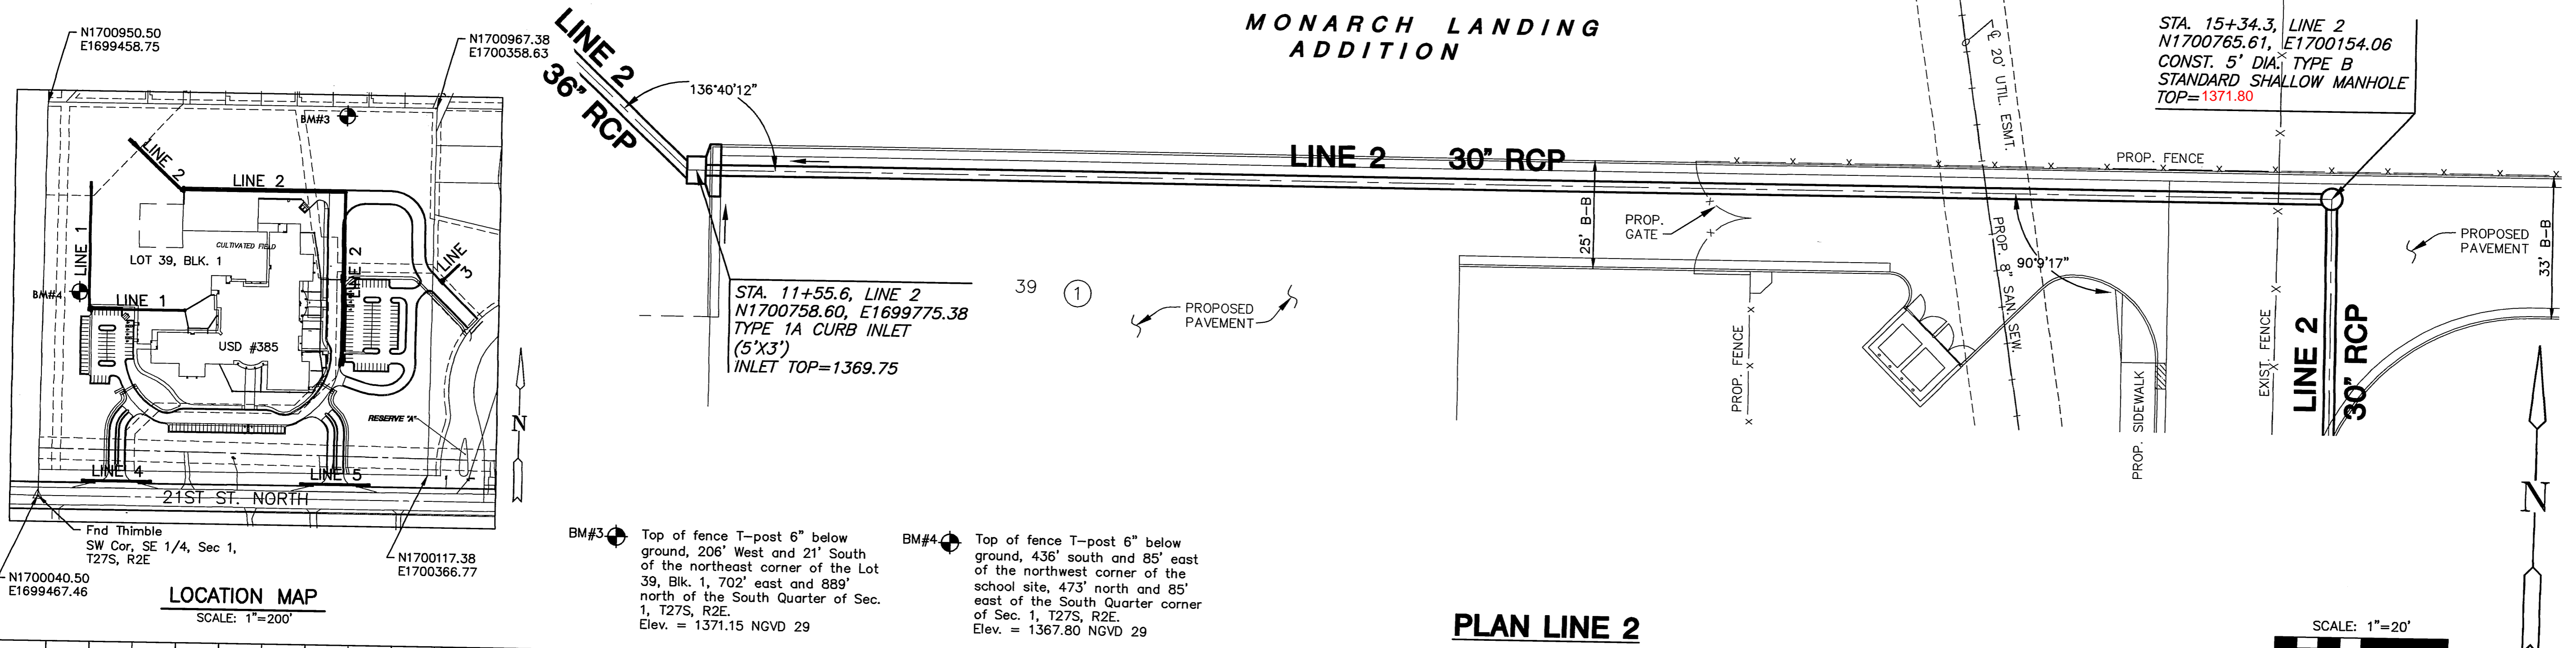

**MONARCH LANDING
ADDITION**

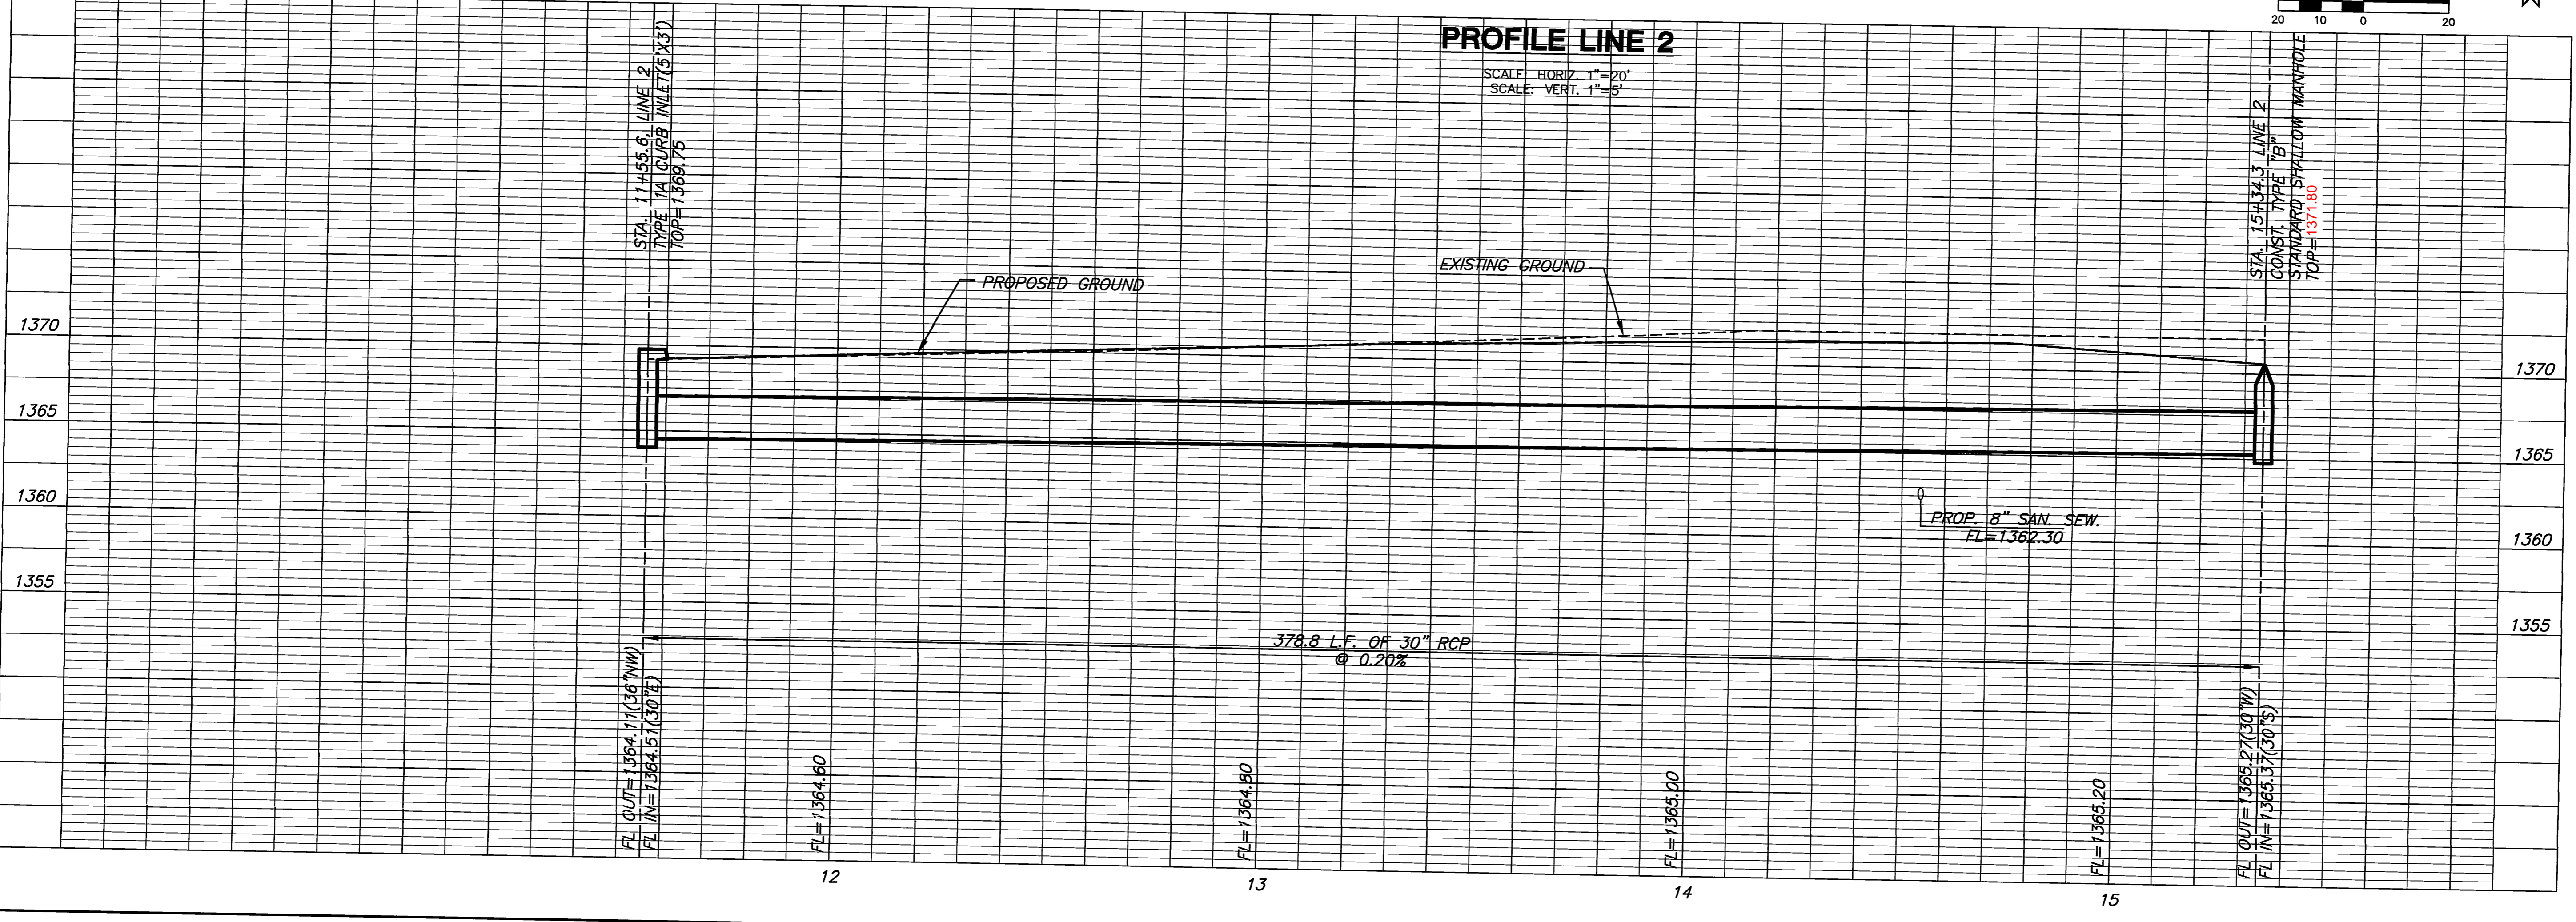

PROFILE LINE 2



**STORM WATER SEWER PLANS
ANDOVER ELEMENTARY SCHOOL #2**
LOT 39, BLOCK 1 MONARCH LANDING ADDITION

LINE 2
SHEET TITLE

06544
PROJECT NUMBER

SRS
DESIGN BY

MK
DRAWN BY

MAB
CHECKED BY

ISSUED
MARCH 2007

REVISED

SHEET NO.
3 of 5