


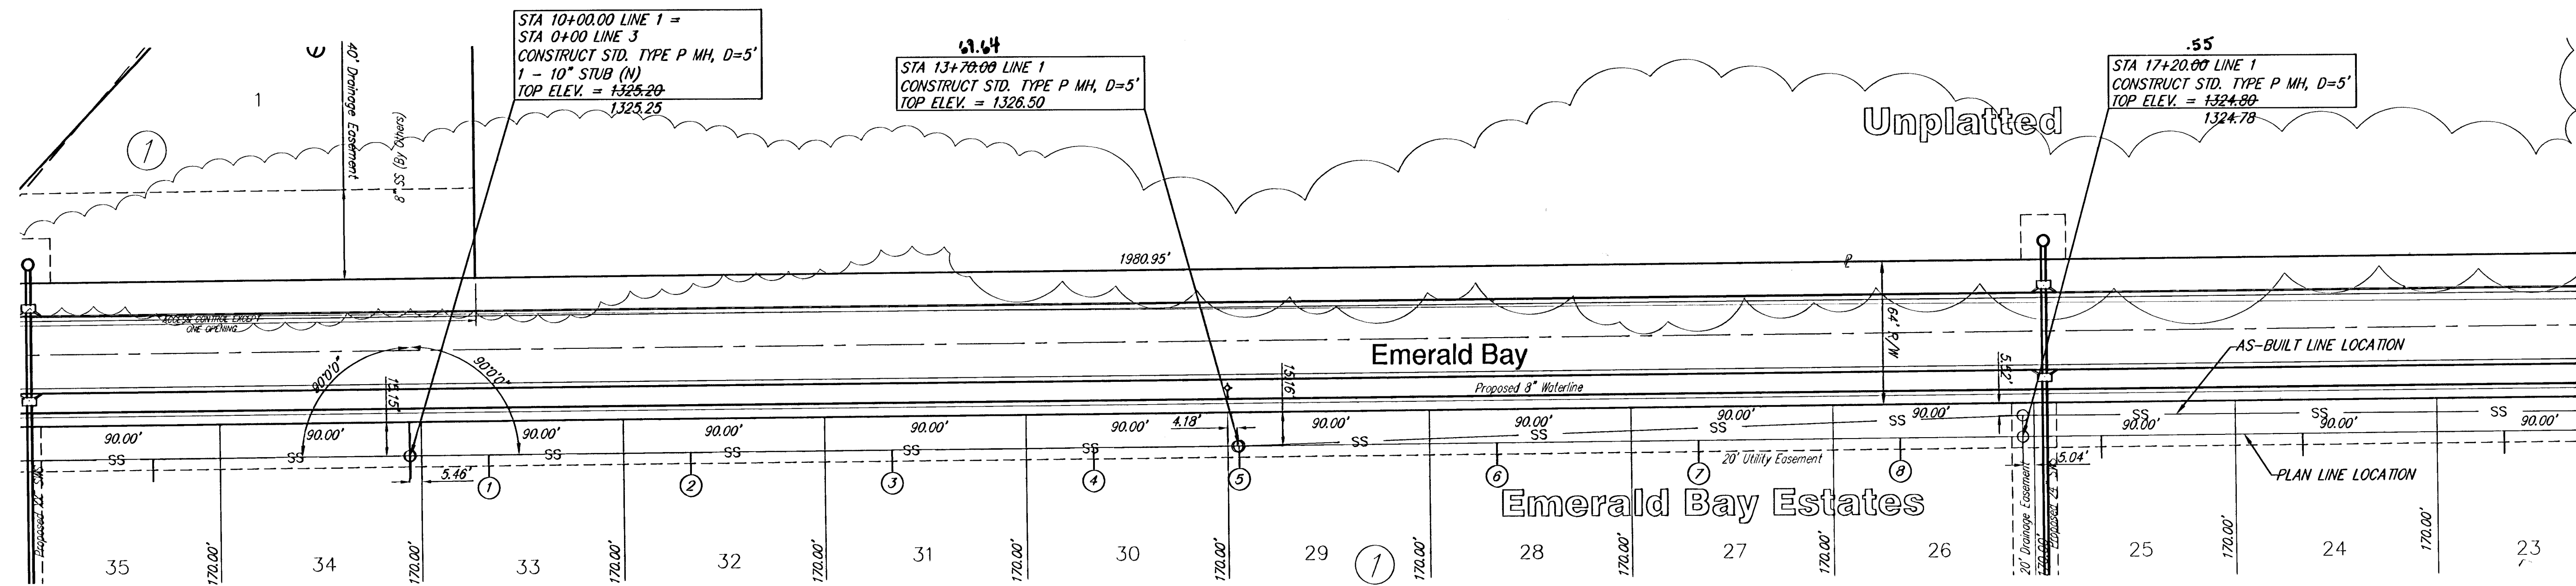

SCALE 1" = 40' HORIZ.
1" = 5' VERT.
IRON = ●

SEWER SERVICE TABLE

NUMBER	TYPE	LOCATION			FOR INFORMATION ONLY		
		LOT NO.	BLOCK NO.	LINE NO.	STATION\ DIRECTION	APPROXIMATE LENGTH 4" PIPE	
1	8" X 4" Tee Saddle	33	1	1	10+30/R	31.07	21'
2	8" X 4" Tee Saddle	32	1	1	11+25/R	26.12	21'
3	8" X 4" Tee Saddle	31	1	1	12+18/R	13.35	22'
4	8" X 4" Tee Saddle	30	1	1	13+08/R	66.07	22'
5	4" MH Riser	29	1	1	13+20/R	10.0	21'
6	8" X 4" Tee Saddle	28	1	1	14+85/R	8.3	20'
7	8" X 4" Tee Saddle	27	1	1	15+75/R	7.3	20'
8	8" X 4" Tee Saddle	26	1	1	16+85/R	10.2	19'

NOTE: ALL BACKFILL FOR SHALL BE SAND FLUSHED AND VIBRATED.

NOTE: Vertical Riser Pipe shall be extended to 2' minimum above ground water elevation and 4' maximum below proposed ground elevation.

"AS-BUILT"
12.2.07
3-15-07
AML
12.3.07
AML

