



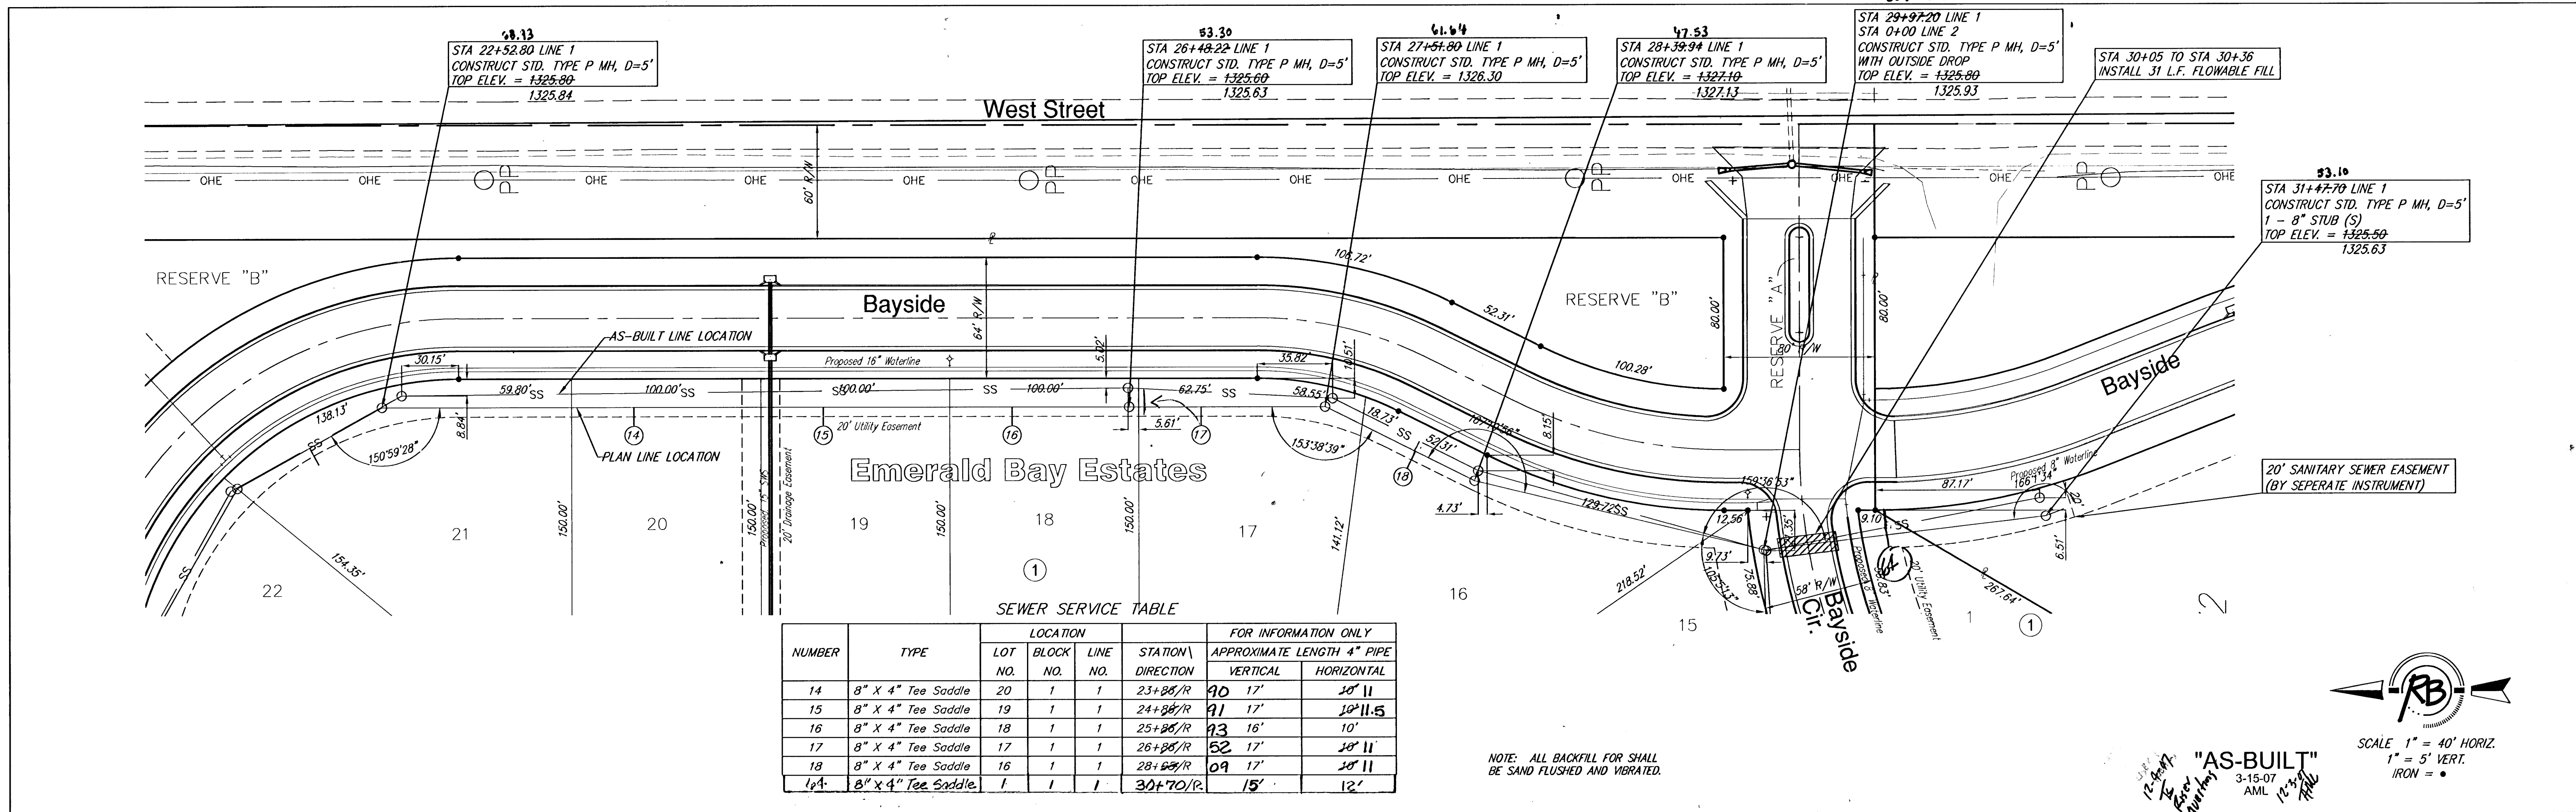


NUMBER	TYPE	LOCATION			FOR INFORMATION ONLY		
		LOT NO.	BLOCK NO.	LINE NO.	STATION\ DIRECTION	APPROXIMATE LENGTH 4" PIPE	
14	8" X 4" Tee Saddle	20	1	1	23+88/R	90' 17"	10' 11"
15	8" X 4" Tee Saddle	19	1	1	24+88/R	91' 17"	10' 11.5"
16	8" X 4" Tee Saddle	18	1	1	25+88/R	93' 16"	10'
17	8" X 4" Tee Saddle	17	1	1	26+88/R	52' 17"	10' 11"
18	8" X 4" Tee Saddle	16	1	1	28+88/R	09' 17"	10' 11"
19	8" X 4" Tee Saddle	1	1	1	30+70/R	15'	12'

NOTE: ALL BACKFILL FOR SHALL BE SAND FLUSHED AND VIBRATED.

"AS-BUILT"
3-15-07
AML

SCALE 1" = 40' HORIZ.
1" = 5' VERT.
IRON = •

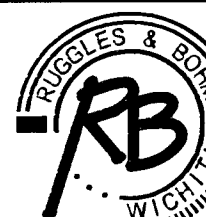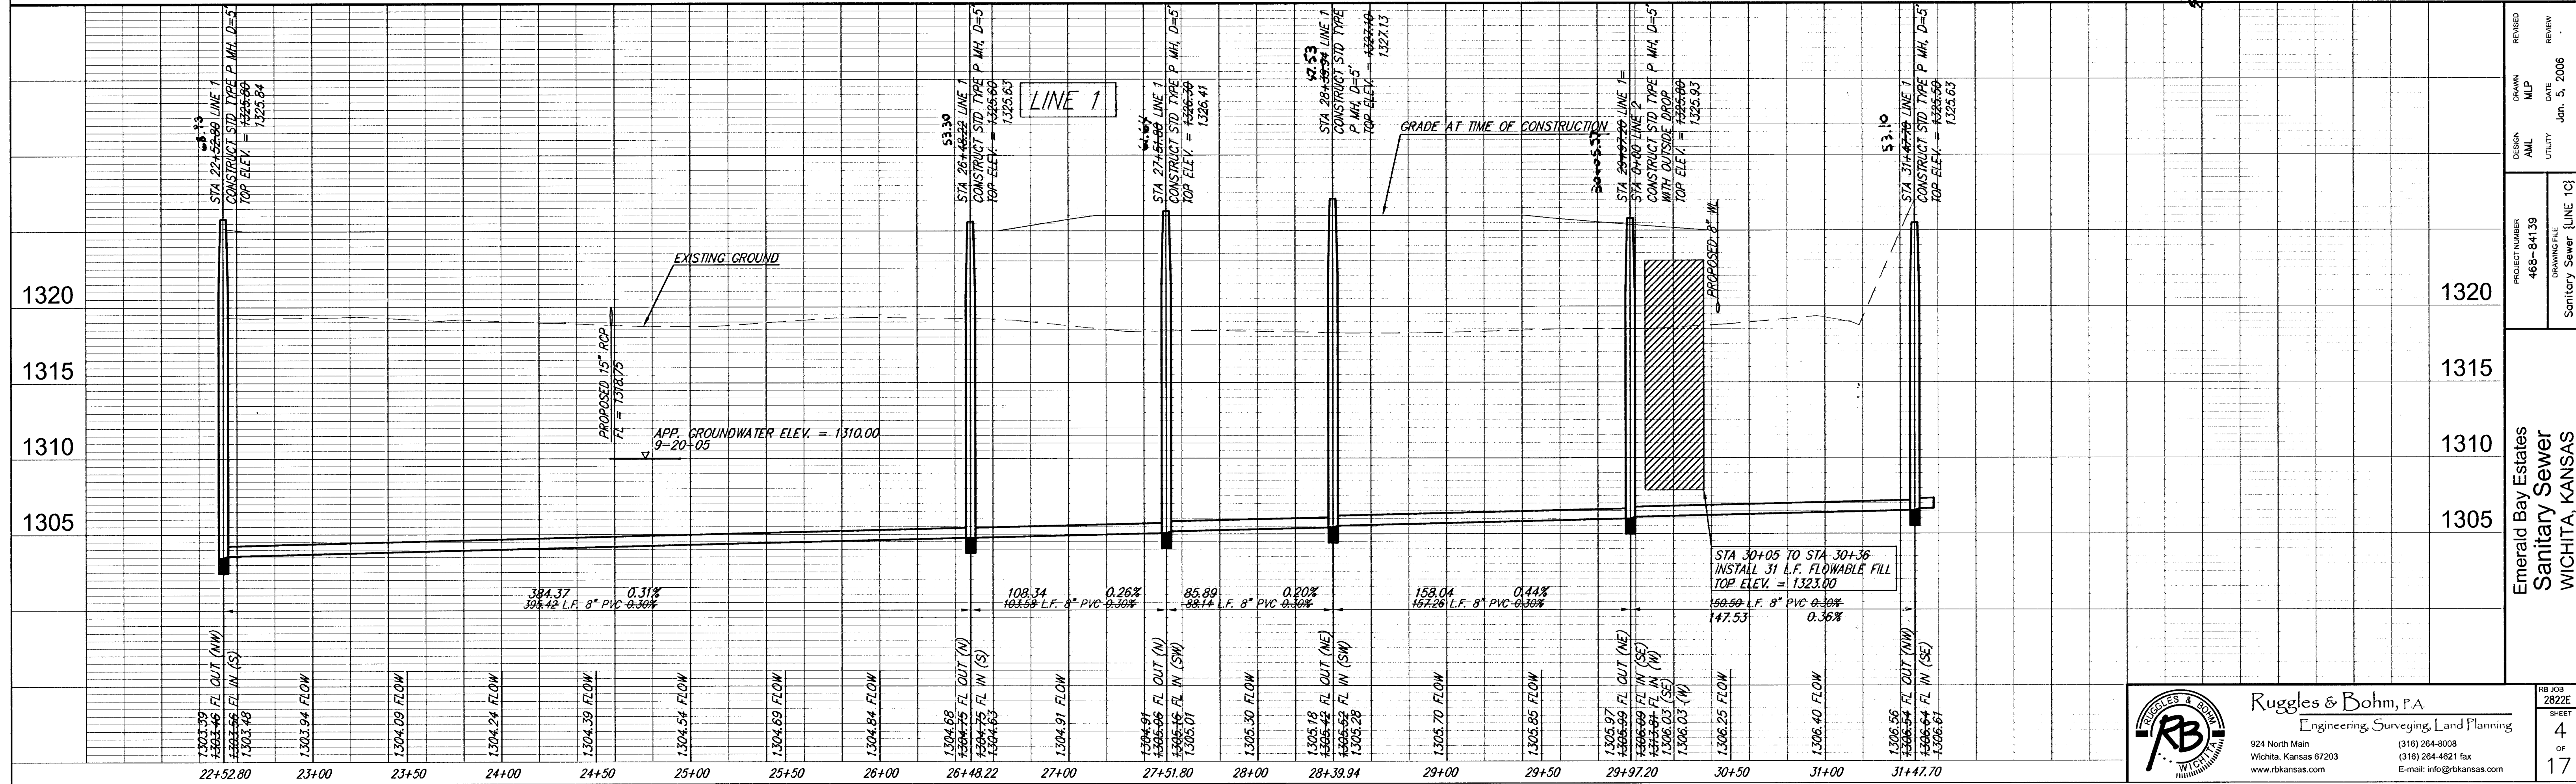

Ruggles & Bohm, P.A.
Engineering, Surveying, Land Planning
924 North Main
Wichita, Kansas 67203
www.rbkansas.com
(316) 264-8008
(316) 264-4621 fax
E-mail: info@rbkansas.com