




SEWER SERVICE TABLE						
NUMBER	TYPE	LOCATION			FOR INFORMATION ONLY	
		LOT NO.	BLOCK NO.	LINE NO.	STATION\ DIRECTION	APPROXIMATE LENGTH 4" PIPE VERTICAL HORIZONTAL
19	8" X 4" Tee Saddle	15	1	2	0+18/R 44	7' 10' 11"
20	8" X 4" Tee Saddle	14	1	2	1+75/R 73	6' 10' 11"
21	4" MH Riser	13	1	2	2+57/R 52	5' 10'
22	8" X 4" Tee Saddle	12	1	2	3+85/R 64	6' 10'
23	4" MH Riser	11	1	2	4+37/R 38	5' 10' 9.5"
24	4" MH Riser	10	1	2	6+31/R 36	5' 10'
25	4" MH Riser	9	1	2	6+31/R 36	5' 10' 9.5"
26	4" MH Riser	8	1	2	6+99/R 7404	5' 10' 10.5"
27	8" X 4" Double Wye	2	1	2A	0+83/L 78	5' 10' 9"
28	8" X 4" Double Wye	3	1	2A	0+83/R 78	5' 10' 9.5"
29	8" X 4" Double Wye	4	1	2B	0+83/L 77	5' 10' 9.5"
30	8" X 4" Double Wye	5	1	2B	0+83/R 77	5' 10'
31	8" X 4" Double Wye	6	1	2C	1+31/L 07	5' 10' 9"
32	8" X 4" Double Wye	7	1	2C	1+31/R 07	5' 10'

NOTE: Vertical Riser Pipe shall be extended to 2' minimum above ground water elevation and 4' maximum below proposed ground elevation.

NOTE: ALL BACKFILL FOR SHALL BE SAND FLUSHED AND VIBRATED.

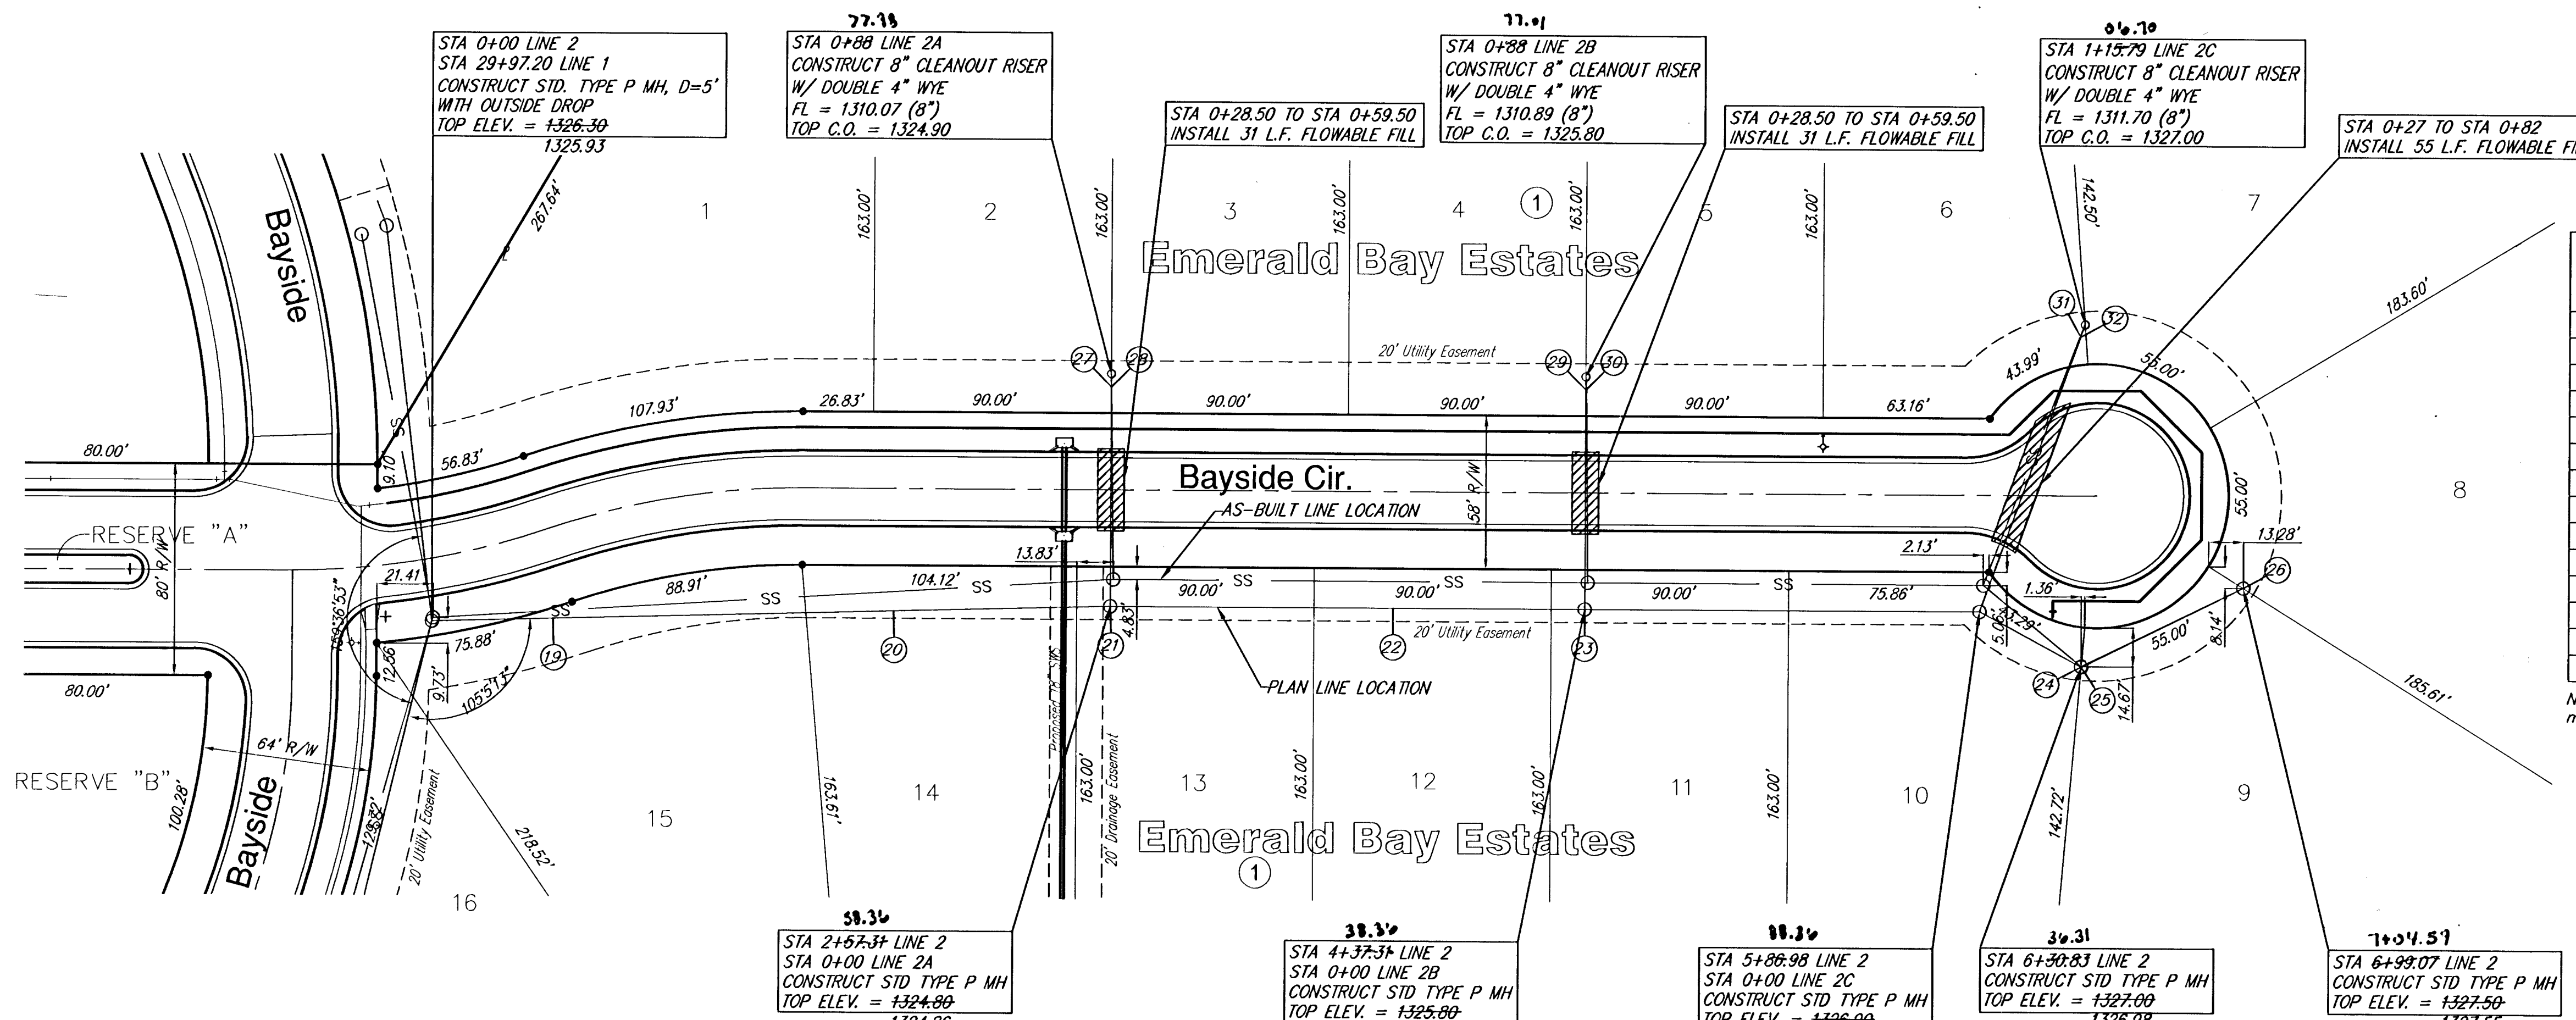

"AS-BUILT" 12-4-07

