


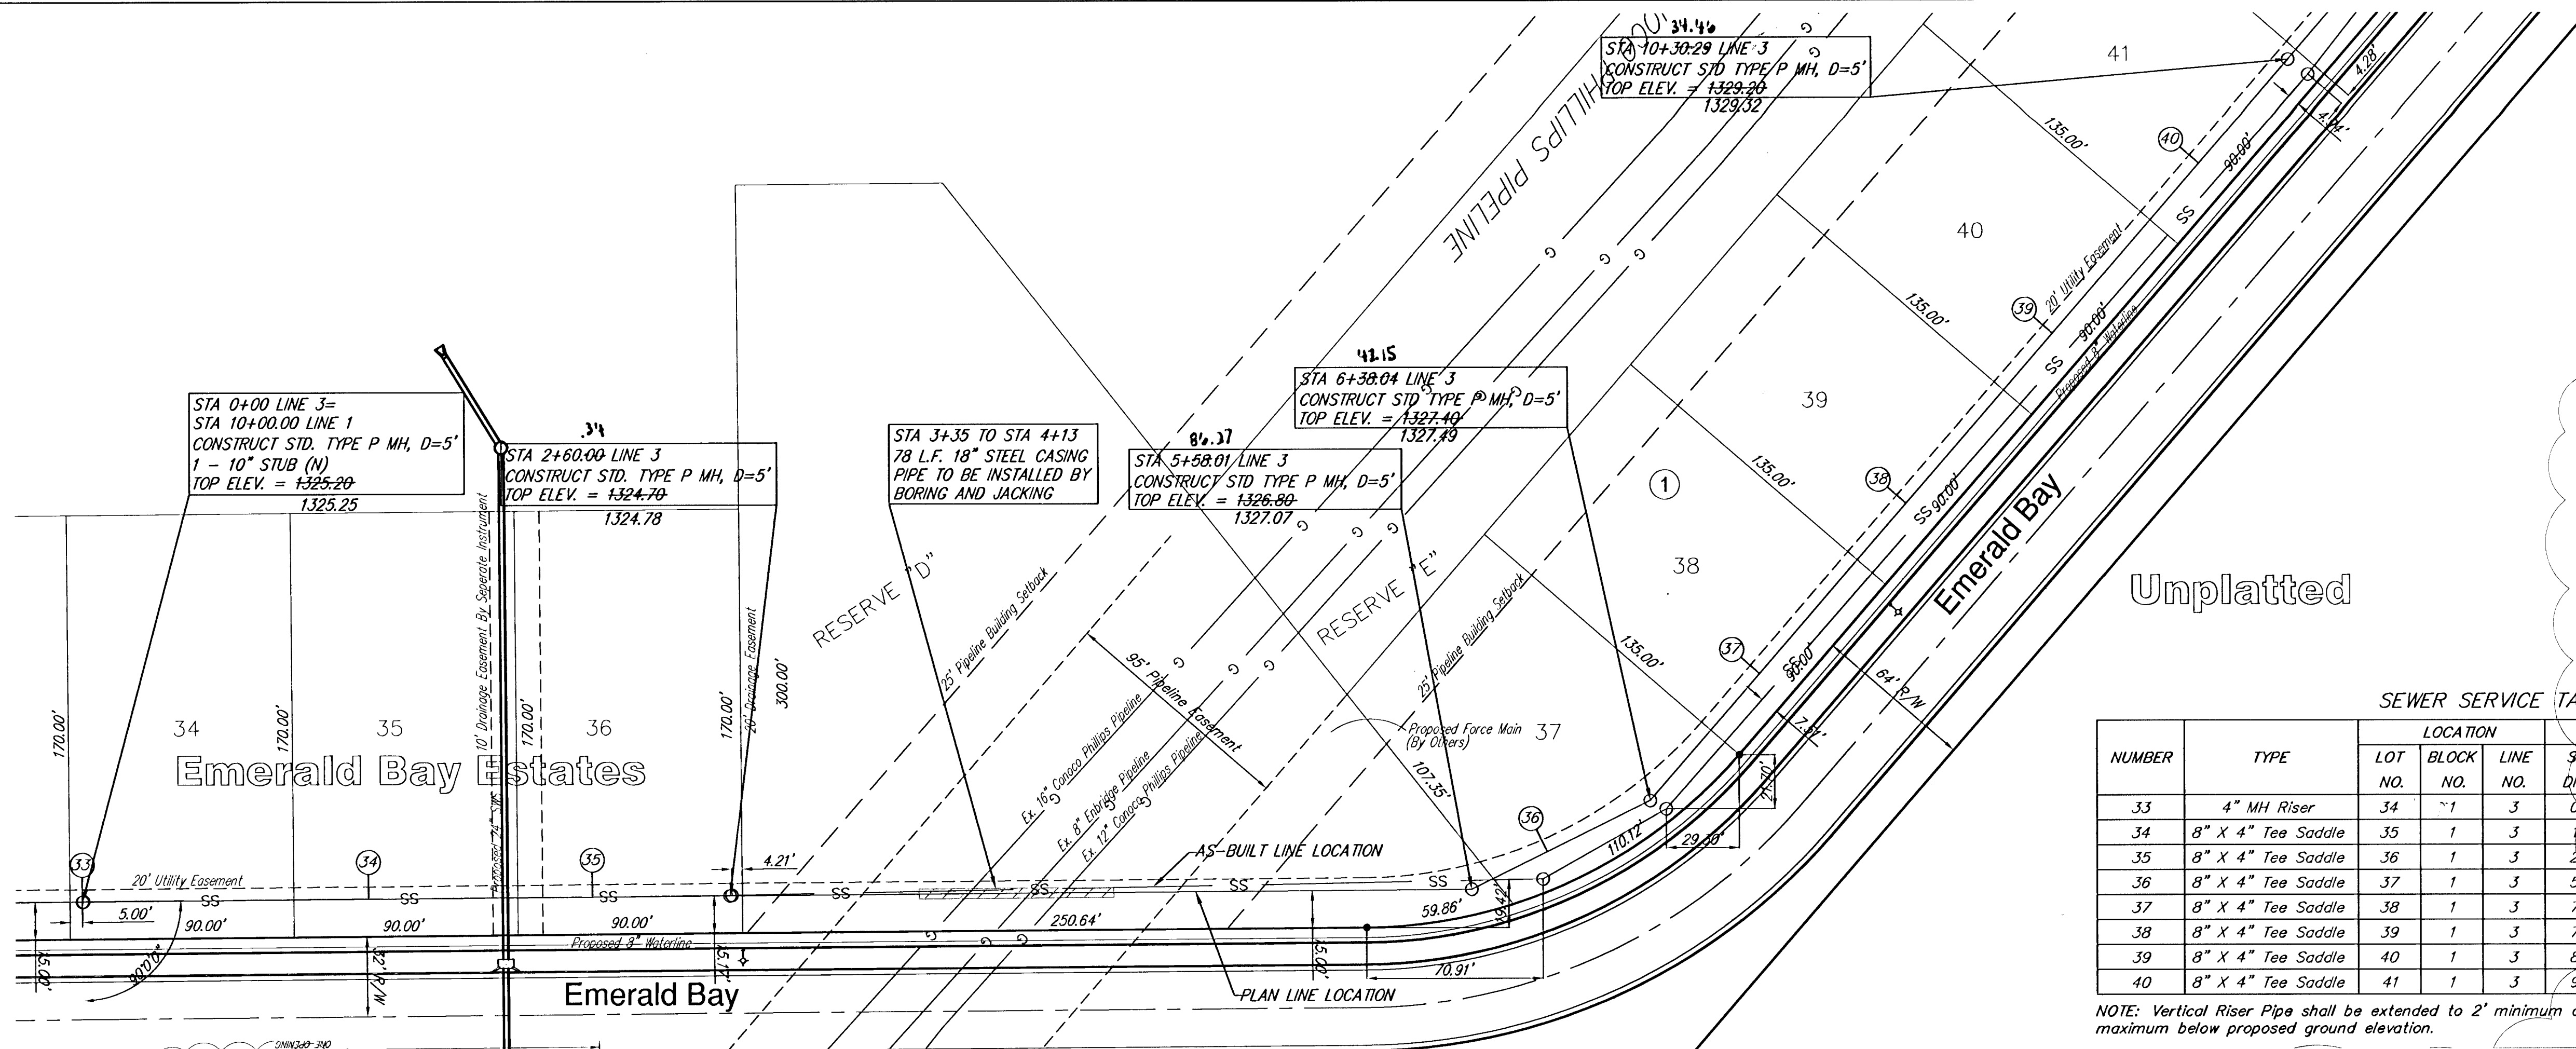


NOTE: ALL BACKFILL FOR SHALL BE SAND FLUSHED AND VIBRATED.

SEWER SERVICE TABLE



NUMBER	TYPE	LOCATION			FOR INFORMATION ONLY	
		LOT NO.	BLOCK NO.	LINE NO.	STATION\ DIRECTION	APPROXIMATE LENGTH 4" PIPE
33	4" MH Riser	34	1	3	0+00/L	21'
34	8" X 4" Tee Saddle	35	1	3	1+15/L	20'
35	8" X 4" Tee Saddle	36	1	3	2+05/L	19'
36	8" X 4" Tee Saddle	37	1	3	5+22/L	21'
37	8" X 4" Tee Saddle	38	1	3	7+08/L	21'
38	8" X 4" Tee Saddle	39	1	3	7+98/L	22'
39	8" X 4" Tee Saddle	40	1	3	8+85/L	22'
40	8" X 4" Tee Saddle	41	1	3	9+25/L	10'

NOTE: Vertical Riser Pipe shall be extended to 2' minimum above ground water elevation and 4' maximum below proposed ground elevation.

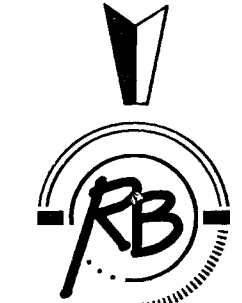

SCALE 1" = 40' HORIZ.
1" = 5' VERT.
IRON = •

"AS-BUILT"
12-3-07
3-15-07
AML

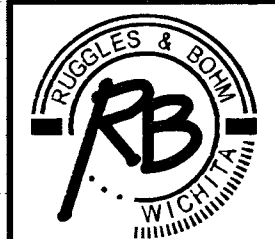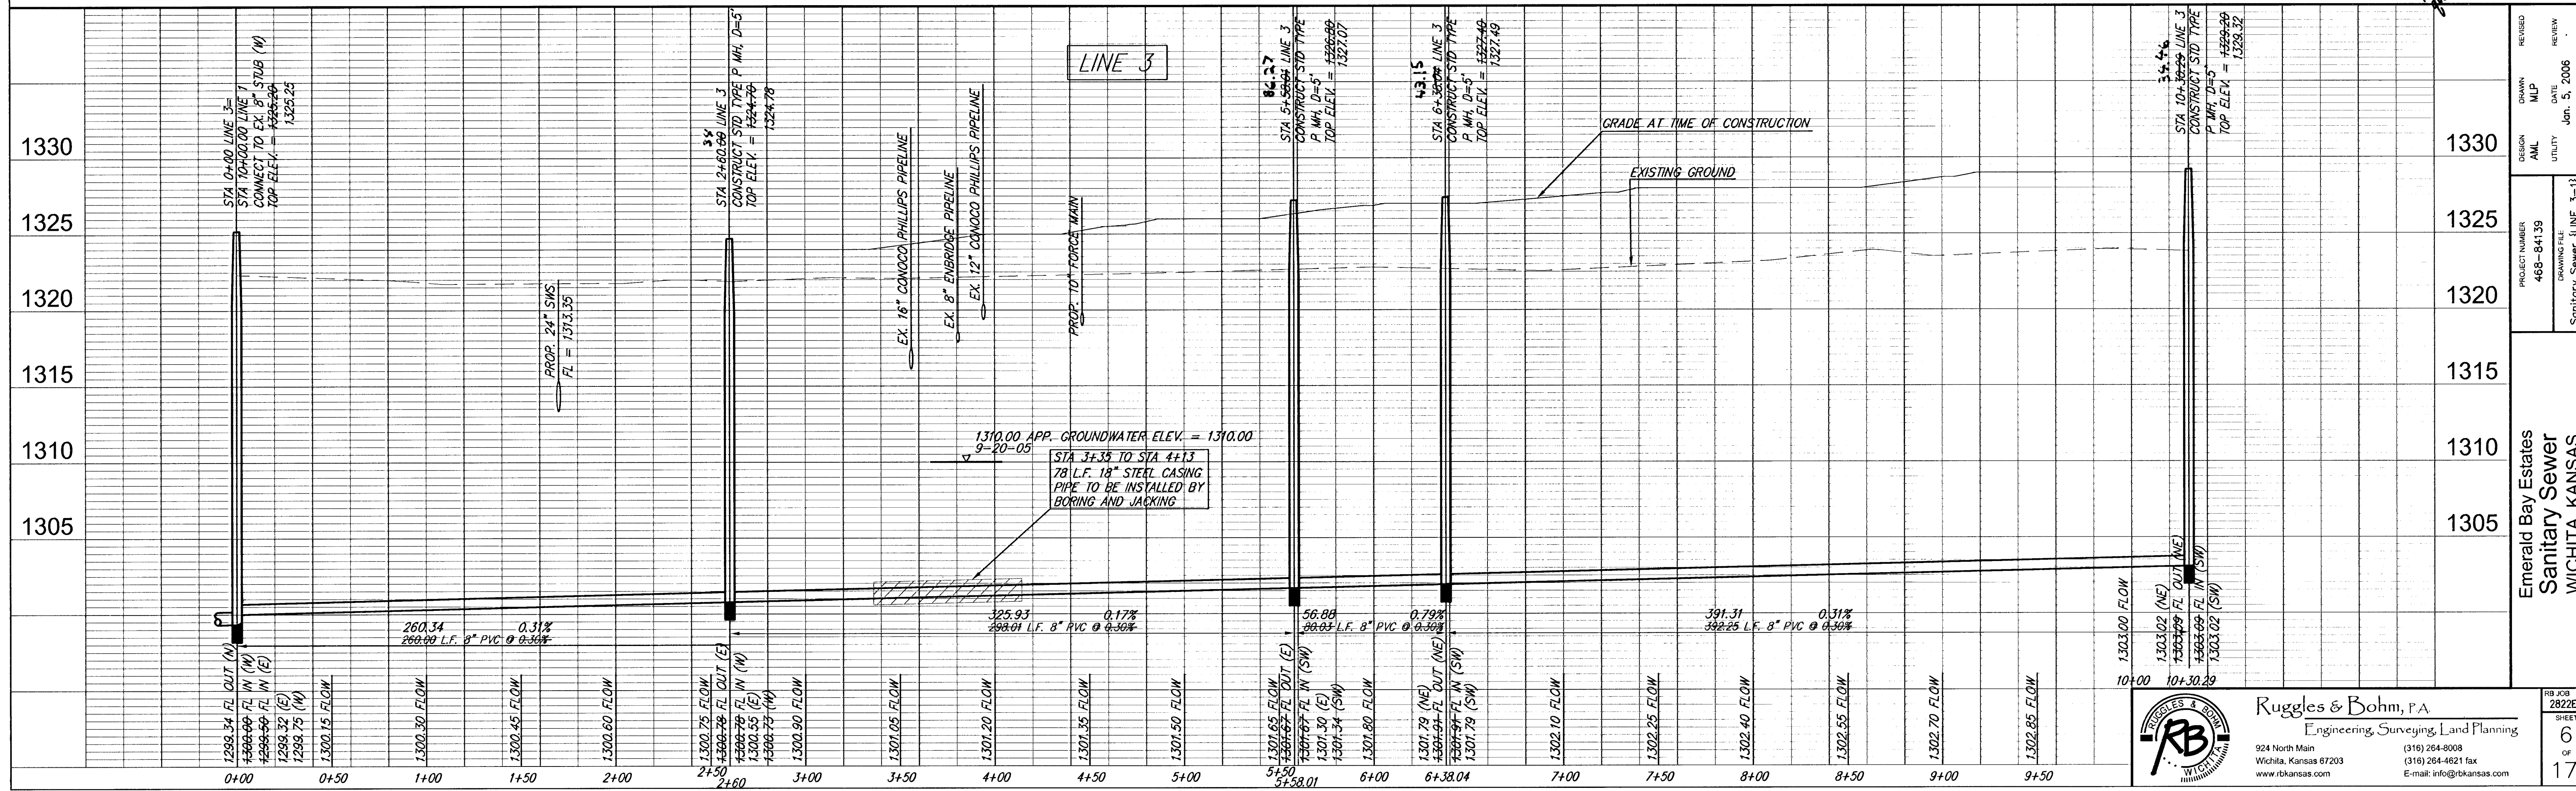

Ruggles & Bohm, P.A.
Engineering, Surveying, Land Planning
924 North Main
Wichita, Kansas 67203
(316) 264-8008
(316) 264-4621 fax
E-mail: info@rbkansas.com

REVIEW	DATE	REVIEW
DESIGN	MLP	Jan. 3, 2008
PROJECT NUMBER	468-84139	
DRAWING FILE	Sanitary Sewer {LINE 3-13}	
Emerald Bay Estates Sanitary Sewer WICHITA, KANSAS		
RB JOB	2822E	
SHEET	6	
OF	17	