




**NOTE: ALL BACKFILL FOR SHALL
BE SAND FLUSHED AND VIBRATED.**

**SANITARY SEWER EASEMENT
(BY SEPERATE INSTRUMENT)**

"AS-BUILT"
SCALE 1" = 40' HORIZ.
1" = 5' VERT.
IRON = •

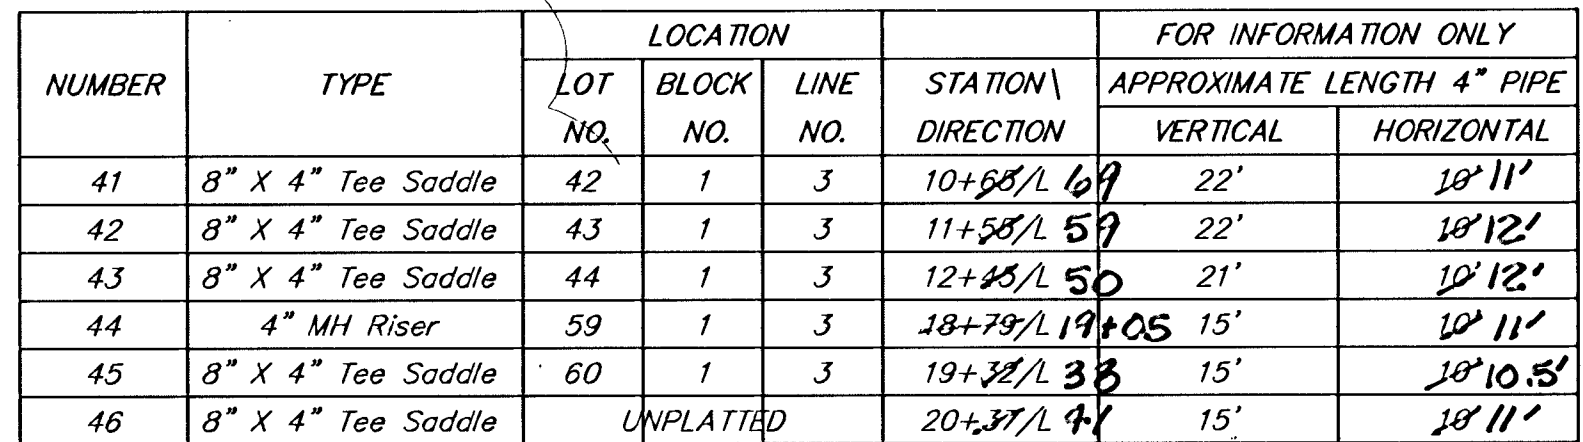