


Unplatted

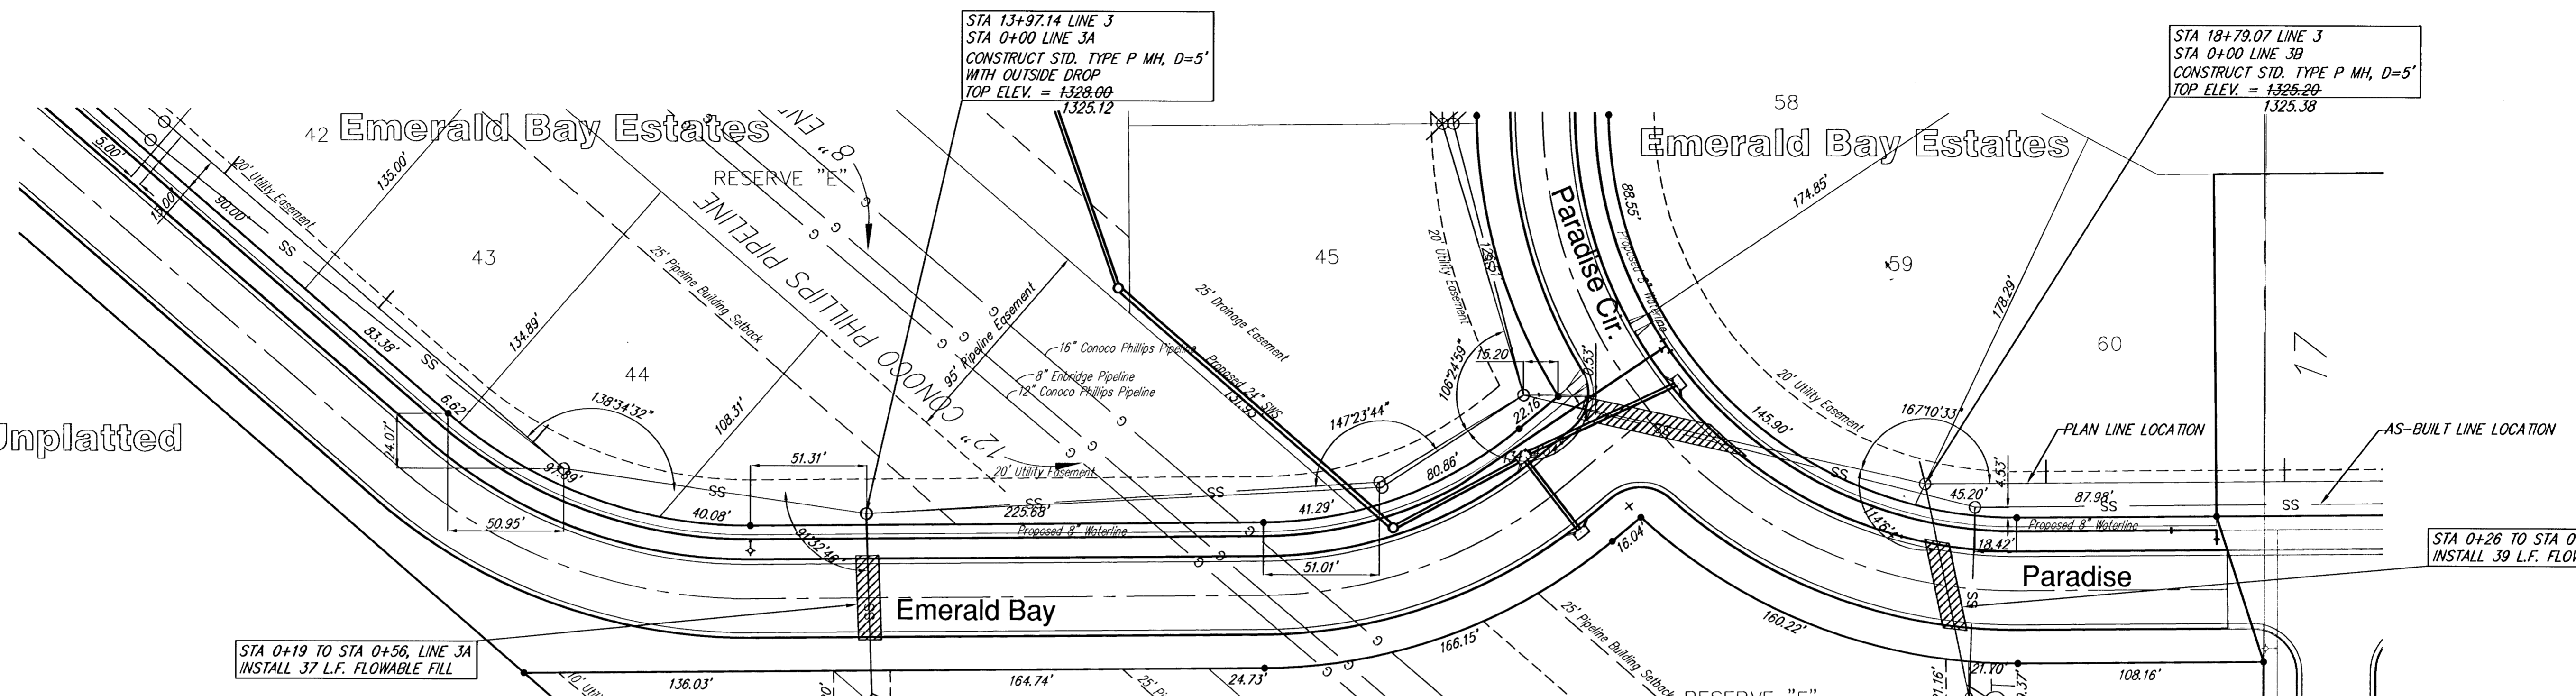

STA 0+19 TO STA 0+56, LINE 3A  
INSTALL 37 L.F. FLOWABLE FILL

SEWER SERVICE TABLE

NUMBER	TYPE	LOCATION			STATION	DIRECTION	APPROXIMATE LENGTH 4" PIPE	
		LOT NO.	BLOCK NO.	LINE NO.			VERTICAL	HORIZONTAL
47	8" X 4" Double Wye	1	2	3A	0+79/R	84	6'	10'
48	8" X 4" Double Wye	2	2	3A	0+28/L	84	6'	18' 9"
49	8" X 4" Wye	3	2	3A	0+98/L	88	2'	20' 11"

NOTE: Vertical Riser Pipe shall be extended to 2' minimum above ground water elevation and 4' maximum below proposed ground elevation.

STA 0+64.03 LINE 3A  
CONSTRUCT 8" CLEANOUT RISER  
W/ DOUBLE 4" WYE  
FL = 1306.80 (8")  
TOP C.O. = 1328.30

20'X25' SANITARY SEWER EASEMENT  
(BY SEPERATE INSTRUMENT)

NOTE: ALL BACKFILL FOR SHALL  
BE SAND FLUSHED AND VIBRATED.

STA 0+94.92 LINE 3B  
CONSTRUCT 8" CLEANOUT RISER  
W/ DOUBLE 4" WYE  
FL = 1308.54 (8")  
TOP C.O. = 1325.30

"AS-BUILT"  
3-15-07  
AML

SCALE 1" = 40' HORIZ.  
1" = 5' VERT.  
IRON = ●

