
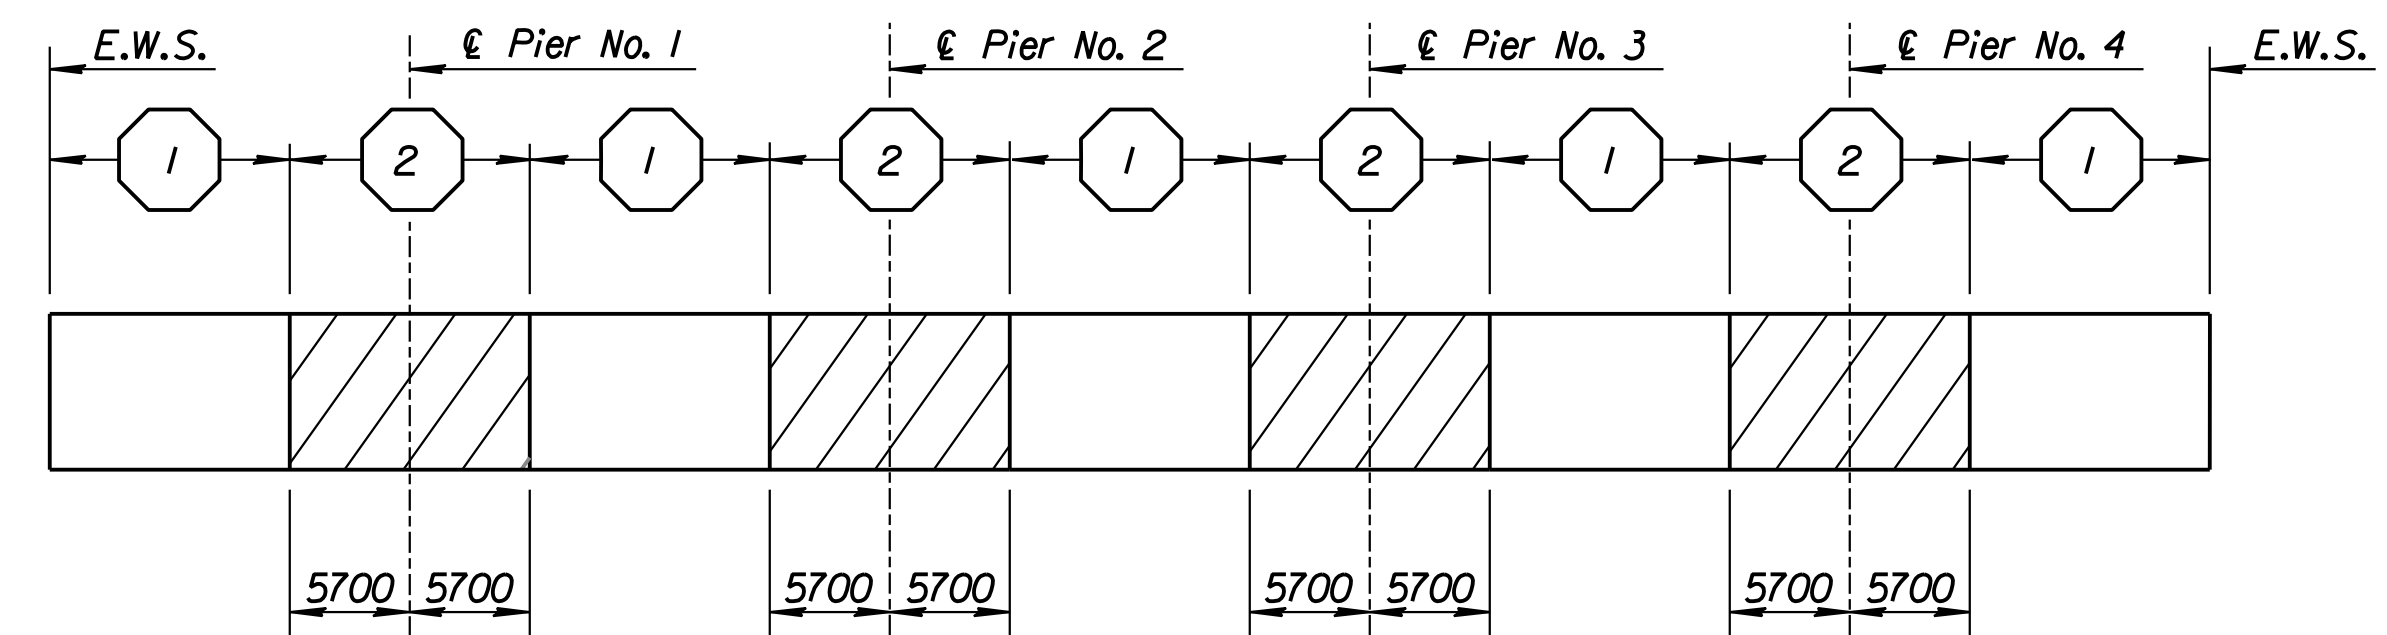


STATE	PROJECT NO.	YEAR	SHEET NO.	TOTAL SHEETS
KANSAS	54-87 K-6657-01	2002	551	1122

106 052 E.W.S. to E.W.S. (measured along left edge of slab)

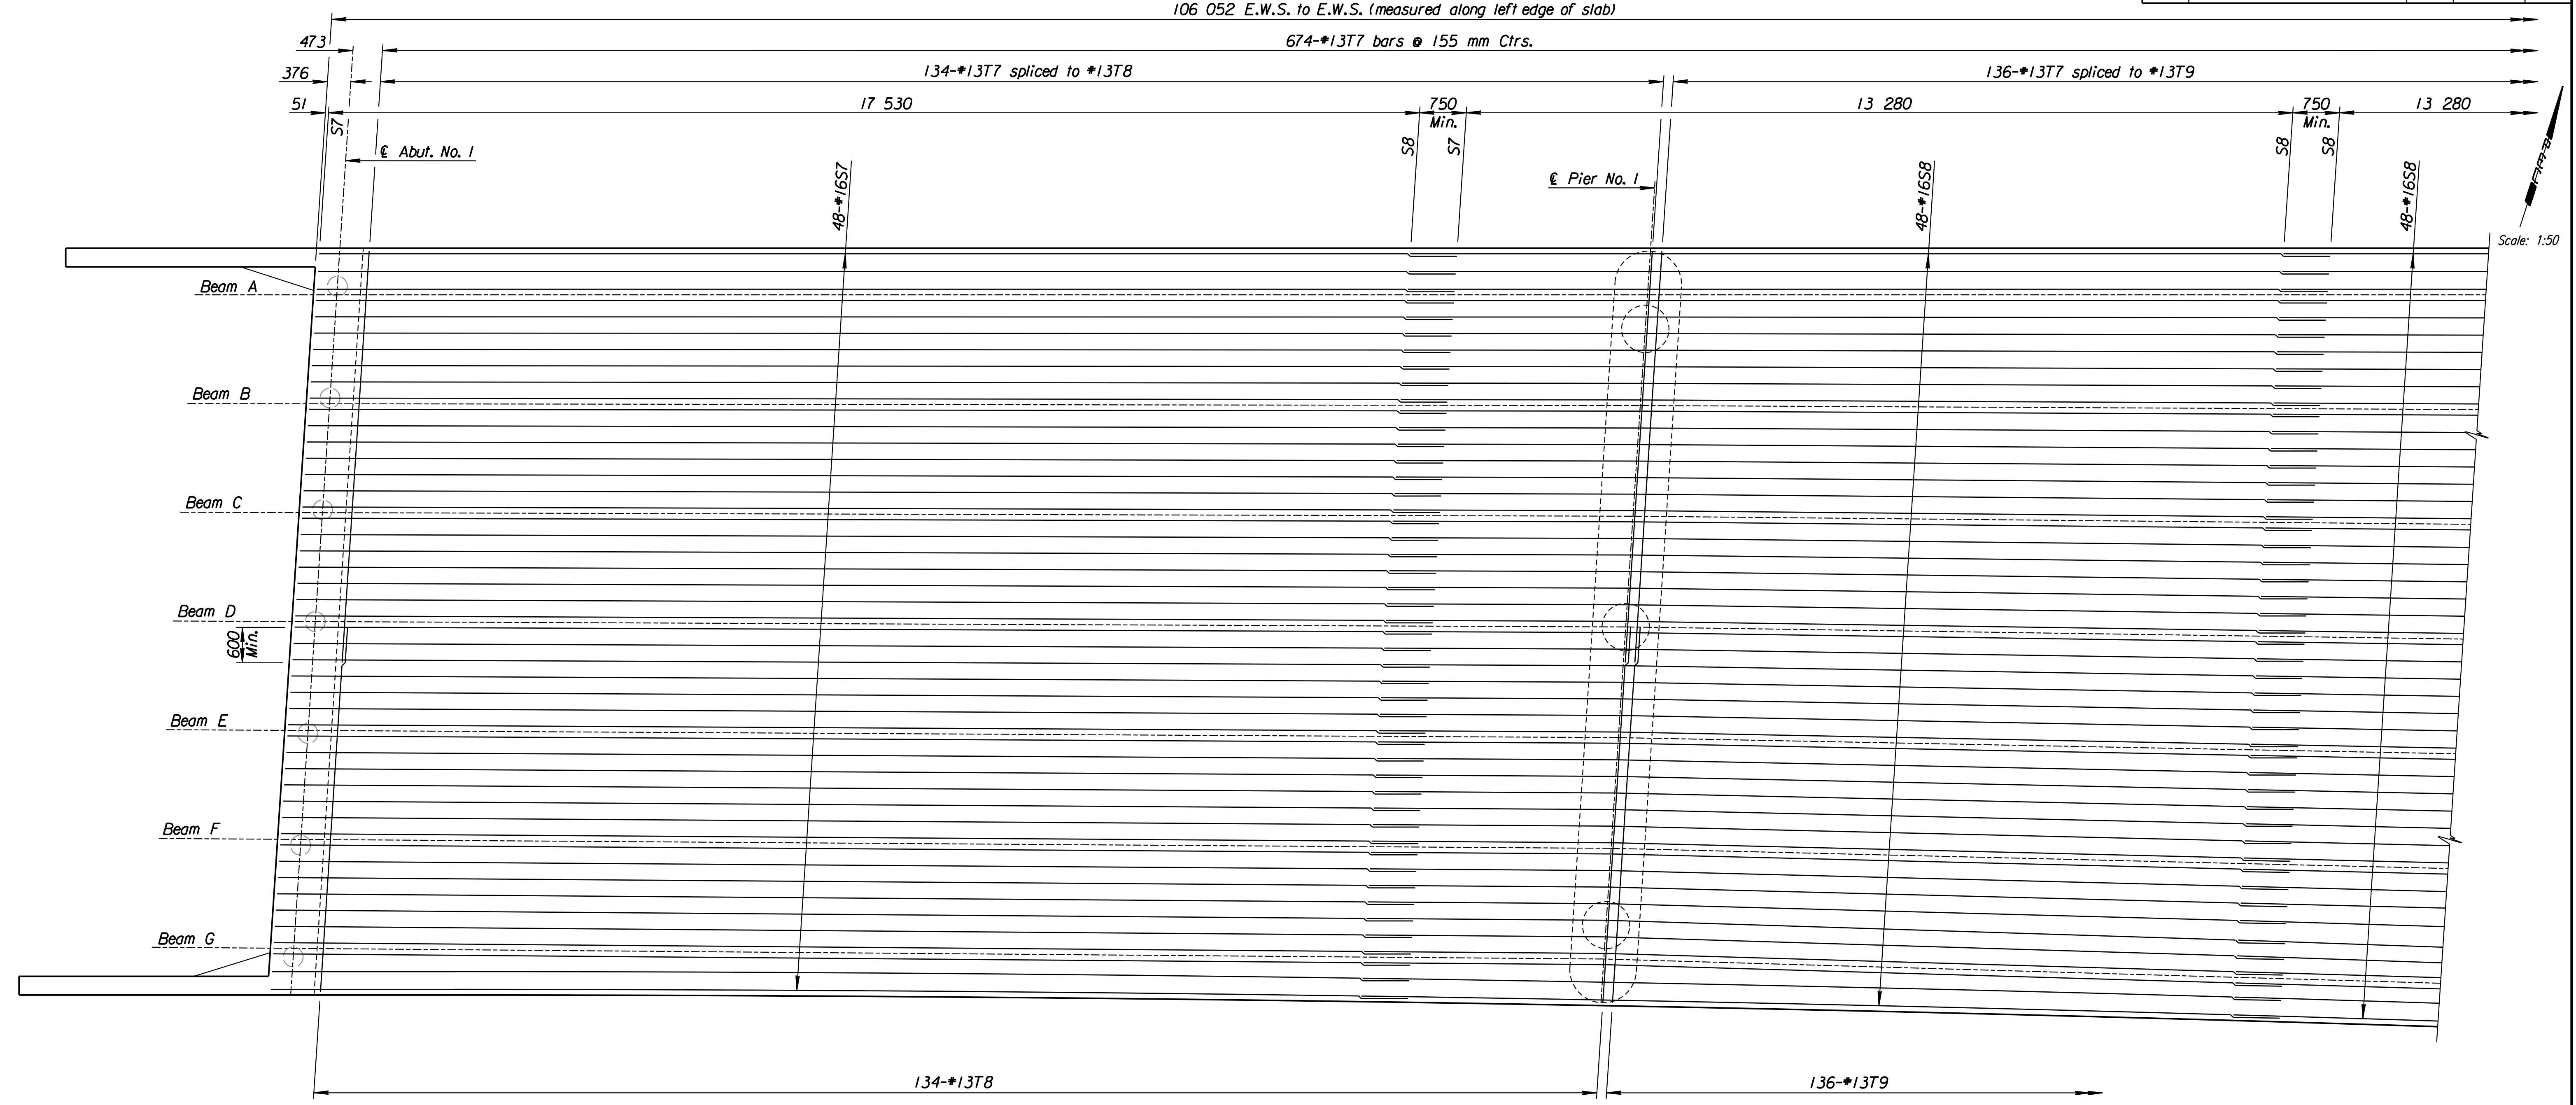

CONCRETE PLACING SEQUENCE

Note:
T7 thru T12 bars to be placed parallel to € of Abutments and Piers.

See Superstructure Bottom of Slab Sheet No. 2 for continuation.
See Typical Bridge Section for additional information.

RECORD DRAWING

1			
No.	Revisions	By	Date
CITY OF WICHITA BR. NO. 54-87-19.29 (492) F.E.B. STA. 16+005.740 SUPERSTRUCTURE BOTTOM OF SLAB-SHEET NO. 1 E.B. FRT. RD. OVER COWSKIN CREEK SEDGWICK COUNTY			
Professional Engineering Consultants, P.A. 303 S. TOPEKA • WICHITA, KANSAS 67202 316-262-2691 • FAX 316-262-3003			
Designed by	RAS	Checked by	RAS
Drawn by	DRP	Date	April, 2002
		Job No.	97362

Dsnr: RAS Oper: gdr Scale: 1:50
 12/1997/97.362/As-Builts/dgns/Vol_3/Sh 551-suptbl.dgn Last Rev: 9-5-07 By: gdr