


FHWA REGION NO.	STATE	PROJECT NO.	YEAR	SHEET NO.	TOTAL SHEETS
7	KANSAS	54-87 K-6657-01	2002	895	1122

DATE	
BY	
REFERENCES NOTED	
REFERENCES CHECKED	

image : DRWMP2.HMR image border level 62
 Plot driver: /i:/msse/plotting/metric/descartes/755solim.plt (Contrast/Brightness 58)
 Scale: 1:6000
 /i:/1997/97362/As-Builts/dgn/s/Val 4/Sh 895-drainage map.dgn Last Rev: 10-8-07 By: gdr

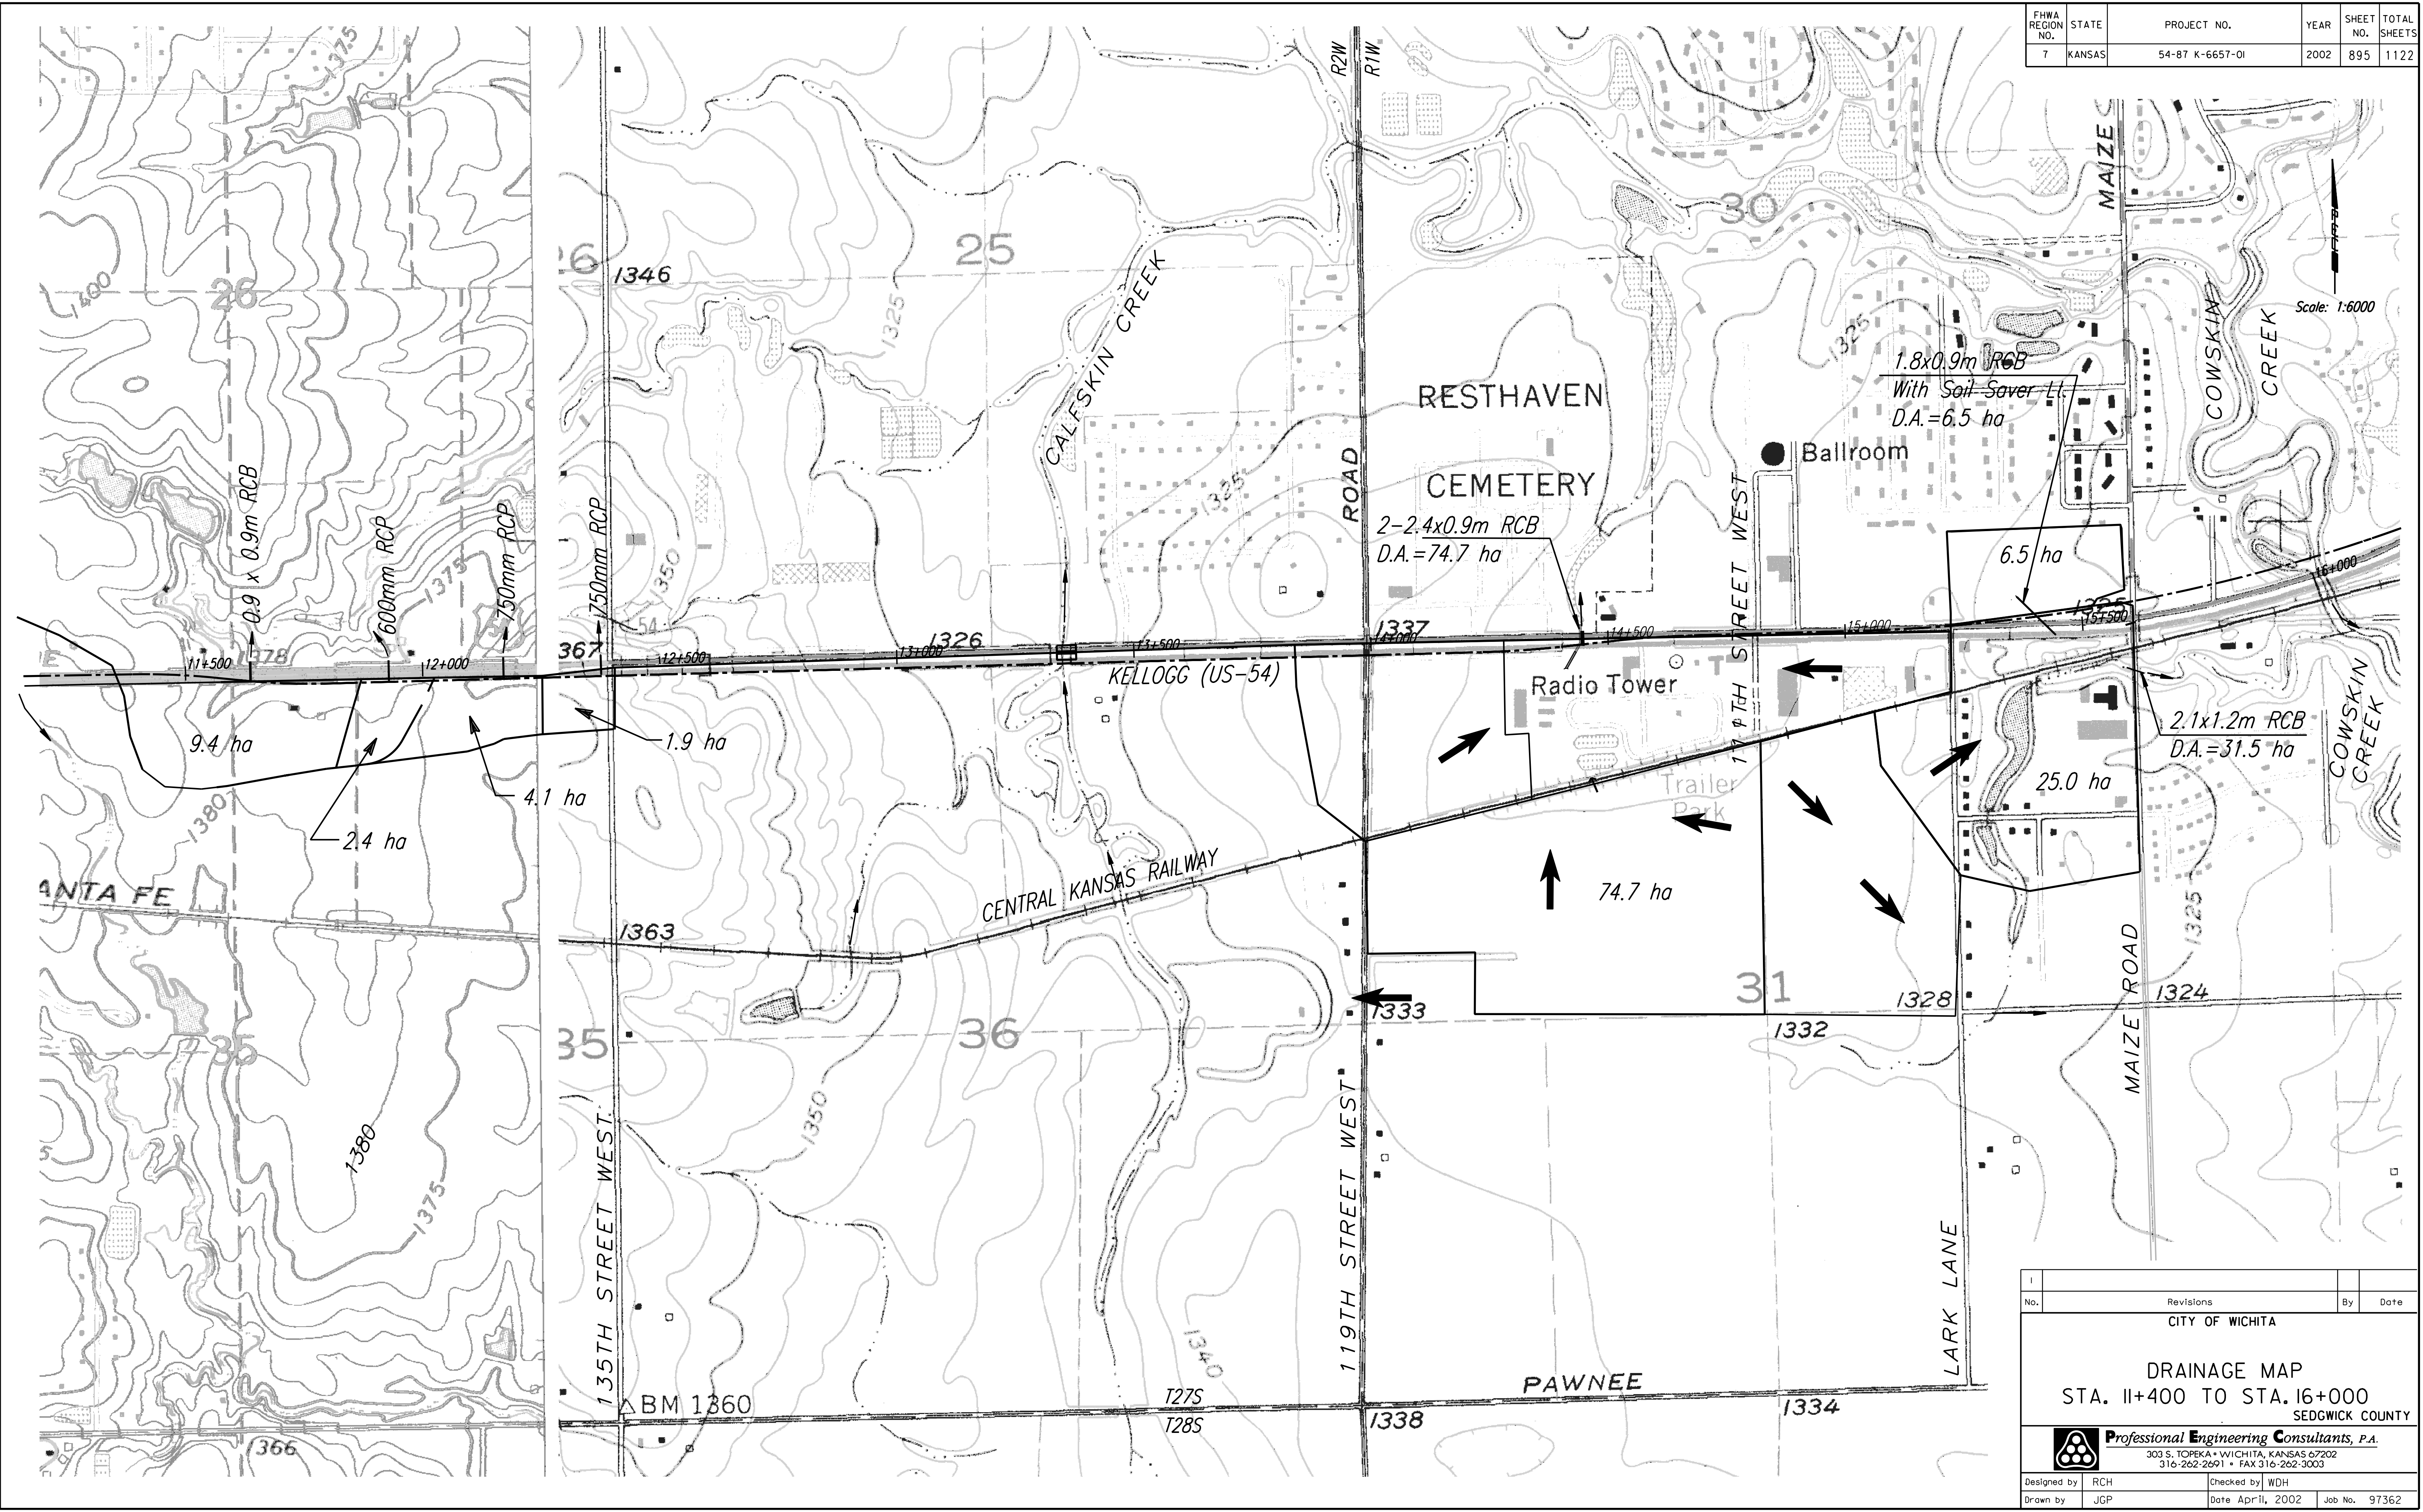

Scale: 1:6000

Revisions			
No.		By	Date
CITY OF WICHITA			
DRAINAGE MAP			
STA. 11+400 TO STA. 16+000			
SEDGWICK COUNTY			
Professional Engineering Consultants, P.A. 303 S. TOPEKA • WICHITA, KANSAS 67202 316-262-2691 • FAX 316-262-3003			
Designed by	RCH	Checked by	WDH
Drawn by	JGP	Date	April, 2002
		Job No.	97362