


FHWA REGION NO.	STATE	PROJECT NO.	YEAR	SHEET NO.	TOTAL SHEETS
7	KANSAS	54-87 K-6657-01	2002	682	1122

DATE	BY
REFERENCES NOTED	REFERENCES CHECKED

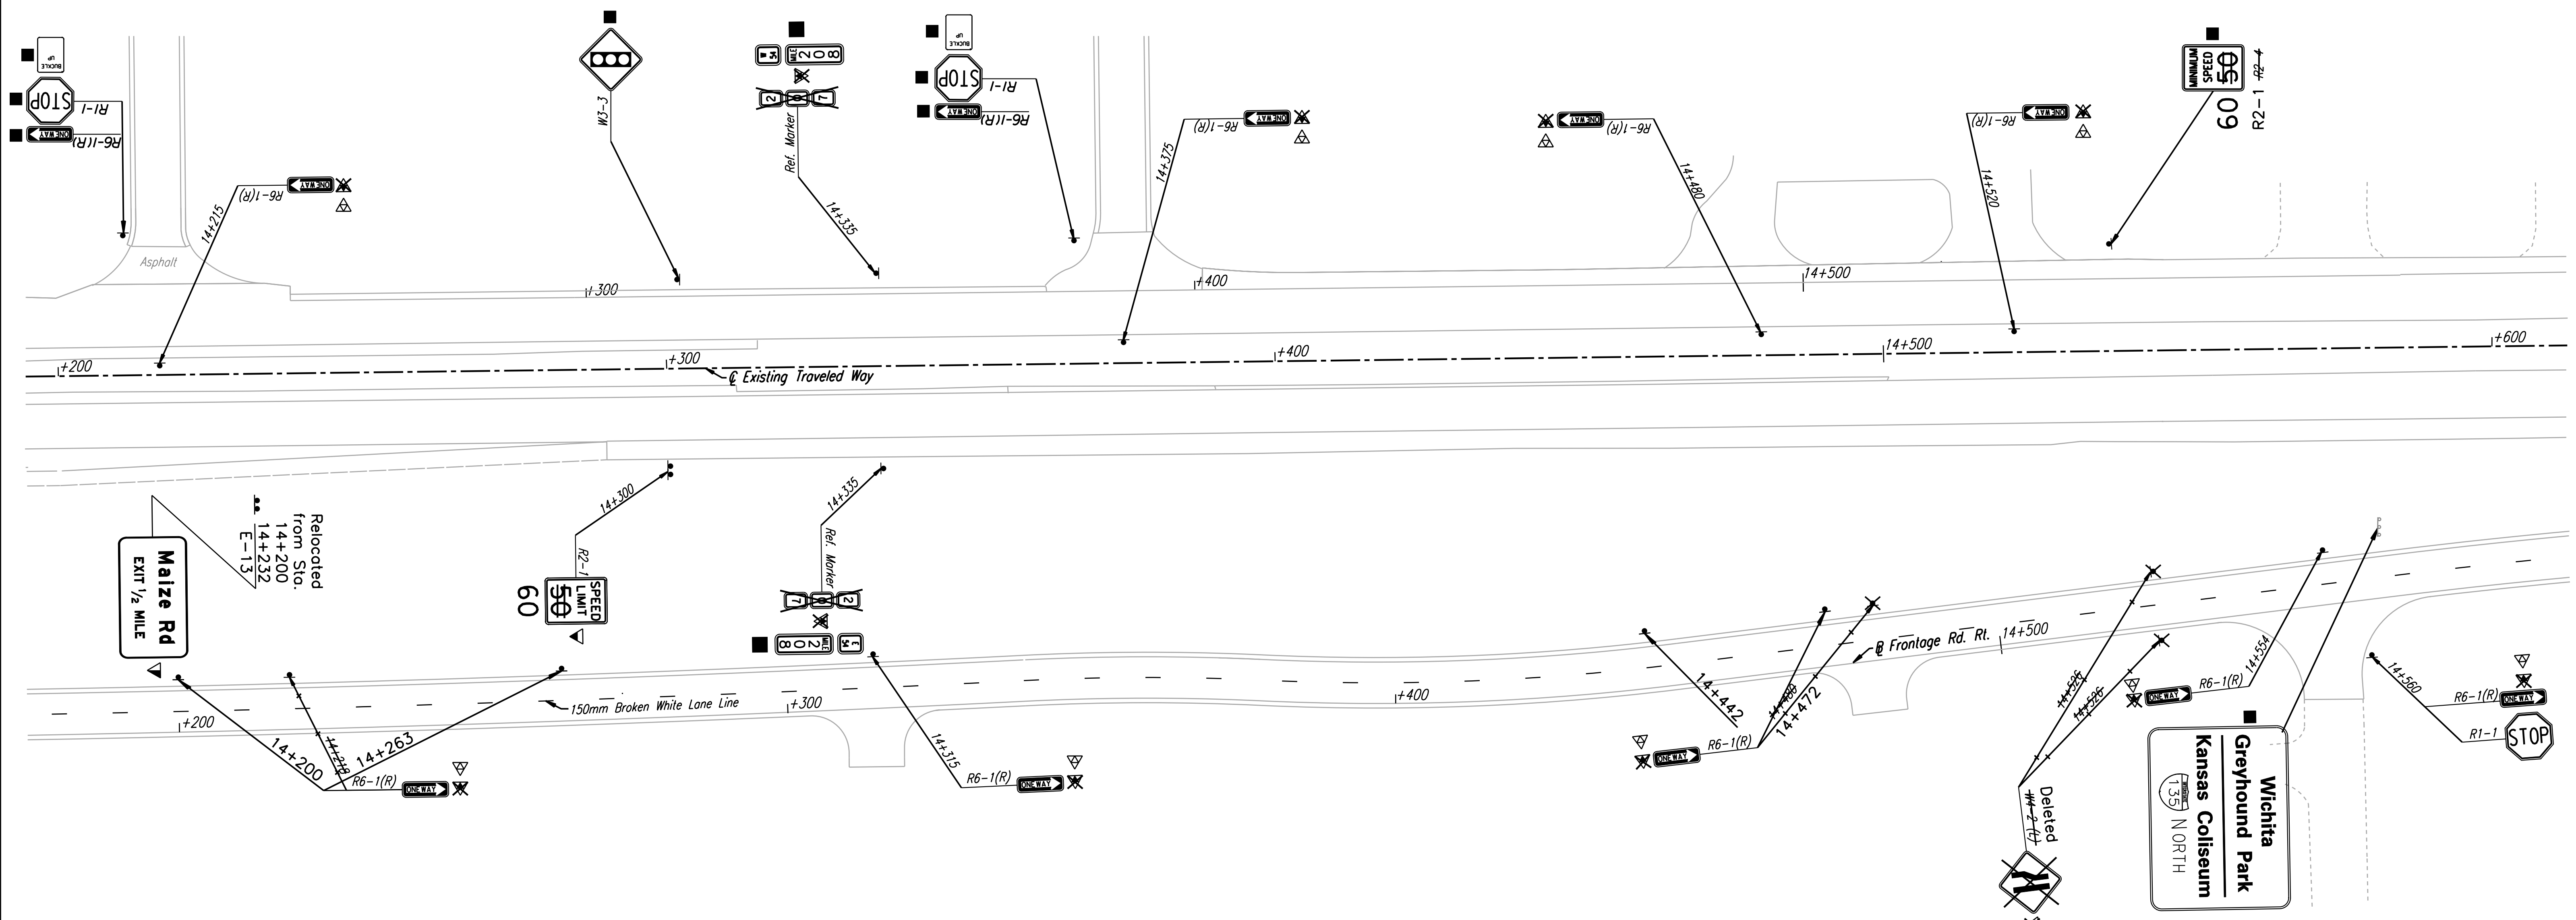

DSNR: WDH OPER: JGP SCALE: 1:500  
 I:/1997/97362/As-Builts/dgn's/Vol. 4/Sh 682-pl142.dgn Last Rev: 9-21-07 By: gdr

**RECORD DRAWING**

No.	Revisions	By	Date

CITY OF WICHITA

**SIGNING & MARKING PLAN**  
Sta. 14+200 TO Sta. 14+600

SEDGWICK COUNTY

**Professional Engineering Consultants, P.A.**  
 303 S. TOPEKA • WICHITA, KANSAS 67202  
 316-262-2691 • FAX 316-262-3003

Designed by	RPG	Checked by	WDH
Drawn by	SVB	Date	April, 2002
		Job No.	97362