


FHWA REGION NO.	STATE	PROJECT NO.	YEAR	SHEET NO.	TOTAL SHEETS
7	KANSAS	54-87 K-6657-01	2002	687	1122

BY	DATE
REFERENCES NOTED	
REFERENCES CHECKED	

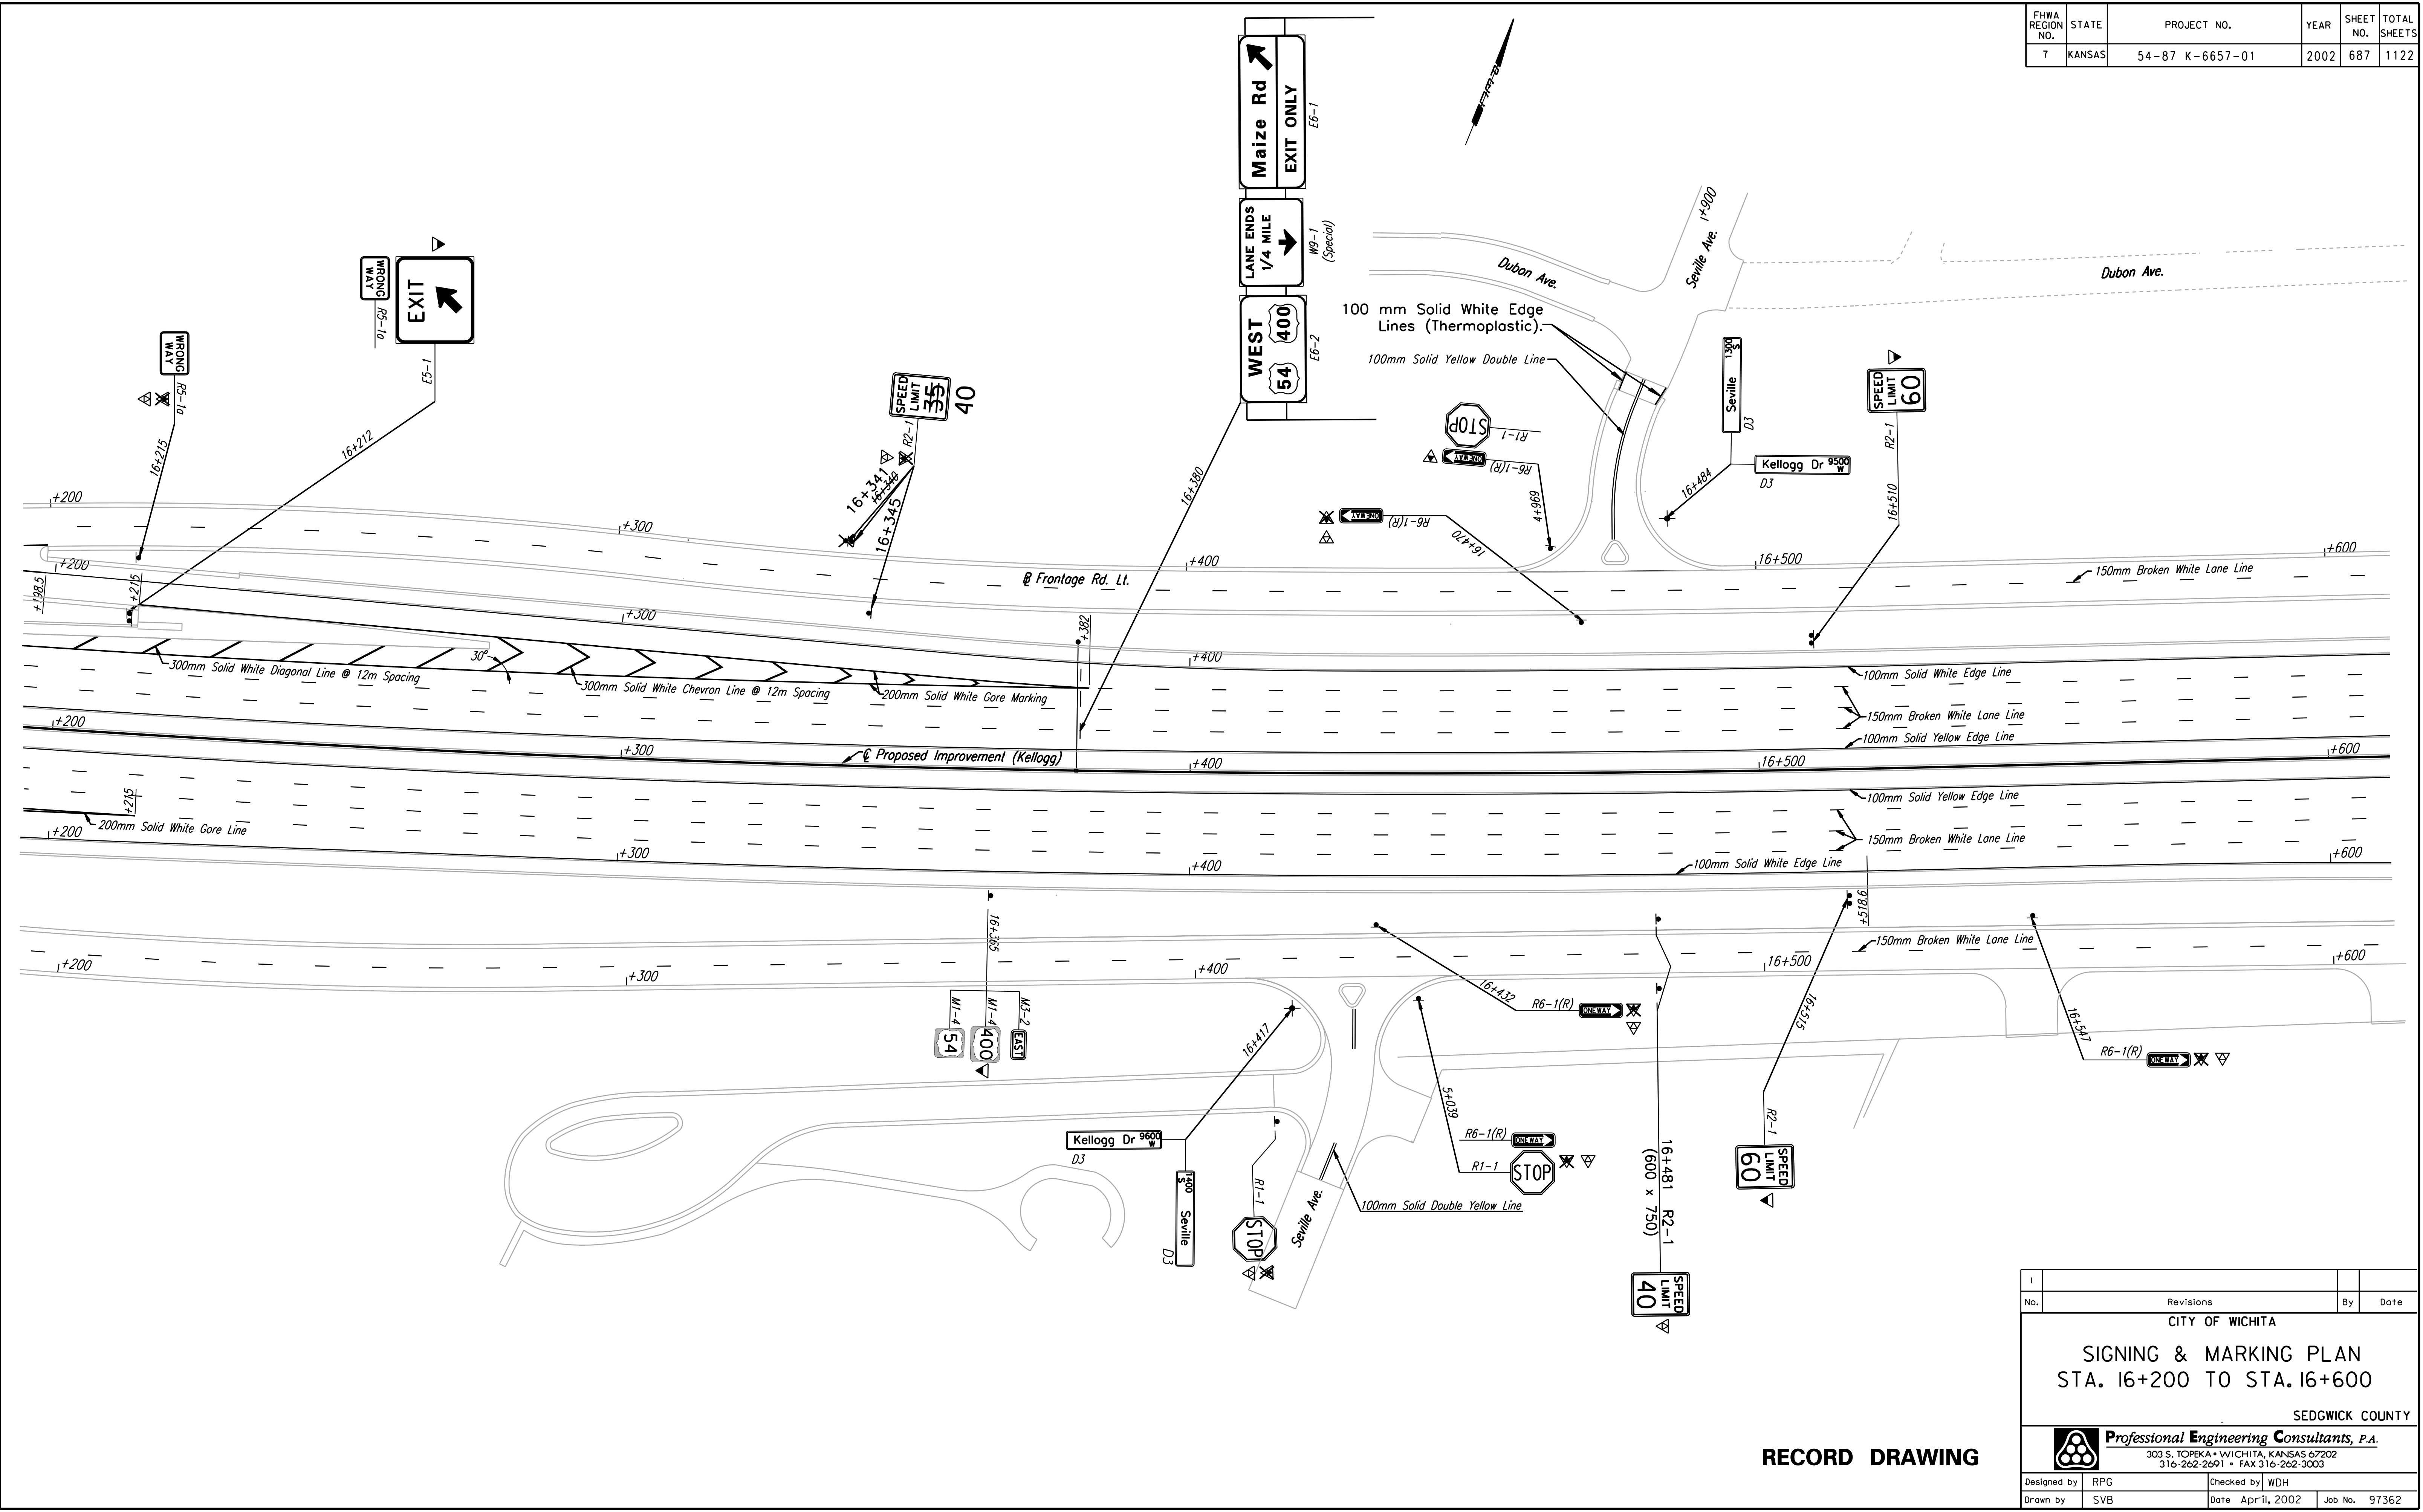

DSNR: WDH OPER: JGP SCALE: 1:500
 12/1997/97362/As-Builts/dgn/s/Vol_4/Sh 687-pl162.dgn Last Rev: 10-1-07 By: gdr

RECORD DRAWING

No.	Revisions	By	Date
CITY OF WICHITA SIGNING & MARKING PLAN STA. 16+200 TO STA. 16+600 SEDGWICK COUNTY			
Professional Engineering Consultants, P.A. <small>303 S. TOPEKA • WICHITA, KANSAS 67202 316-262-2691 • FAX 316-262-3003</small>			
Designed by	RPG	Checked by	WDH
Drawn by	SVB	Date	April, 2002 Job No. 97362