


FHWA REG NO.	STATE	PROJECT NO.	YEAR	SHEET NO.	TOTAL SHEETS
7	KANSAS	54-87 K-6657-01	2002	1083	1122
32		36		40	

DATE	
BY	
SURVEYED	
PLOTTED	
TEMPLATE	
AREAS	
CHECKED	
FINAL SURVEY NOTE BOOK NO.	

DSNR: RCH OPER: SVB SCALE: 1:100  
 I:/1997/07362/As-Built/sgn's/vol.5/5h\_1083-Tyler-X54660.dgn

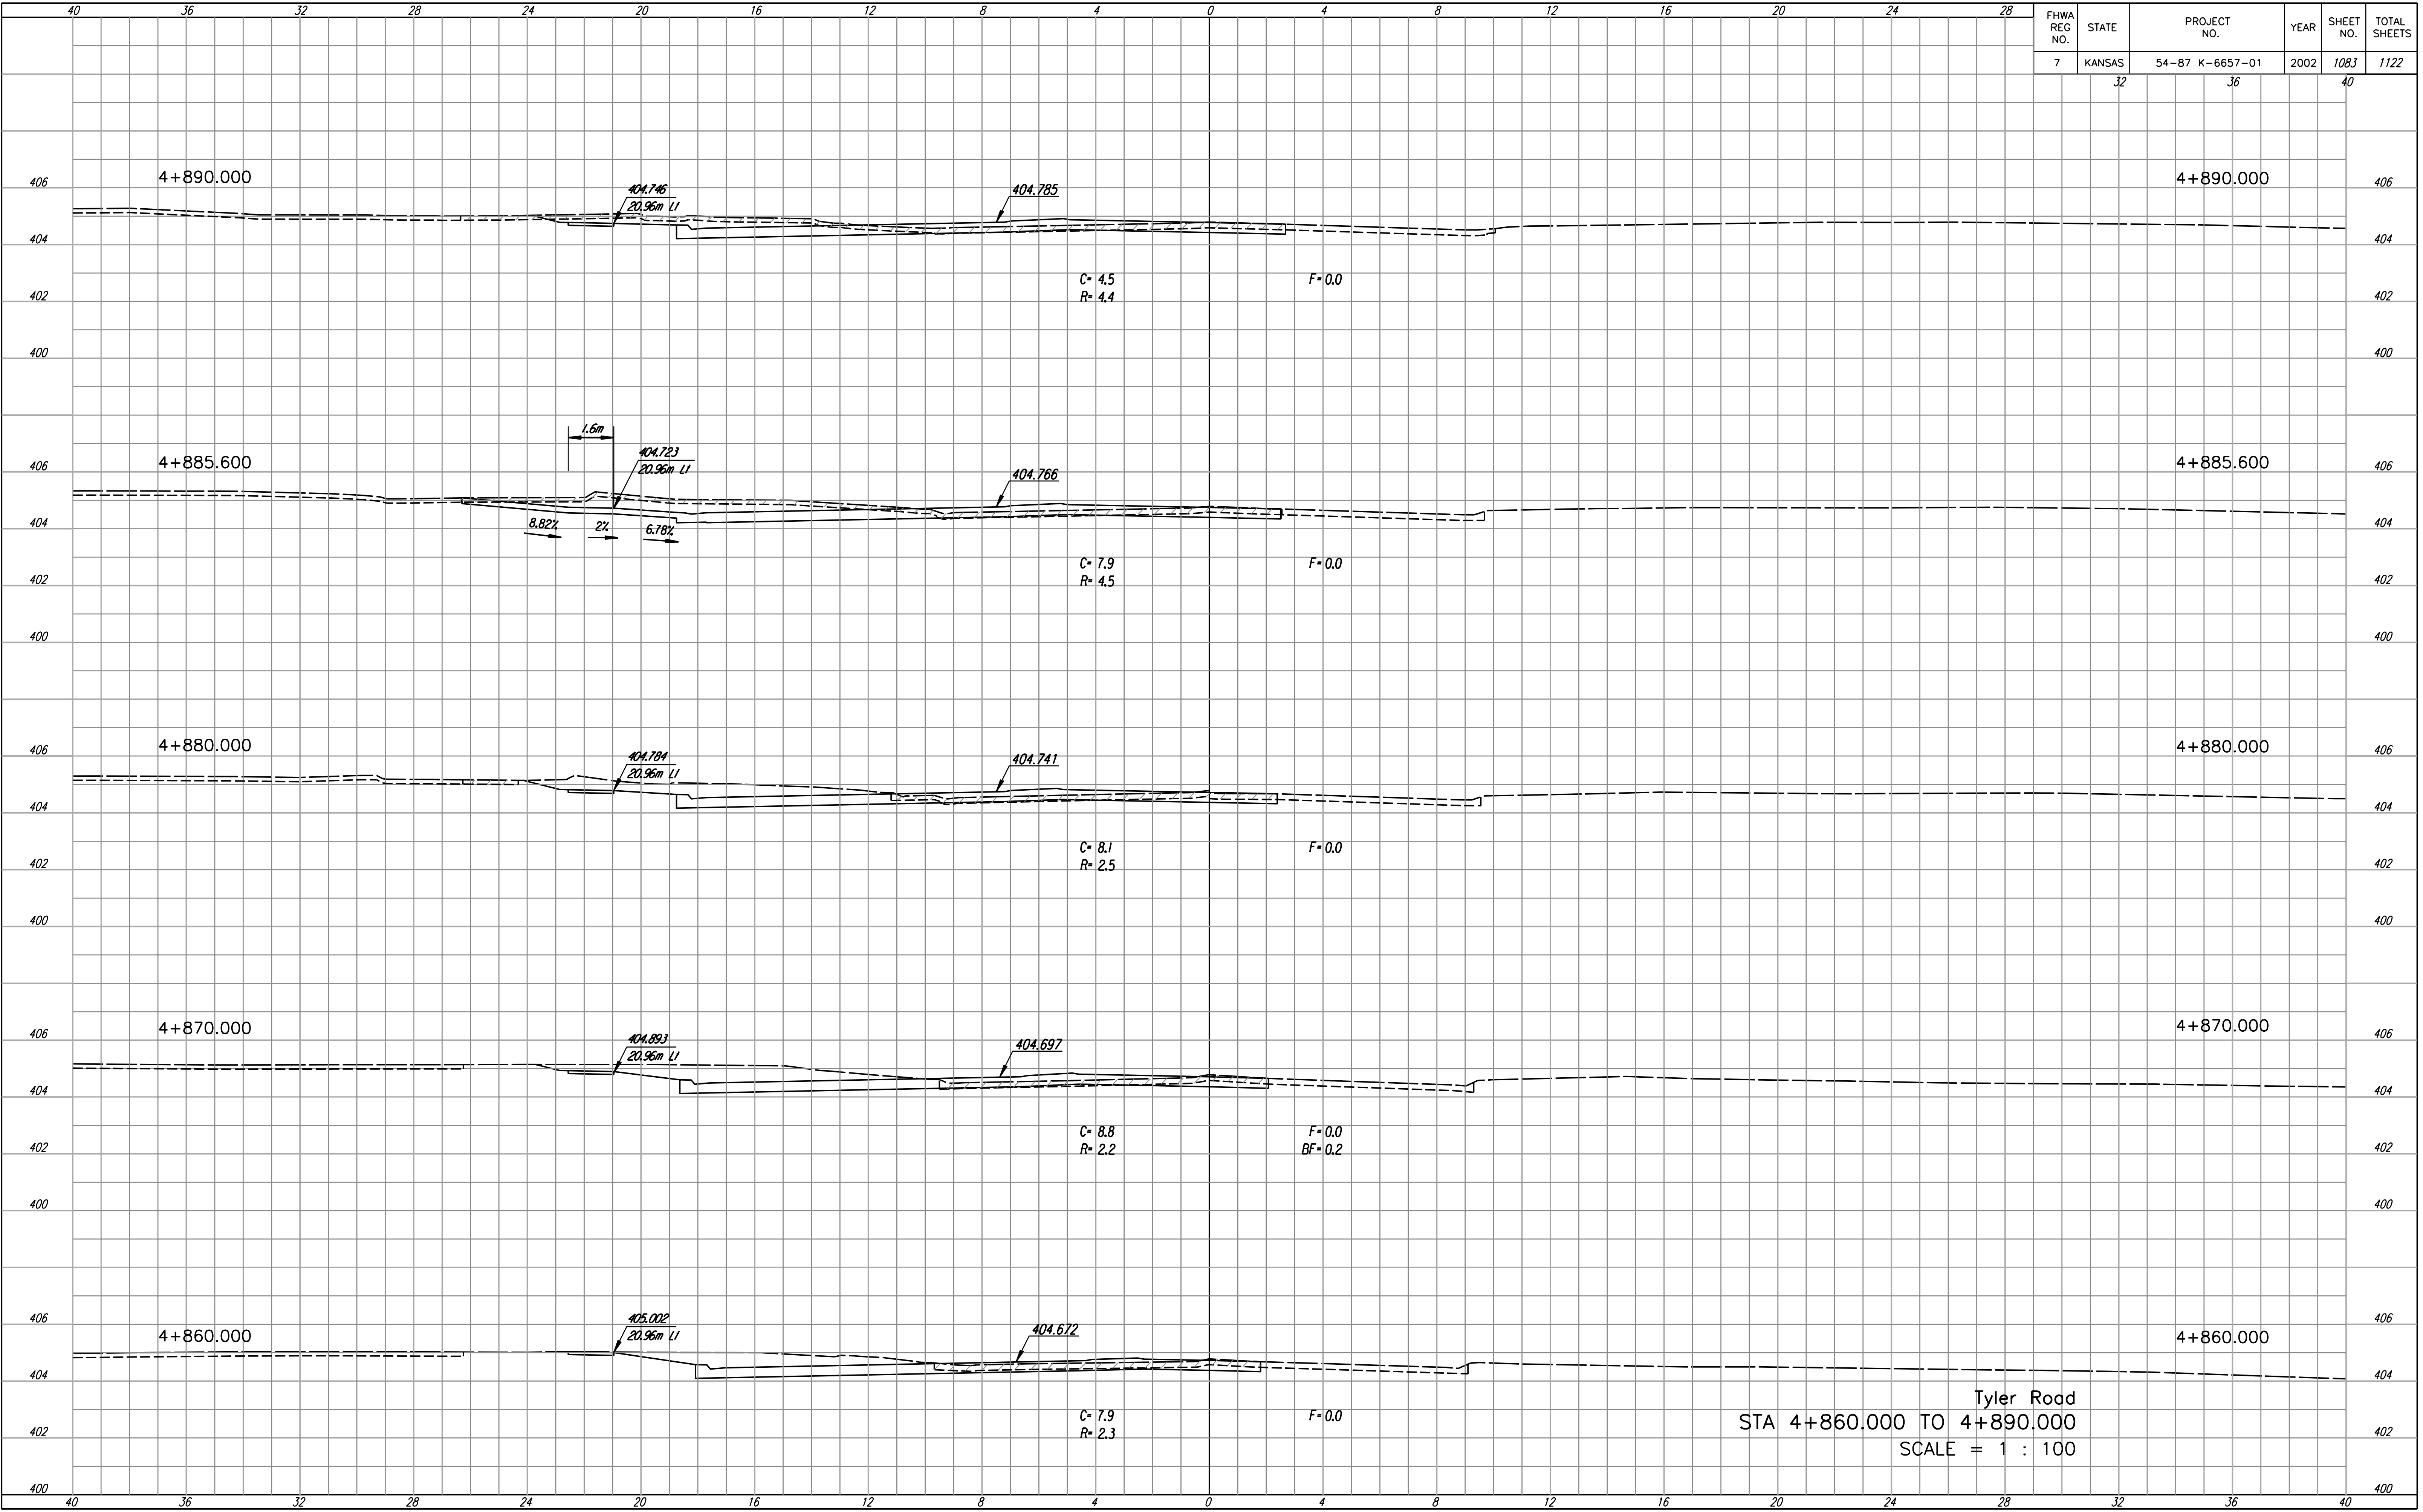

Tyler Road  
 STA 4+860.000 TO 4+890.000  
 SCALE = 1 : 100