


**SANITARY SEWER PLANS FOR
WATERFRONT FOURTH ADDITION**


LINE 1 & LINE 2
SHEET TITLE
PROJECT NUMBER
04026
DESIGN BY
SRS
DRAWN BY
SKF
CHECKED BY
DFL
ISSUED
AUGUST 2007
REVISED
SHEET NO.
4 of 11

WATERFRONT FOURTH ADDITION

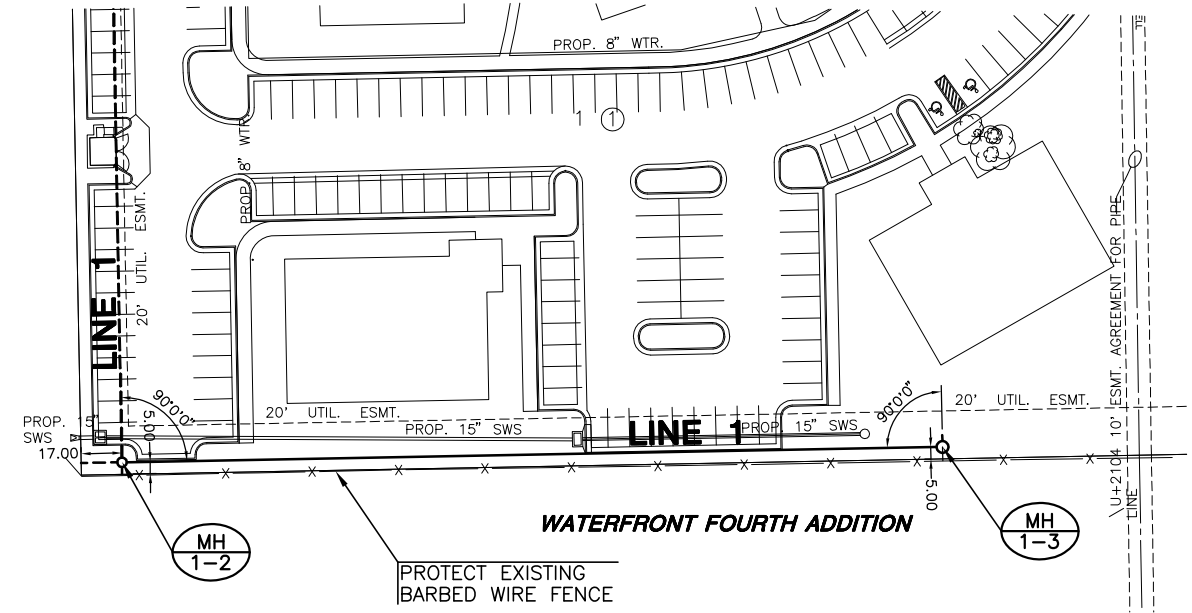


PLAN LINE 1

PROFILE LINE 1

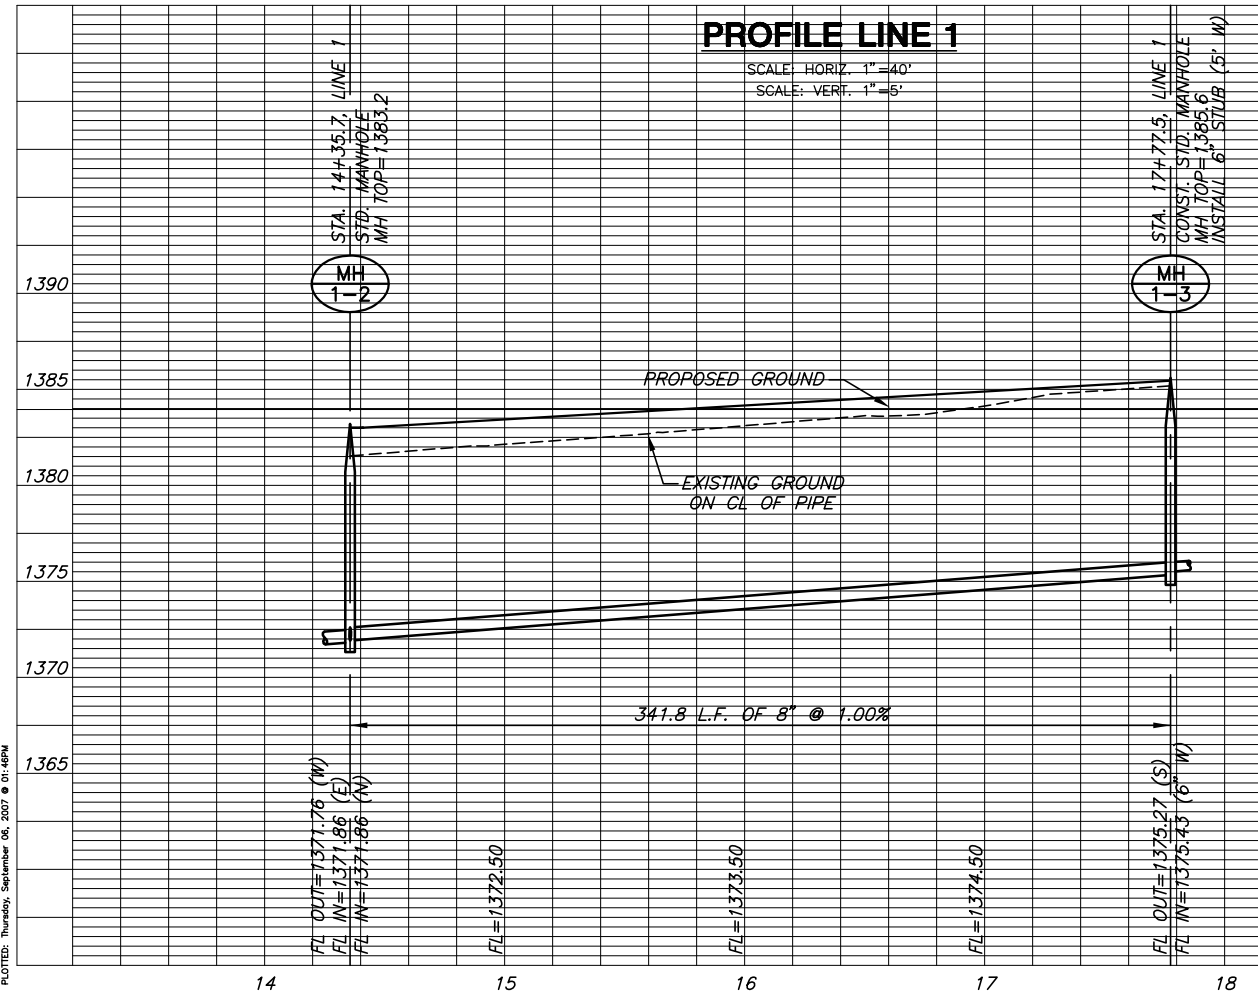


WATERFRONT FOURTH ADDITION

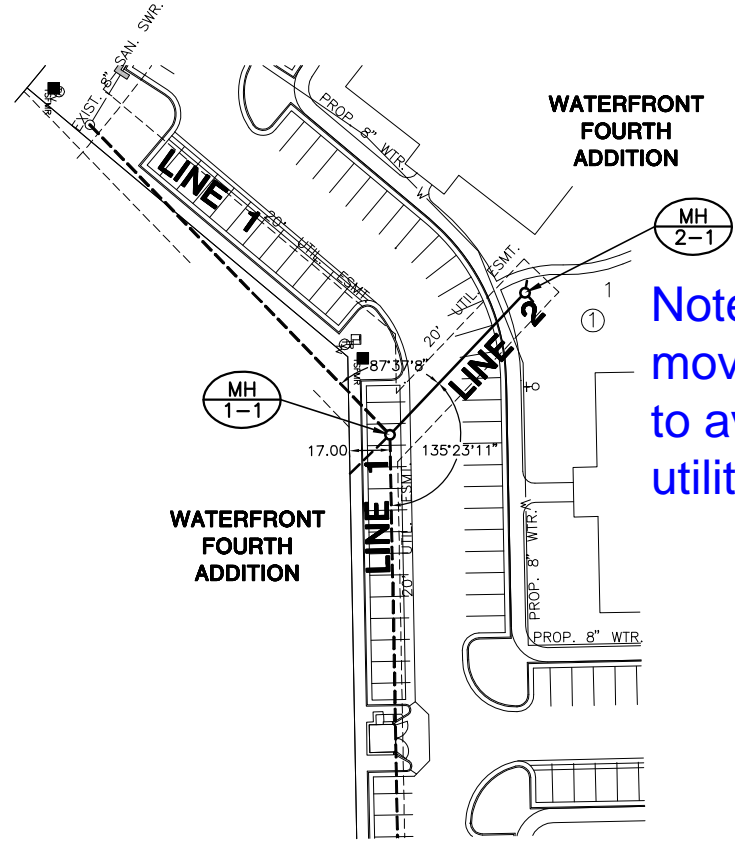


PLAN LINE 2

PROFILE LINE 2

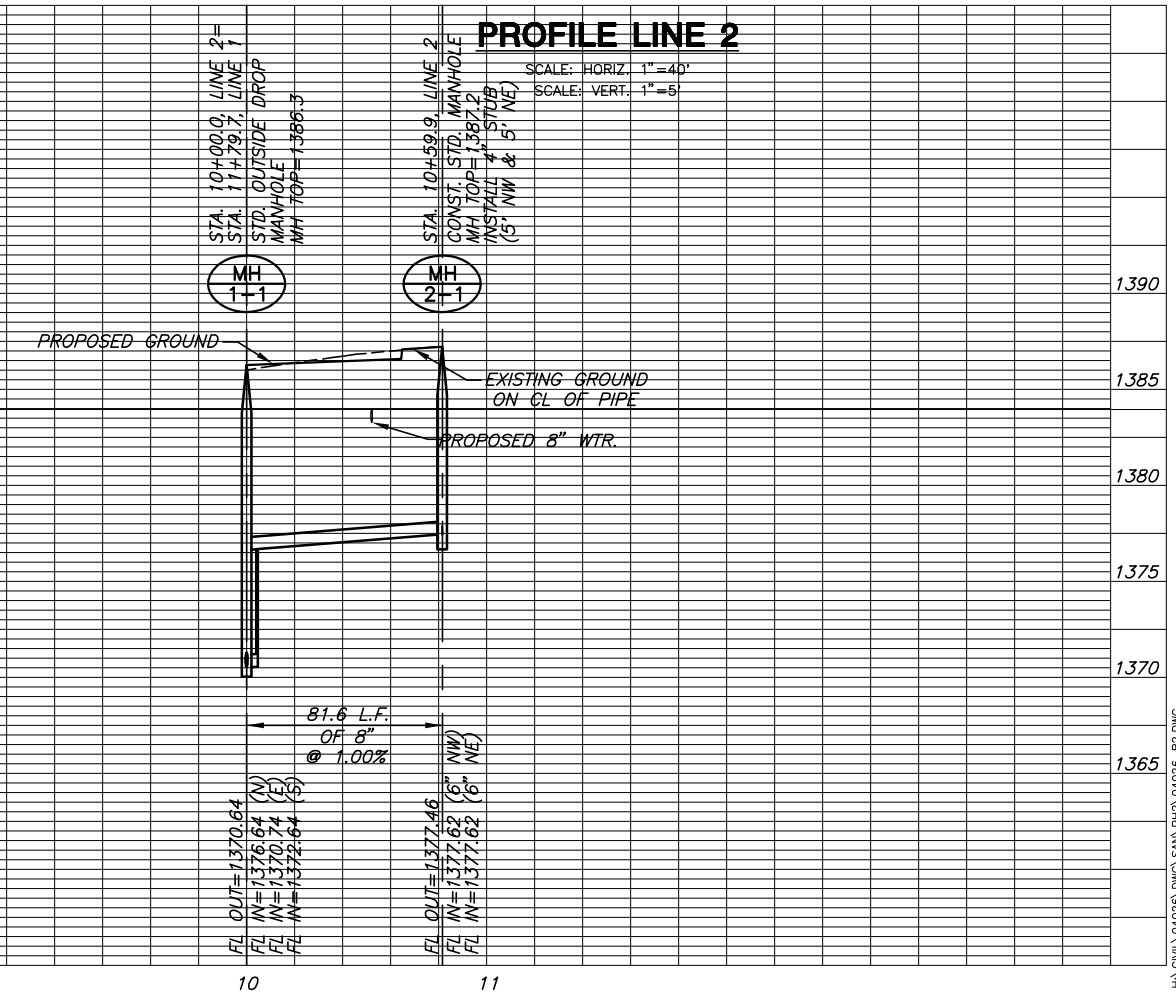

Note: MH 2-1 was moved 6" to the east to avoid underground utilities.

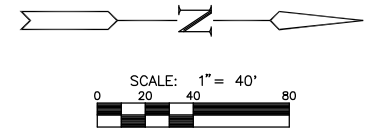

PLOTED: Thursday, September 06, 2007 9:01:48AM

H:\CIVIL\04026\DWG\SAN\PH2\04026_B2.DWG