


LATERAL 5, MAIN 16 OF THE FOUR MILE CREEK SEWER IN THE CITY OF WICHITA, KANSAS

OCA NO. 744167

CITY OF WICHITA PROJECT NO. 468-84044

JAMES L. ARMOUR, P.E. - CITY ENGINEER

McCullough Excavation, Inc. - Contractor
Strothman, City - Inspector
Released 8/25/07
As-Built
Risers & Stubs
.pdf by JDL 11/19/07

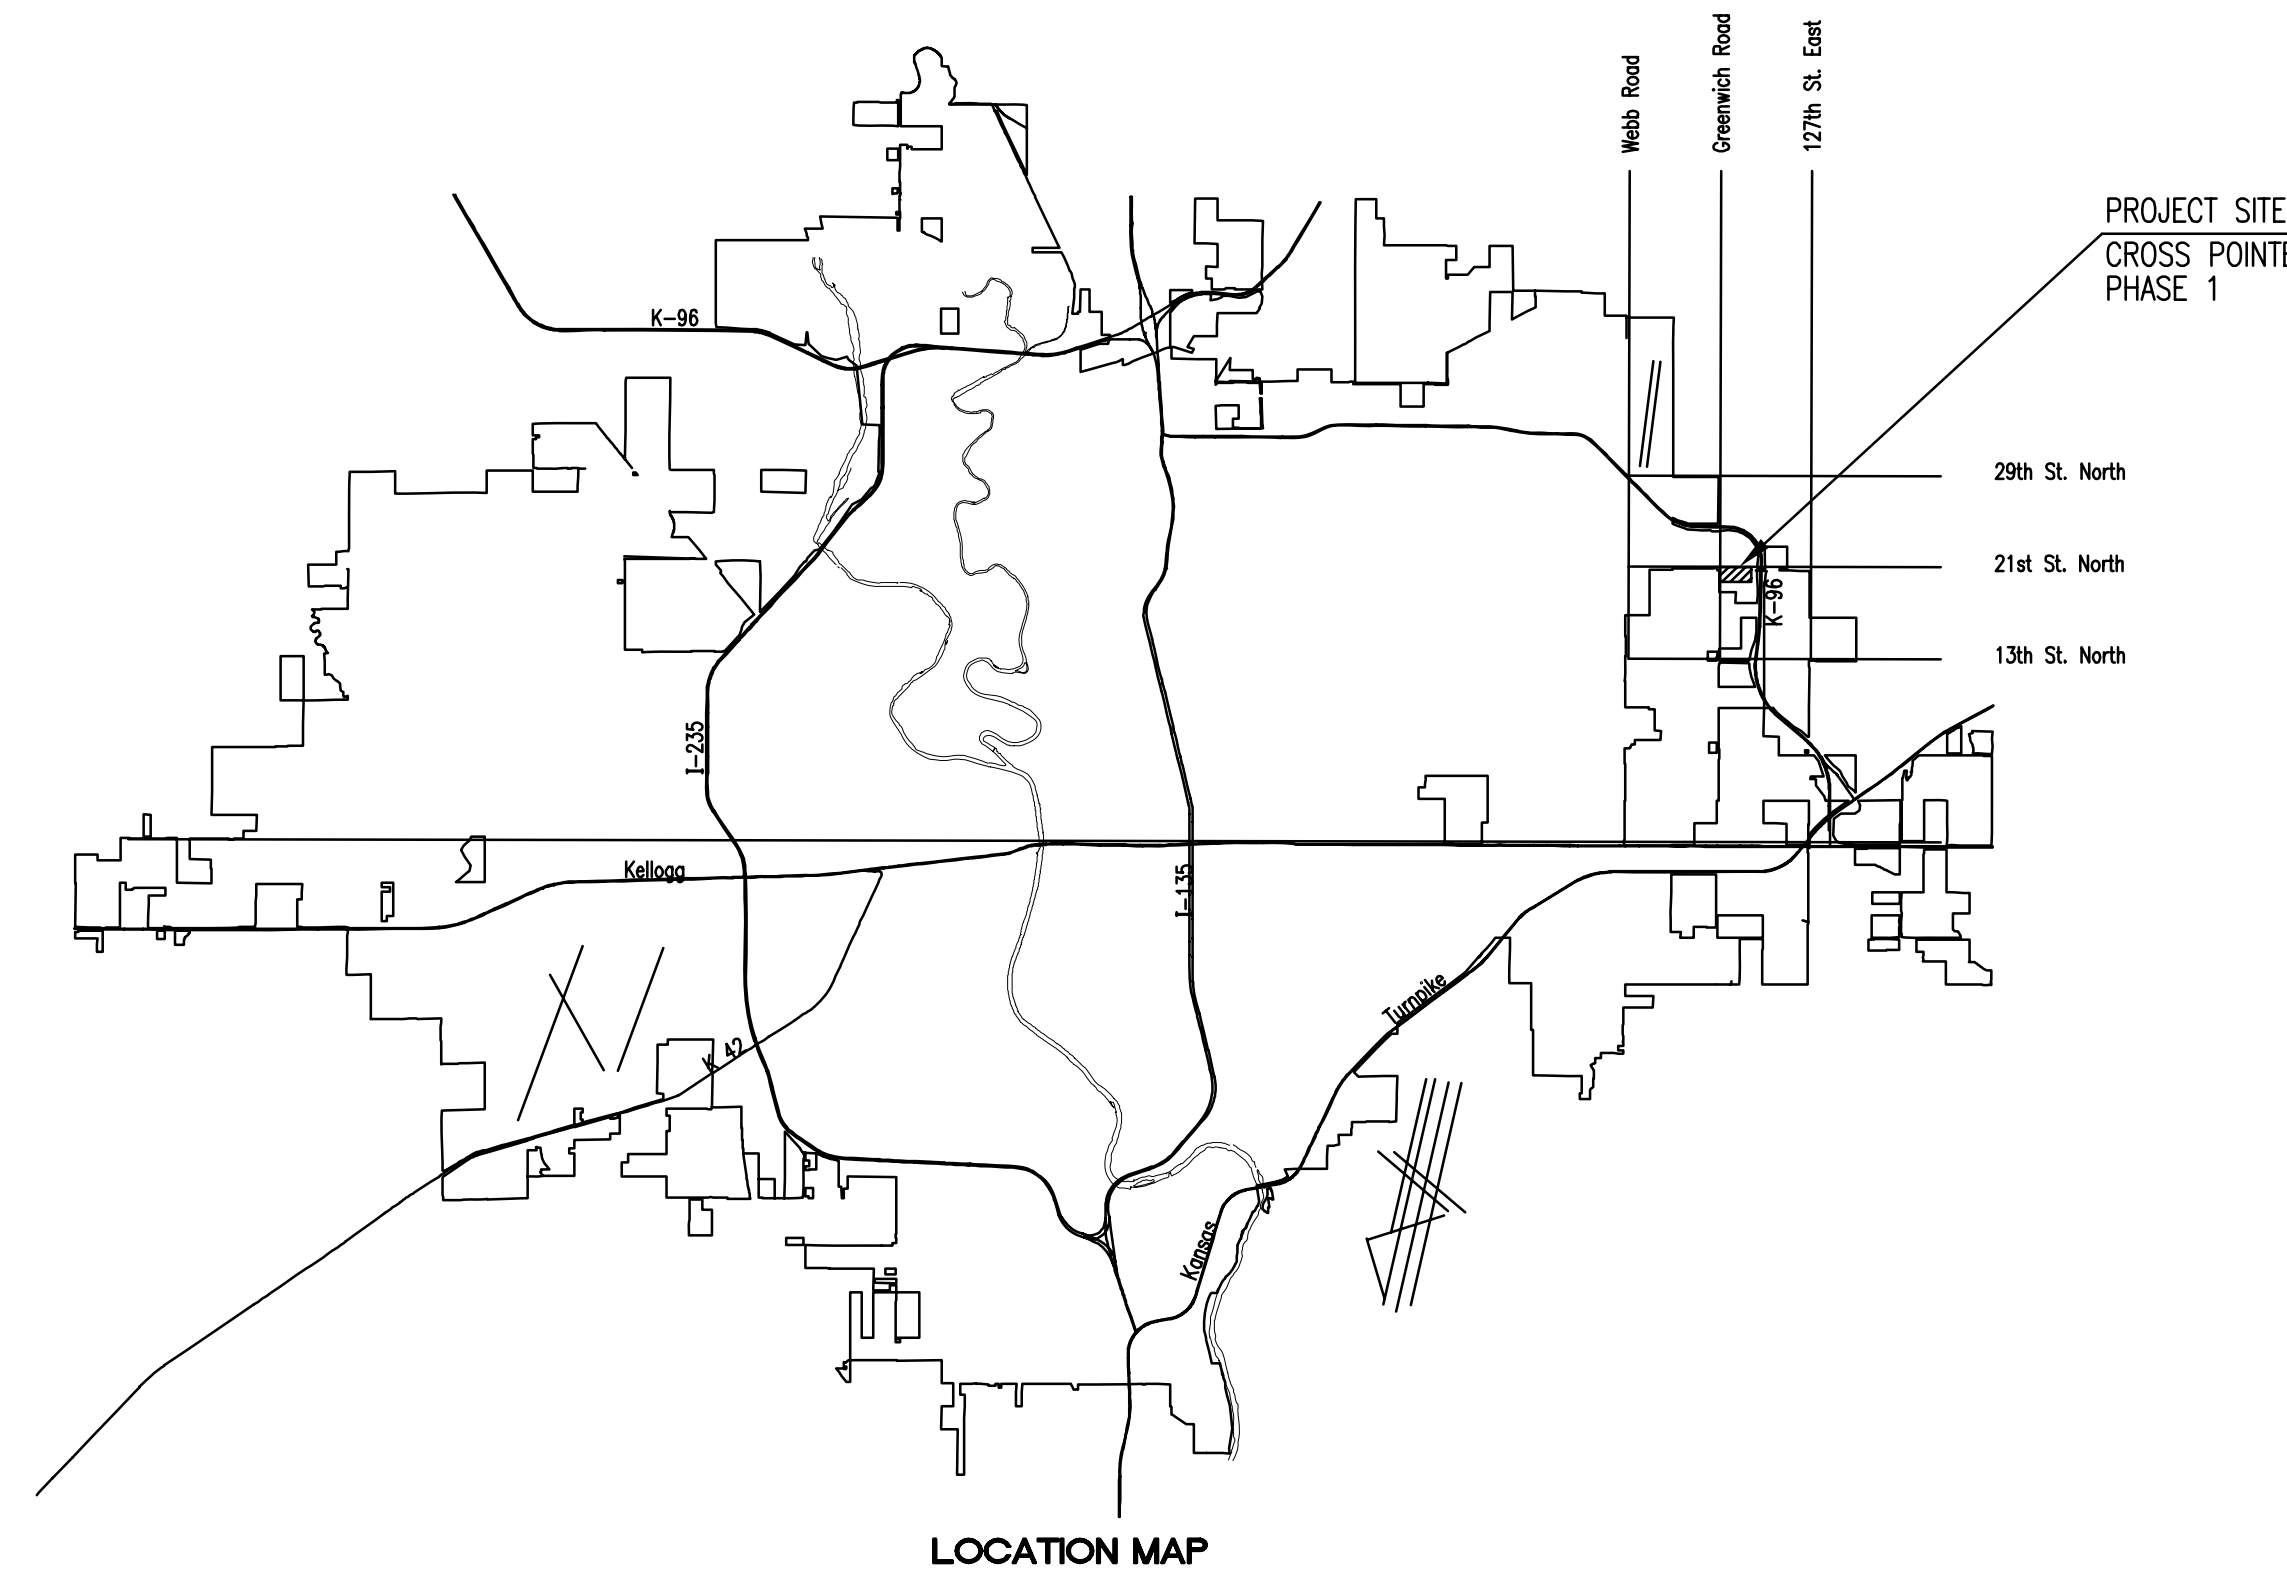

INDEX OF SHEETS

SHEET NO. 1	TITLE SHEET
SHEET NO. 2	KEY MAP AND GENERAL NOTES
SHEET NO. 3	PLAT
SHEET NO. 4-6	PLAN/PROFILE
SHEET NO. 7	TYPE "P" MANHOLE DETAILS
SHEET NO. 8	FRAME & COVER DETAILS
SHEET NO. 9	RISER DETAILS
SHEET NO. 10-13	SOIL EROSION BMP DETAILS

CONSTRUCTION SEQUENCING

THIS PROJECT WILL BE CONSTRUCTED CONCURRENTLY WITH PAVING, STORM WATER DRAIN, AND WATER DISTRIBUTION SYSTEM IMPROVEMENTS ON THE SAME SITE AND THE CONTRACTOR SHALL COORDINATE ALL CONSTRUCTION EFFORTS.

PRIVATE PAVING PROJECT - PEC PROJECT NO. 35-05548-042
STORM WATER DRAIN NO. 272 - 468-84047
WATER DISTRIBUTION SYSTEM IMPROVEMENTS - 448-90083

THE CONTRACTOR SHALL COMMENCE WITH CONSTRUCTION OF SANITARY SEWER LINE NO. 1 FROM MH 1 TO MH 4, AND LINE NO. 2 FROM MH 2 TO MH 5 IN ITS ENTIRETY PRIOR TO PROCEEDING WITH PIPE LAYING OPERATIONS FOR THE REMAINDER OF LINE NO. 2. THE CONTRACTOR WILL BE REQUIRED TO COMPLETE ALL TESTING OF THESE LINES PRIOR TO BEGINNING THE REMAINDER OF LINE NO. 2. THIS PORTION OF THE SANITARY SEWER CONSTRUCTION, INCLUDING TESTING, SHALL BE COMPLETED BY MARCH 17, 2006.

THE EXISTING POND SHALL BE DRAINED AND FILLED WITH COMPACTED SOIL BY THE STORM WATER DRAIN CONTRACTOR PRIOR TO CONSTRUCTION OF THE REMAINDER OF THE SANITARY SEWER IMPROVEMENTS. UPON COMPLETION OF POND FILLING, THE CONTRACTOR SHALL PROCEED WITH CONSTRUCTION OF THE REMAINDER OF THE SANITARY SEWER WITHIN 7 CALENDAR DAYS AND COMPLETE THIS WORK WITHIN 14 CALENDAR DAYS.

ANY RE-MOBILIZATION REQUIRED FROM DELAYS THAT MAY OCCUR FROM THE STORM WATER DRAIN CONTRACTOR SHALL BE INCIDENTAL TO THE LUMP SUM PRICE BID FOR "SITE CLEARING".

JANUARY 2006

PLANS PREPARED BY
PROFESSIONAL ENGINEERING CONSULTANTS, P.A.
ENGINEERS
WICHITA, KANSAS