
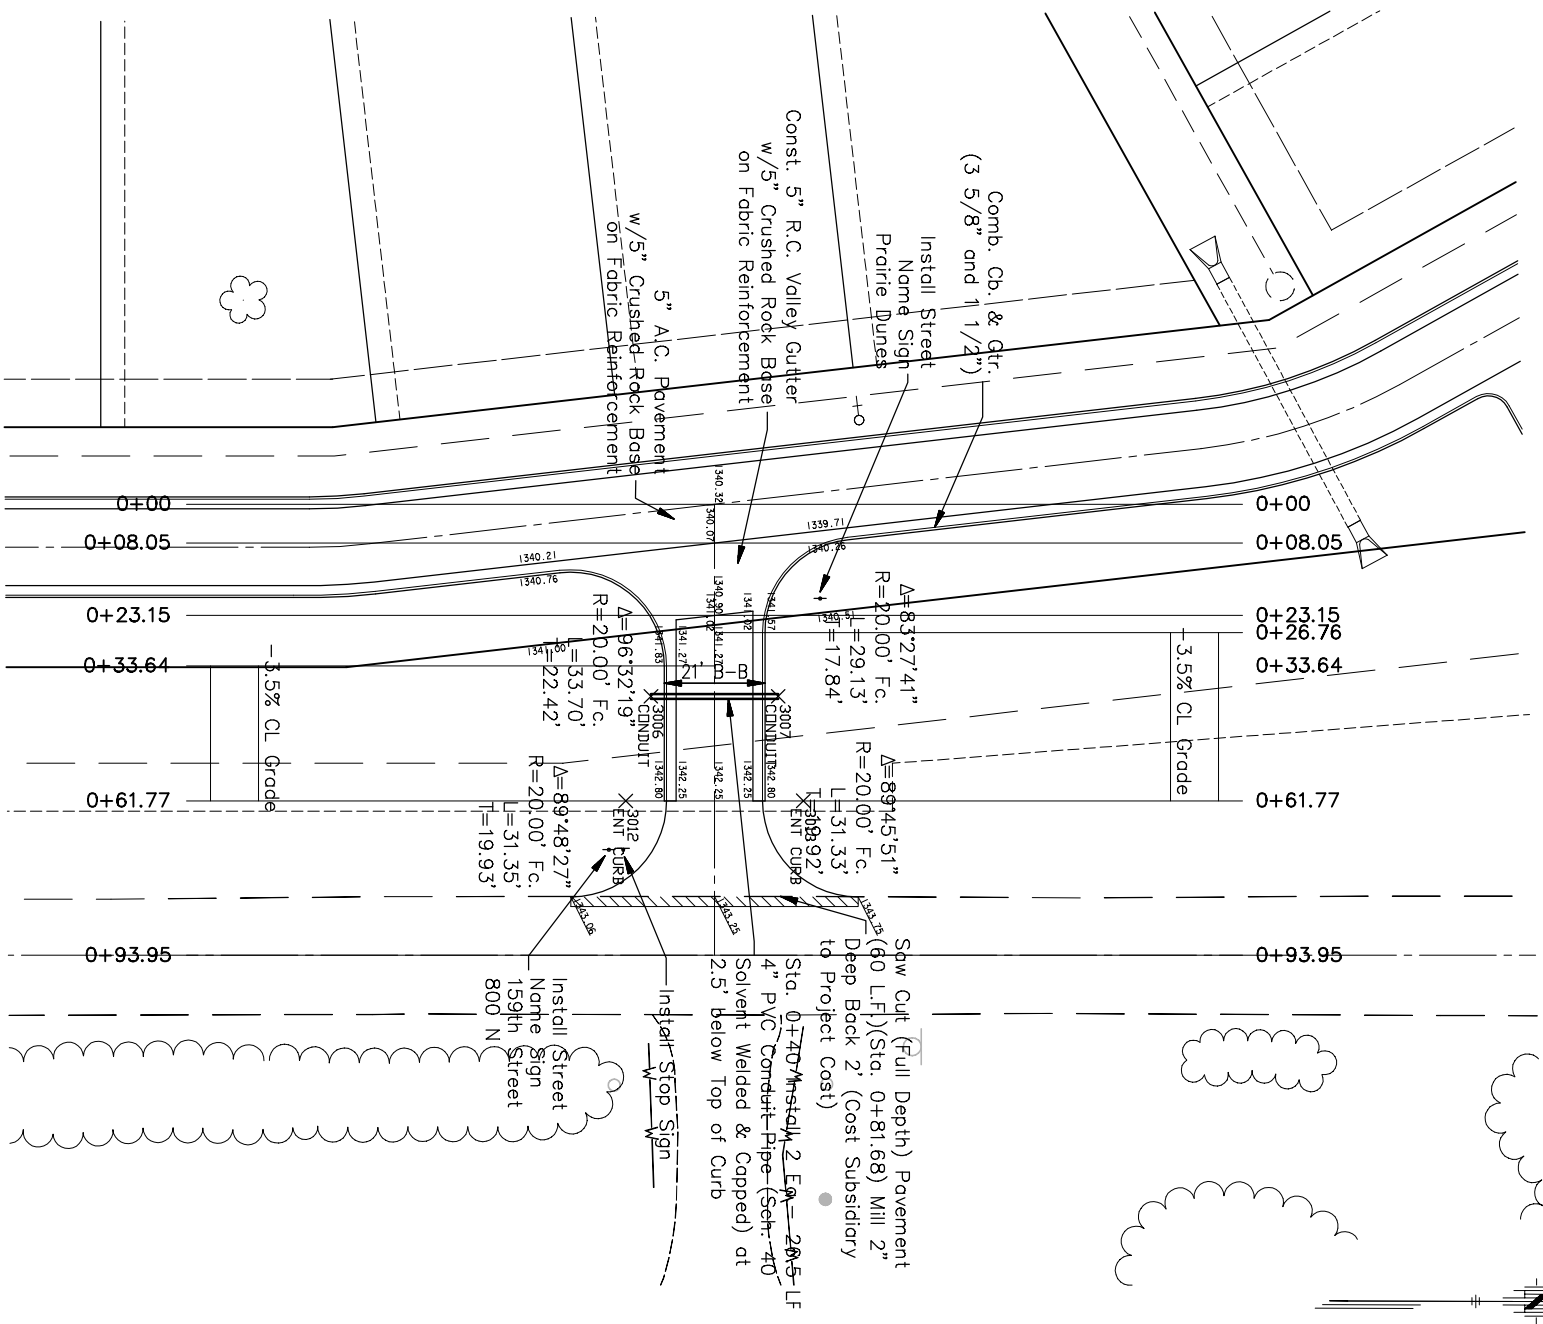


RECORD DRAWING
1/9/2008
MLT

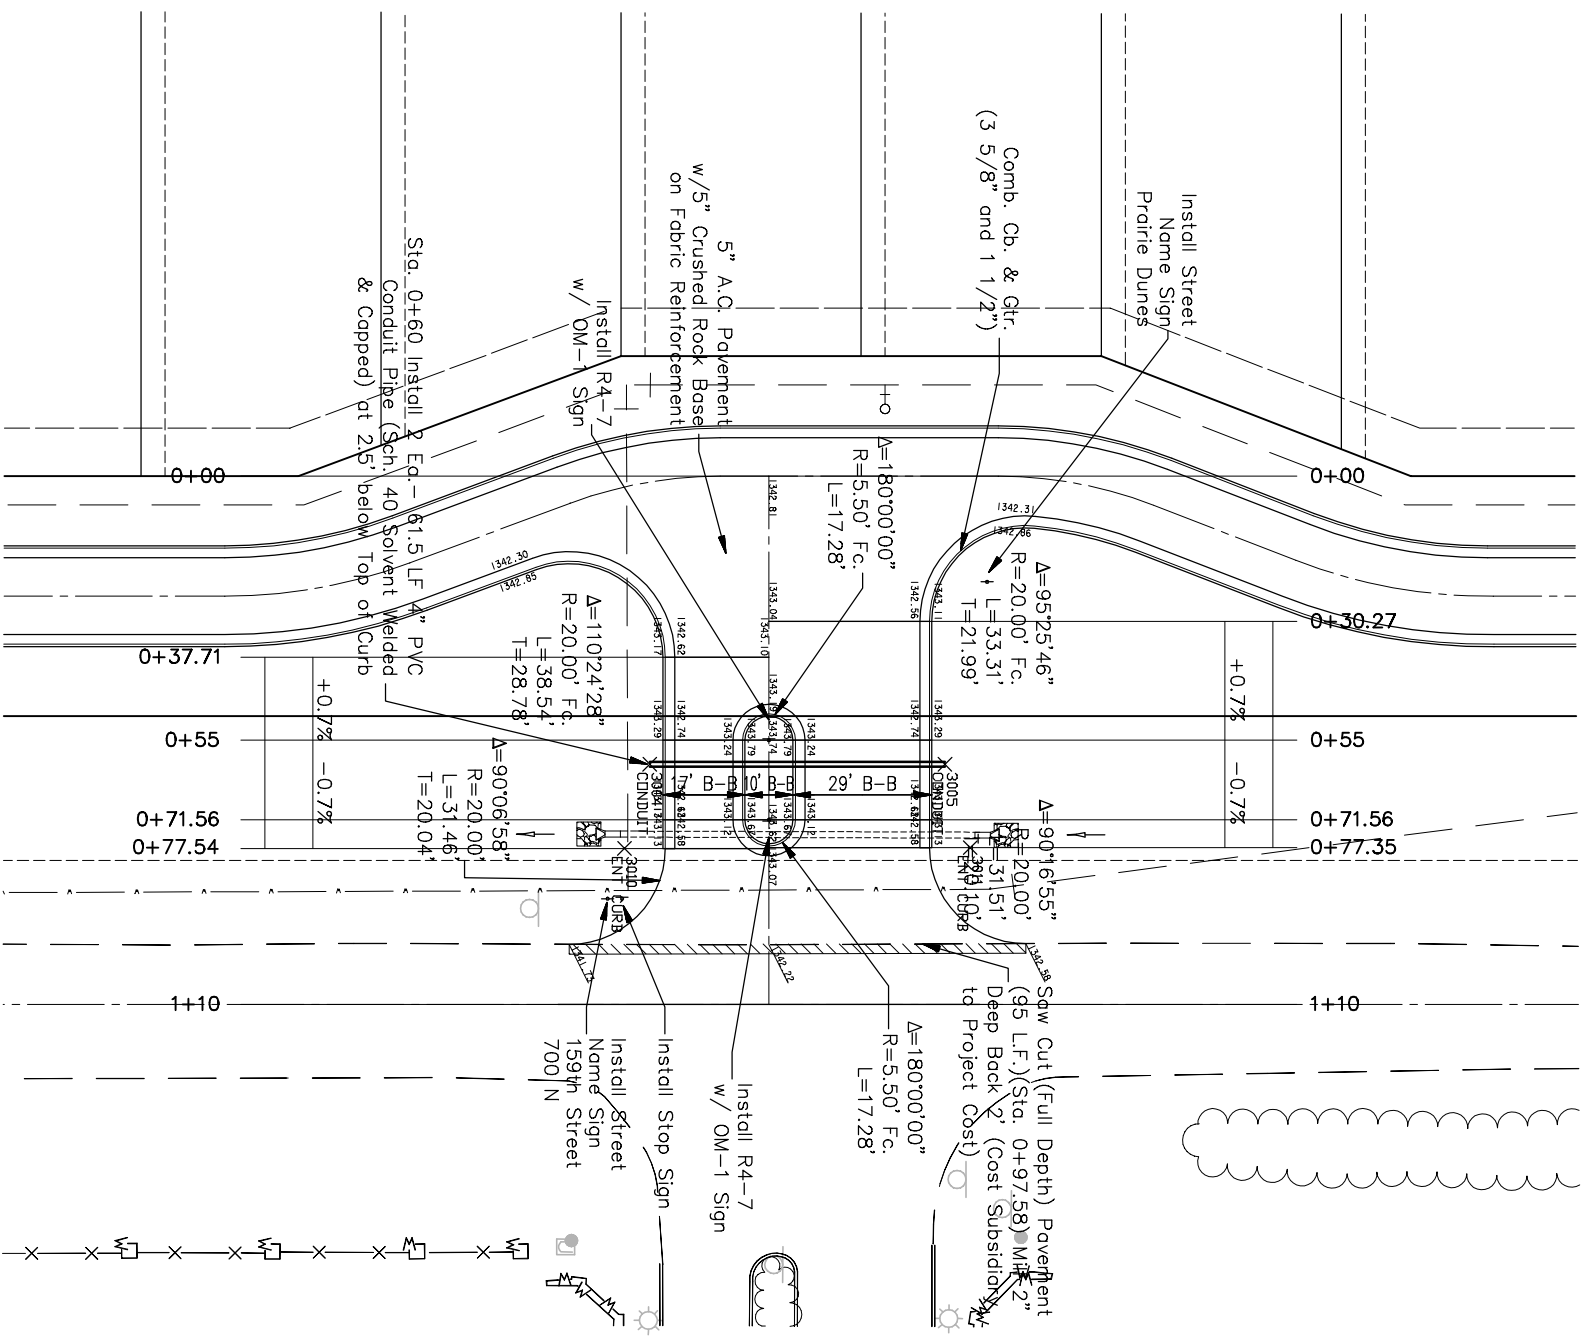

NOTES:
Elevations show at top of curb are full height curb elevations. Subtract 0.25 for roll curb elevations.
Grade from top of curb to existing ground when curb is not adjacent to proposed lots. Ensure that grades do not cause water to pond in these areas.

FINAL

Designed By: J. Dickman
Drawn By: M. Tucker
Poe Job No.: 1809B
Date: April 2007



POE & ASSOCIATES, INC.
CONSULTING ENGINEERS
5940 E. Central, Suite 200 ■ Wichita, KS 67208-4242
Phone 316/685-4114 ■ FAX 316/685-4444

TERRADYNE WEST ADDITION
STREET IMPROVEMENTS
ENTRANCE DRIVES
CITY OF WICHITA, KANSAS
JAMES L. ARMOUR, P.E. - CITY ENGINEER
Private Project # 179PPP O.C.A. # 607879

No.	Date	By	Approved	Revision
△				
△				
△				
△				